
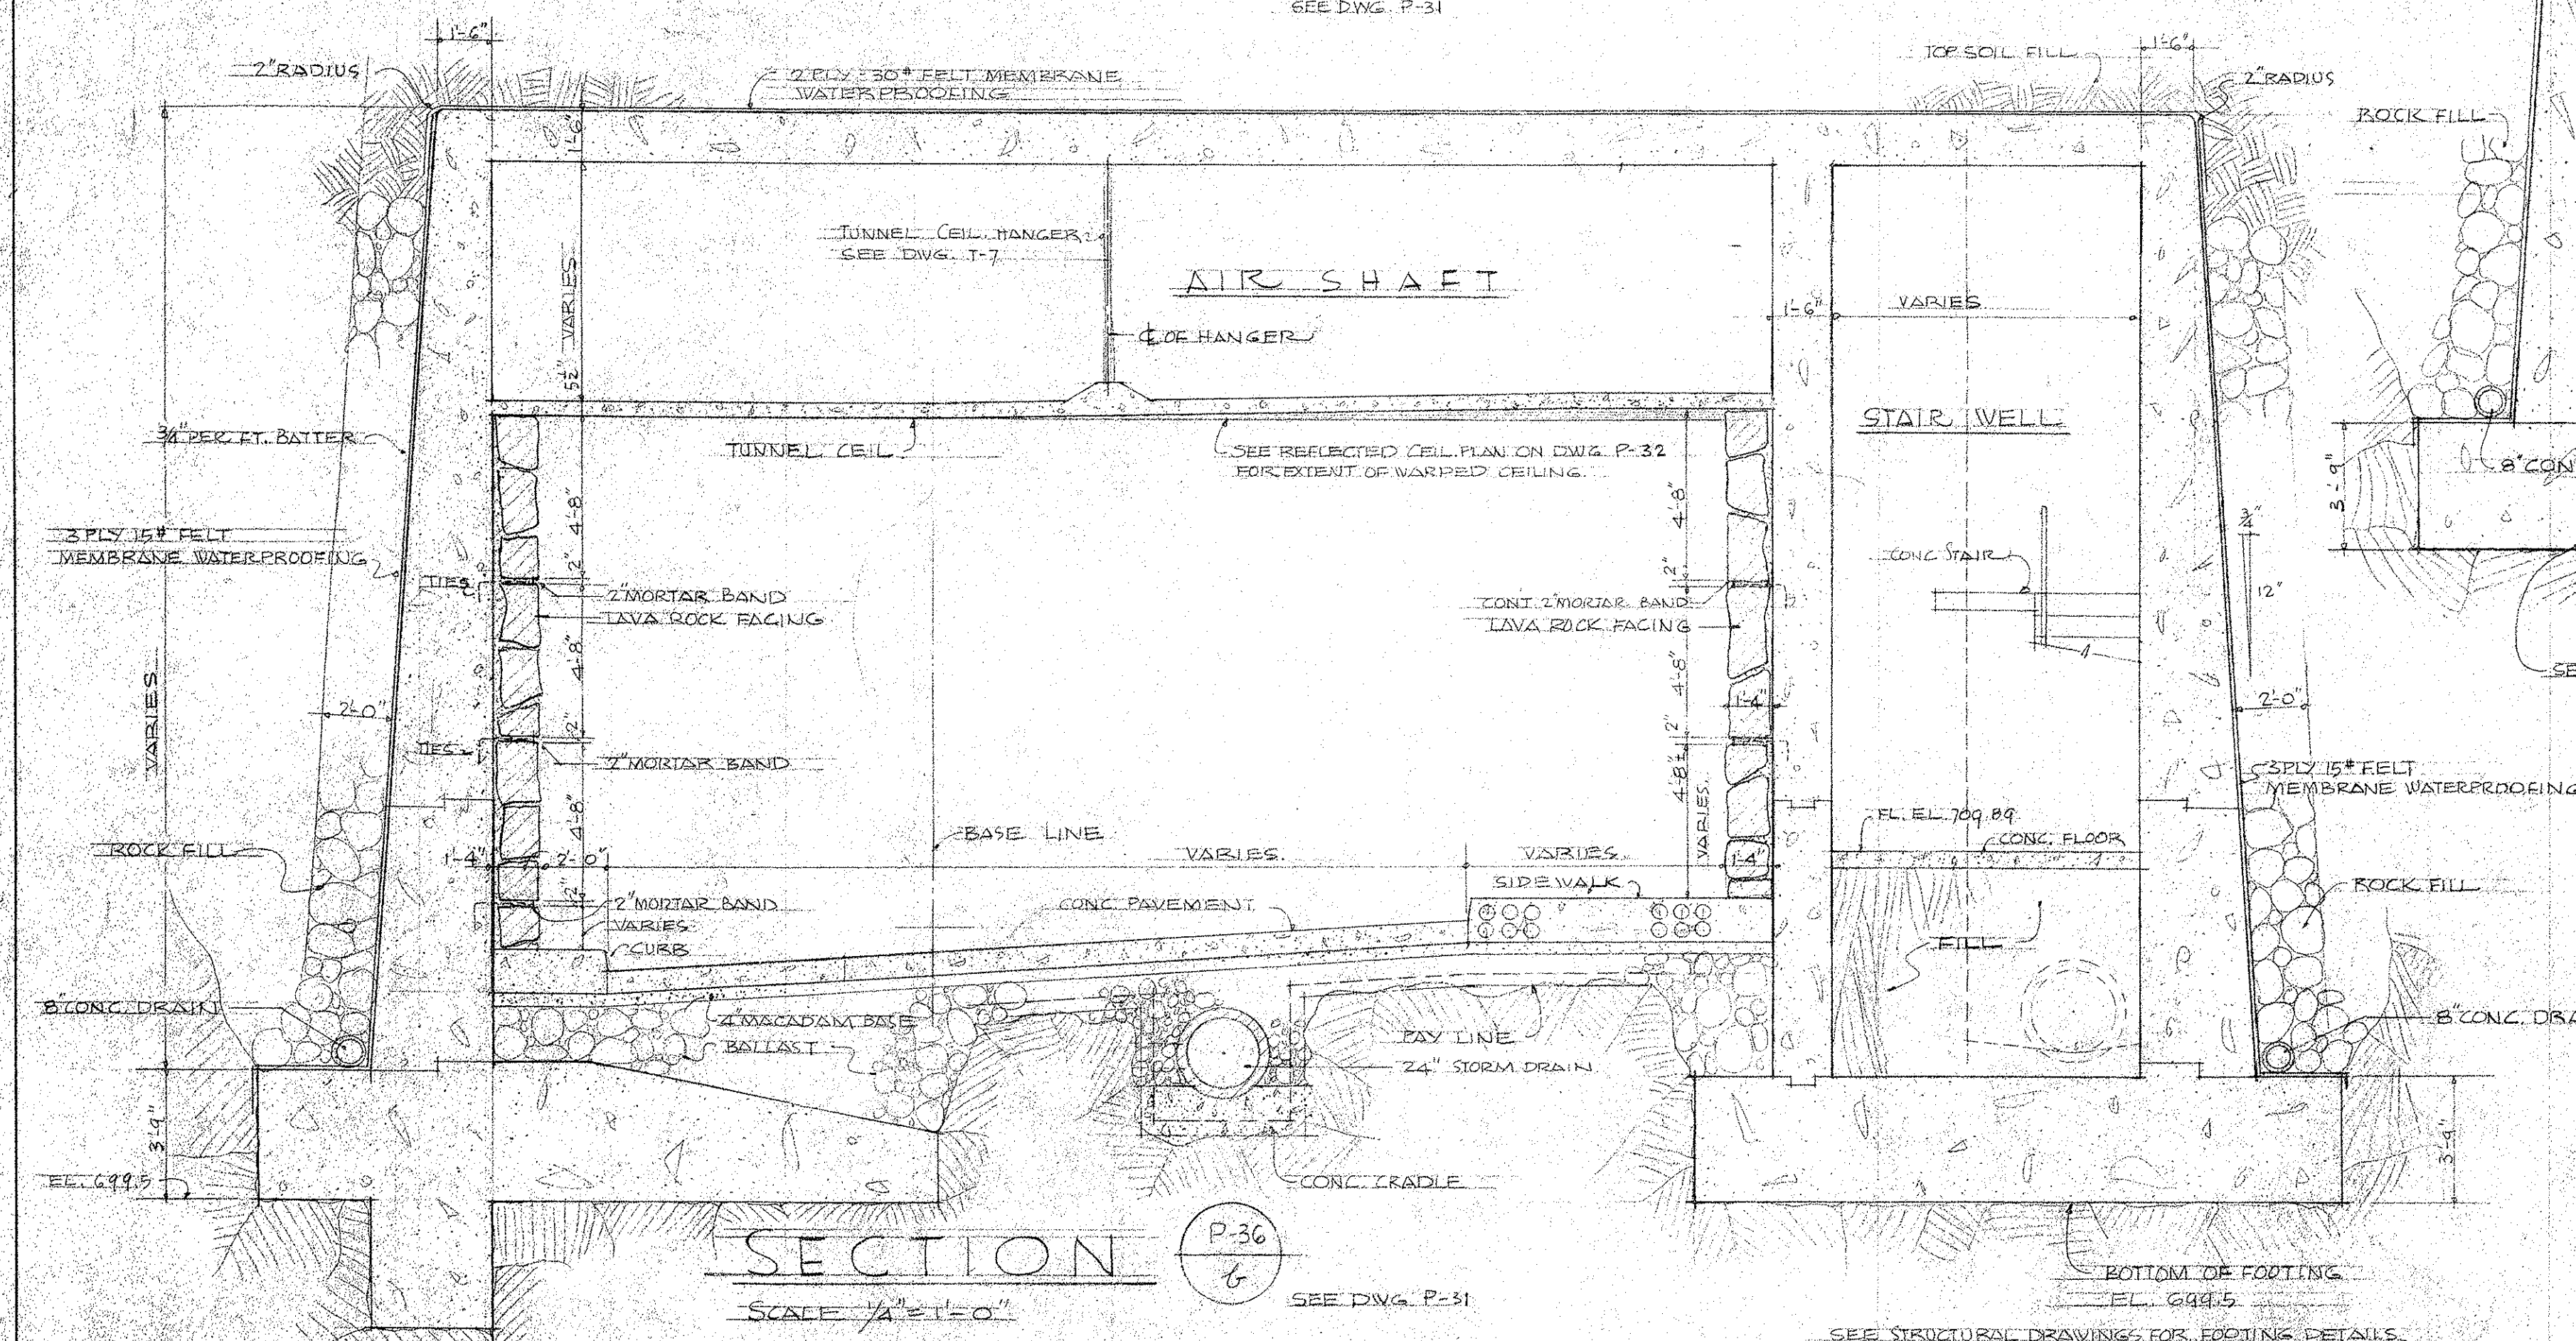


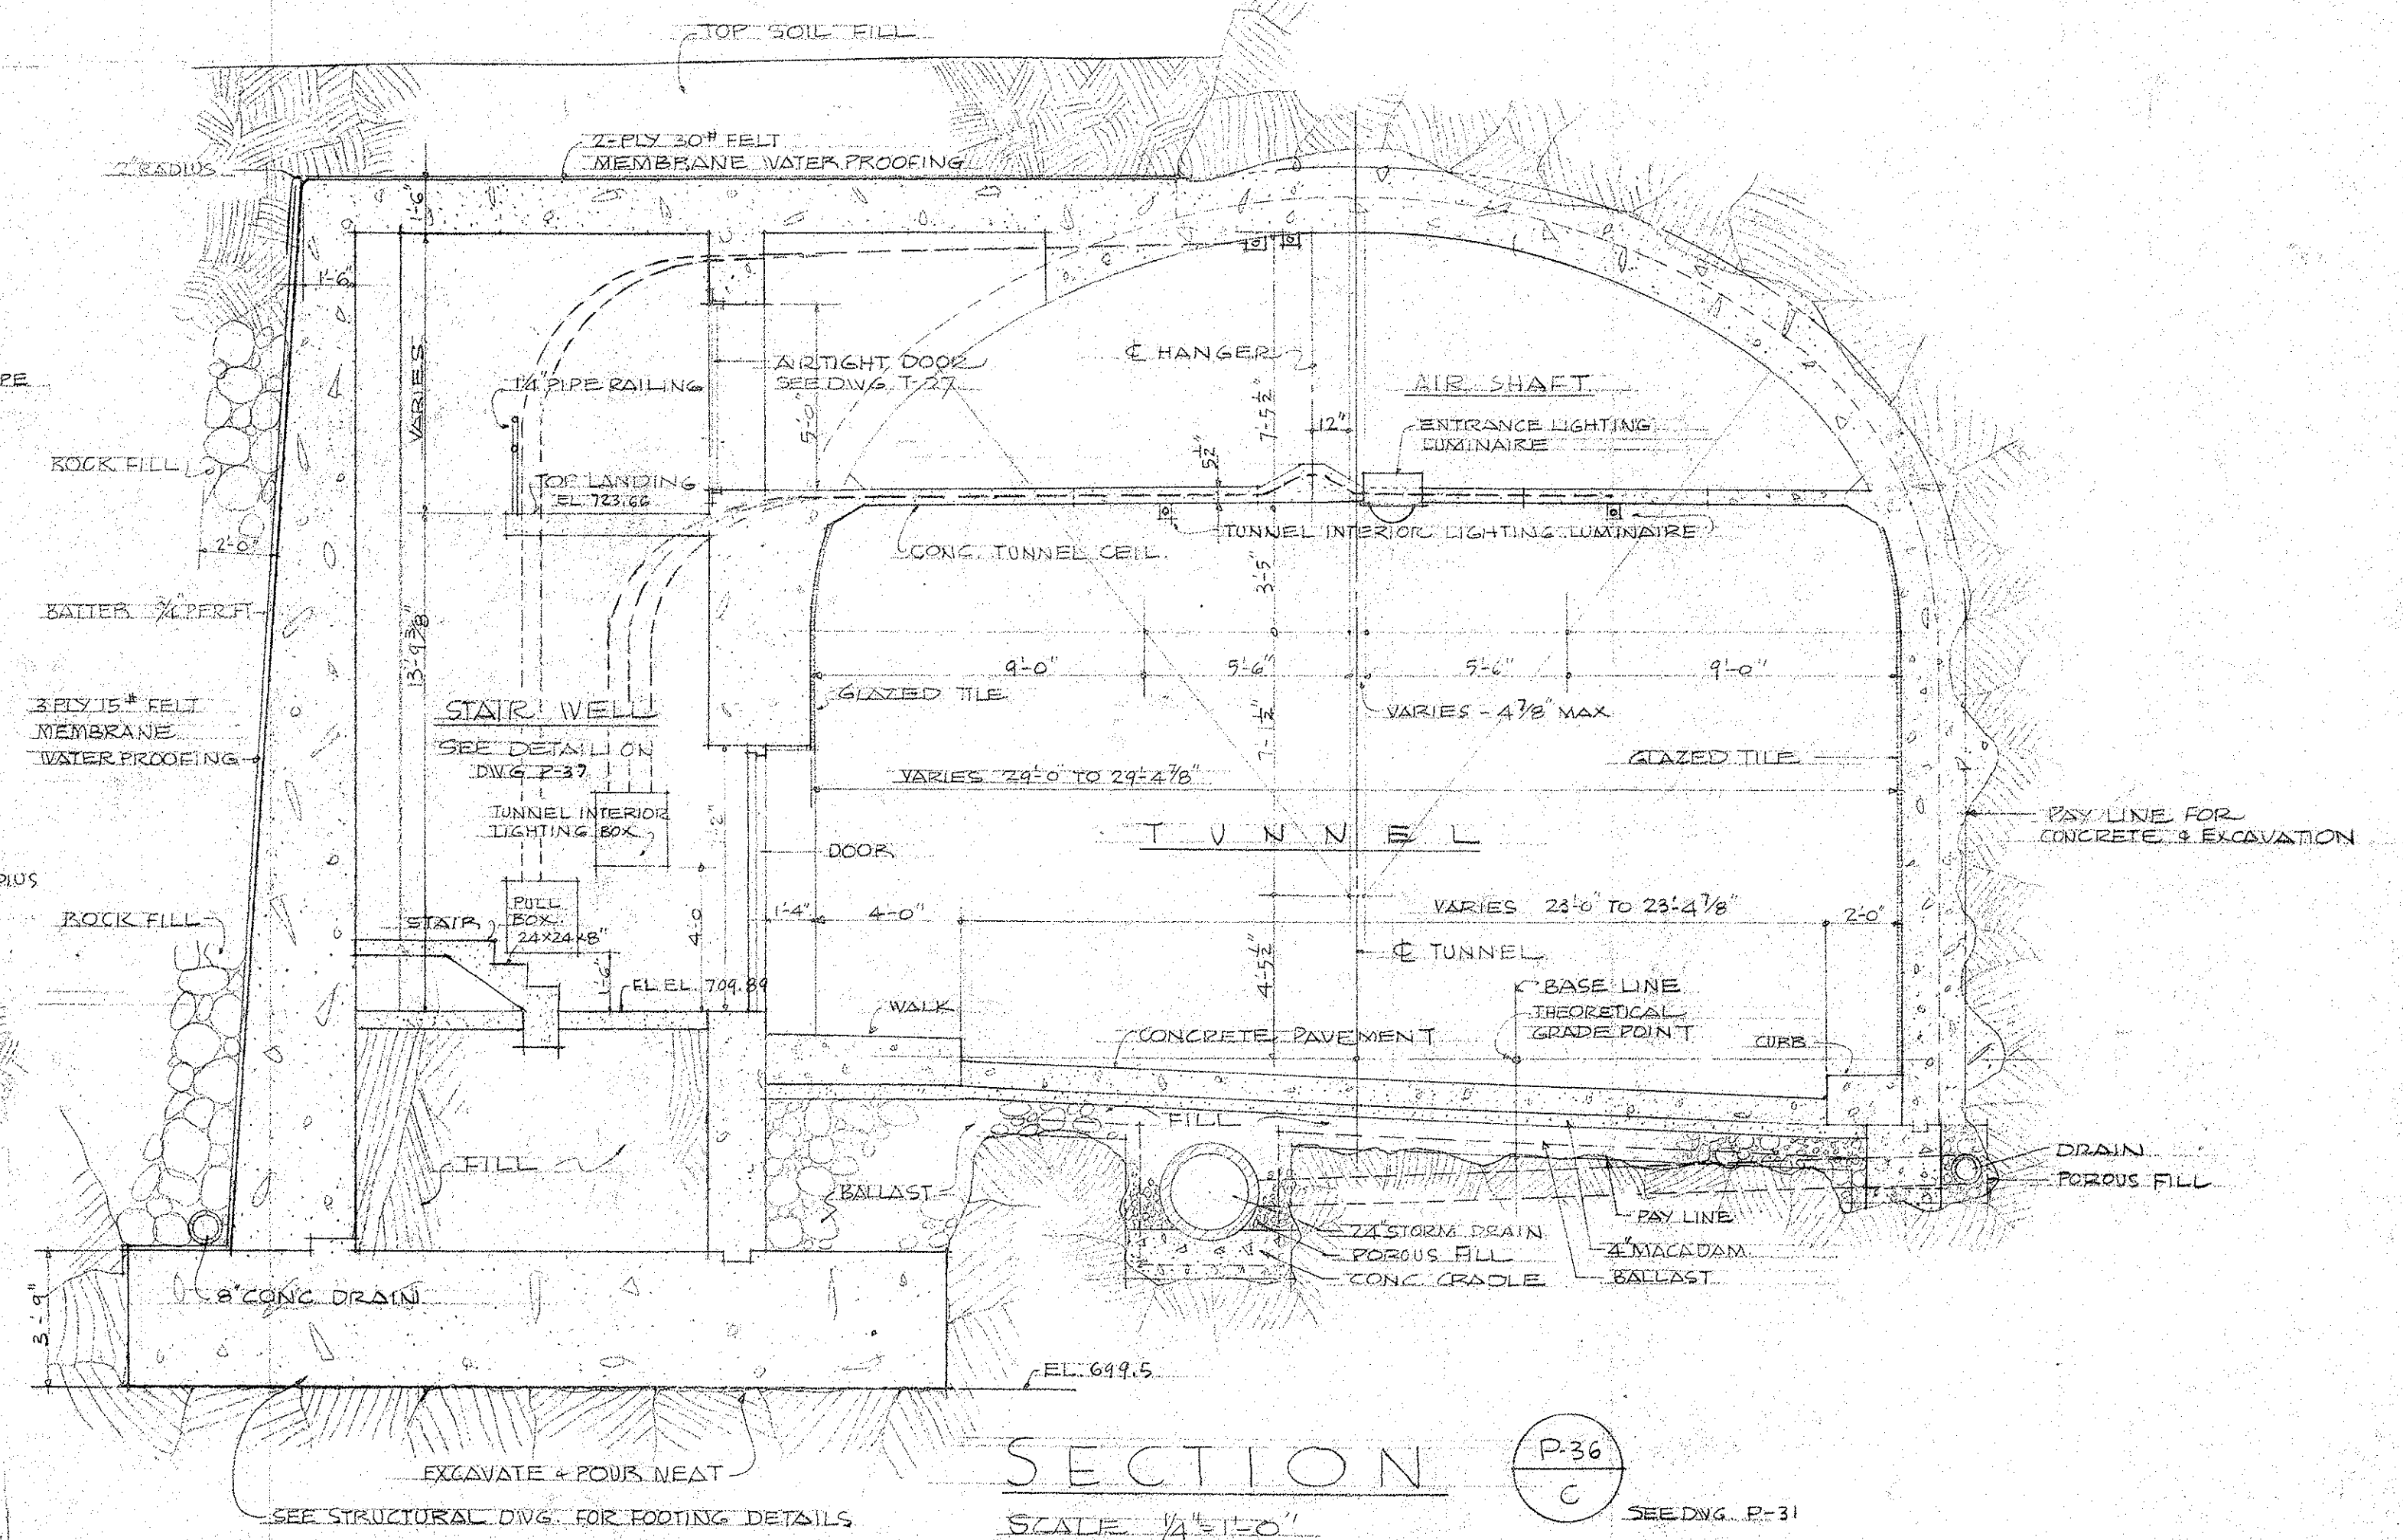

Sheet No. 158 of 252 Sheets

FILE	POCKET	FOLDER	NO.
7	6	1	36