




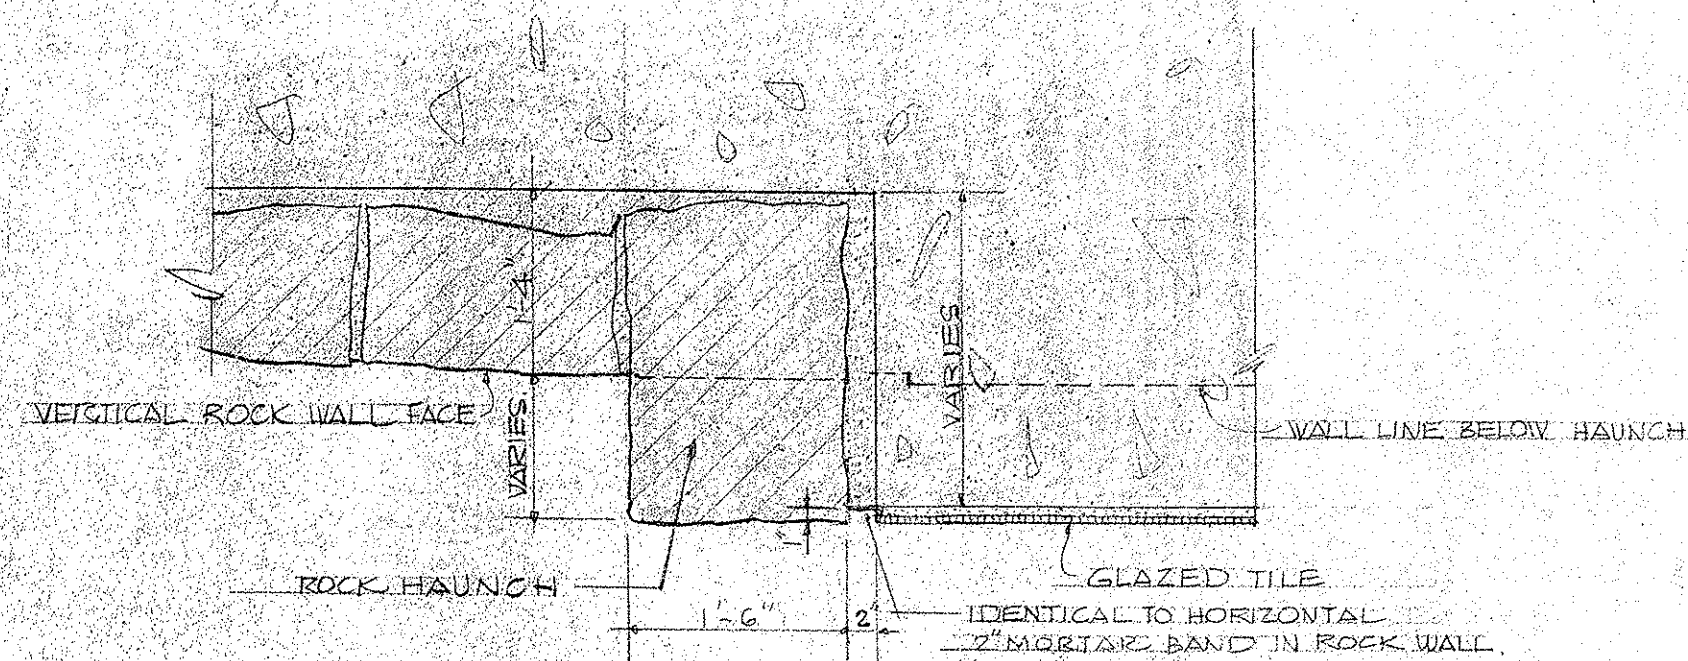

ROCK HAUNCH DETAIL (P-7)
a
SCALE 3/4" = 1'-0"

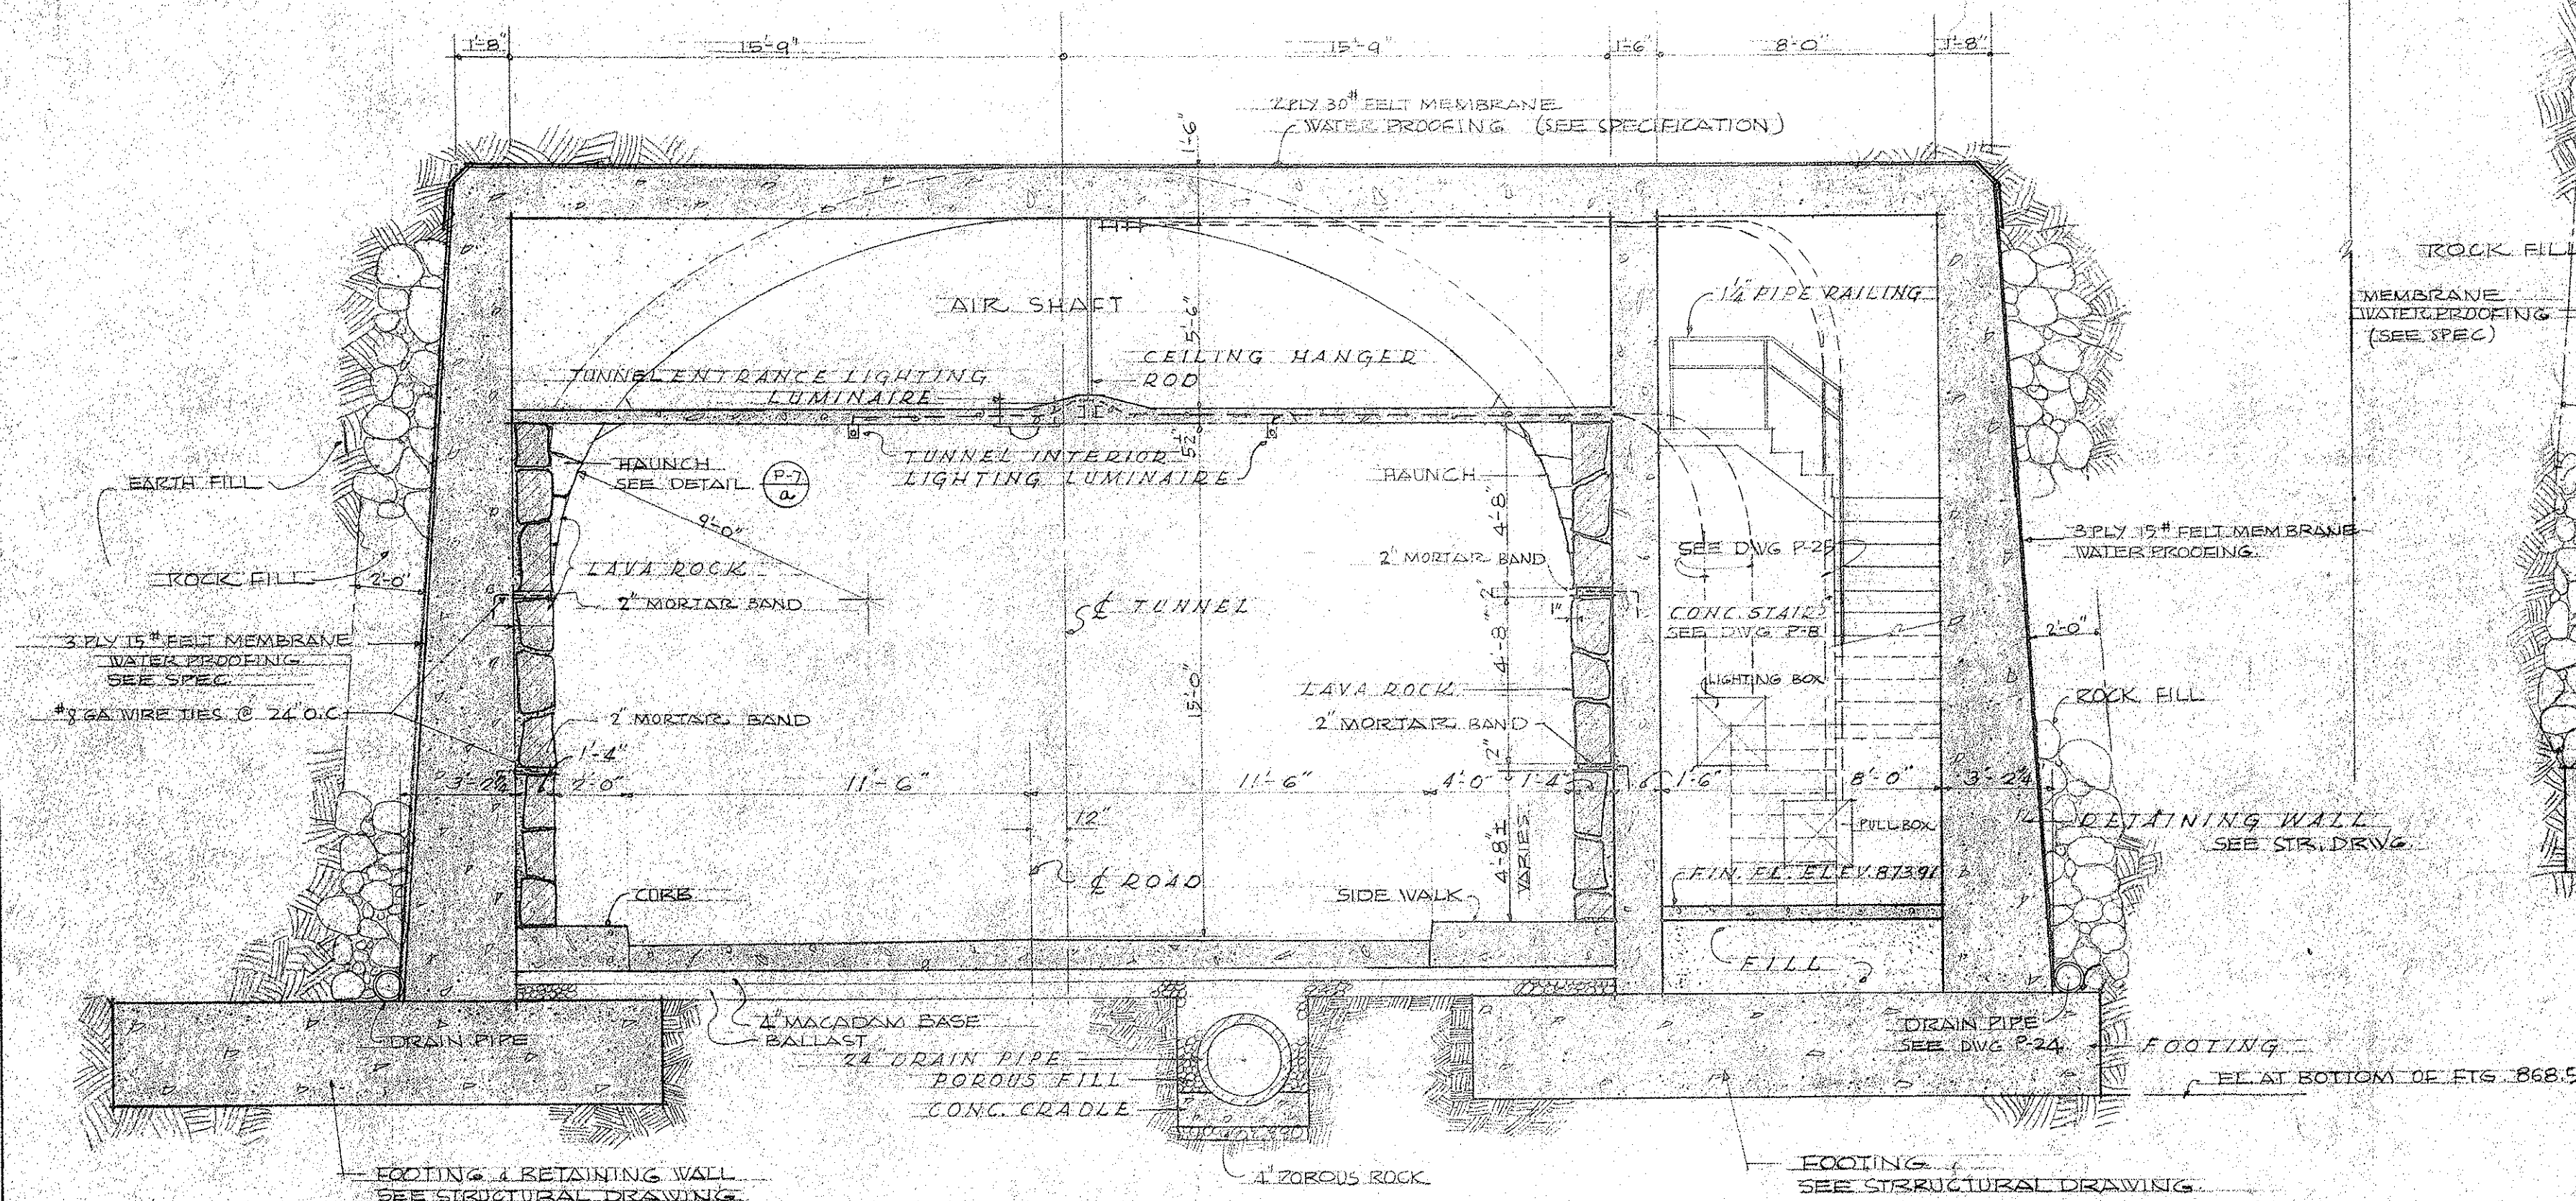

SECTION (P-7)
c
SCALE 1/4" = 1'-0" SEE DWG P-2

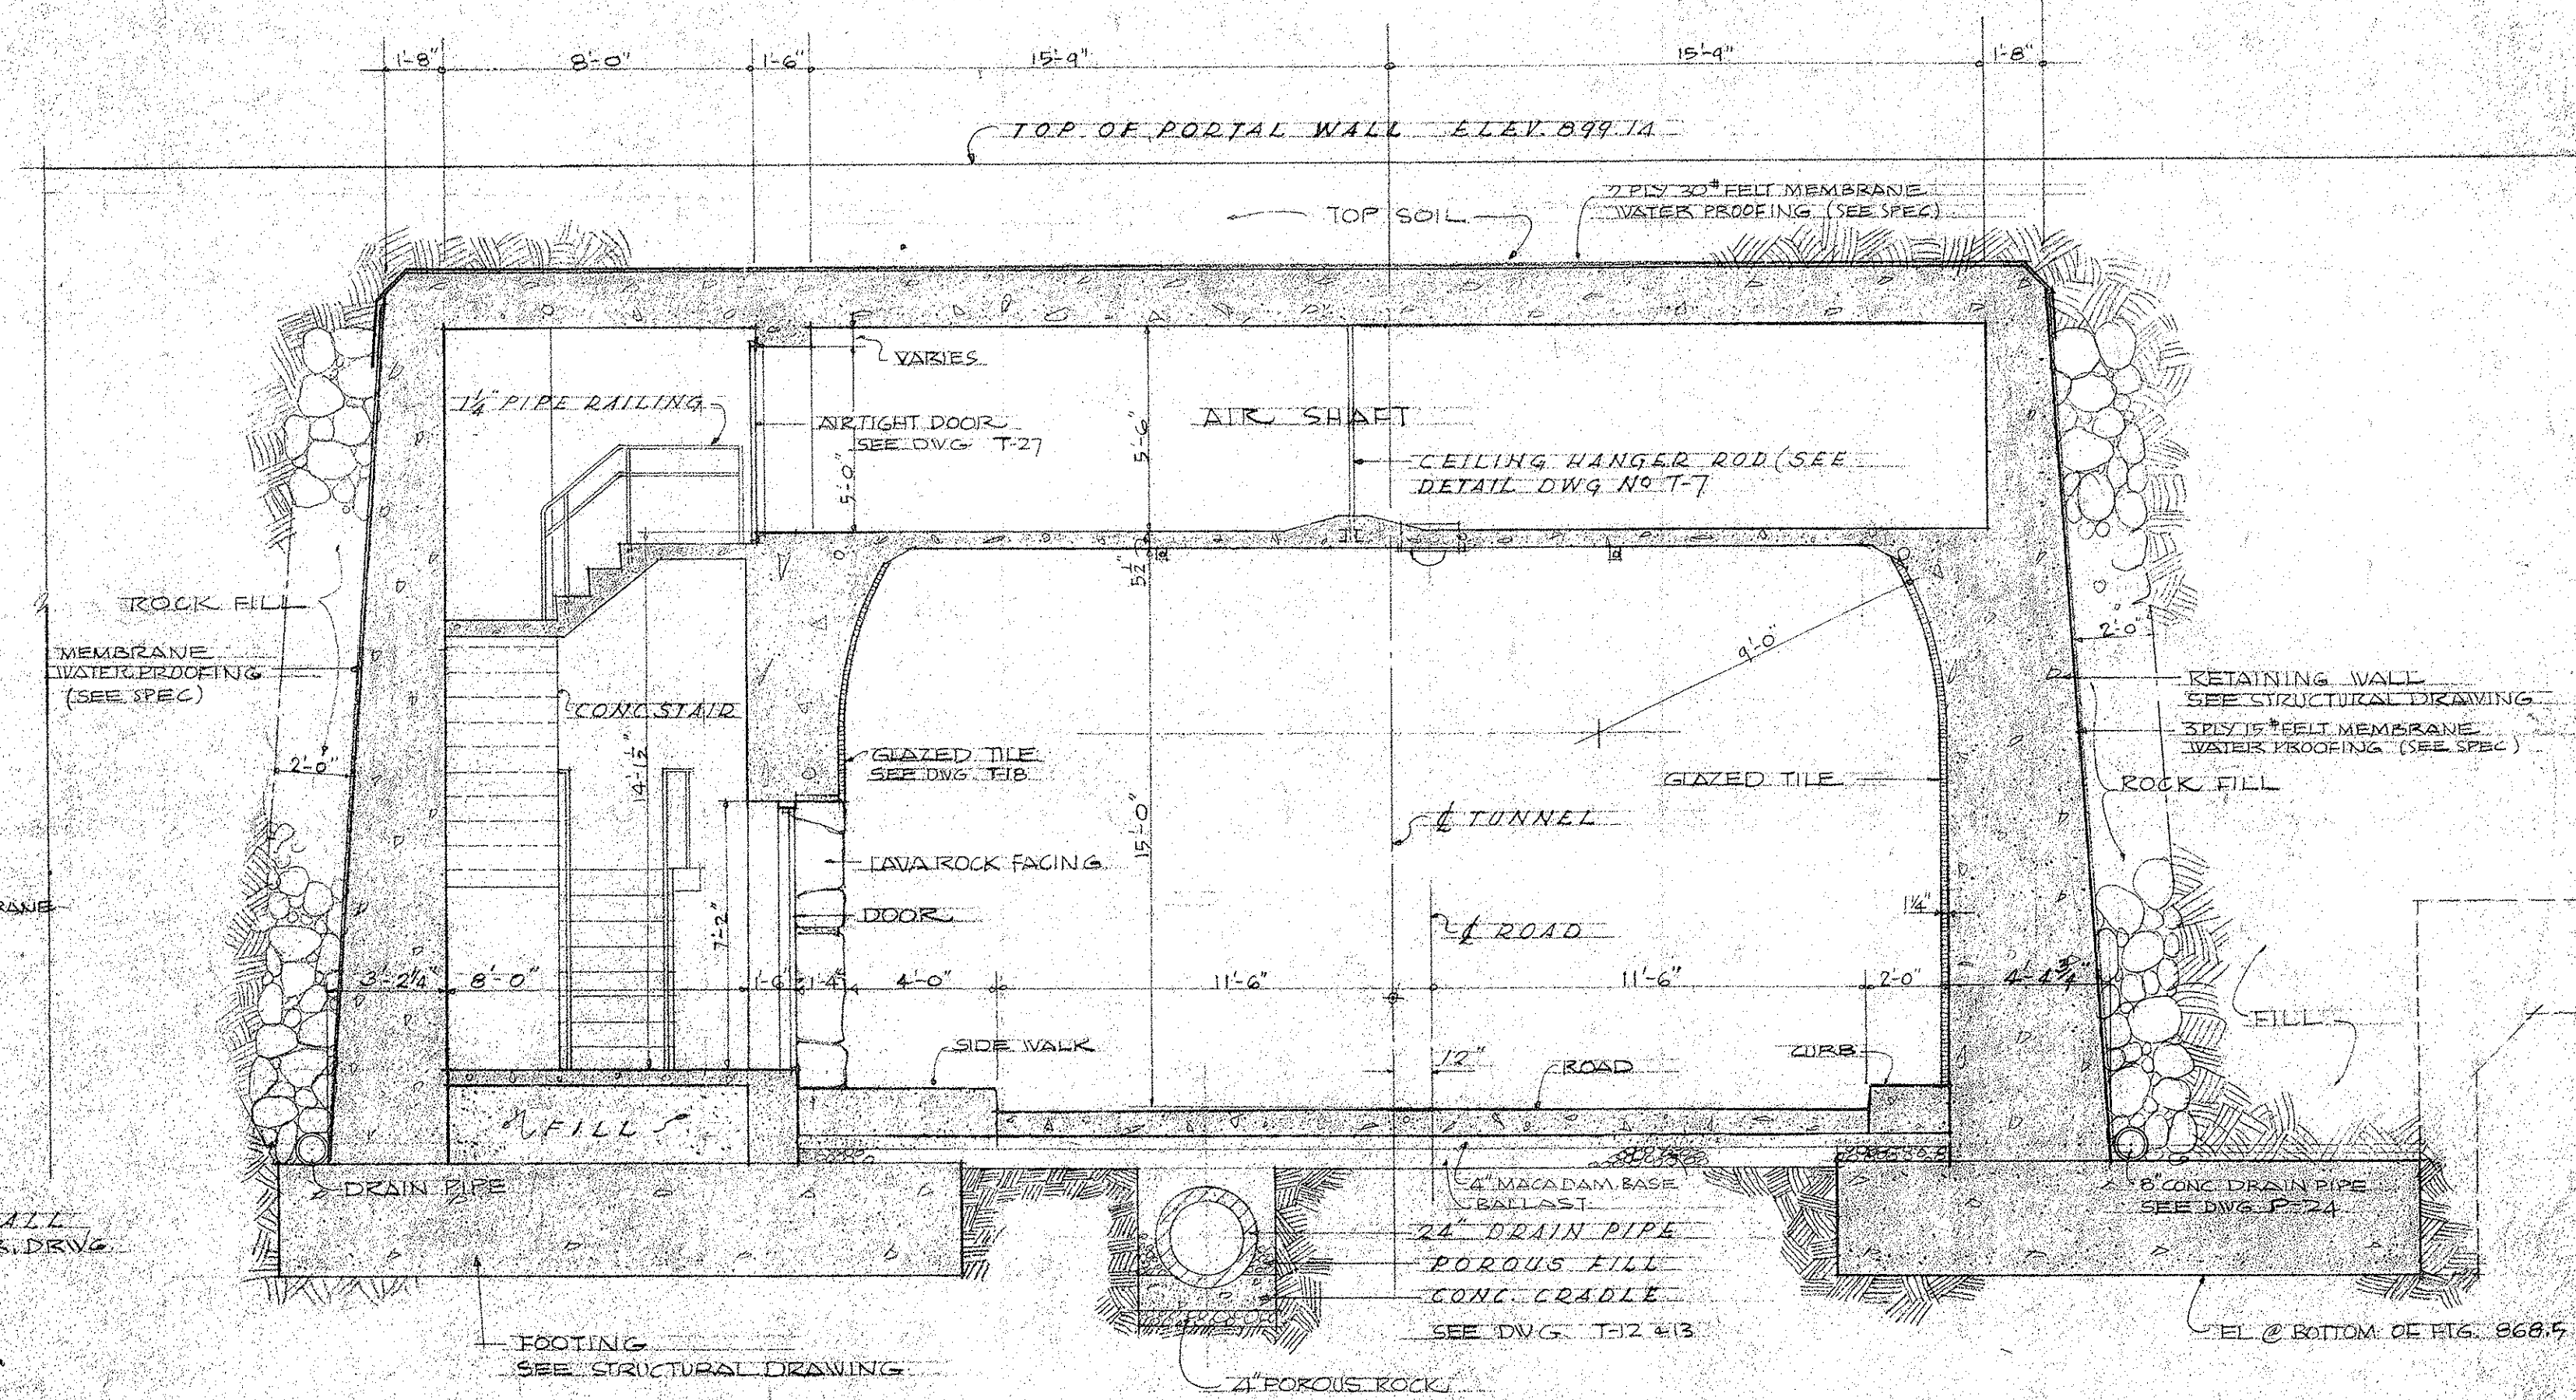

SECTION (P-7)
c
SCALE 1/4" = 1'-0" SEE DWG P-2

LAW & WILSON ARCHITECTS & ENGINEERS			
DEPARTMENT OF PUBLIC WORKS CITY AND COUNTY OF HONOLULU			
BUREAU OF PLANS			
KALIHI TUNNEL			
KALIHI PORTAL CROSS SECTIONS			
ENGINEER: L. S. W.	DATE: JULY 15, 1953		
DRAFTSMAN: T. FURUDERA	CHECKED BY: T.E. [Signature]		
SCALE: AS NOTED	TRACER:		
APPROVED: [Signature] CHIEF ENGINEER	APPROVED: [Signature] BUREAU ENGINEER		

W.S.	PROFILE	C.B.
CR. SEC.	P.B.	S.B.
W.M.B.Y.	P.W.B.Y.	S.B.Y.

SECTION C JOB NO. 26-53 DWG. P-7