


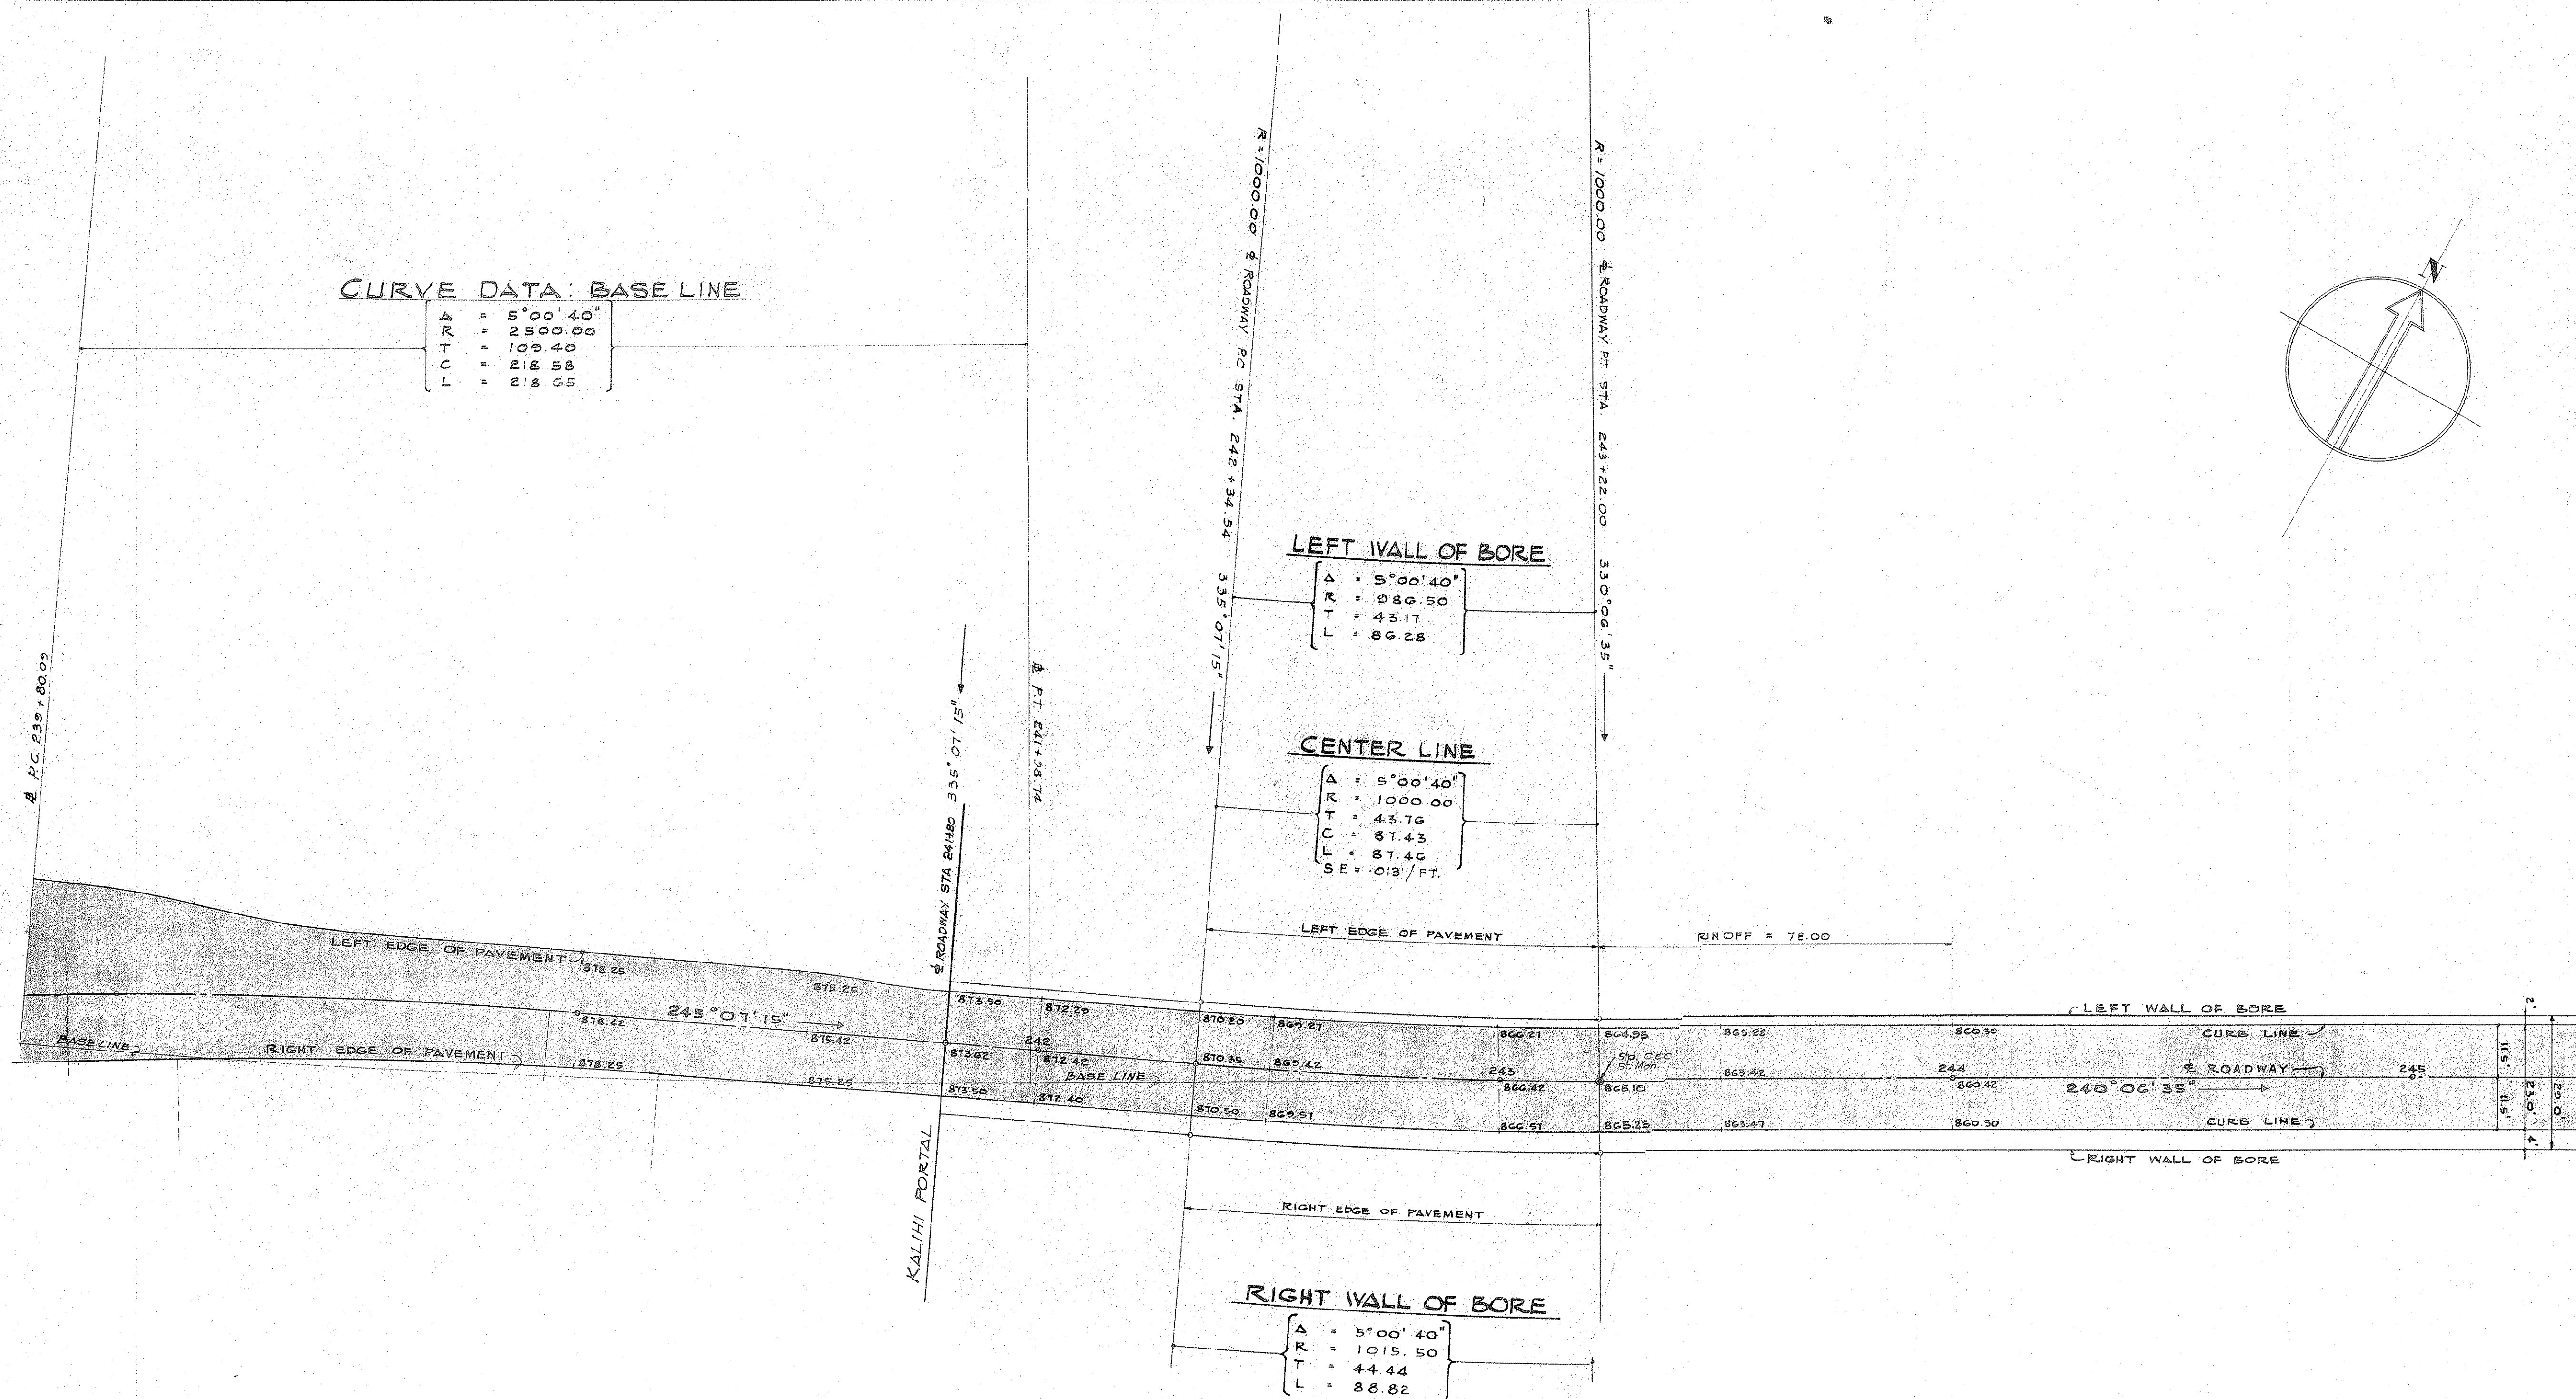

LAW & WILSON
ARCHITECTS & ENGINEERS

DEPARTMENT OF PUBLIC WORKS
CITY AND COUNTY OF HONOLULU

BUREAU OF PLANS

KALIHI TUNNEL
INFORMATION
CURVE DATA
KALIHI END OF TUNNEL

ENGINEER: L.S.W. & K.C. DATE: JULY 15, 1953
DRAFTSMAN: K.N. CHECKED BY: H.T. [Signature]
SCALE: 1" = 20' TRACER: [Signature]
APPROVED: [Signature] CHIEF ENGINEER
APPROVED: [Signature] BUREAU ENGINEER

W.B.	PROFILE	C.B.
CR. SEC.	F.B.	S.B.
W.M. BY	F.W. BY	S. BY

SECTION C JOB NO. 26-53 DWG. X-7

