


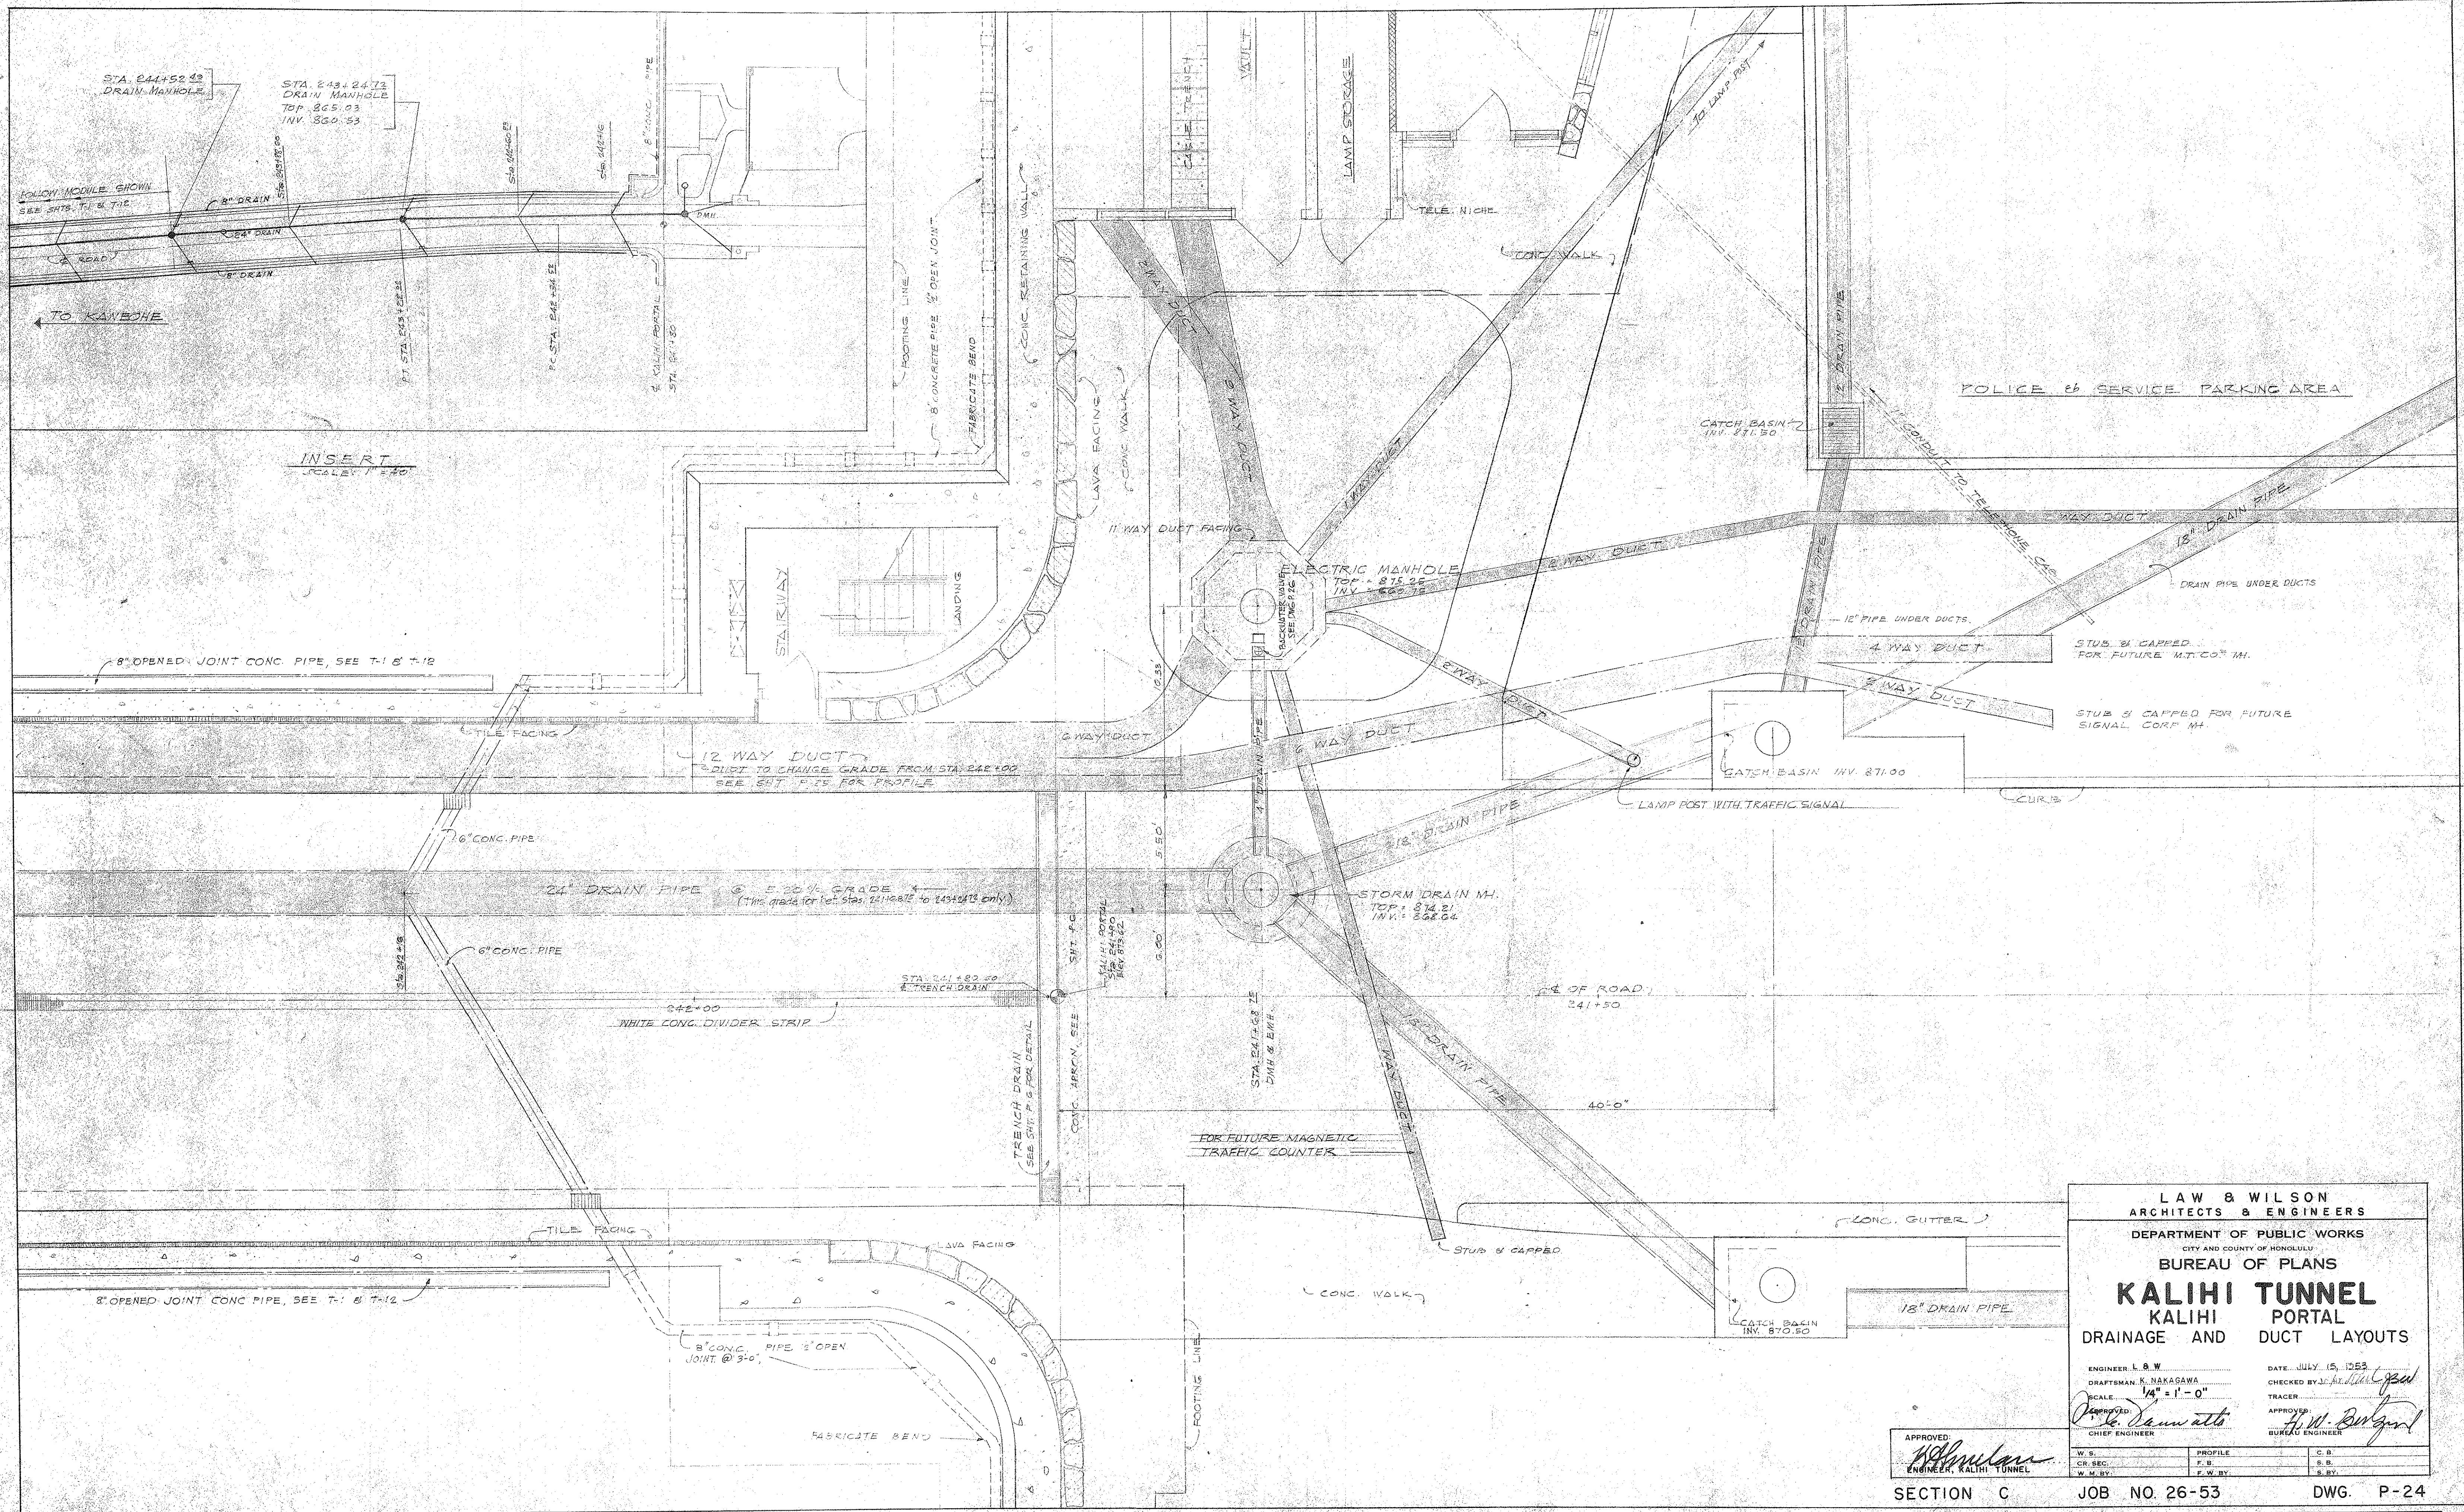

LAW & WILSON
ARCHITECTS & ENGINEERS
DEPARTMENT OF PUBLIC WORKS
CITY AND COUNTY OF HONOLULU
BUREAU OF PLANS

KALIHI TUNNEL
KALIHI PORTAL
DRAINAGE AND DUCT LAYOUTS

ENGINEER: L. & W.
DRAFTSMAN: K. NAKAGAWA
SCALE: 1/4" = 1' - 0"
APPROVED: *[Signature]*
CHIEF ENGINEER

DATE: JULY 15, 1953
CHECKED BY: *[Signature]*
TRACER:
APPROVED: *[Signature]*
BUREAU ENGINEER

W.S.	PROFILE	C.B.
CR. SEC.	F.B.	S.B.
W.M.B.Y.	F.W.B.Y.	S.B.Y.