
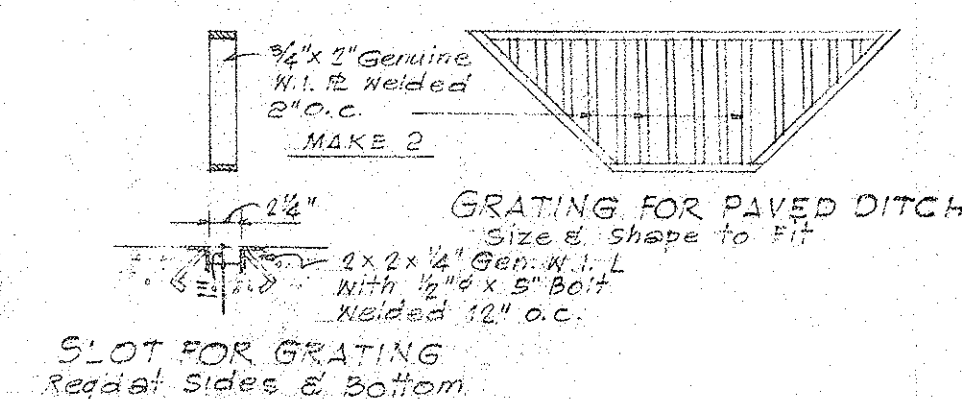
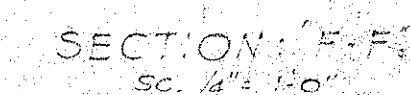
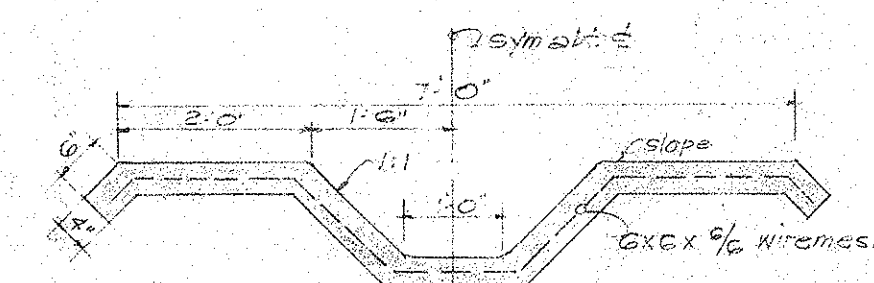
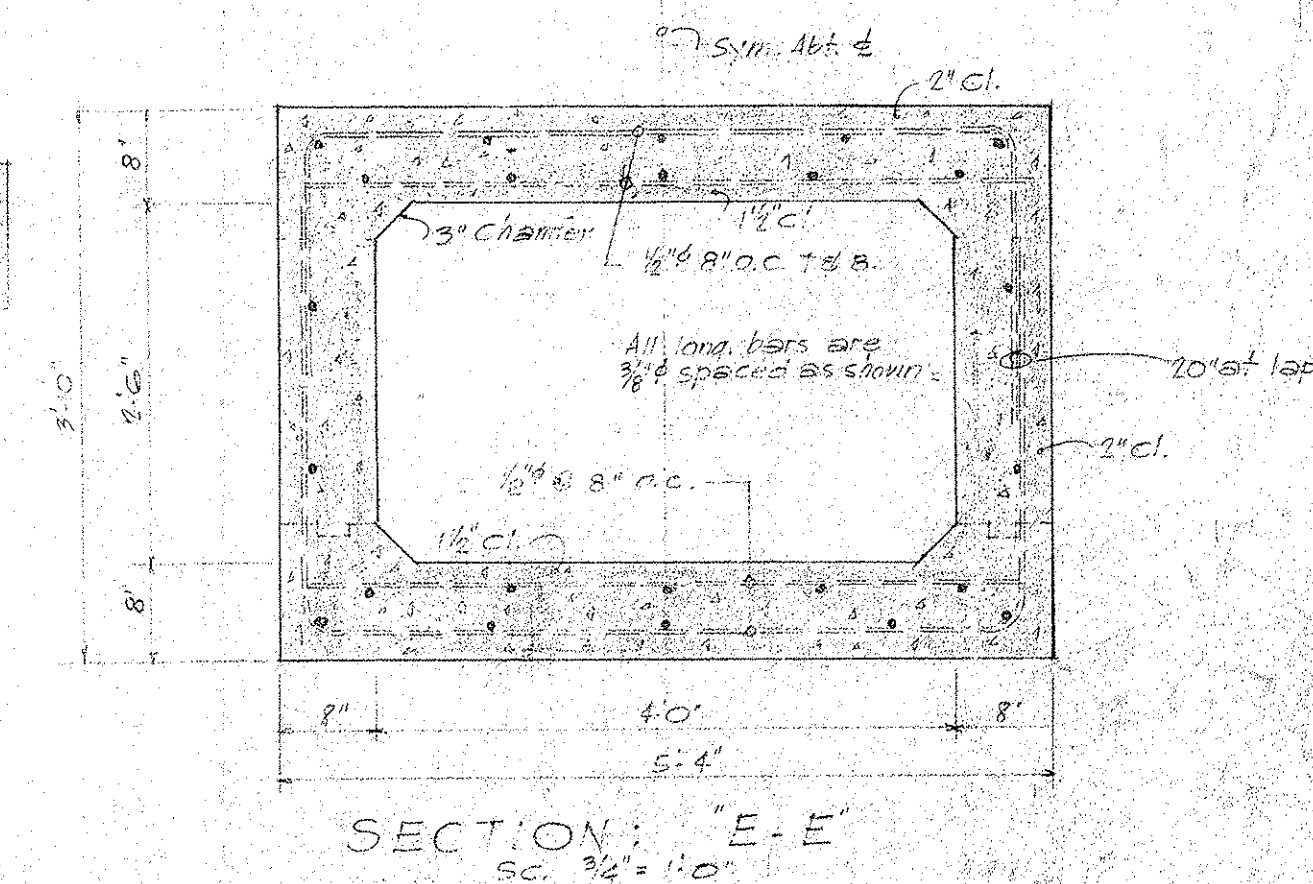
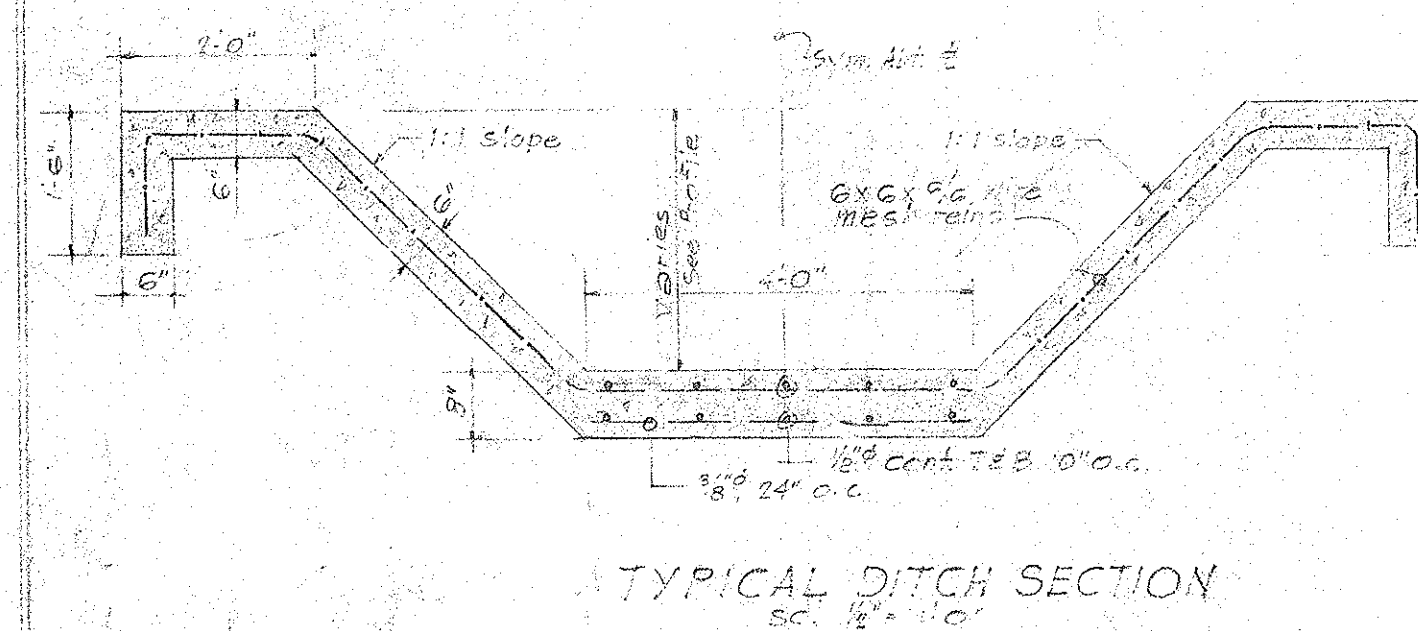
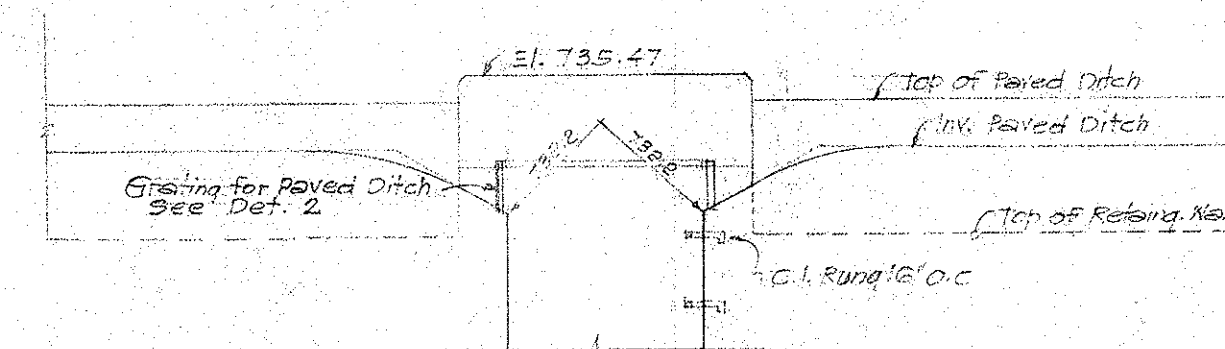
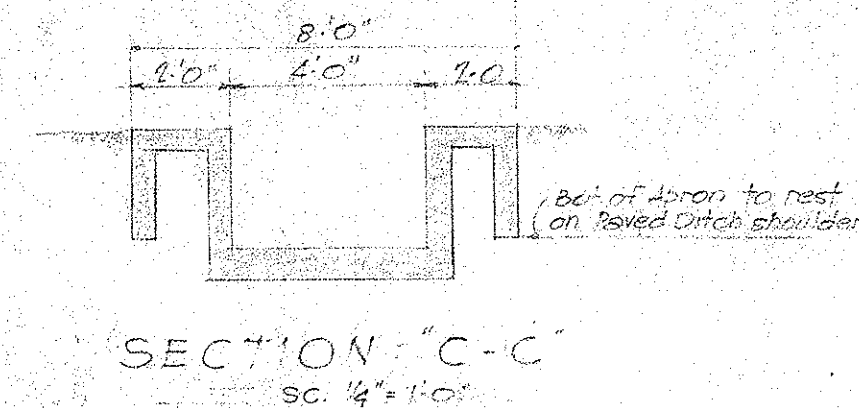
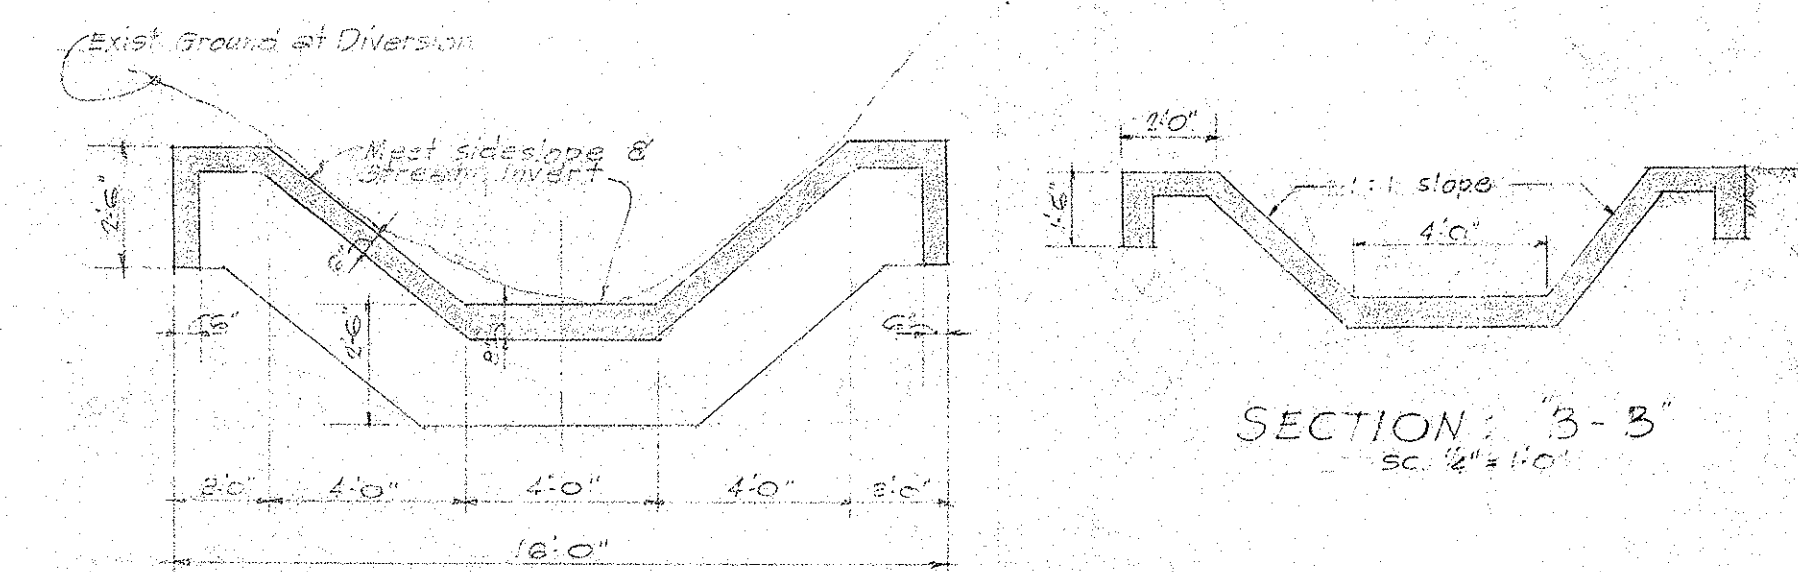


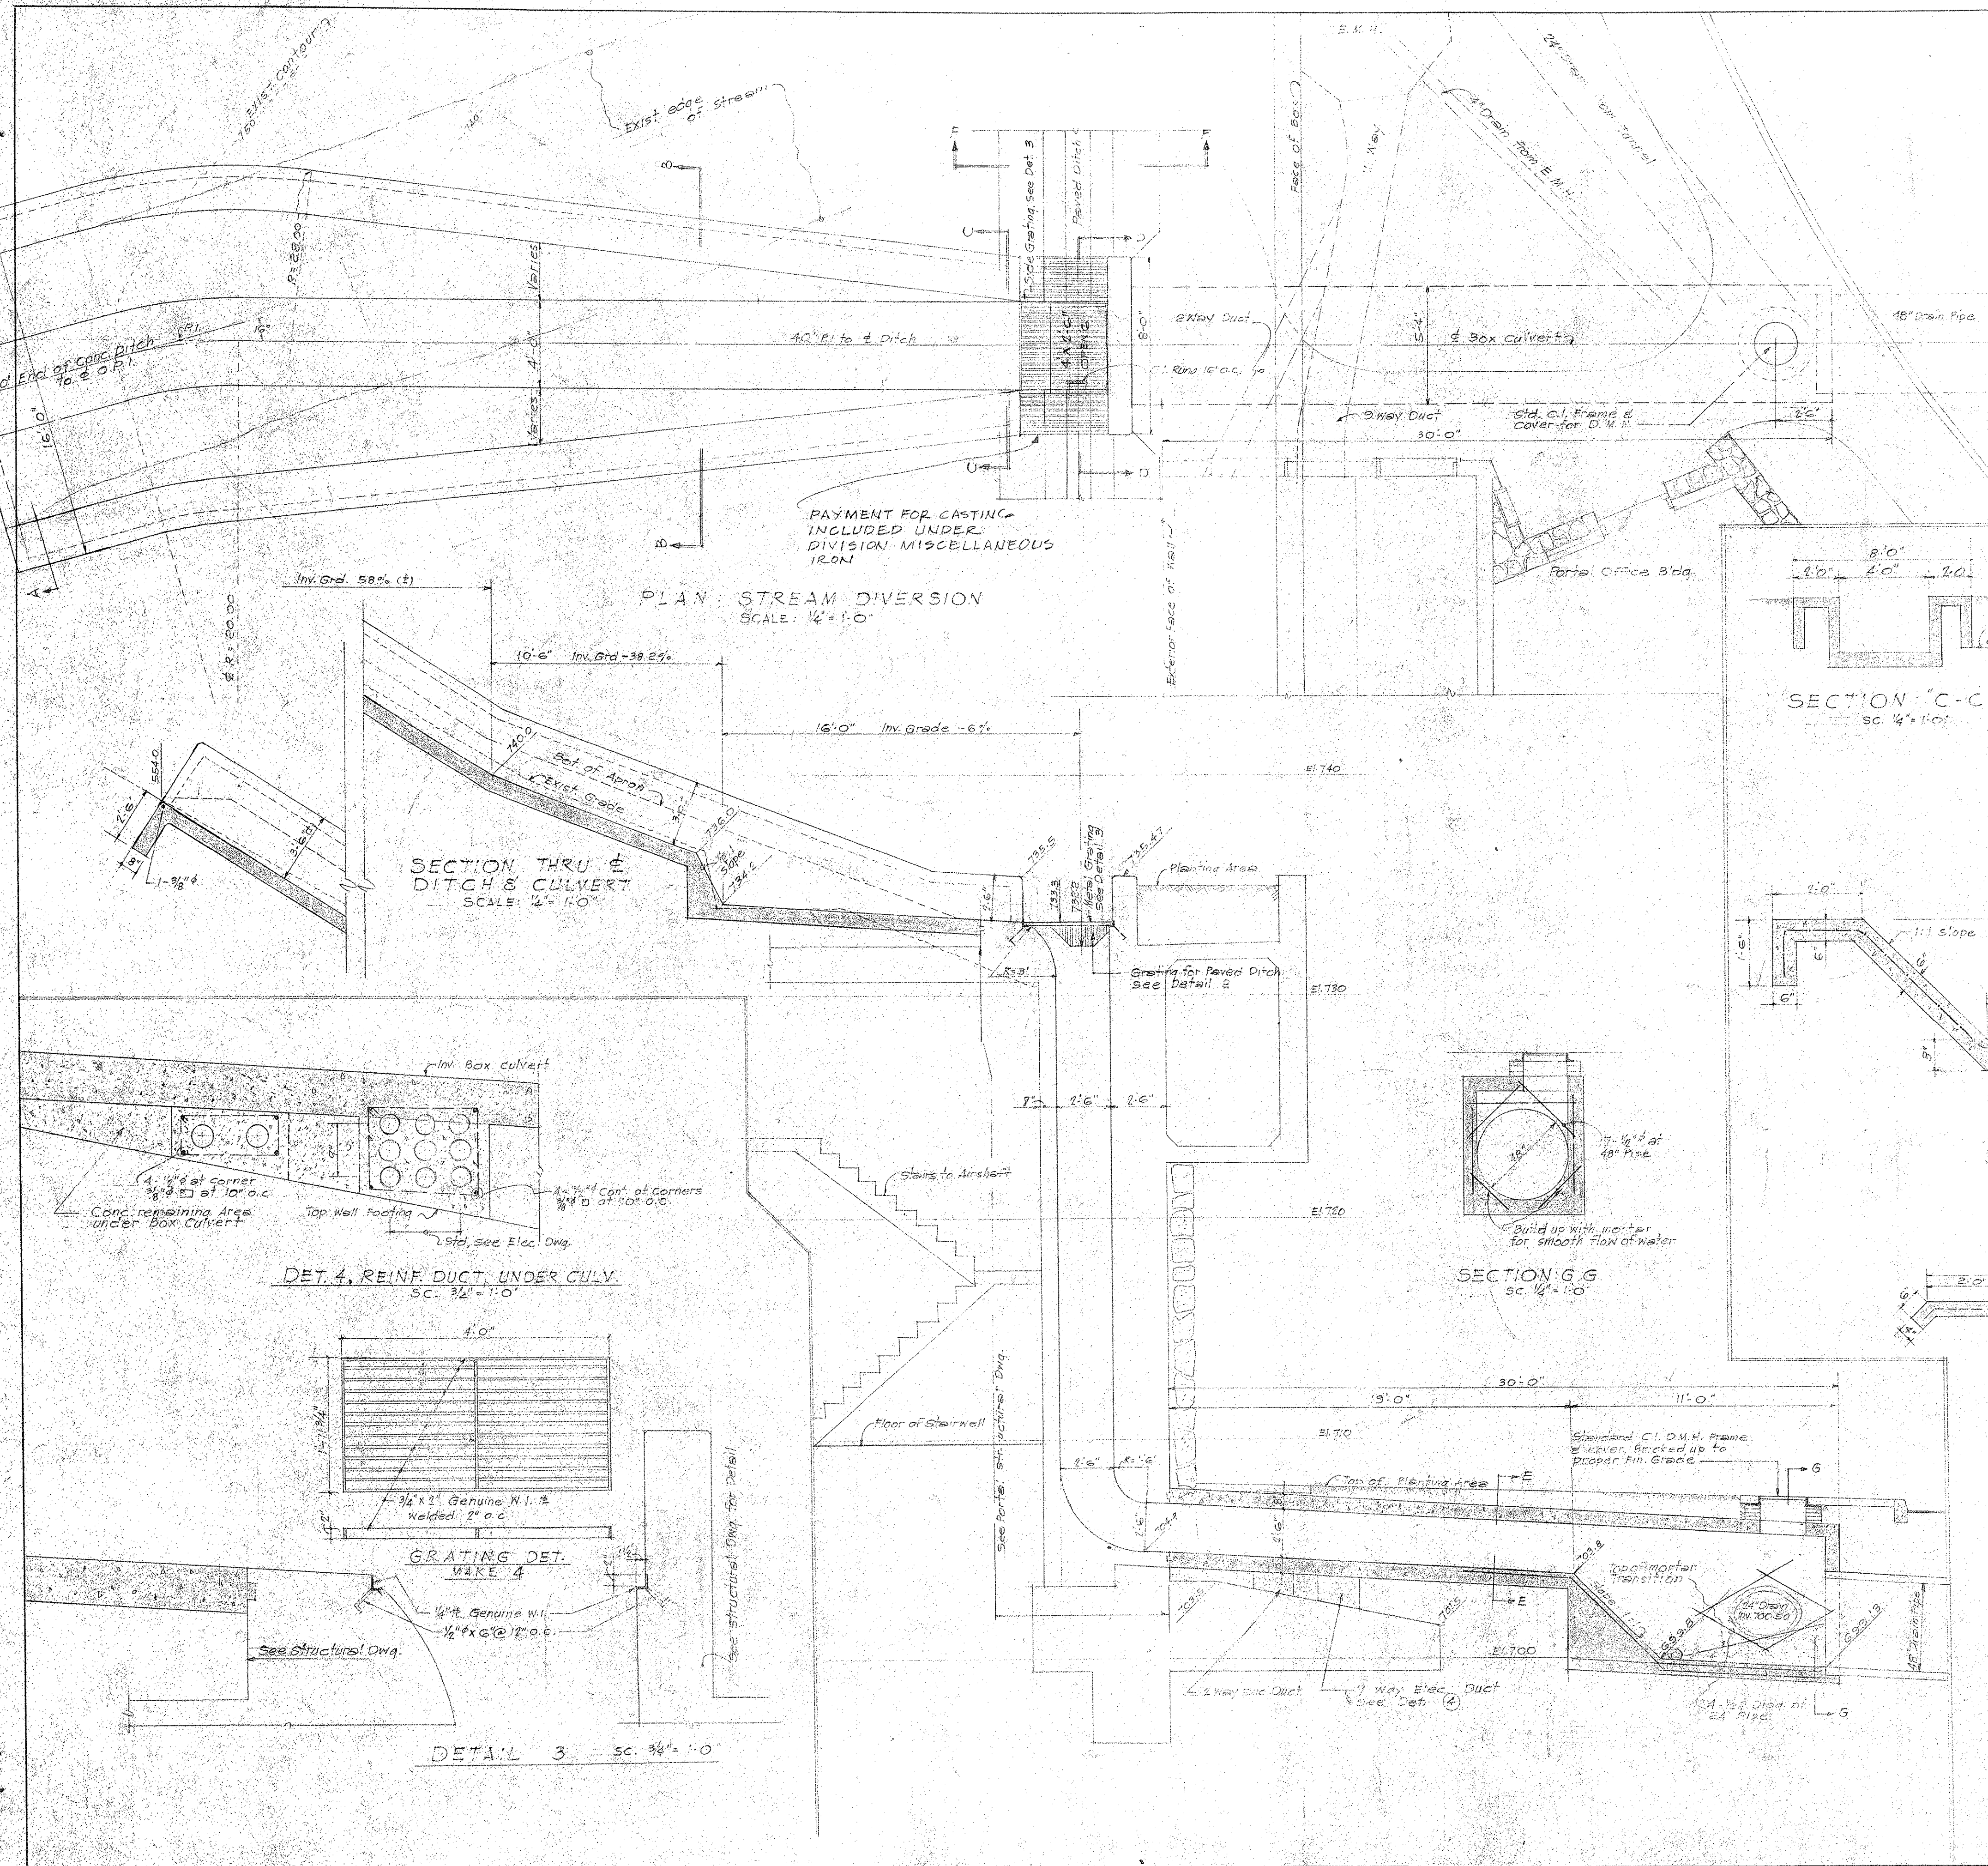

LAW & WILSON
ARCHITECTS & ENGINEERS
DEPARTMENT OF PUBLIC WORKS
CITY AND COUNTY OF HONOLULU
BUREAU OF PLANS
KALIHI TUNNEL
KANEOHE PORTAL
DRAINS ABOVE PORTAL WALL

ENGINEER: I. A. W. DATE: JULY 5 1953
DRAFTSMAN: H. T. CHECKED BY: W. G. [Signature]
SCALE: AS NOTED TRACER: [Signature]
APPROVED: [Signature] APPROVED: [Signature]
CHIEF ENGINEER BUREAU ENGINEER

APPROVED:
749 Linden
ENGINEER KATHI TUNN

W. S.	PROFILE	C. B.
CR. SEC.	F. B.	S. B.

SECTION C JOB NO. 26-53 DWG. P-52

Sheet No. 174 of 252 Sheets

FILE	POCKET	FOLDER	NO.
1	6	1	52