


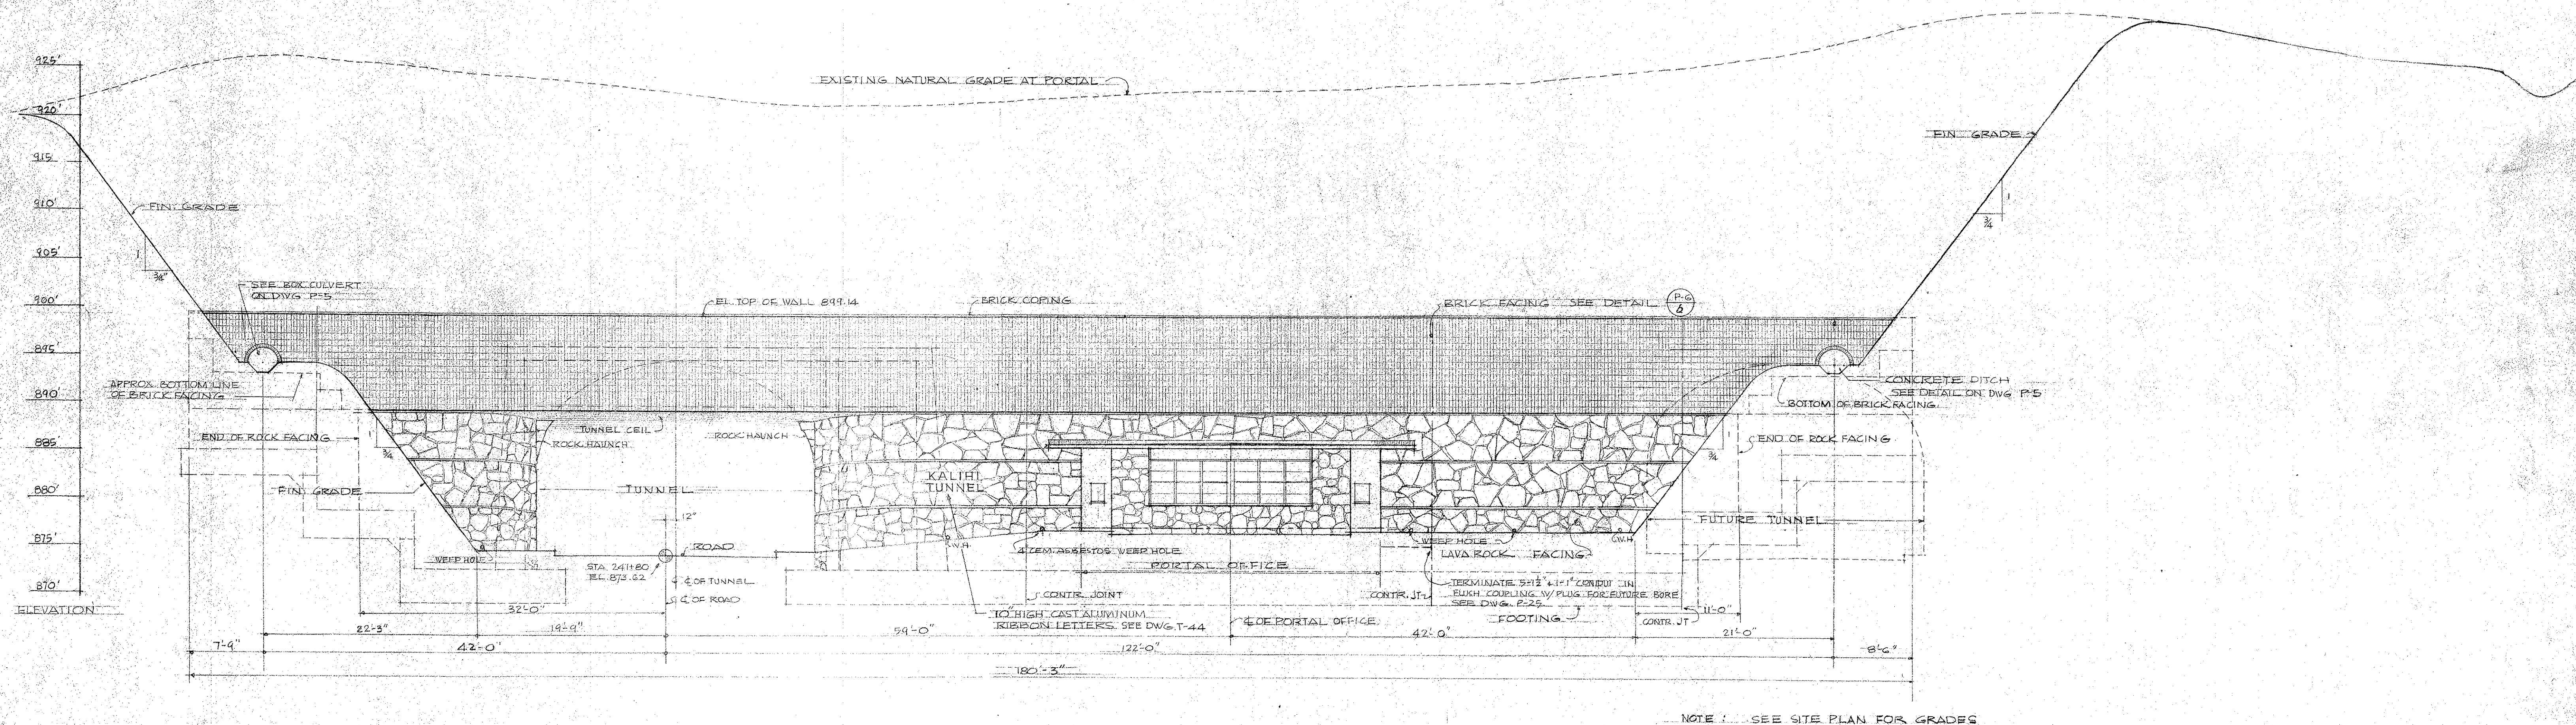

KALIHI PORTAL ELEVATION SCALE 1/8" = 1'-0"

PERMIT NO. 0-96-36
WILSON TUNNEL CELLULAR PHONE SITES
(REFER TO PERMIT PLAN FOR DETAILS)
COMP: 04/04/97

LAW & WILSON ARCHITECTS & ENGINEERS			
DEPARTMENT OF PUBLIC WORKS CITY AND COUNTY OF HONOLULU			
BUREAU OF PLANS			
KALIHI TUNNEL			
KALIHI PORTAL ELEVATION			
ENGINEER: L. B. W.	DATE: JULY 15, 1983		
DRAFTSMAN: T. FURUDERA	CHECKED BY: <i>[Signature]</i>		
SCALE: 1/8" = 1'-0"	TRACER:		
APPROVED: <i>[Signature]</i>	APPROVED: <i>[Signature]</i>		
CHIEF ENGINEER	BUREAU ENGINEER		
W. B.	PROFILE	C. B.	
CR. REC.	P. B.	S. P.	
W. M. BY:	P. W. BY:	S. BY:	

APPROVED
[Signature]
ENGINEER, KALIHI TUNNEL

SECTION C JOB NO. 26-53 DWG. P-4