


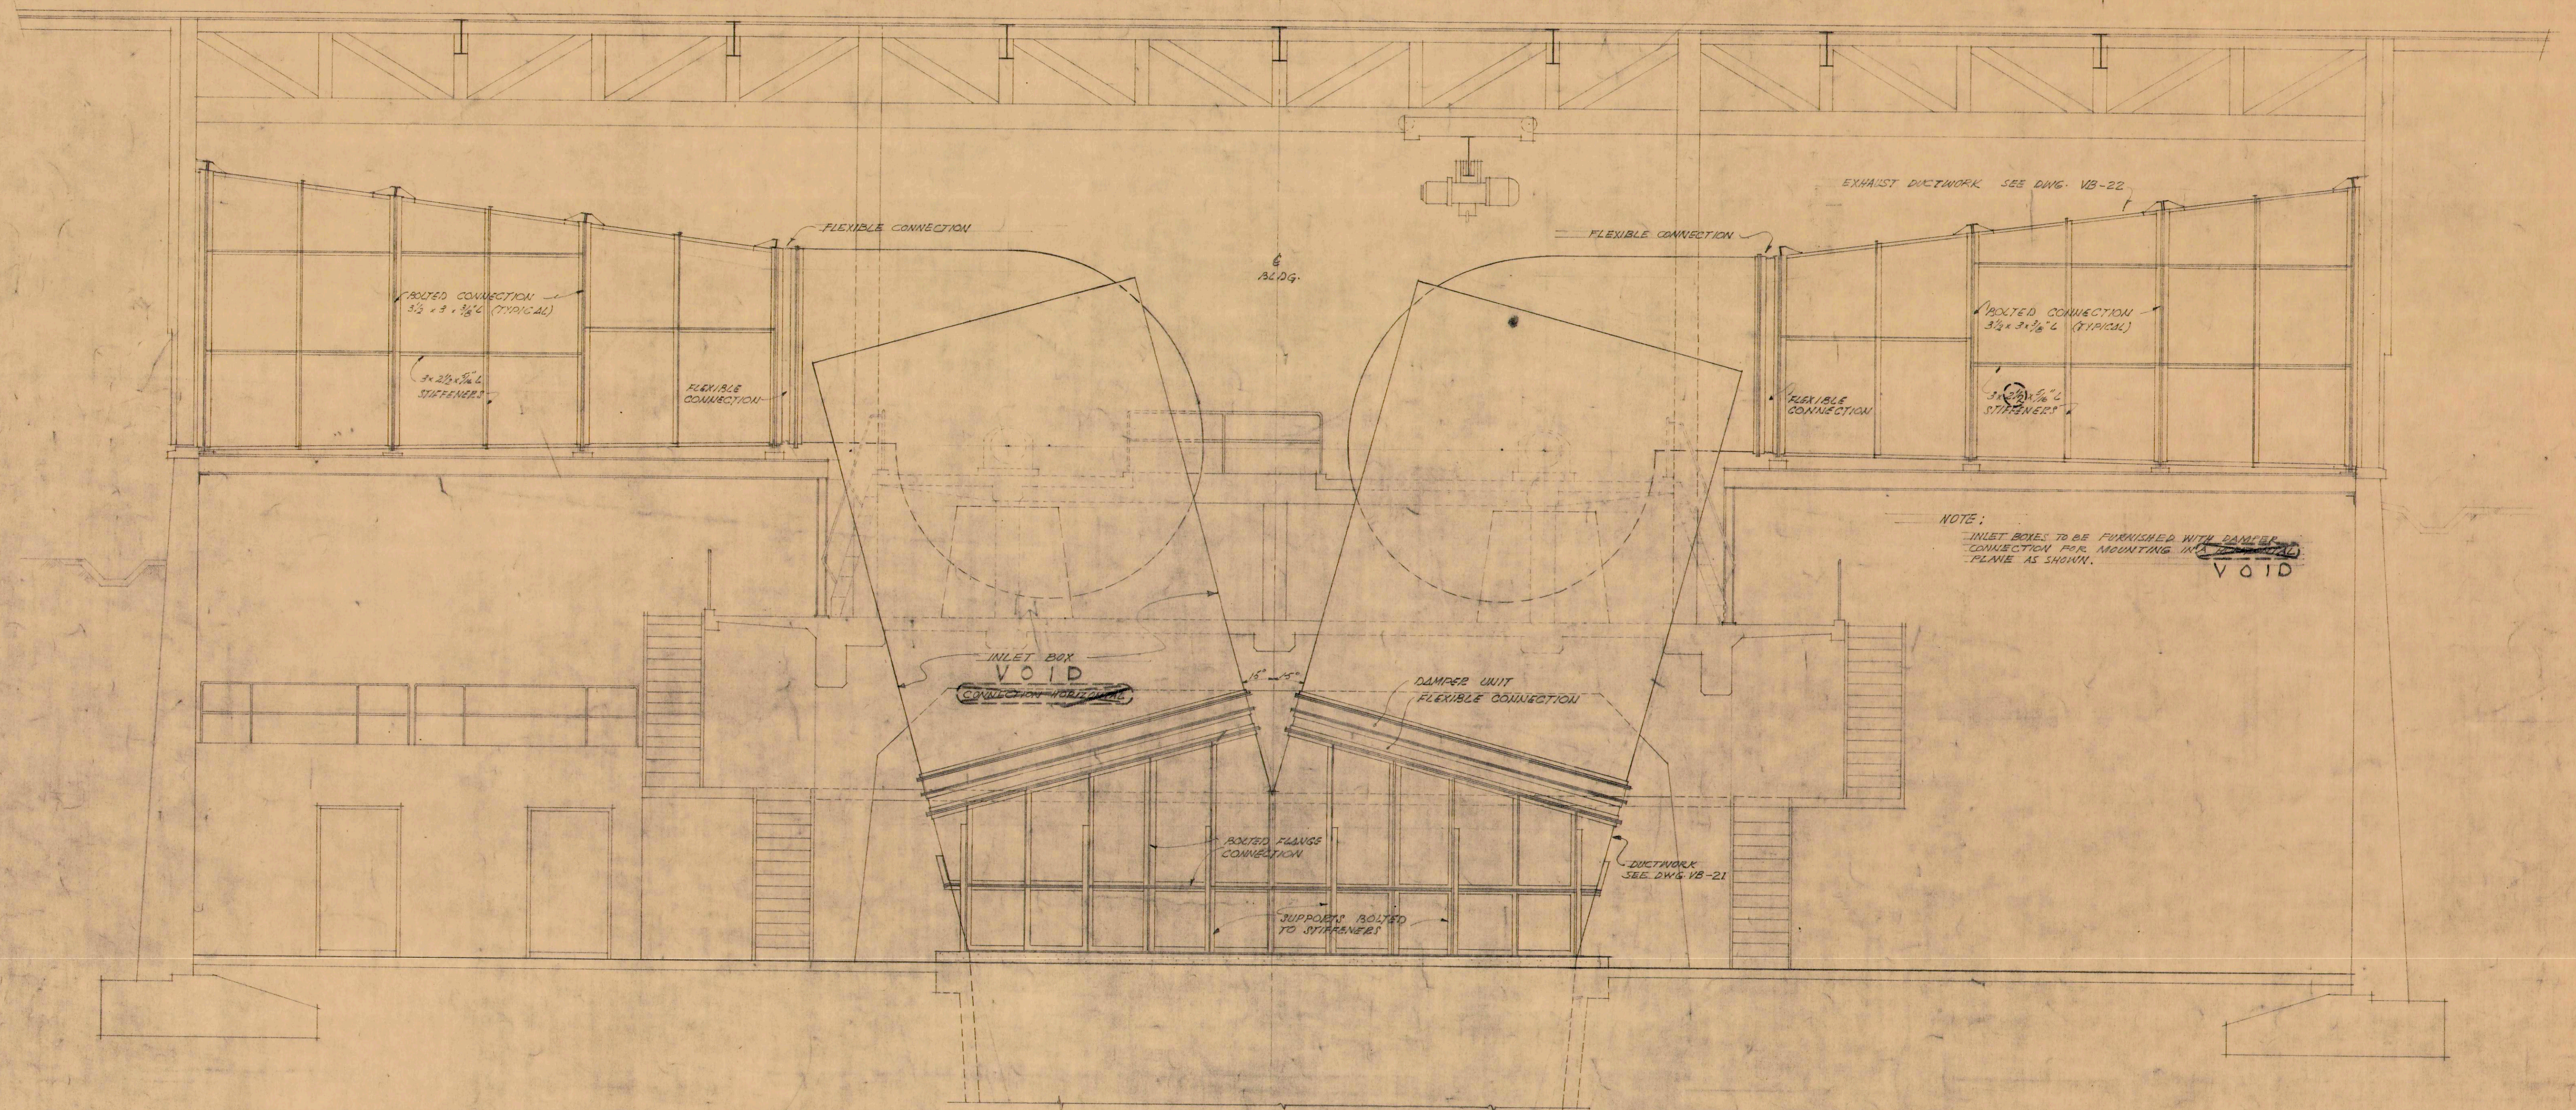

ELEVATION OF KANEHOE FANS -(KALIHI FANS SIMILAR)

1	4-16-56	RELOCATED OPENINGS & EQUIPMENT	E.V.	70
REVISION	DATE	DESCRIPTION	MADE BY	CHK. BY

LAW & WILSON
 ARCHITECTS & ENGINEERS
 DEPARTMENT OF PUBLIC WORKS
 CITY AND COUNTY OF HONOLULU
 BUREAU OF PLANS
KALIHI TUNNEL
 VENTILATION BLDG.
 ELEVATION OF VENTILATION FANS

ENGINEER L & W	DATE JULY 16, 1953
DRAFTSMAN R. B.	CHECKED BY R. B.
SCALE 1/4" = 1'-0"	TRACER
APPROVED: <i>[Signature]</i> CHIEF ENGINEER	APPROVED: <i>[Signature]</i> BUREAU ENGINEER

W.S.	PROFILE	C.B.
CR. SEC.	P.B.	S.B.
W.M. BY	P.W. BY	S.B.Y.

SECTION C JOB NO. 26-53 DWG. VB-48