



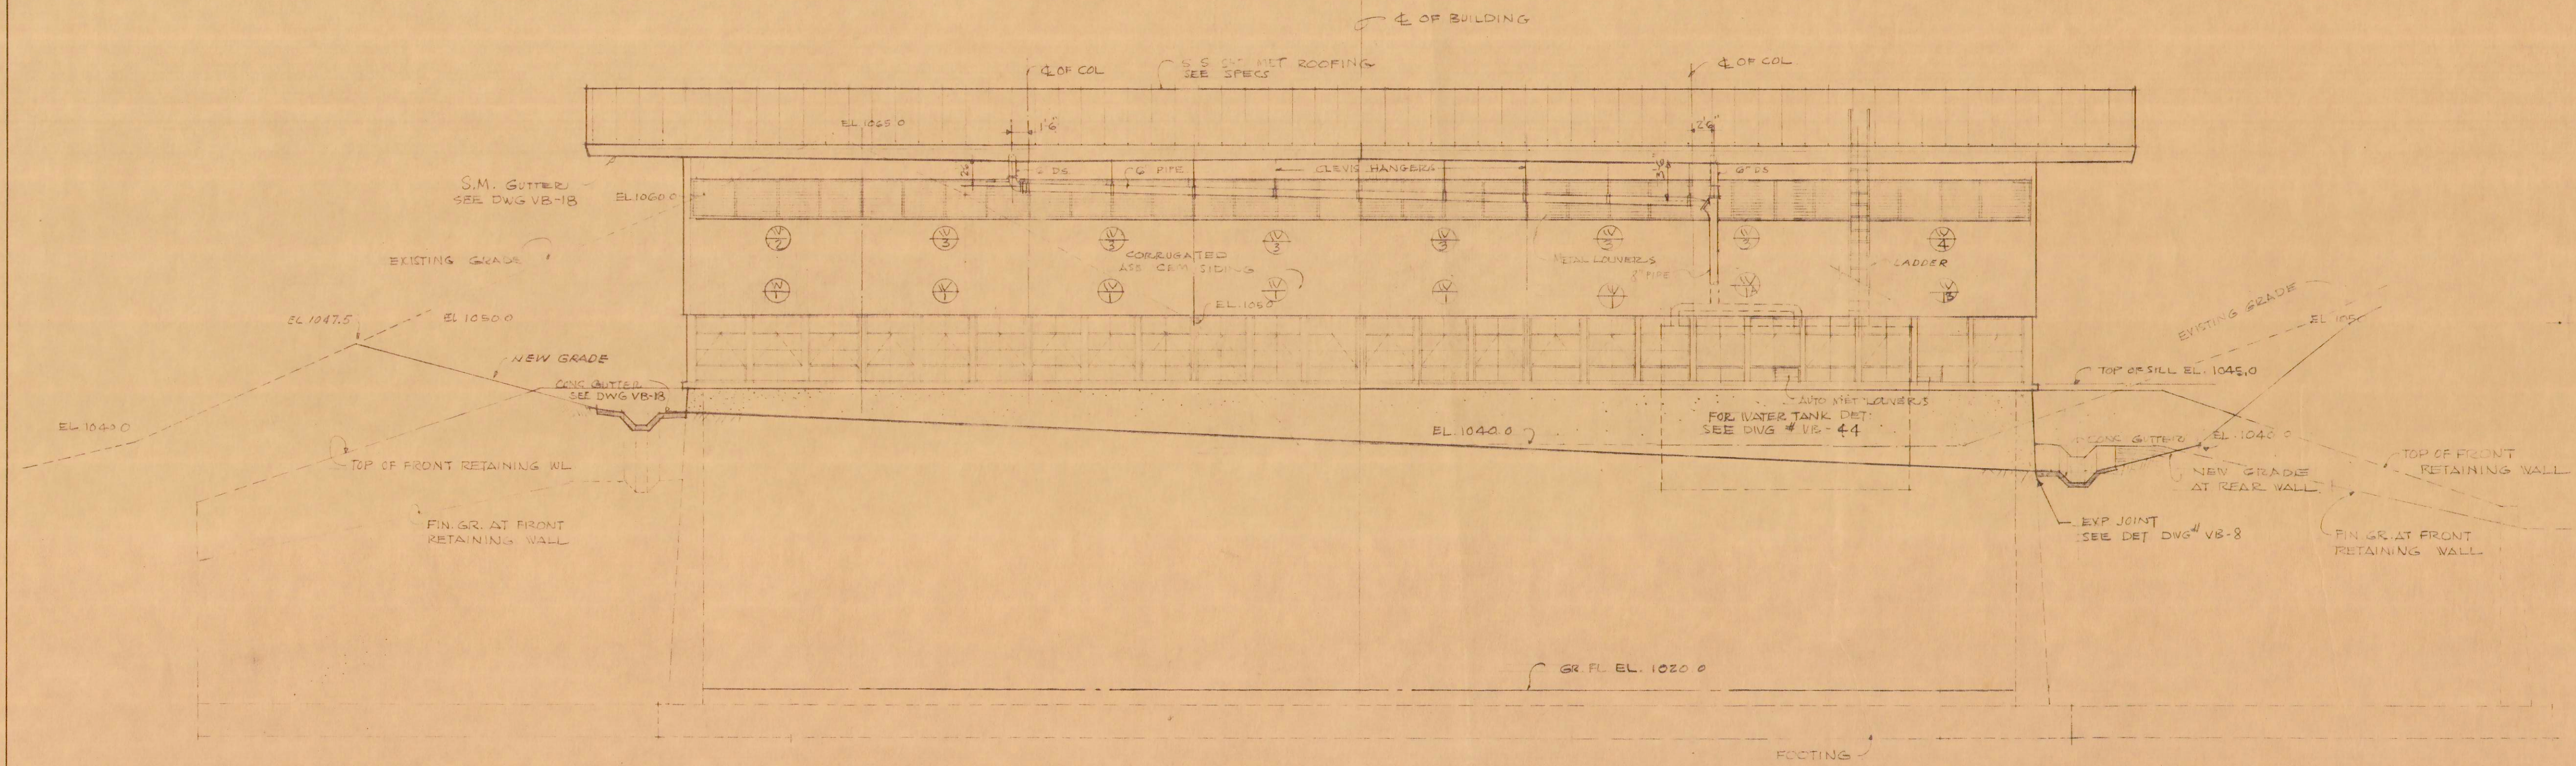

REAR ELEVATION


SCALE: 1/8" = 1'-0"

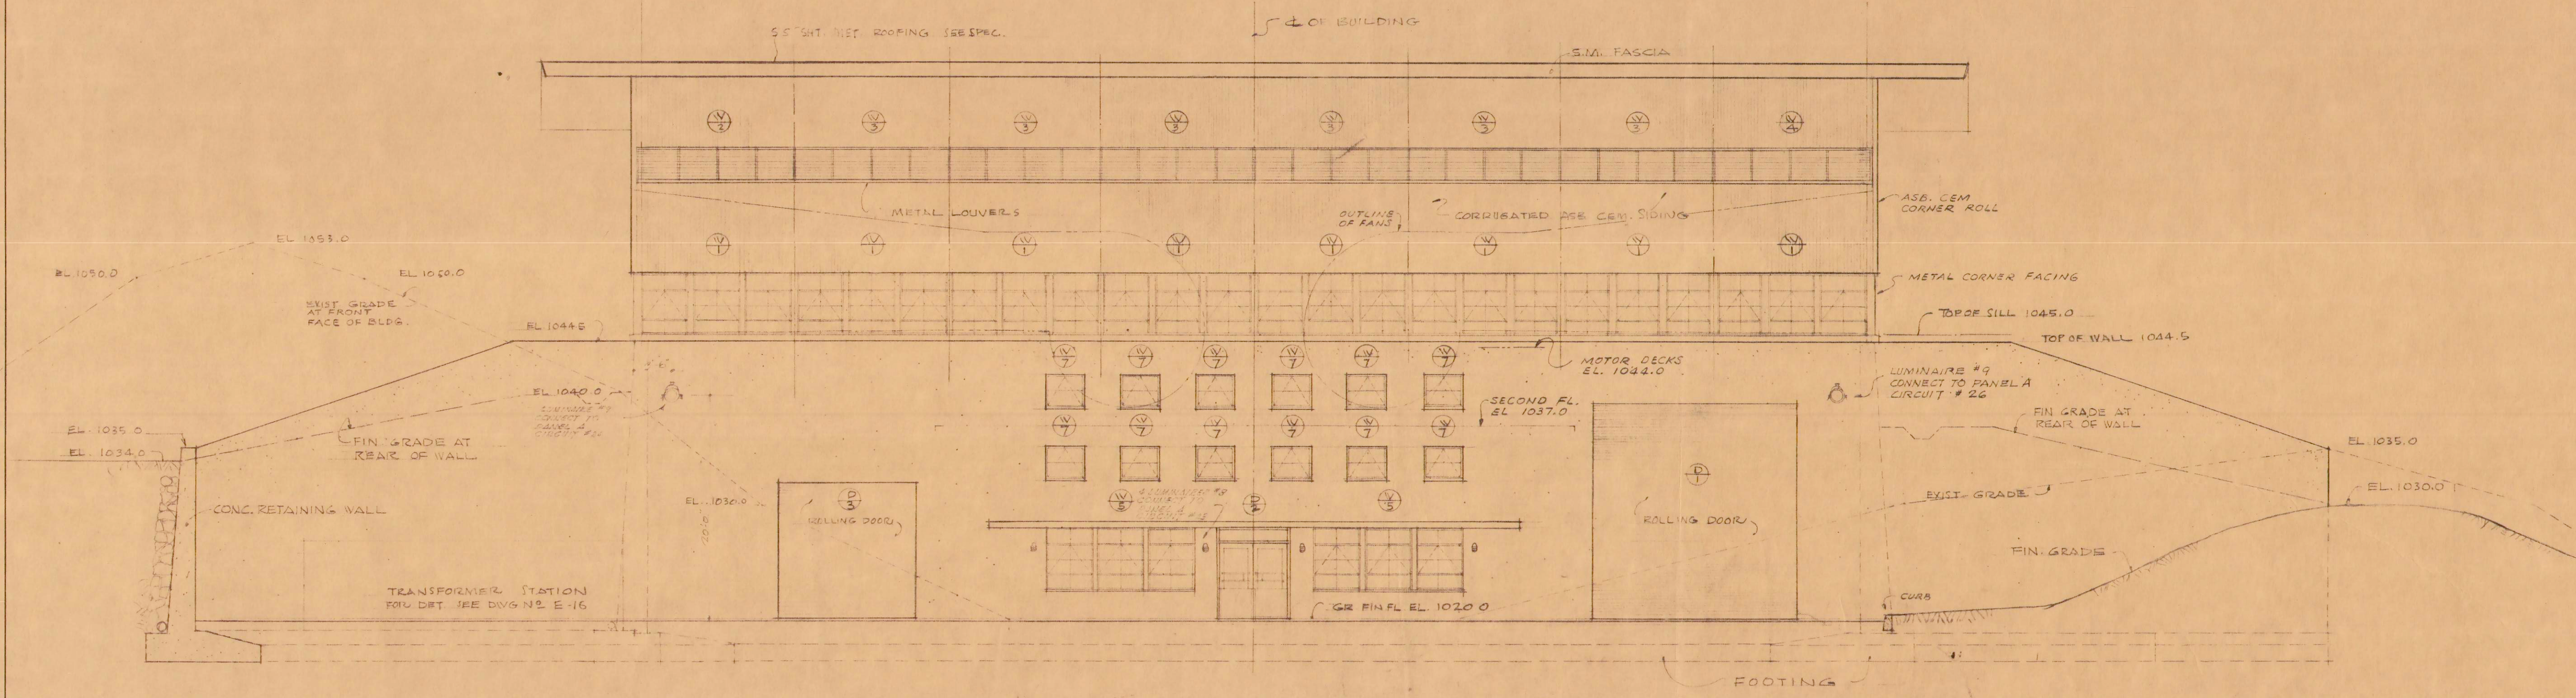


FRONT ELEVATION

SCALE: 1/8" = 1'-0"

LAW & WILSON ARCHITECTS & ENGINEERS CITY AND COUNTY OF HONOLULU			
DEPARTMENT OF PUBLIC WORKS BUREAU OF PLANS			
KALIHI TUNNEL VENTILATION BLDG. ELEVATIONS			
ENGINEER: L. A. W.	DATE: JULY 15, 1953	CHECKED BY: R. B. [Signature]	
DRAFTSMAN: P. K.	SCALE: 1/8" = 1'-0"	TRACER: [Signature]	
APPROVED: [Signature] CHIEF ENGINEER		APPROVED: [Signature] BUREAU ENGINEER	
W. S.	PROFILE	C. B.	
CR. SEC.	P. B.	S. S.	
W. M. BY:	F. W. BY:	S. BY:	

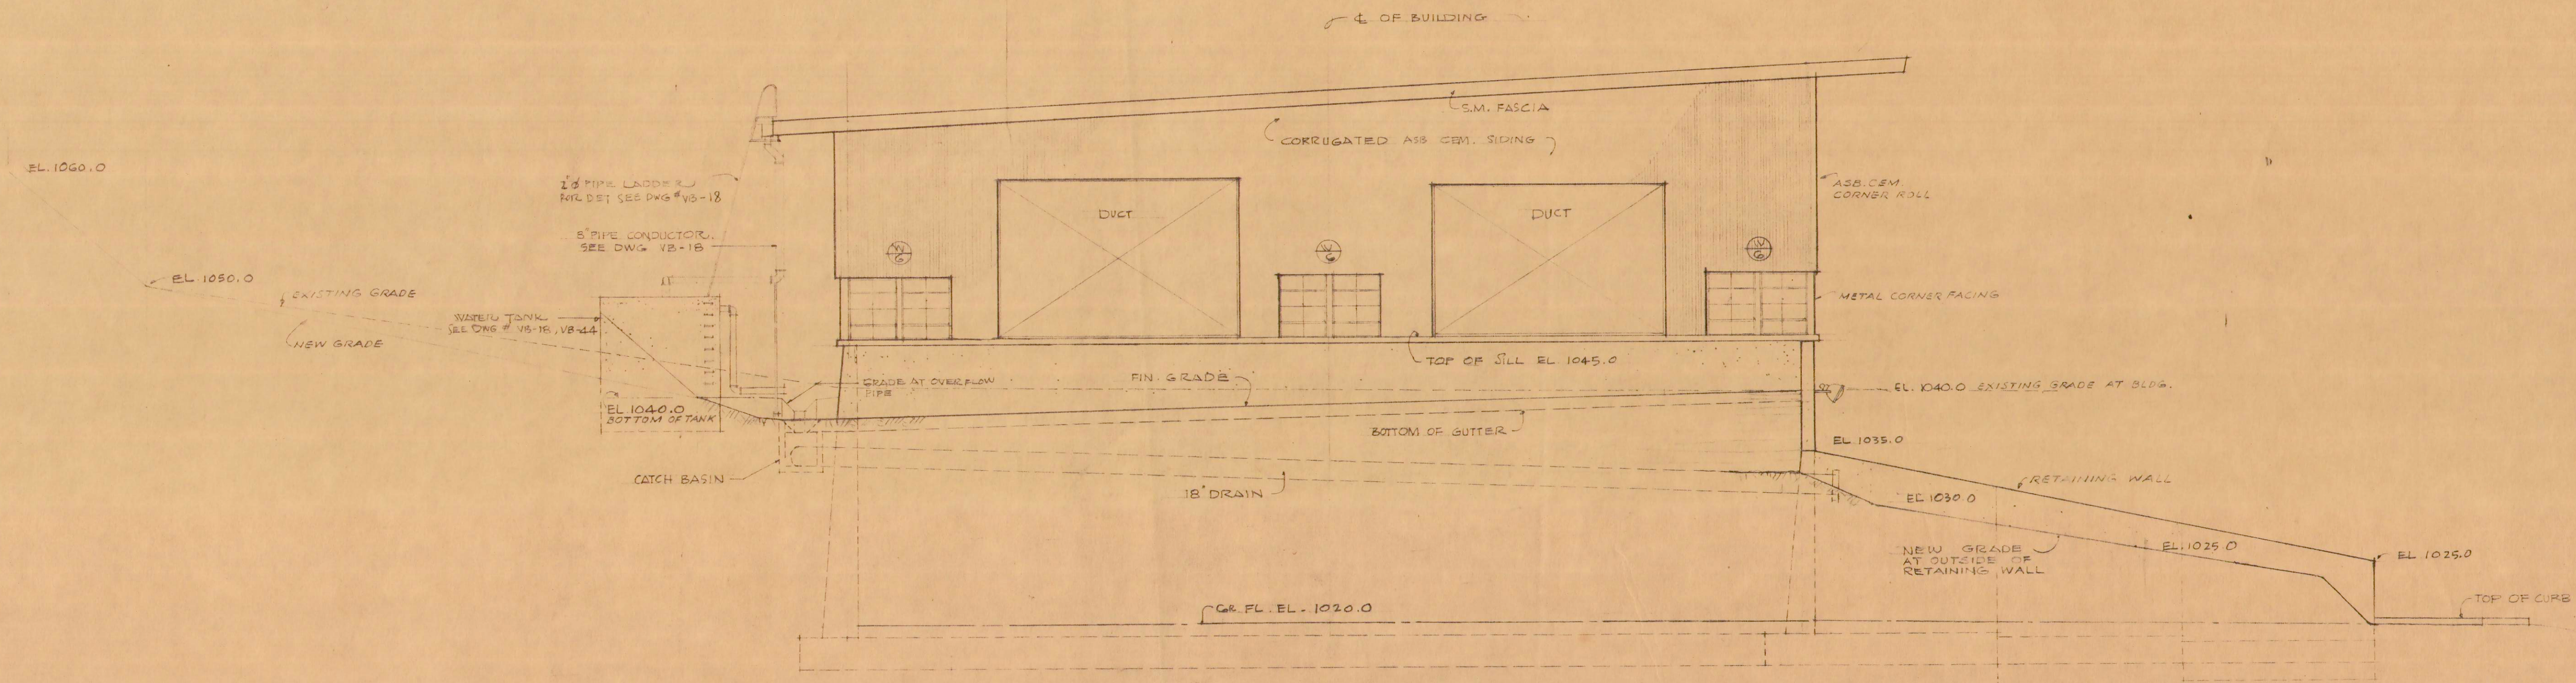

LEFT SIDE ELEVATION
SCALE: 1/8" = 1'-0"

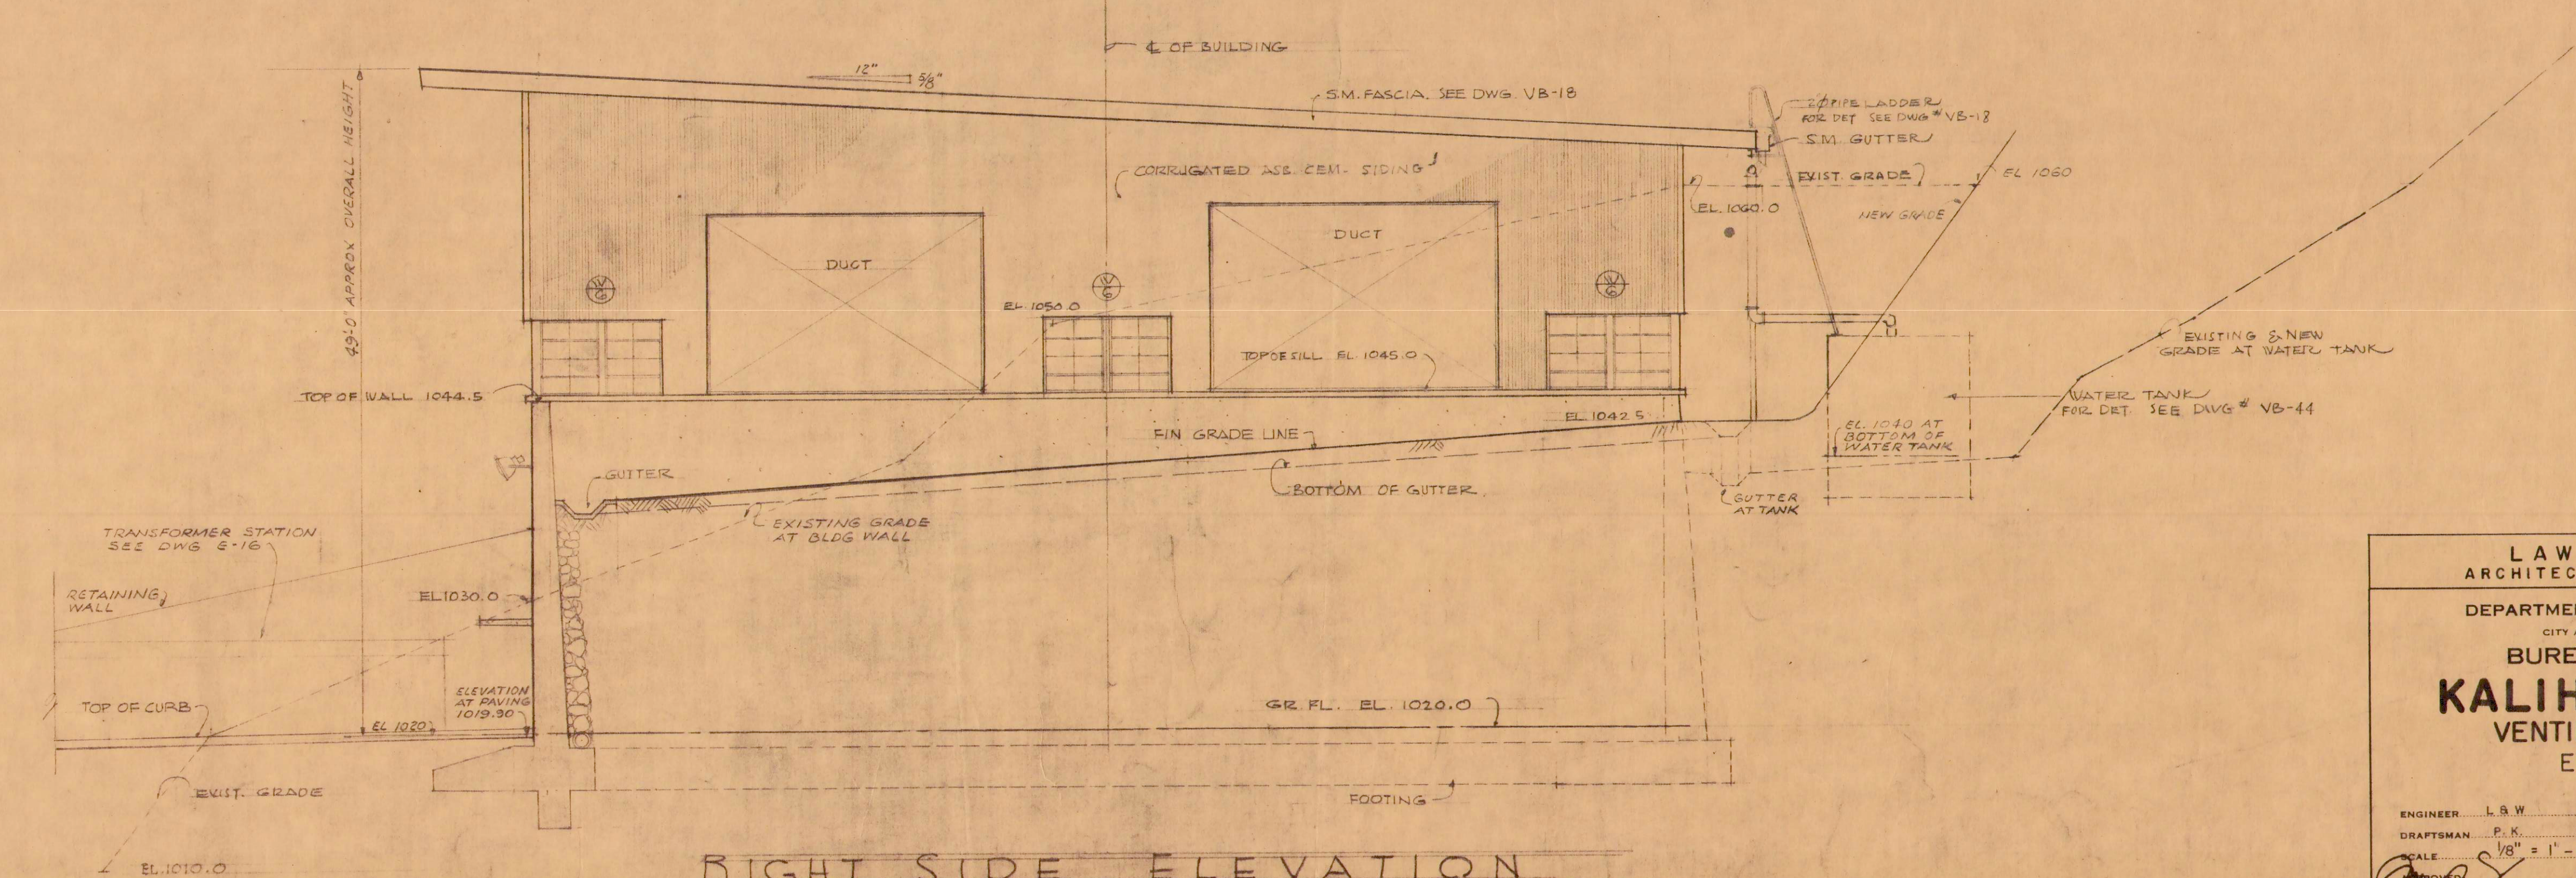

RIGHT SIDE ELEVATION
SCALE: 1/8" = 1'-0"

LAW & WILSON ARCHITECTS & ENGINEERS			
DEPARTMENT OF PUBLIC WORKS CITY AND COUNTY OF HONOLULU			
BUREAU OF PLANS			
KALIHI TUNNEL			
VENTILATION BLDG.			
ELEVATIONS			
ENGINEER: L.W.	DATE: JULY 15, 1953		
DRAFTSMAN: P.K.	CHECKED BY: R.B.		
SCALE: 1/8" = 1'-0"	TRACER:		
APPROVED: <i>[Signature]</i> CHIEF ENGINEER		APPROVED: <i>[Signature]</i> BUREAU ENGINEER	
W.S.	PROFILE	C.B.	
CR. SEC.	F.B.	S.B.	
W.M.B.Y.	F.W.B.Y.	S.B.Y.	

SECTION C JOB NO. 26-53 DWG. VB-7