
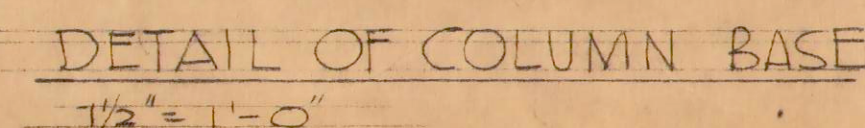
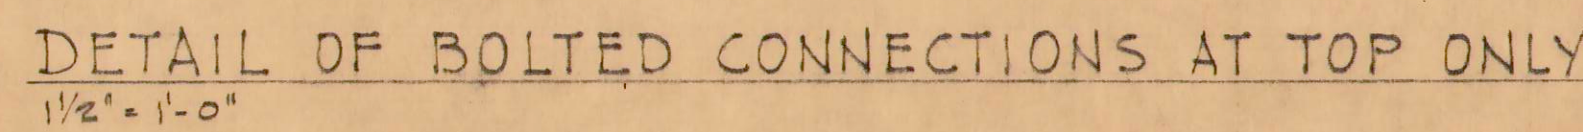
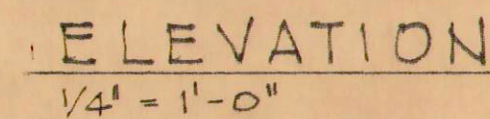
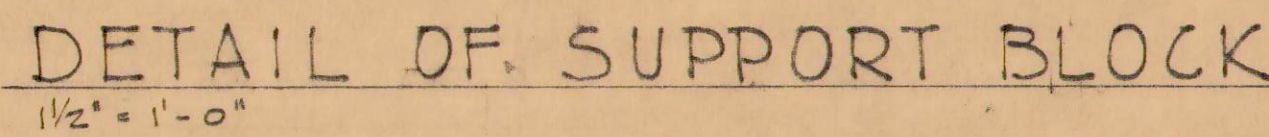


DIMENSION TABLE

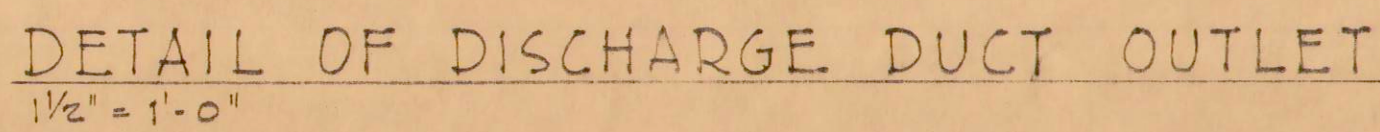

APPROVED:
K. K. McLean
ENGINEER, KALIHI TUNNE