




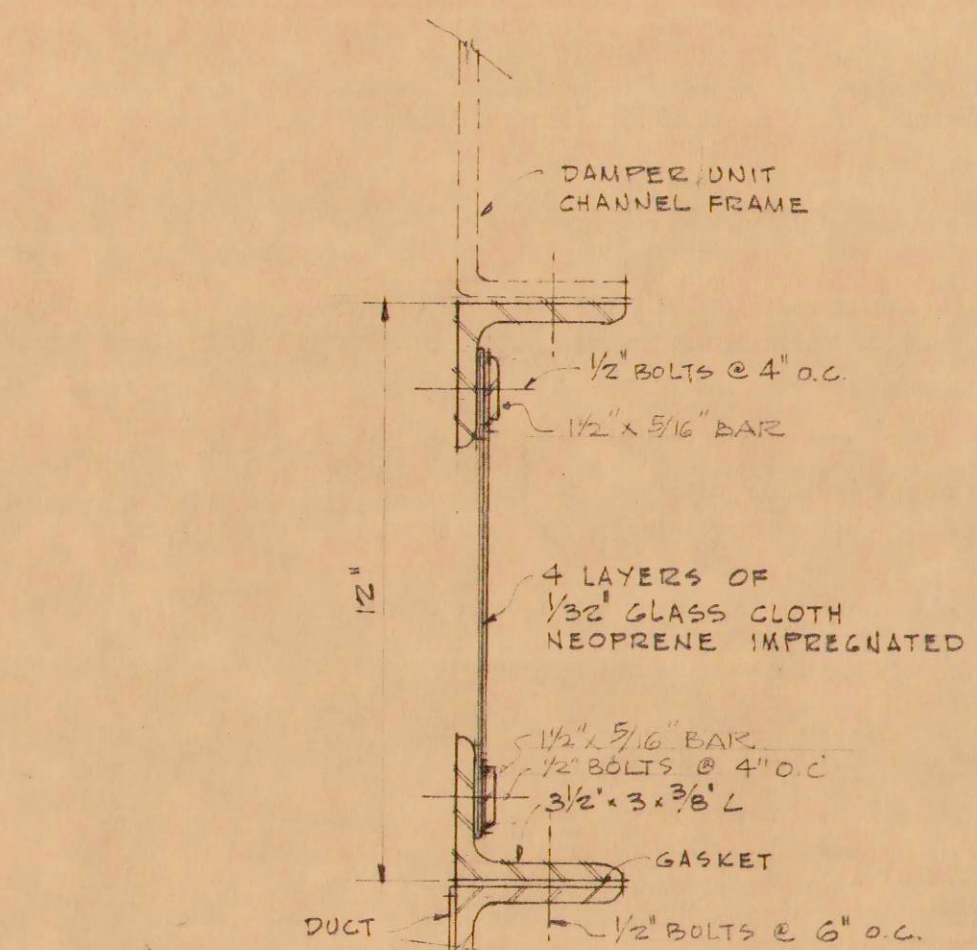


FLEXIBLE CONNECTION

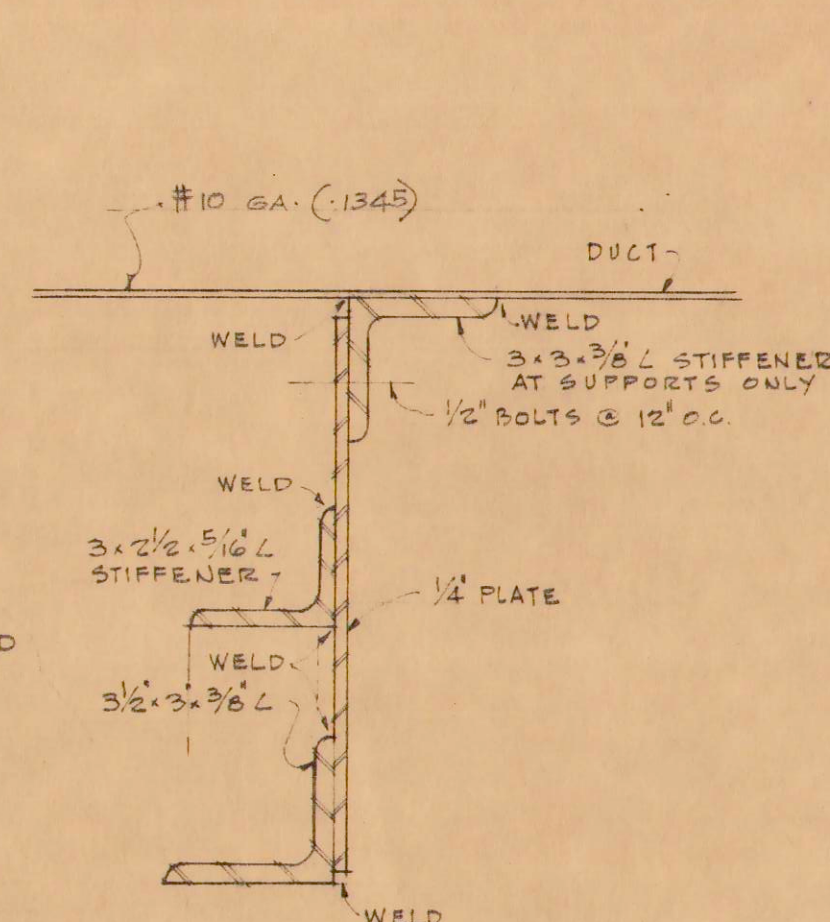


SECTION THRU SUPPORT

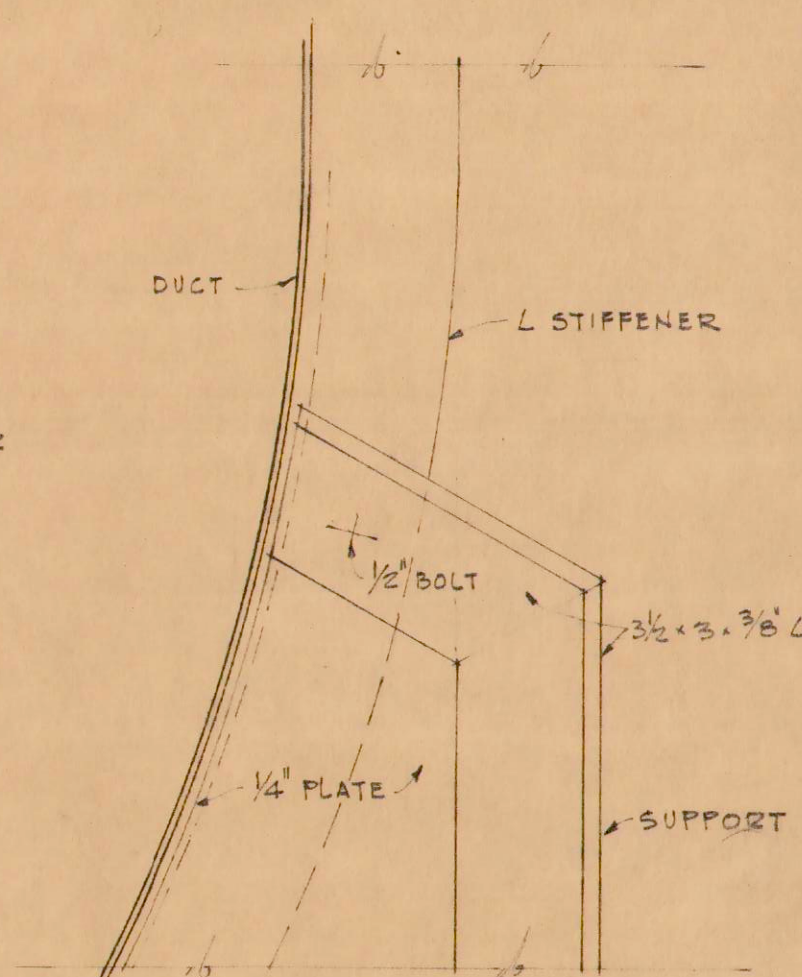


ELEVATION OF TOP OF SUPPORT

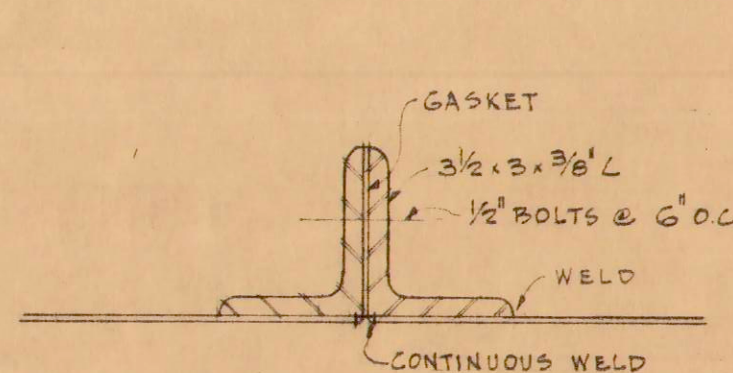


FLANGED CONNECTION

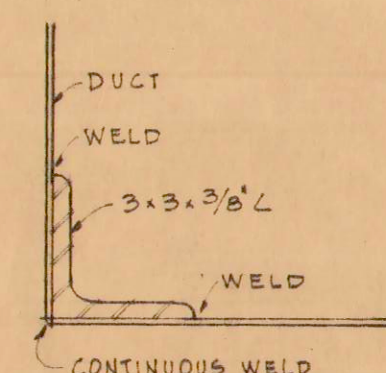

CORNER

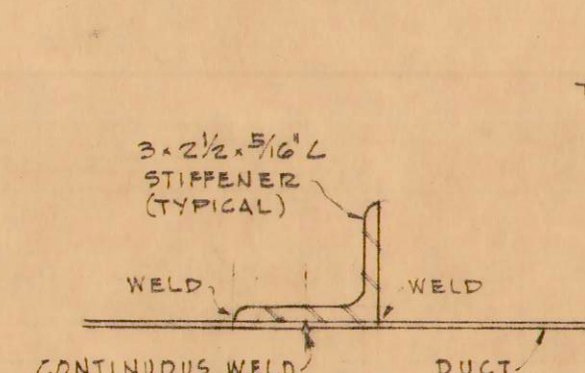


BUTT JOINT

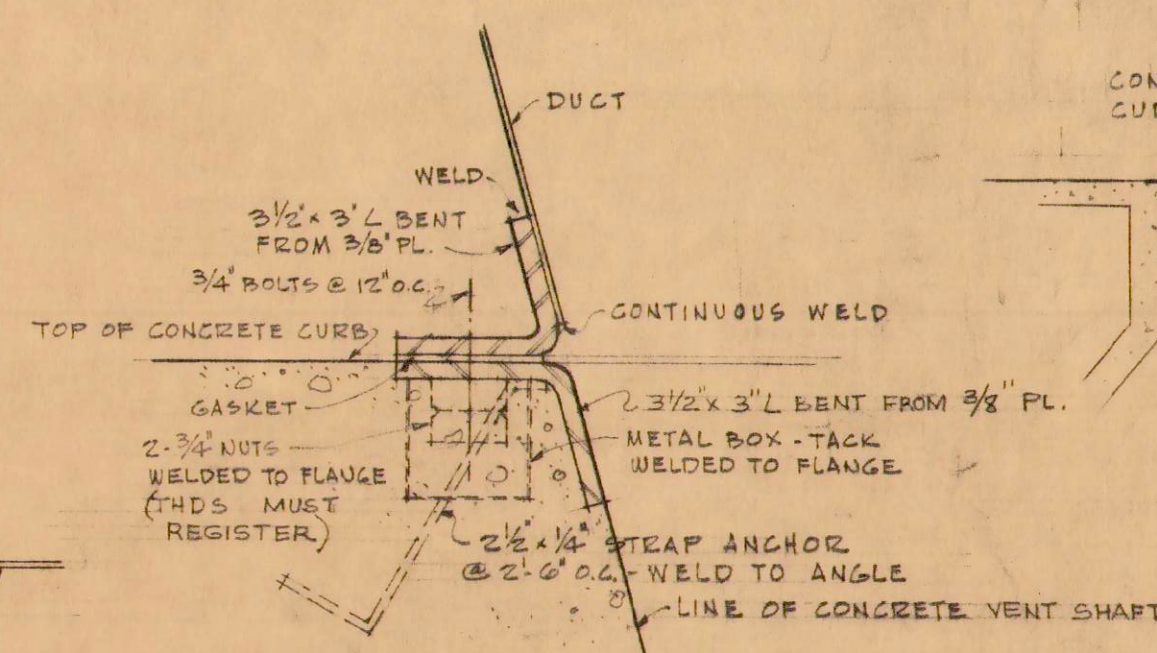


DUCT CONNECTION AT FLOOR

TYPICAL DUCT DETAILS
3' = 1'-0"

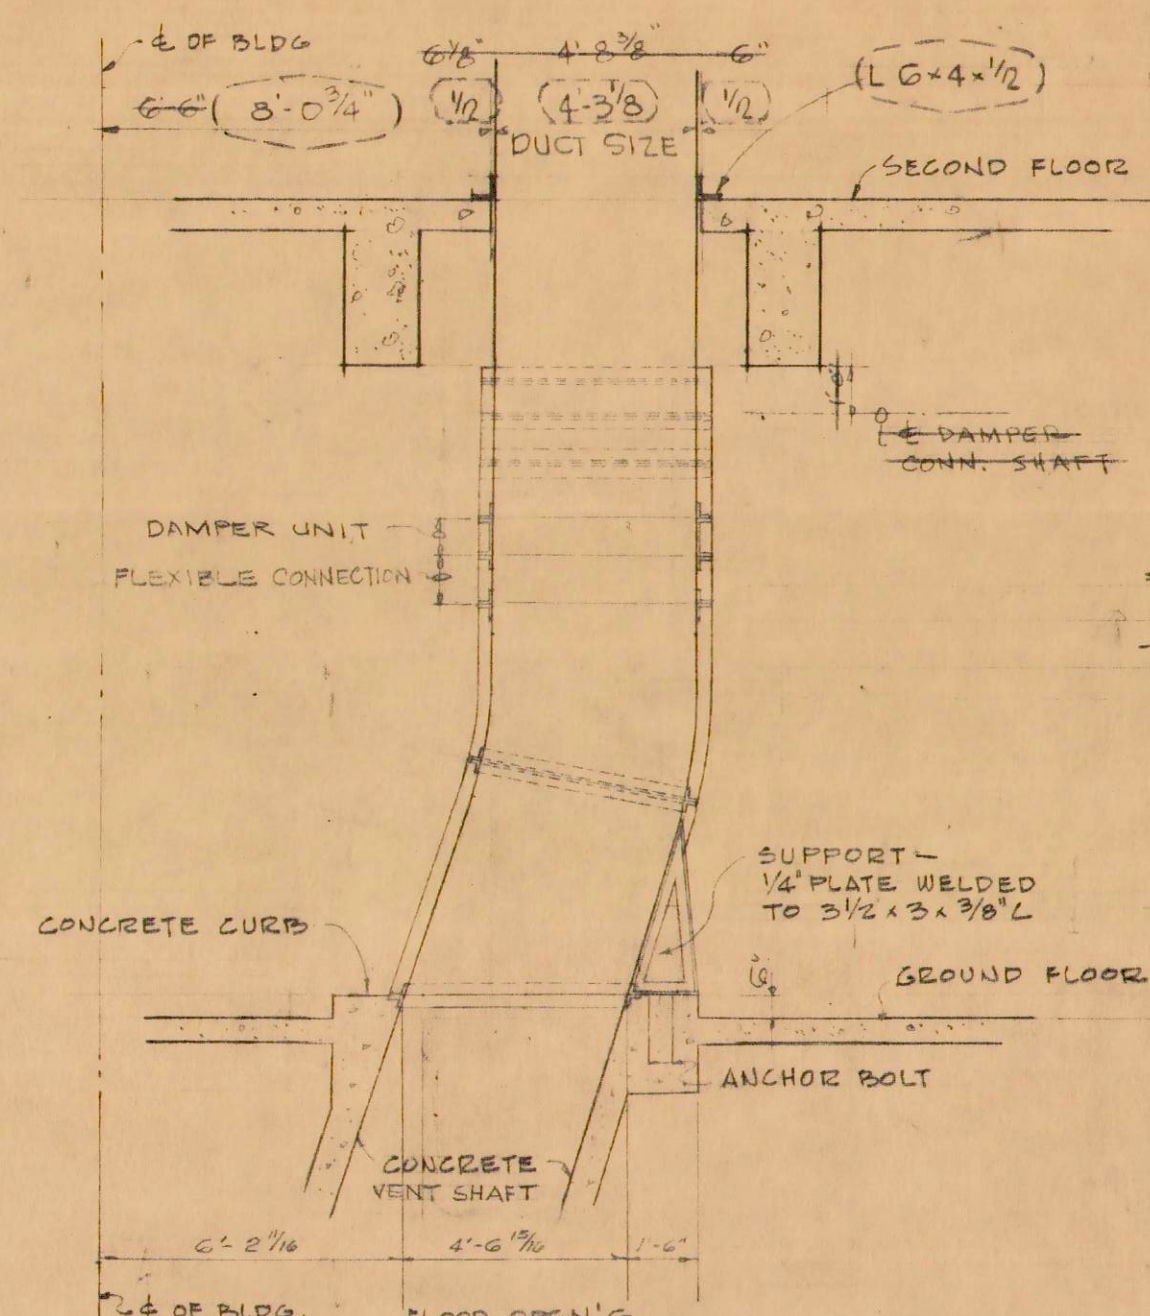


SECTION
1/4" = 1'-0"

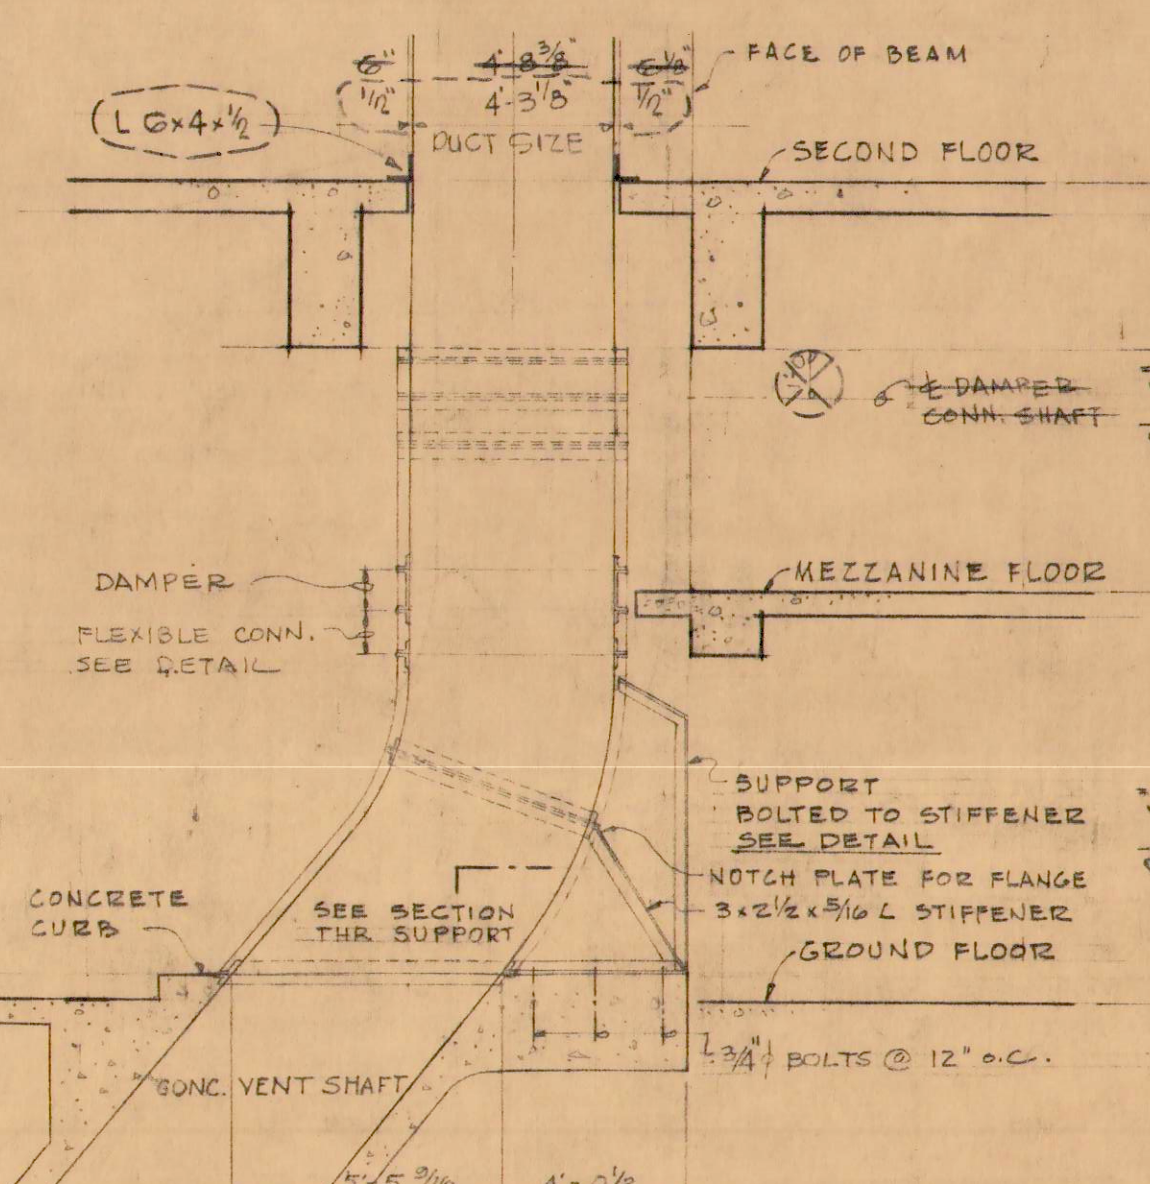


SECTION
1/4" = 1'-0"

NOTE

ACTUAL DIMENSIONS TO BE ADJUSTED TO FIT EQUIPMENT SUPPLIED.

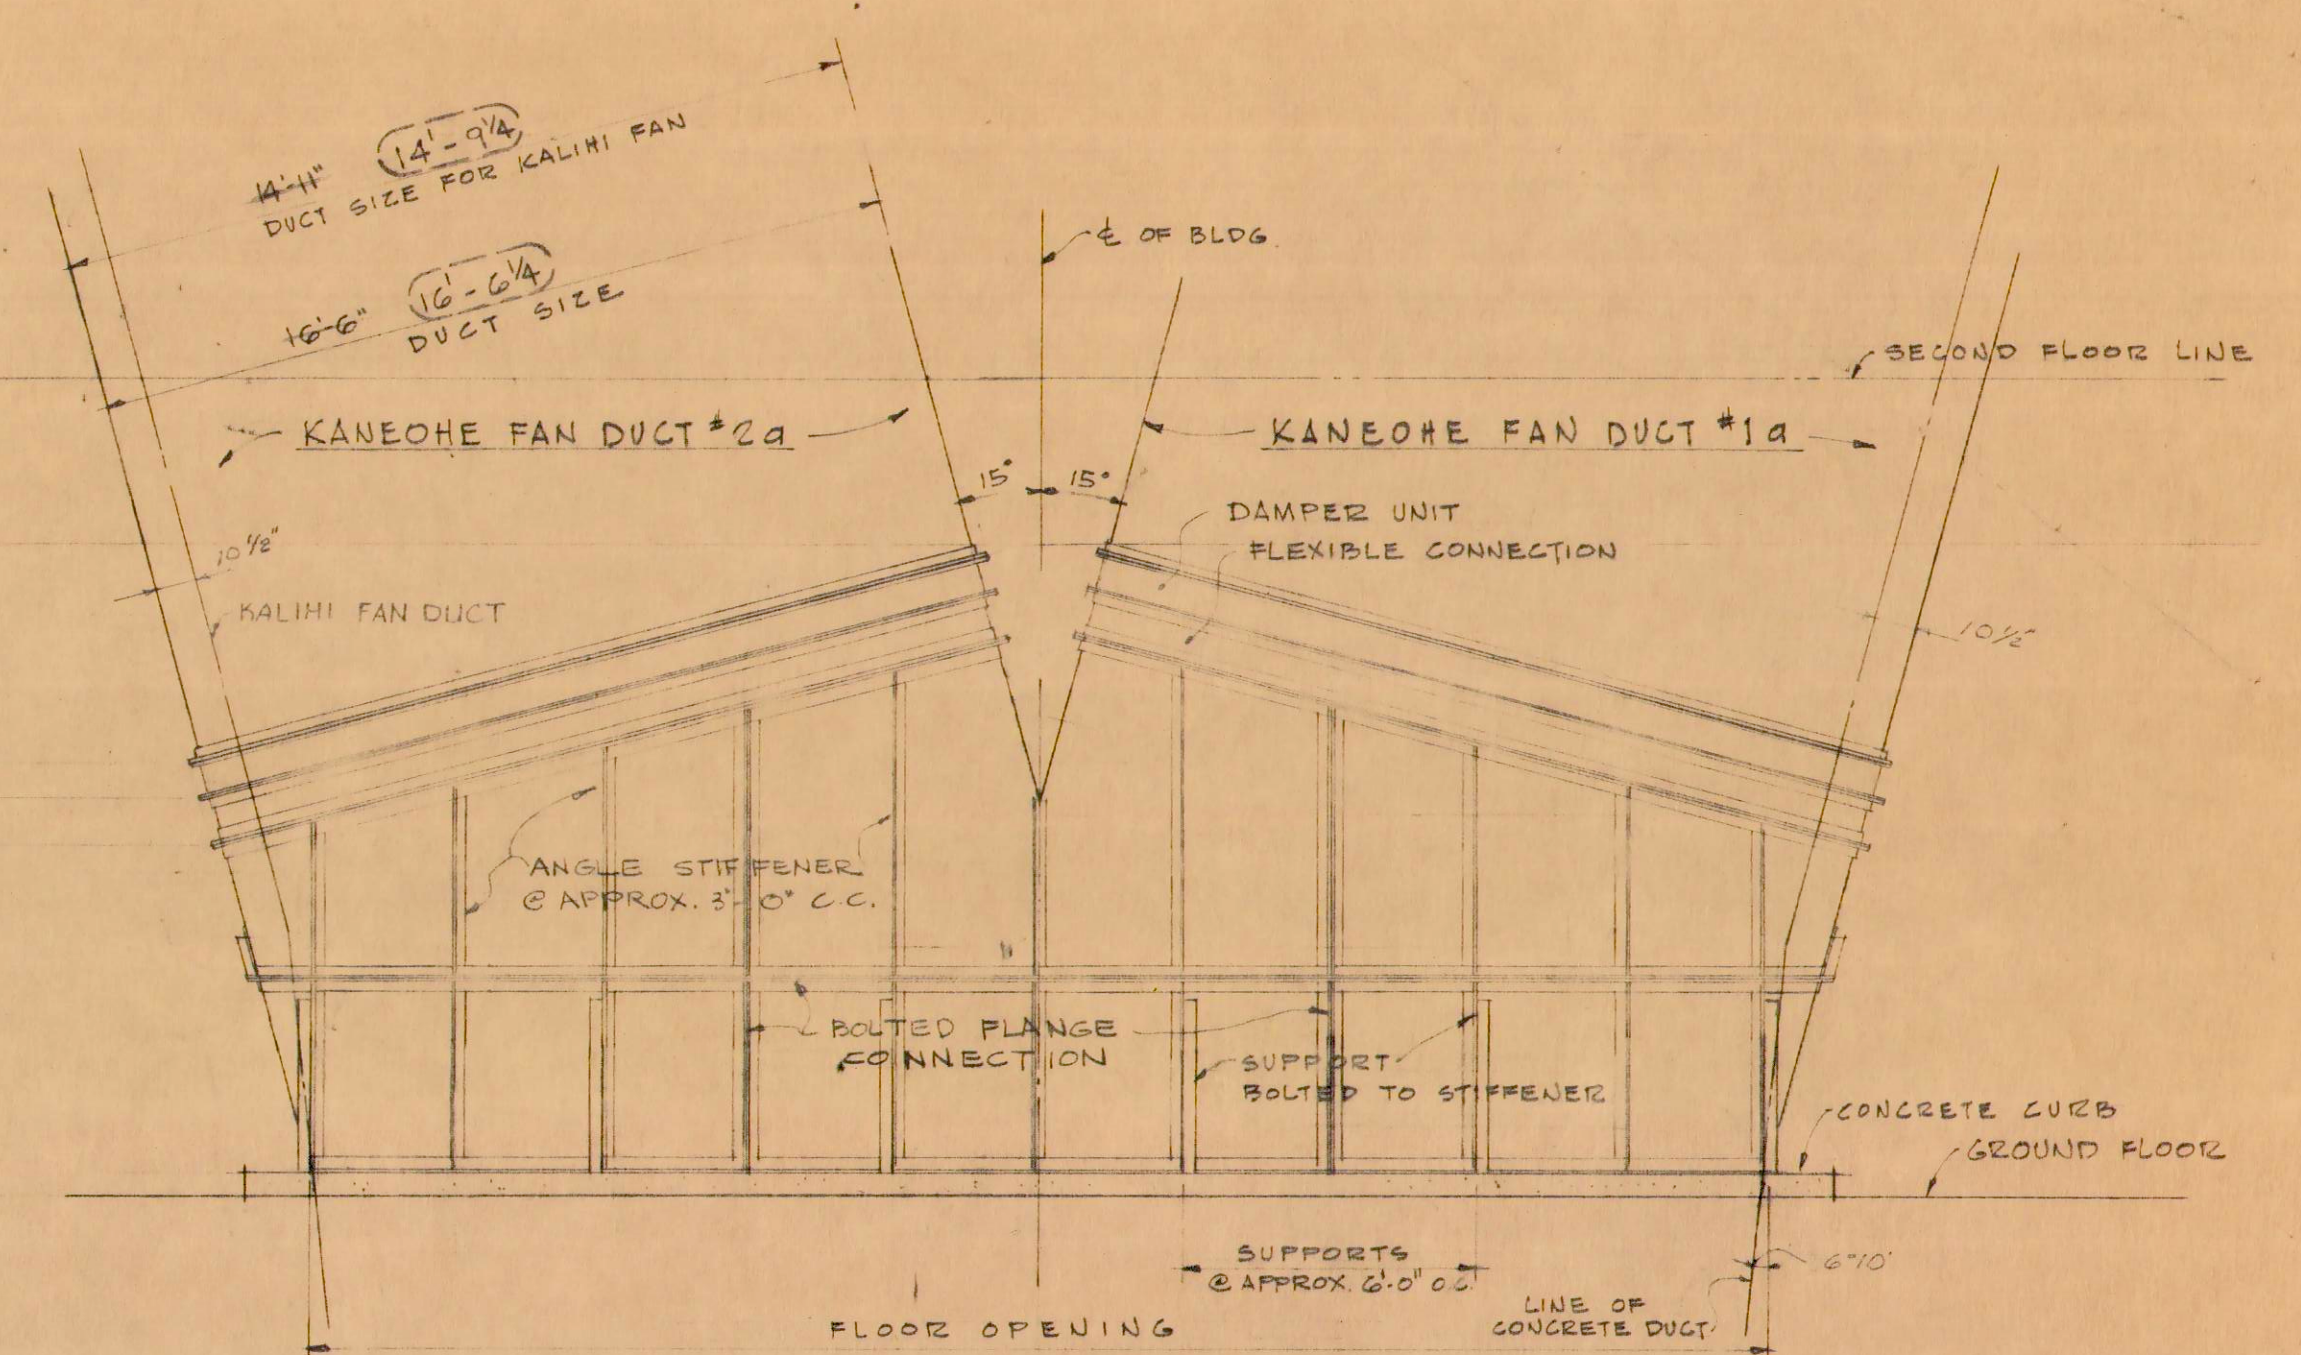

ELEVATION OF JUNCTION OF STEEL & CONCRETE DUCTS
KANE OHE FAN DUCT #1a & #2a AS SHOWN
KALIHI FAN DUCT #1b & #2b SIMILAR
1/4" = 1'-0"

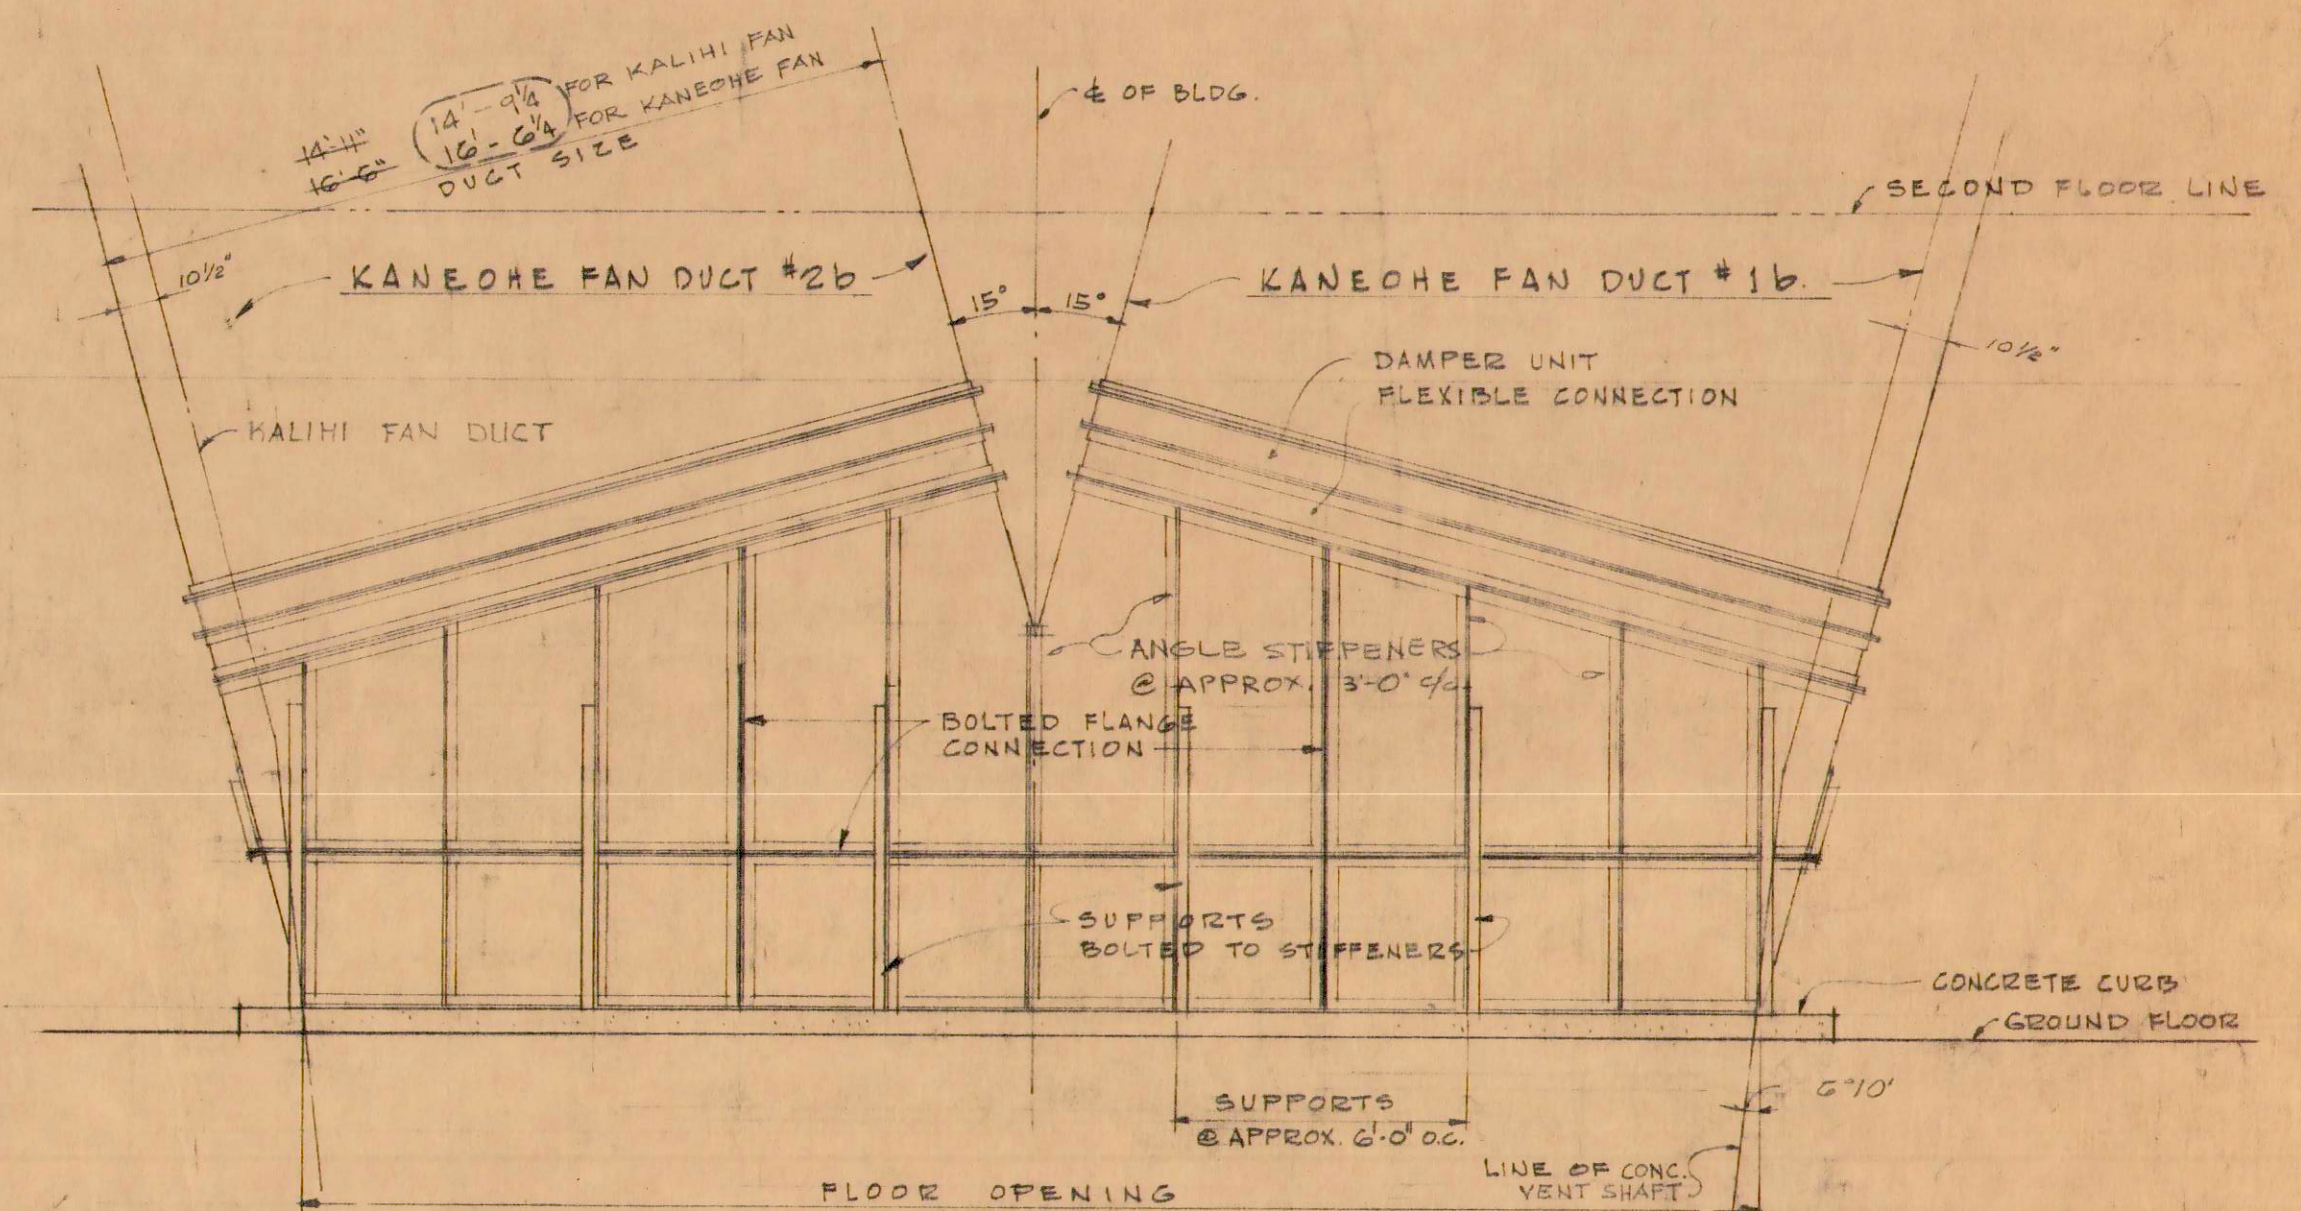

ELEVATION OF JUNCTION OF STEEL & CONCRETE DUCTS
KANE OHE FAN DUCT #1b & #2b AS SHOWN
KALIHI FAN DUCT #1a & #2a SIMILAR
1/4" = 1'-0"

LAW & WILSON
ARCHITECTS & ENGINEERS
DEPARTMENT OF PUBLIC WORKS
CITY AND COUNTY OF HONOLULU
BUREAU OF PLANS
KALIHI TUNNEL
VENTILATION BLDG.
FAN DUCT DETAILS

2	7-20-56	FLARE DETAILS	H.M.	70
1	4-10-56	RELOCATED OPENINGS & EQUIPMENT	E.Y.	70
REVISION	DATE	DESCRIPTION	MADE BY	CHK BY

APPROVED:
ENGINEER, KALIHI TUNNEL

ENGINEER: L. & W.
DRAFTSMAN: R. W.
SCALE: AS NOTED
TRACER: AS NOTED
APPROVED: *[Signature]*
CHIEF ENGINEER

W.S. CR. SEC. F.B. C.B.
W.M. BY F.W. BY S.B.

SECTION C

JOB NO. 26-53

DWG. VB-21