
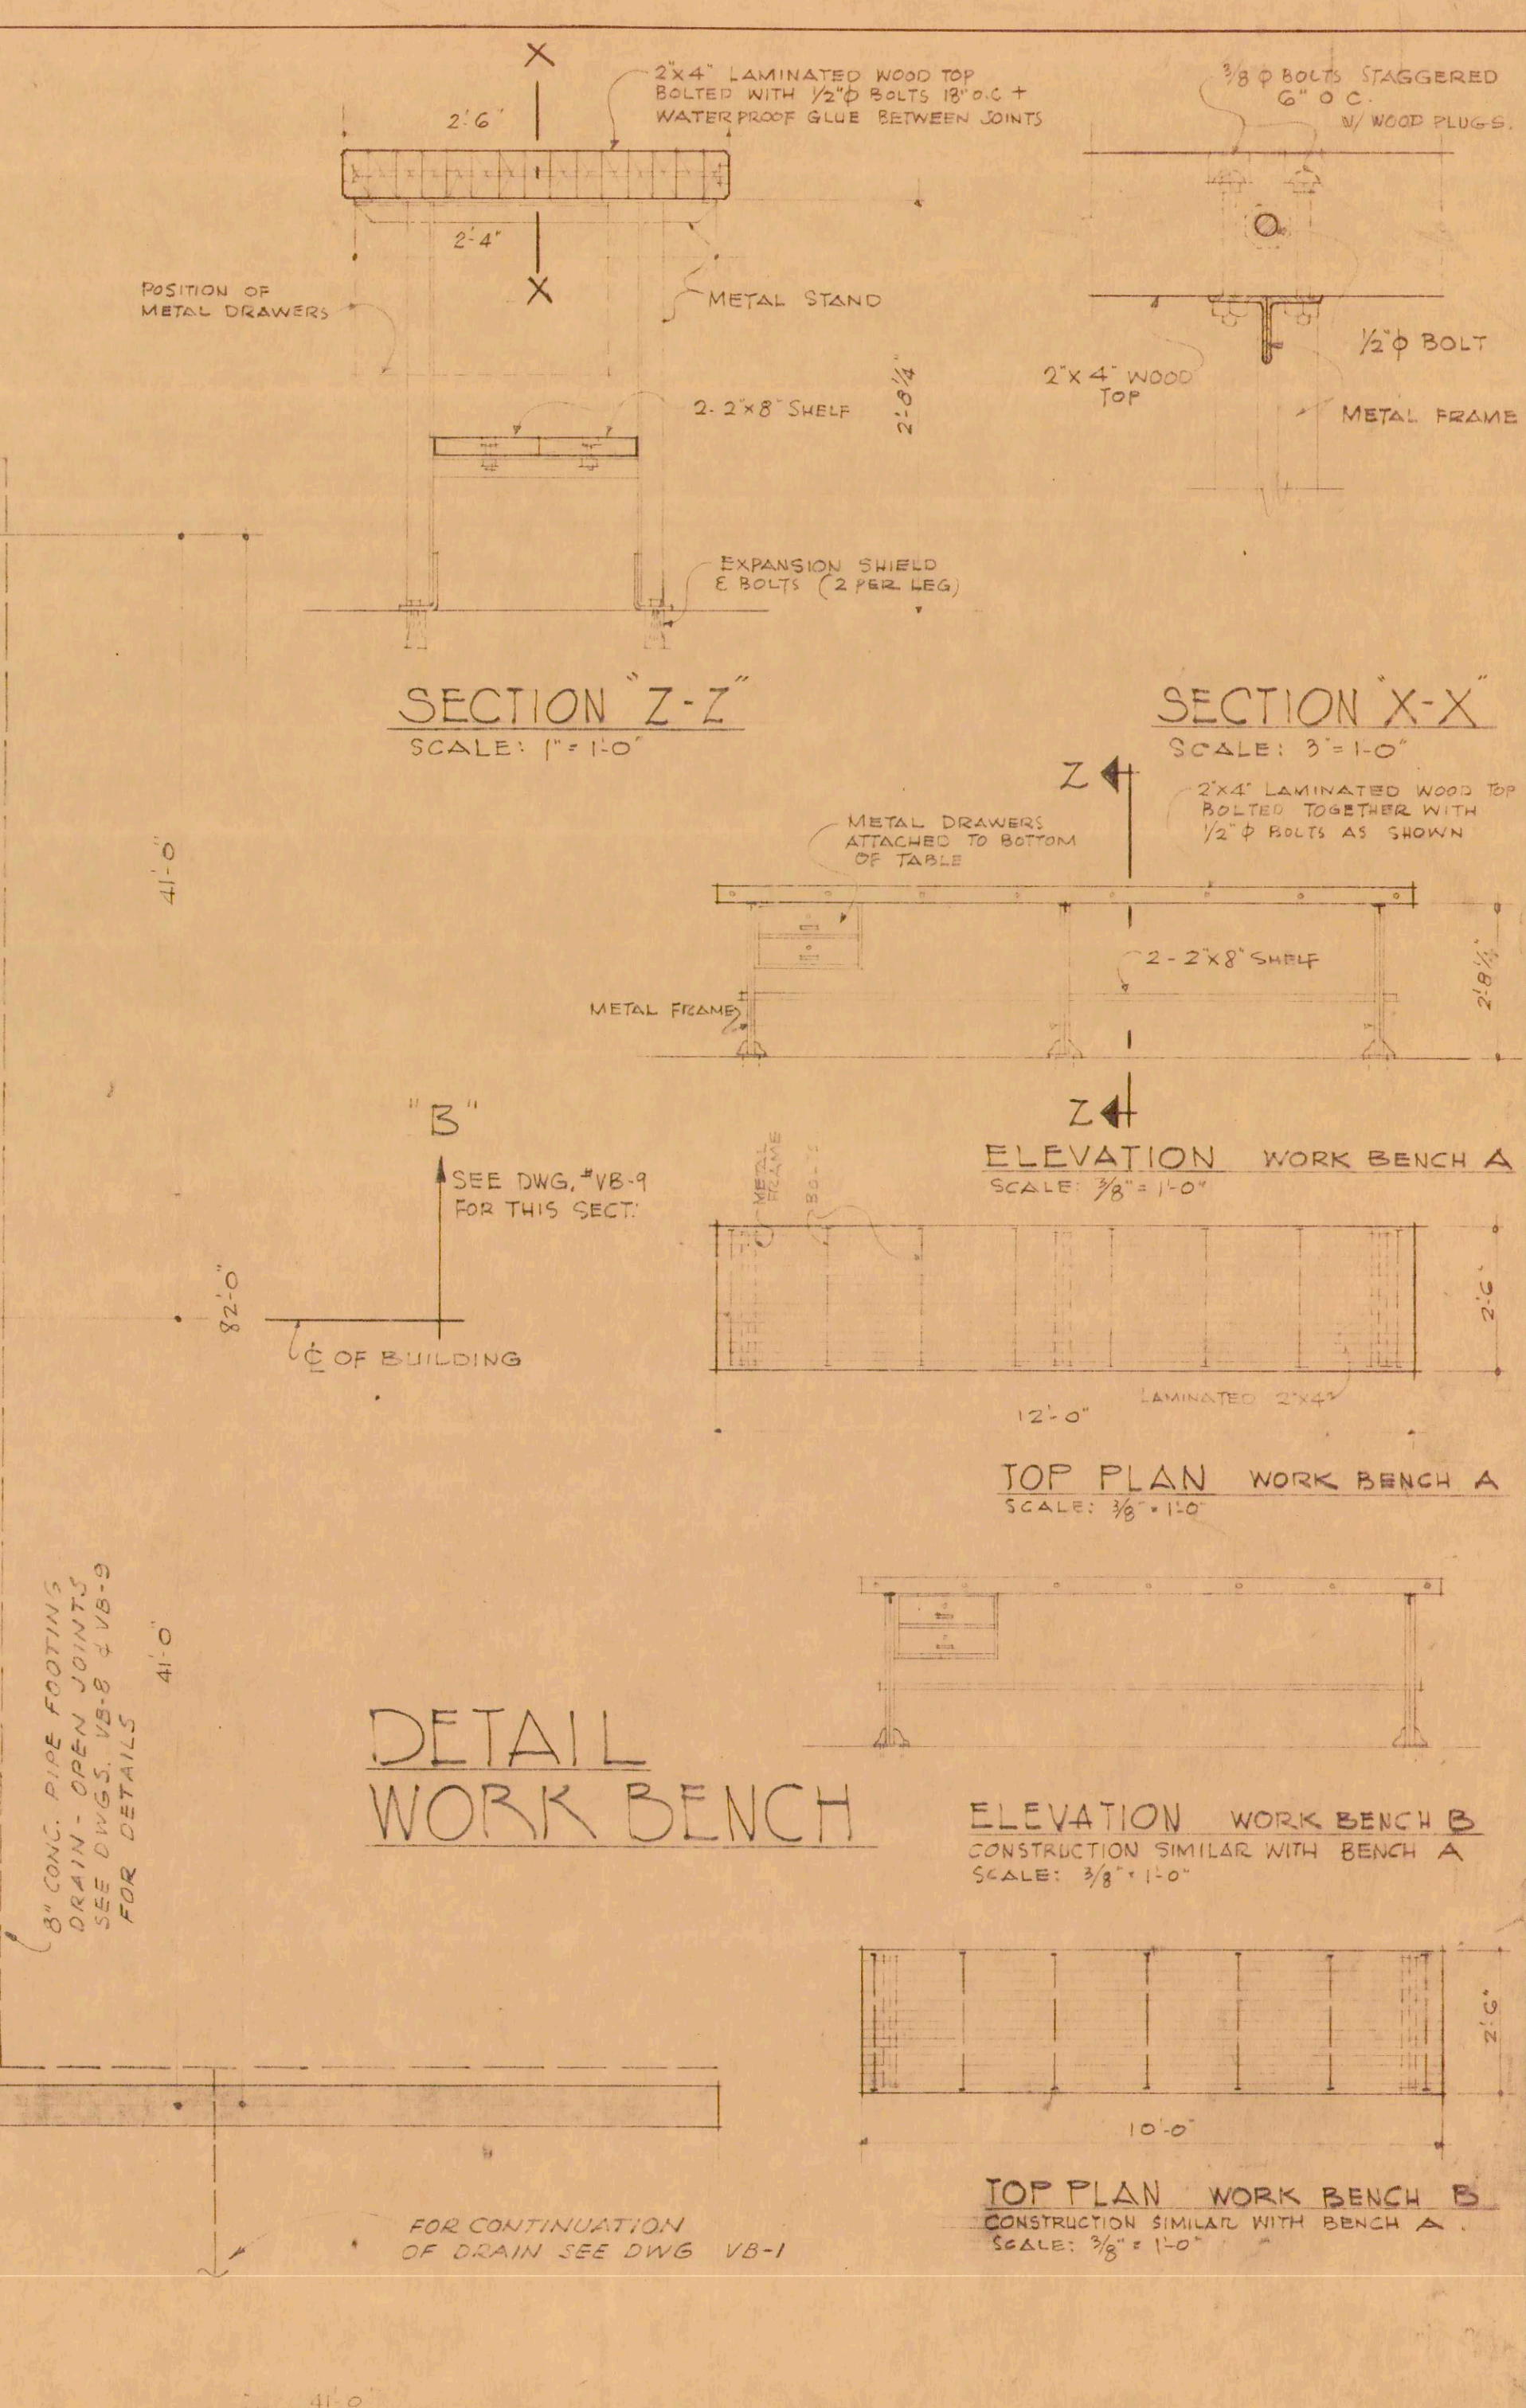
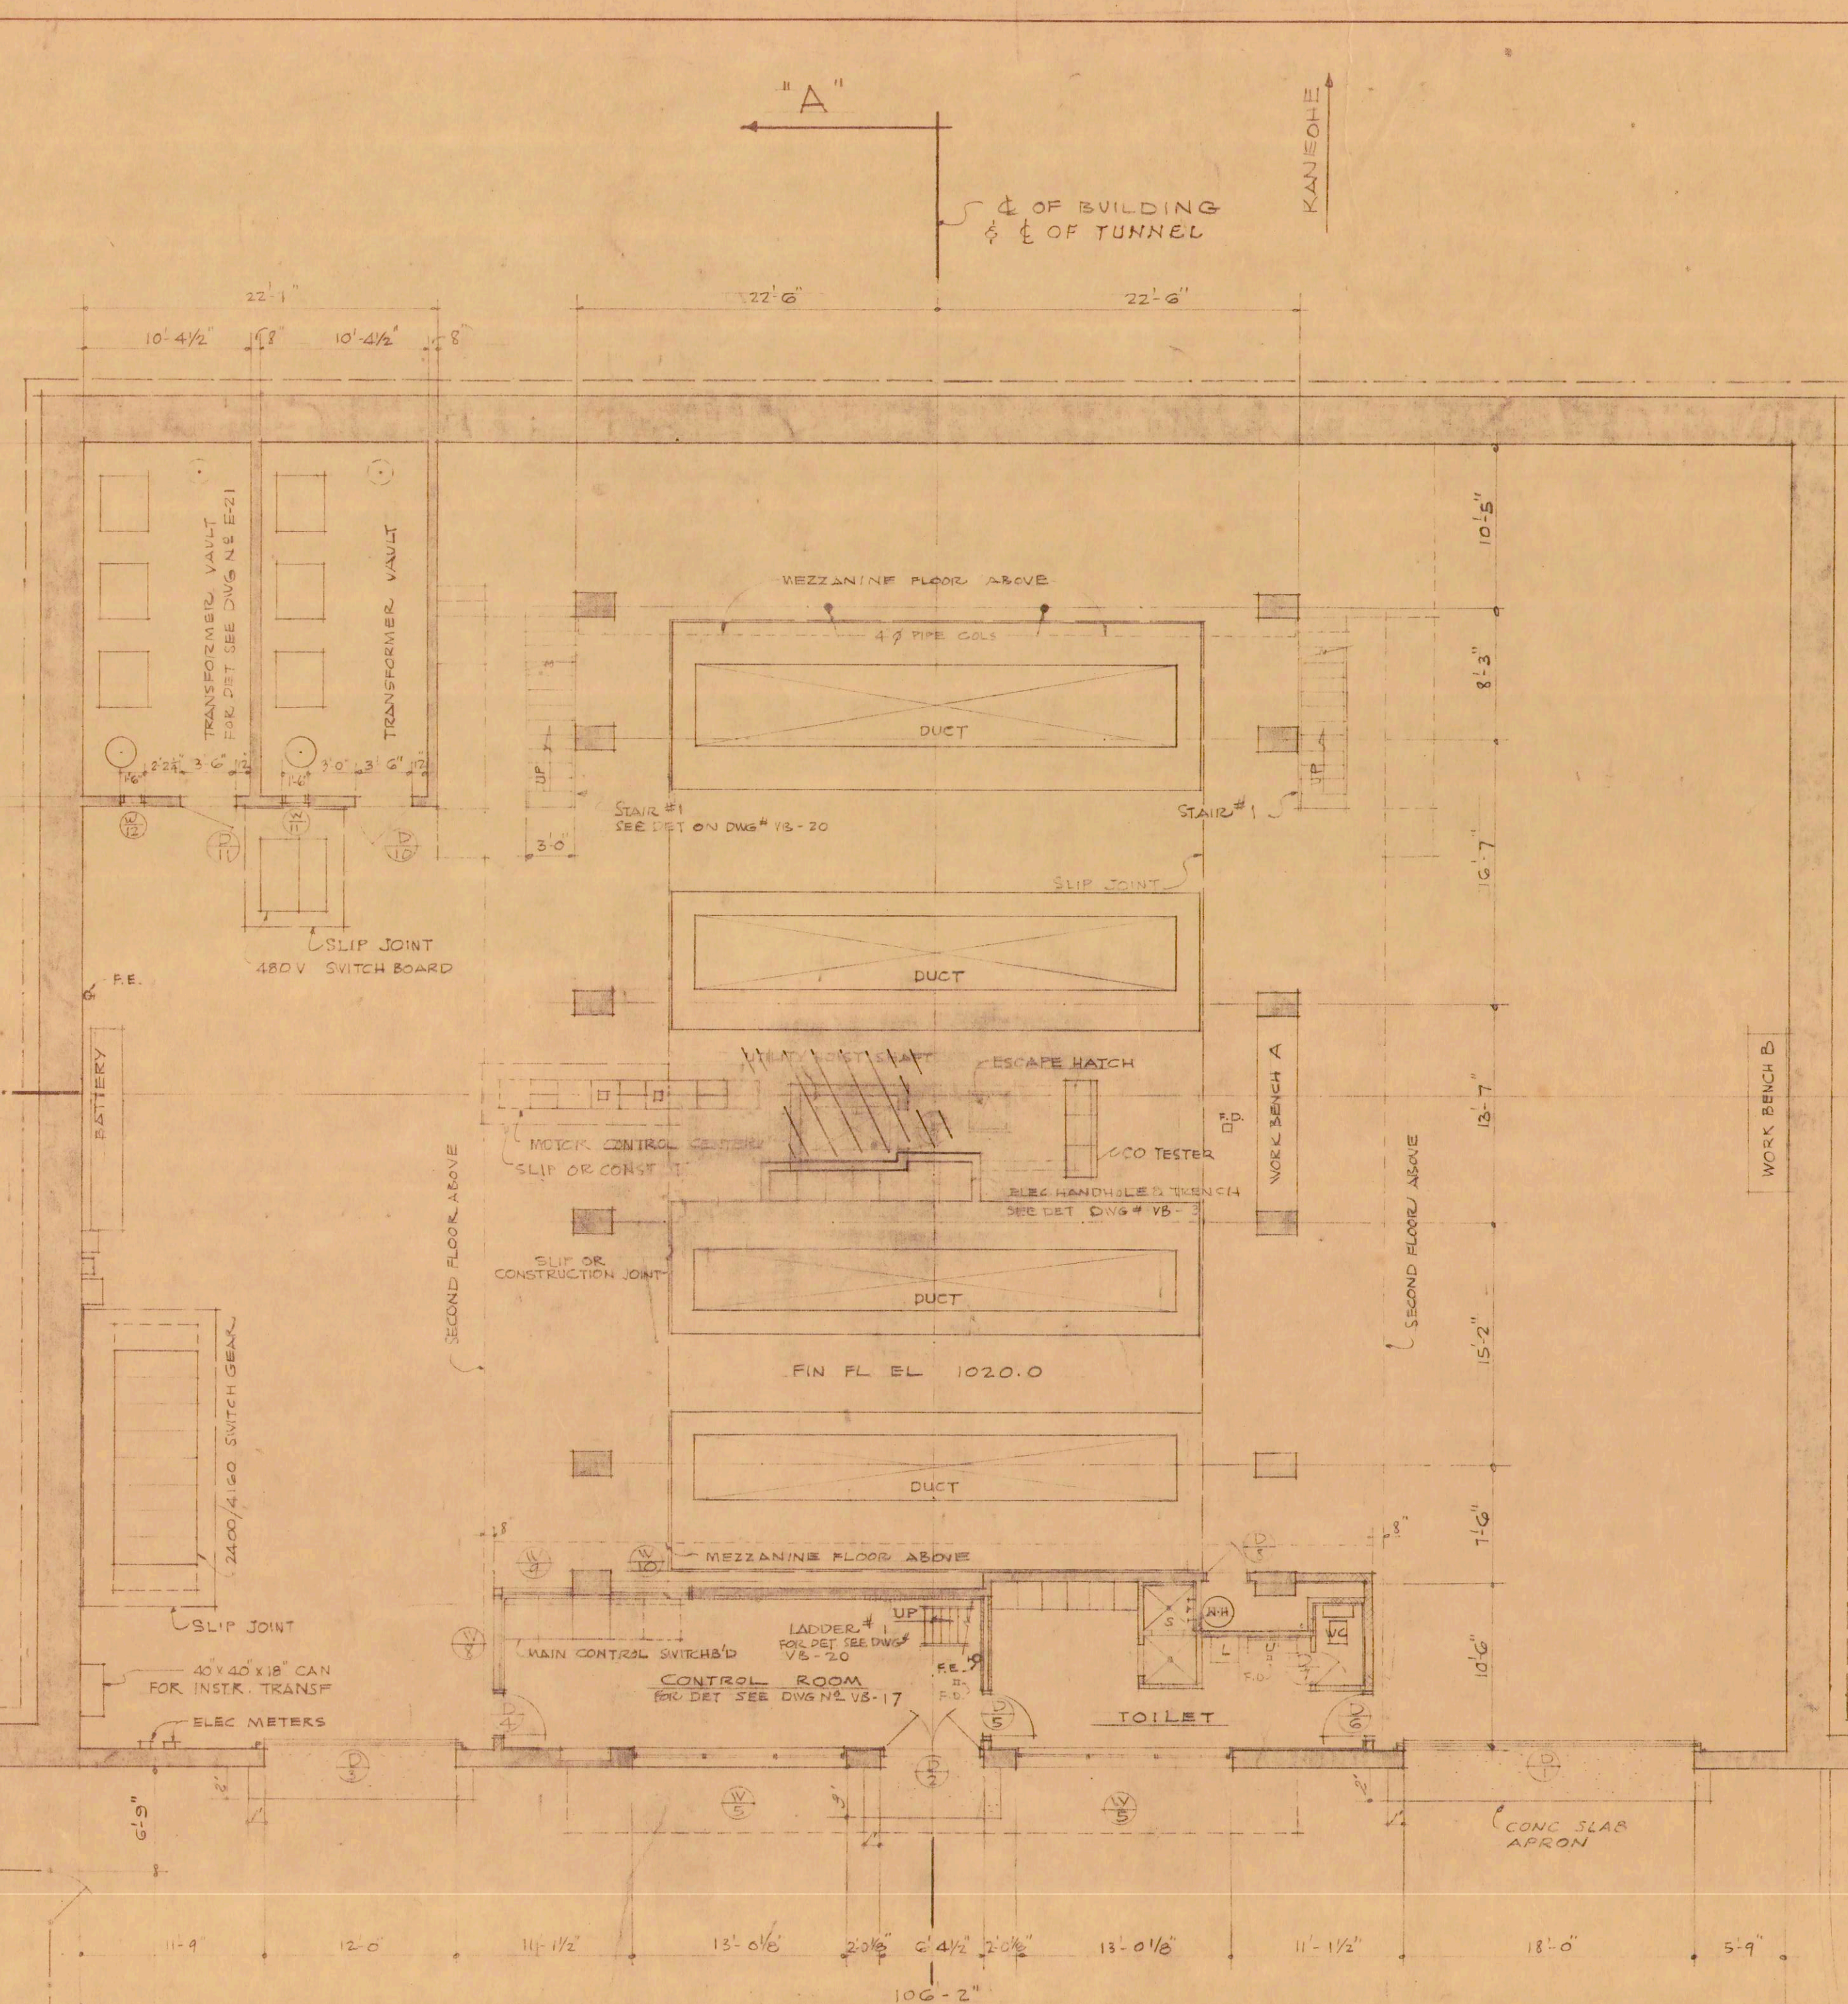
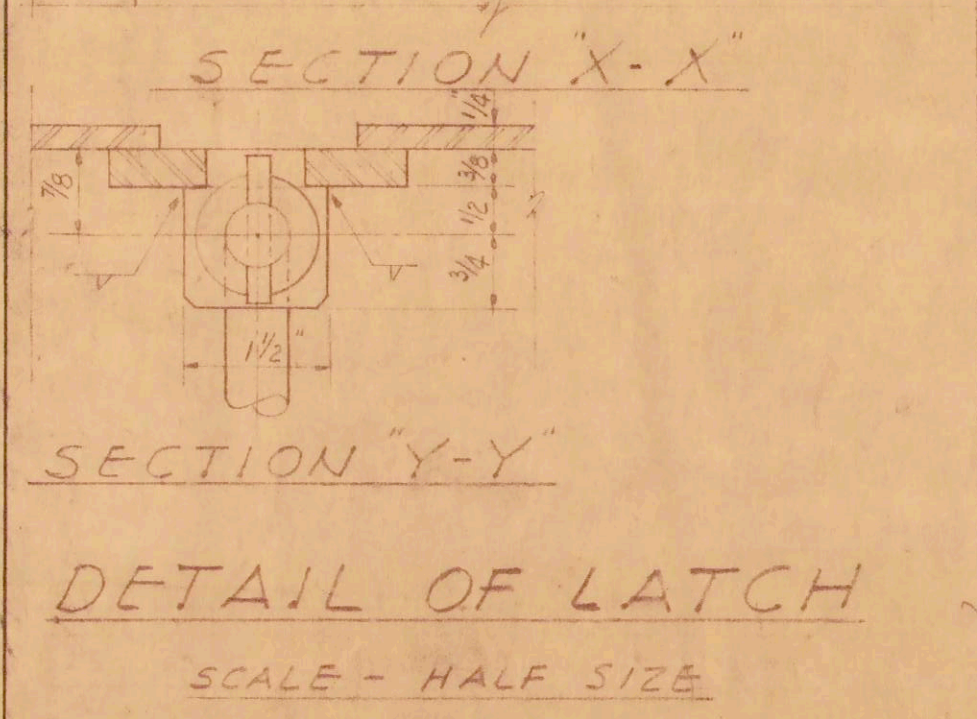
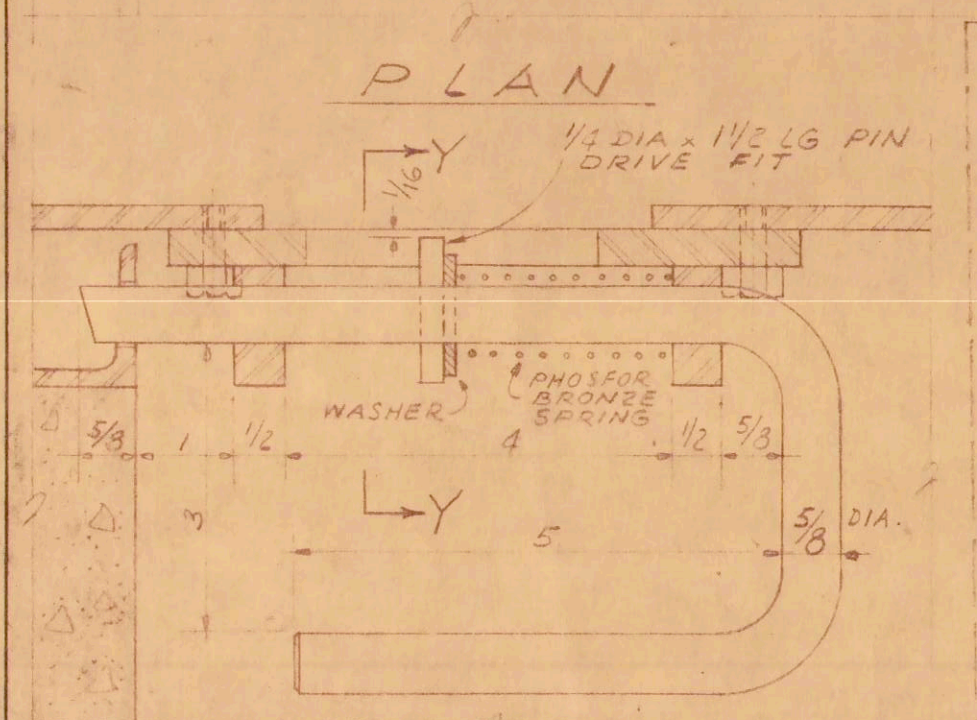
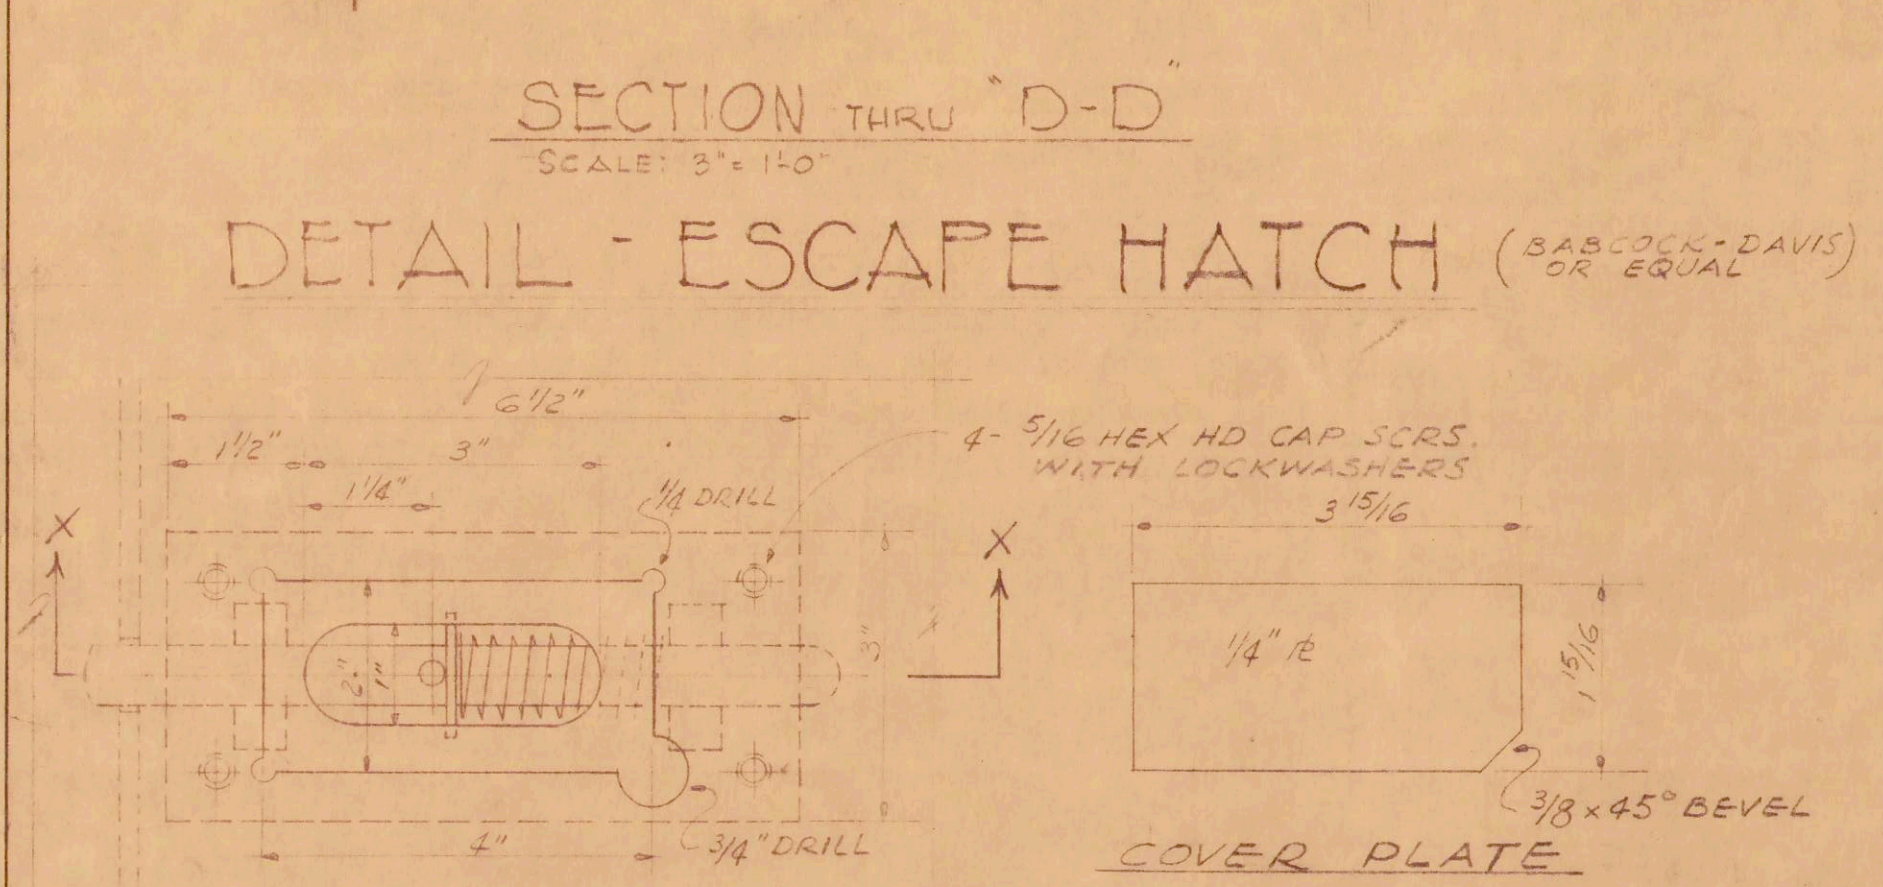


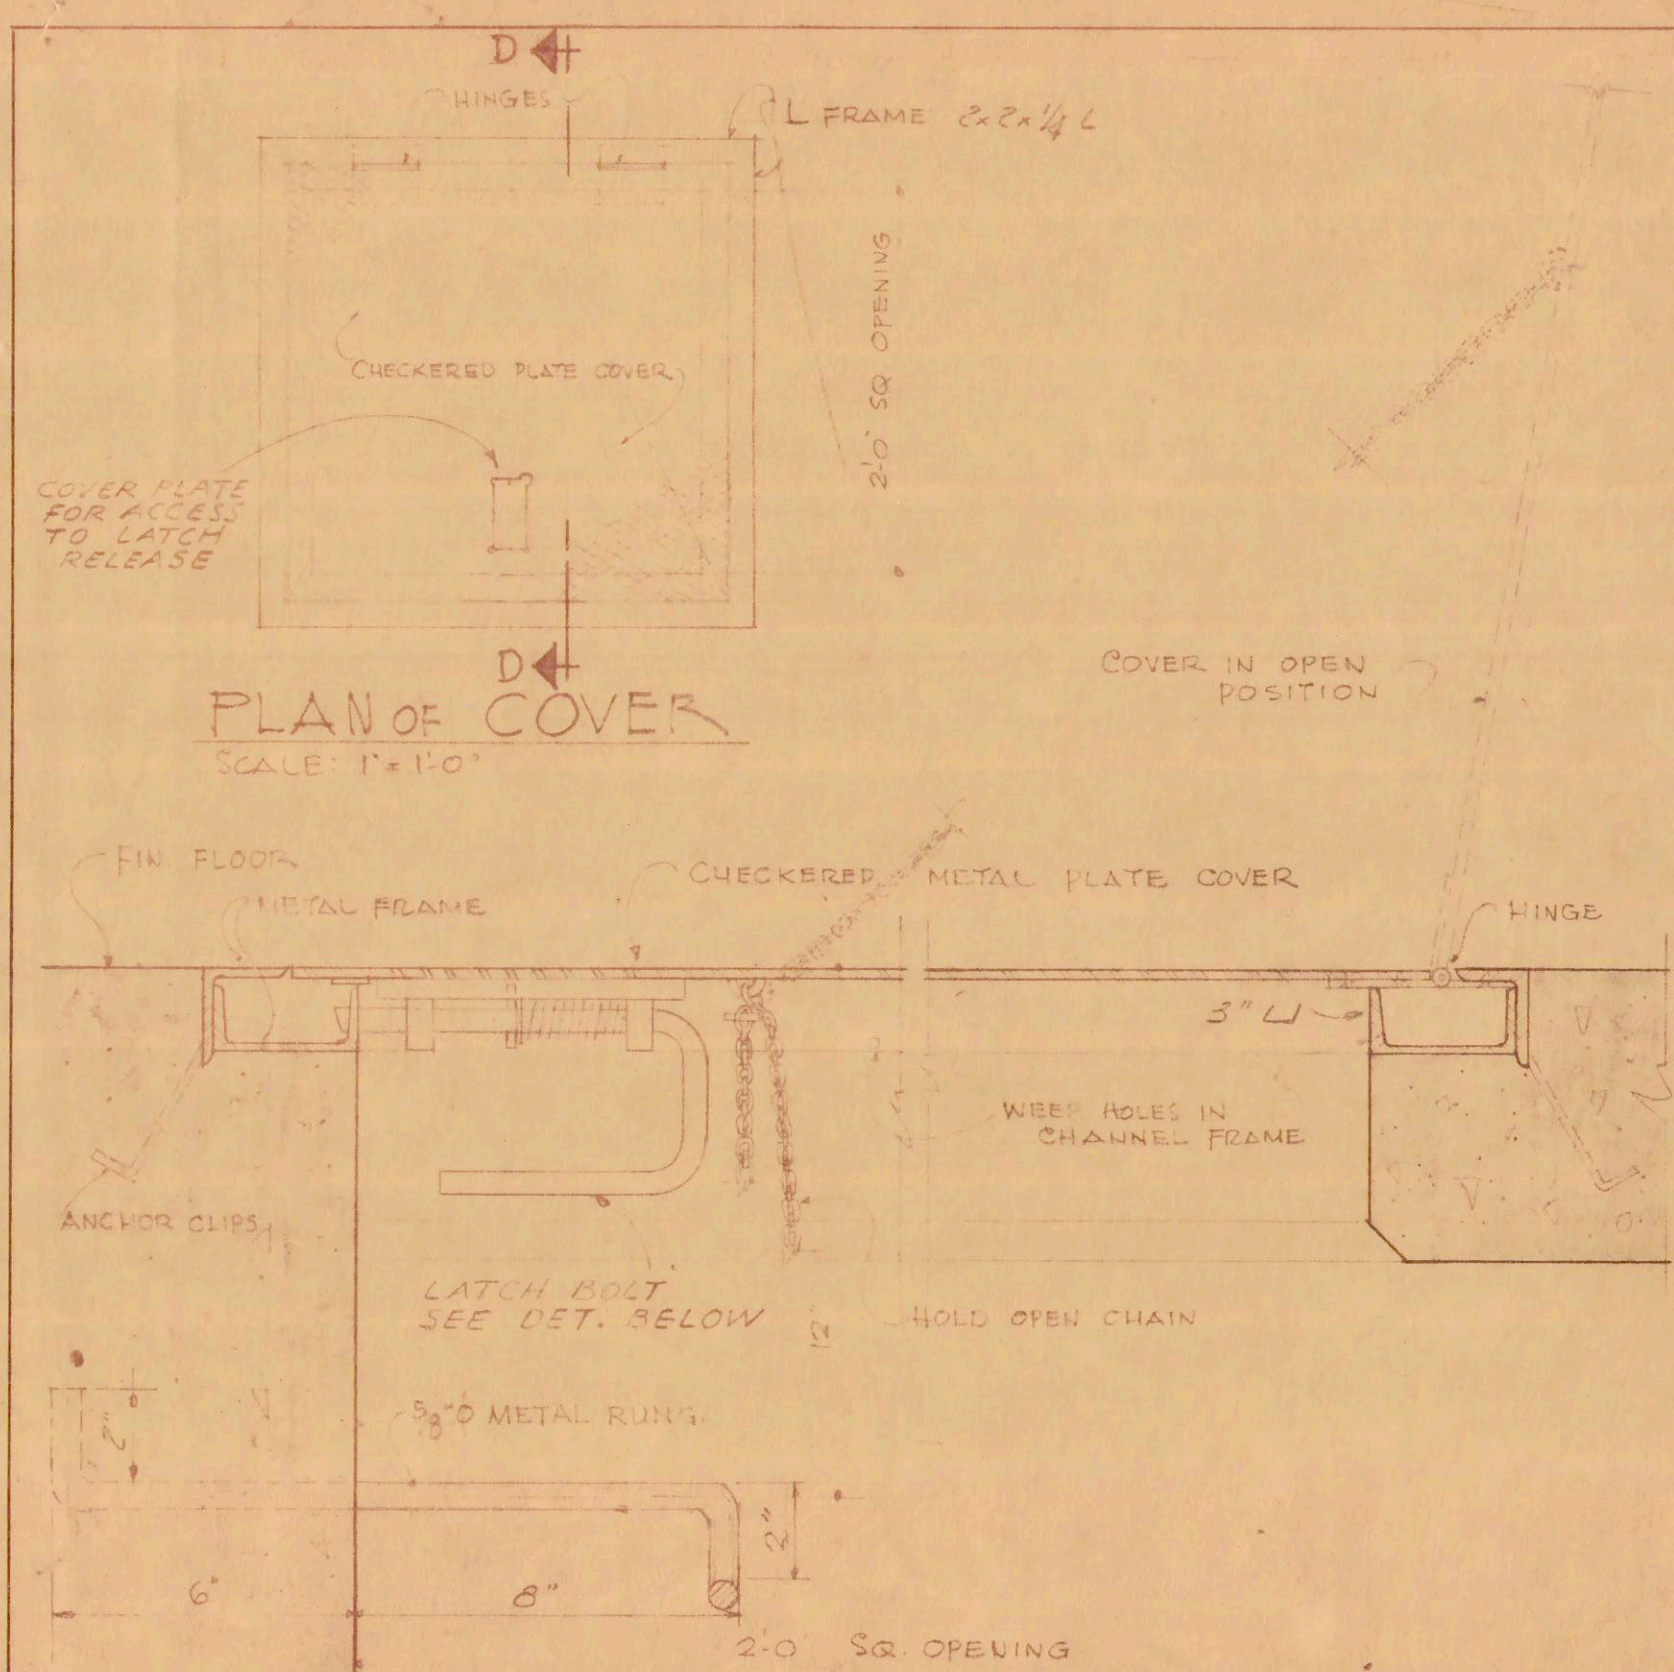

HAWAIIAN ELECTRIC CO.
TRANSFORMER STATION
FL EL 1020.0
FOR DETAIL SEE DWG # B-16

2	7-20-56	RELOCATE DUCT OPENING	H.M.	70
1	4-16-56	RELOCATED OPENINGS & EQUIPMENT	E.V.	70
REVISION	DATE	DESCRIPTION	MADE BY	CHECKED BY
LAW & WILSON ARCHITECTS & ENGINEERS DEPARTMENT OF PUBLIC WORKS CITY AND COUNTY OF HONOLULU BUREAU OF PLANS KALIHI TUNNEL VENTILATION BLDG. GROUND FLOOR PLAN				
ENGINEER	L.S.W.	DATE	JULY 19, 1953	
DRAFTSMAN	P.K.	CHECKED BY	R.E. WILSON	
SCALE	AS NOTED	TRACER		
APPROVED	<i>Le. Tanwatts</i>	APPROVED	<i>R. Butz</i>	
CHIEF ENGINEER		BUREAU ENGINEER		
W.S.	PROFILE	C.B.		
CR. SEC.	P.B.	S.B.		
W.M. BY	P.W. BY	S.B.		