
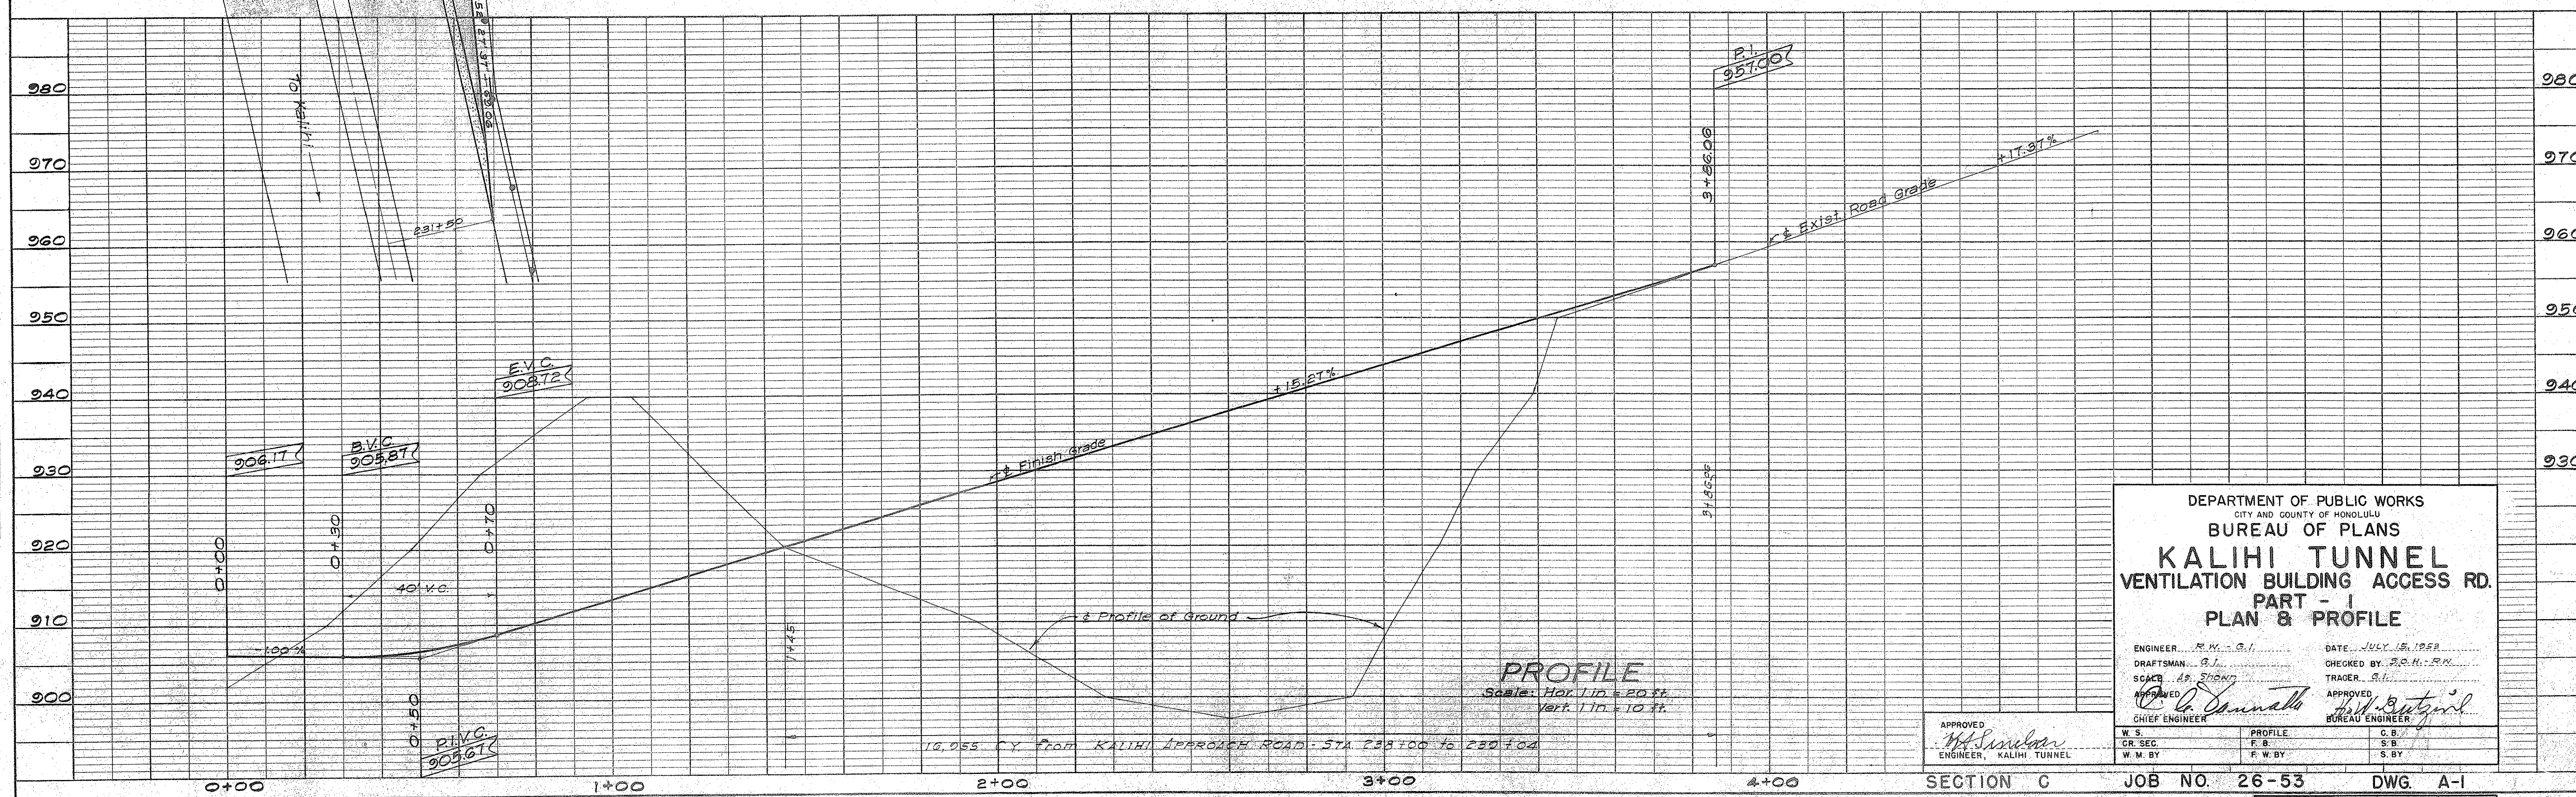


PLAN	SURVEYED	DATE
	PLOTTED	BY
	NOTE BOOK	
	ALIGNMENT CHECKED	
	RT. OF WAY CHECKED	
	NO.	

PROFILE	SURVEYED	DATE
	GRADES CHECKED	BY
	NOTE BOOK	
	STRUCTURE NOTATIONS CHECKED	
	NO.	

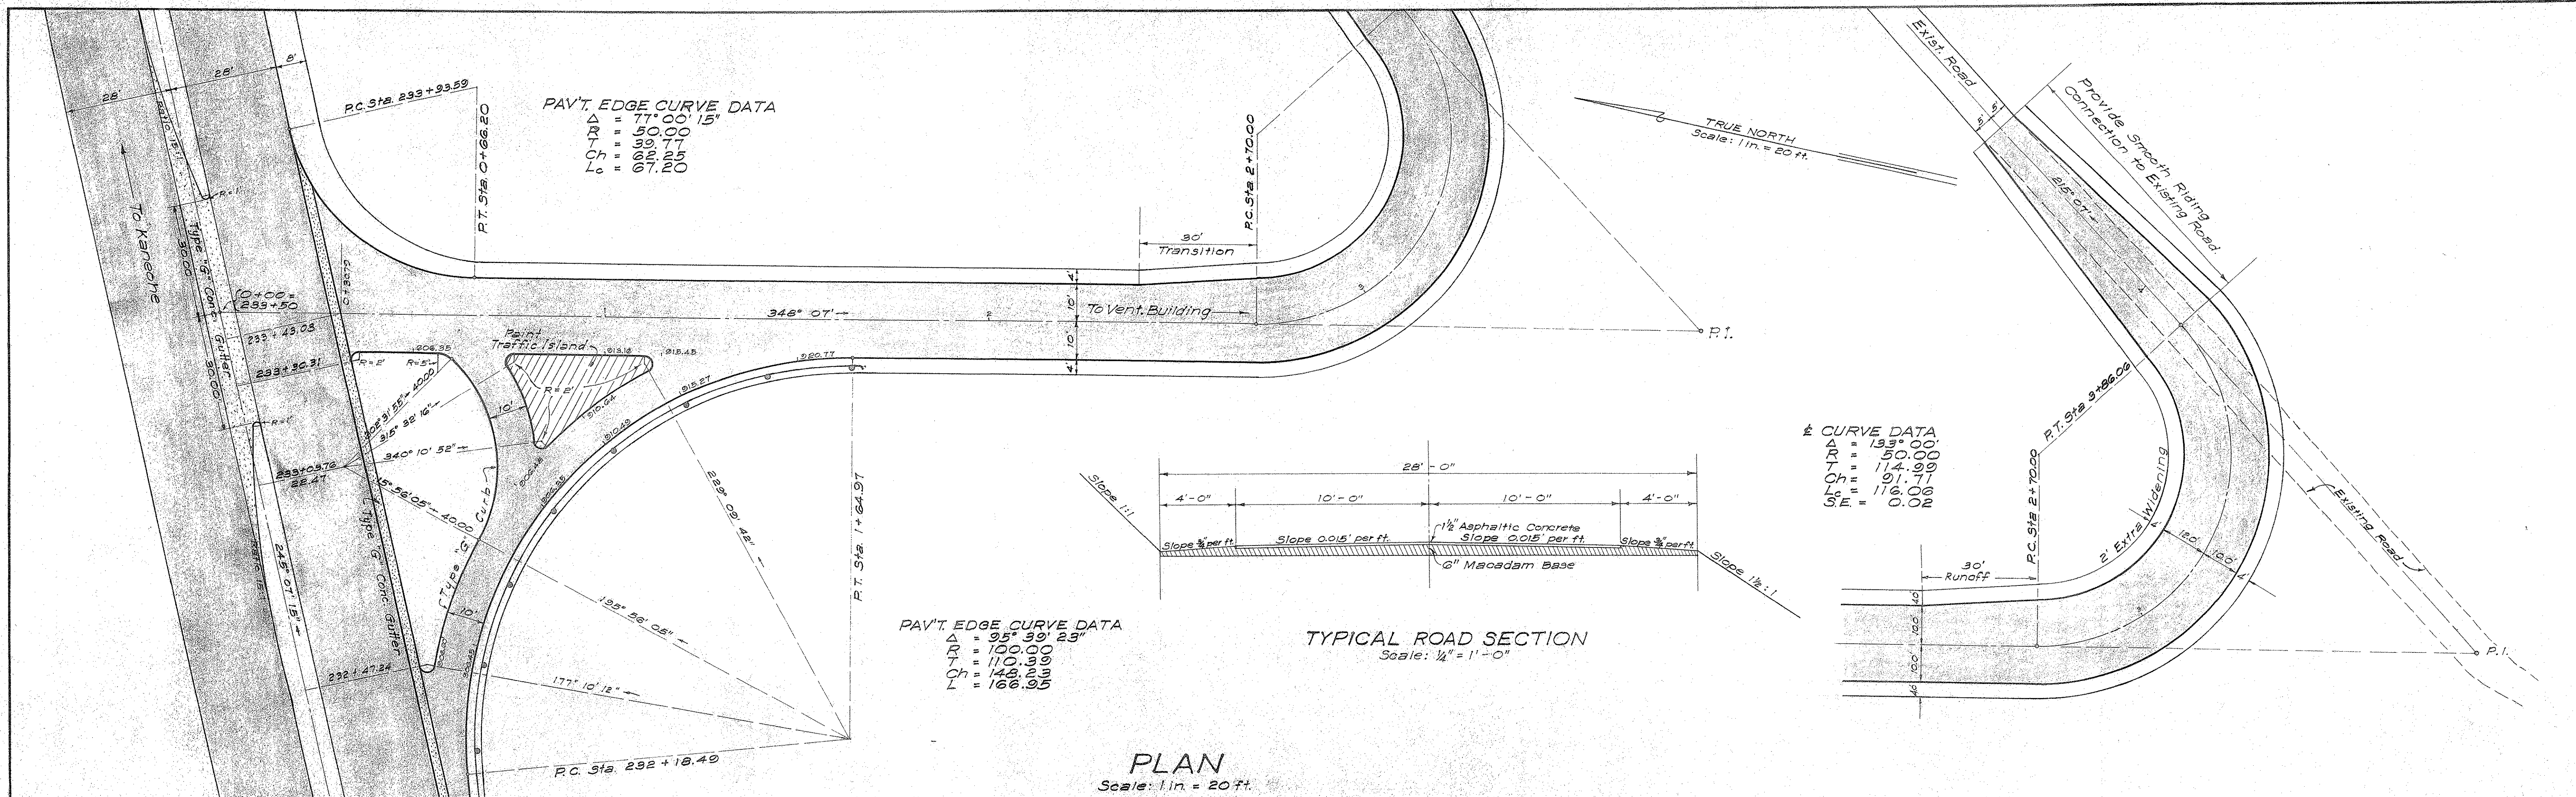

FILE	POCKET	FOLDER	NO.
7	5	2	9

PROFILE	SURVEYED	BY	DATE
NOTE BOOK	GRADES CHECKED		
NO.	B. M.'S NOTED		
	STRUCTURE NOTATIONS CH'D.		

