


PERMIT NO. 0-96-36
WILSON TUNNEL CELLULAR PHONE SITES
(REFER TO PERMIT PLAN FOR DETAILS)
COMP: 04/04/97

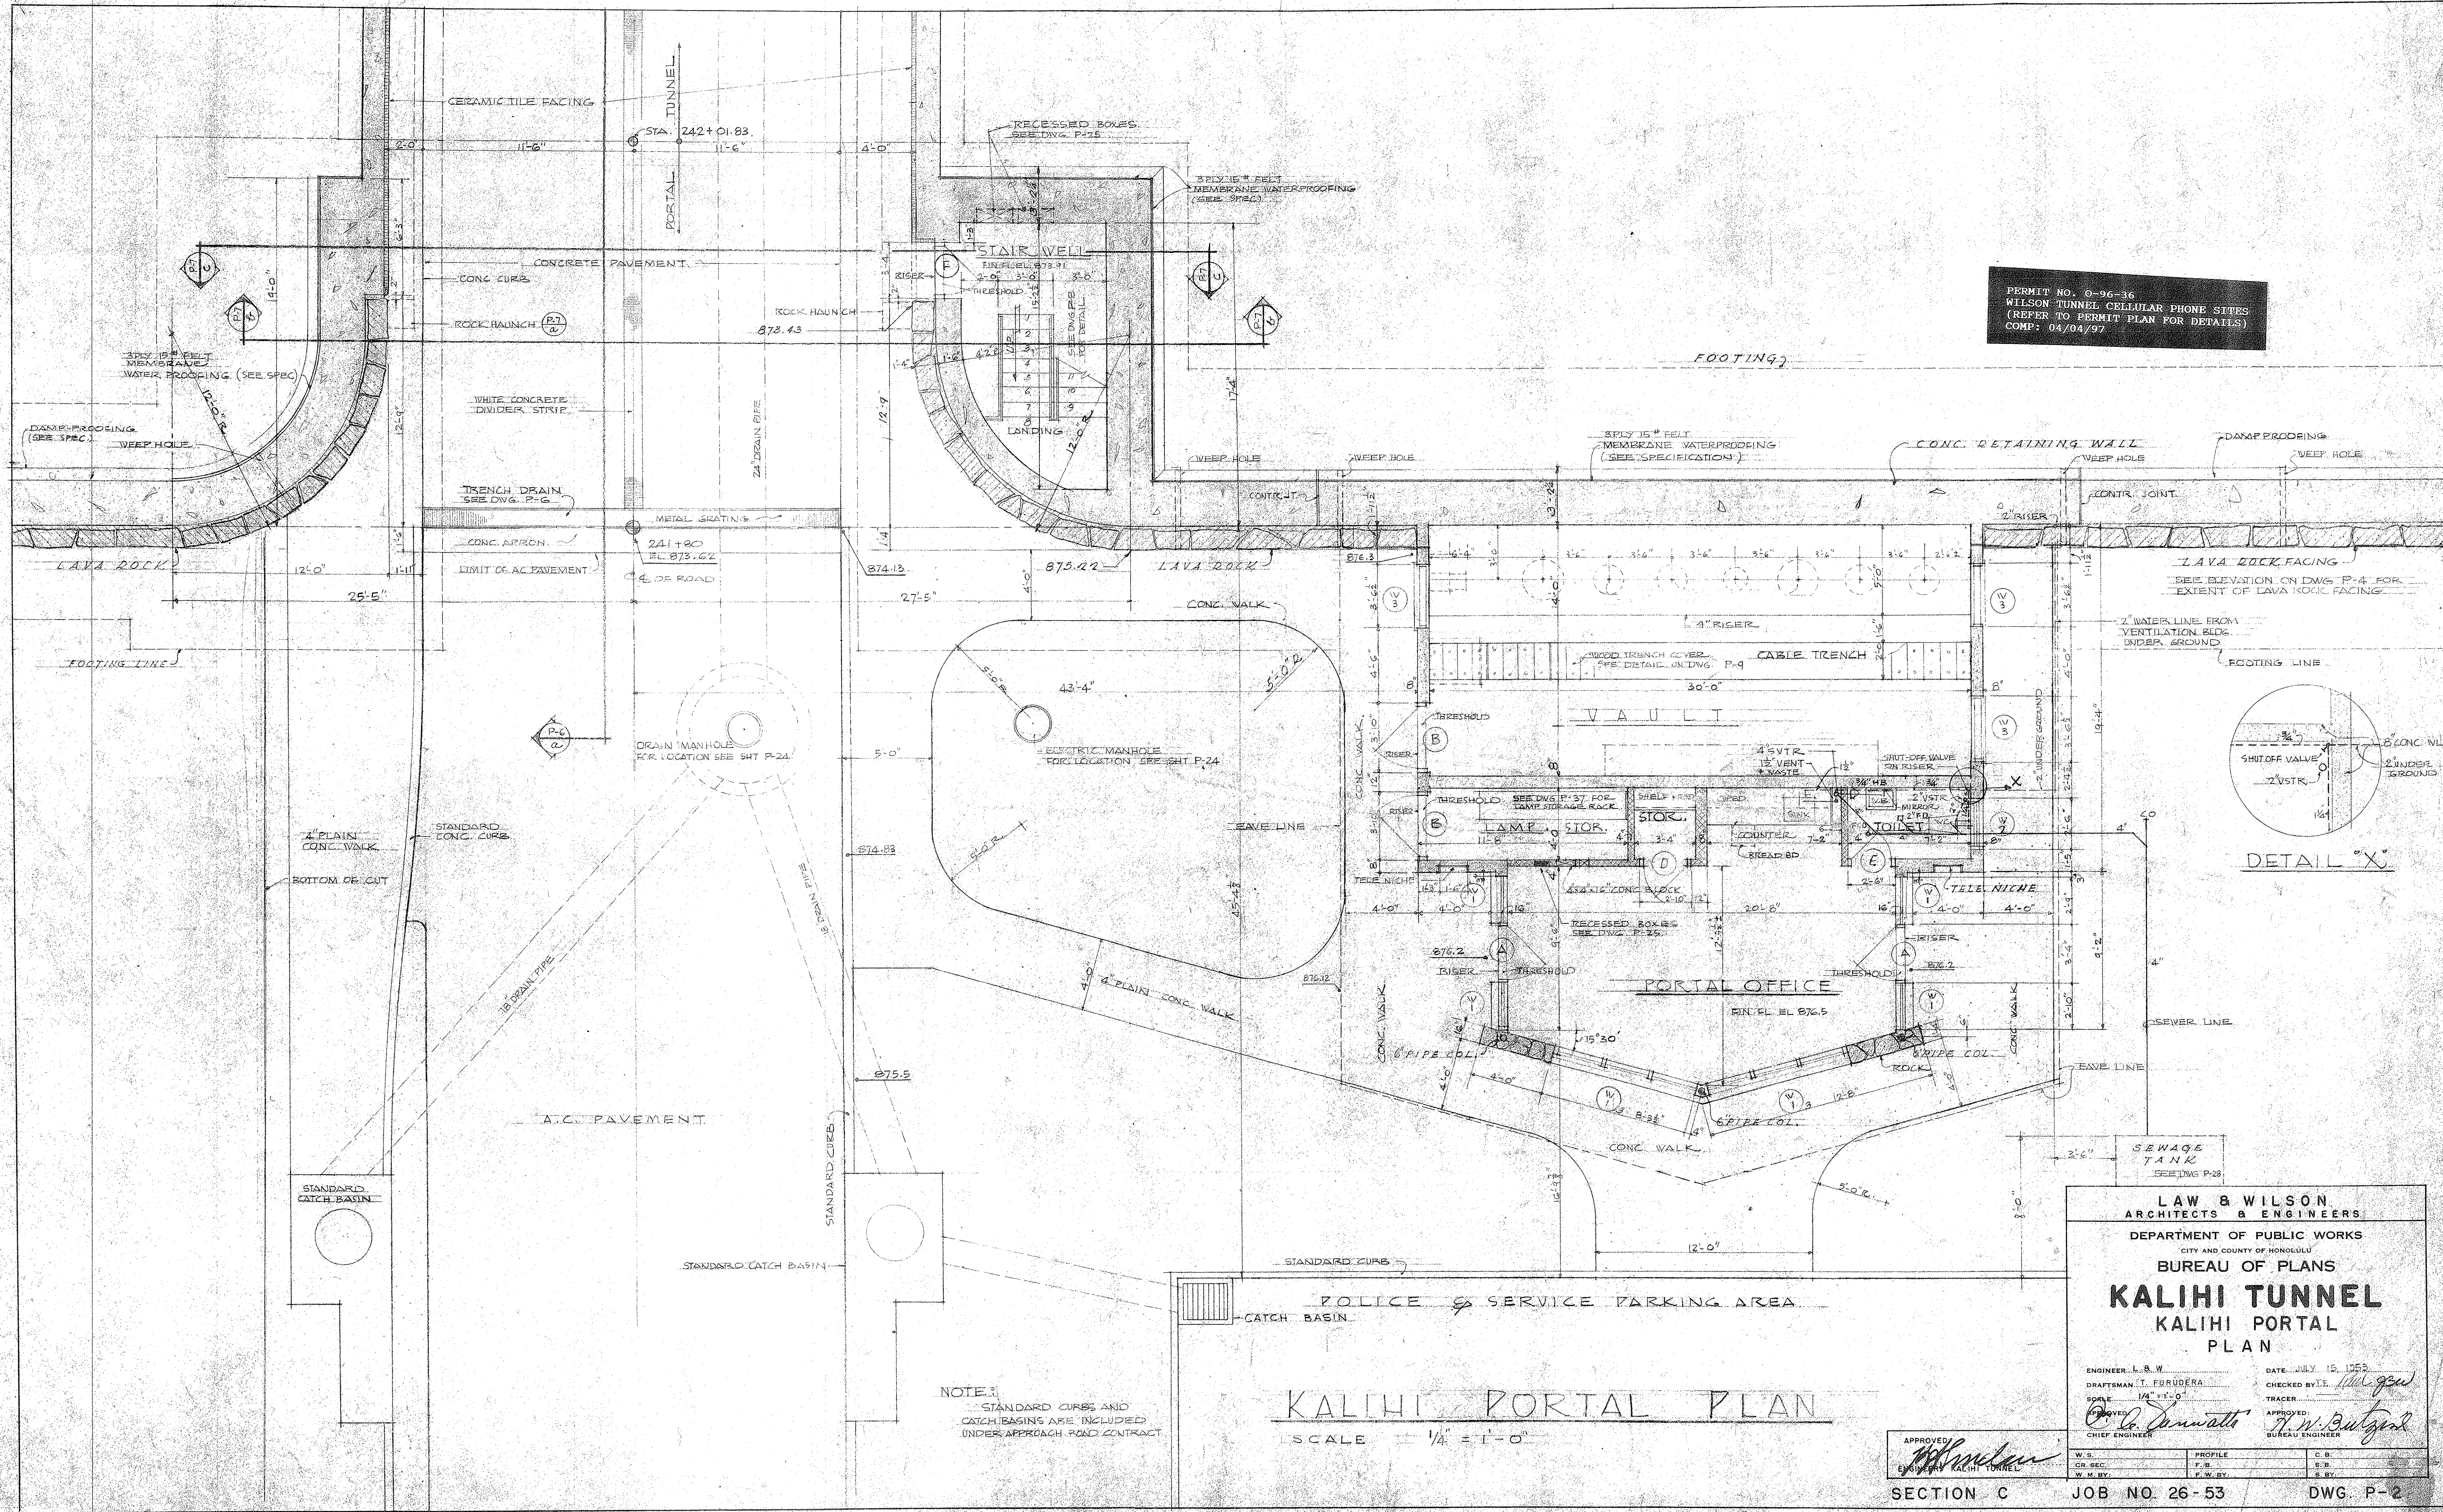

NOTE:
STANDARD CURBS AND
CATCH BASINS ARE INCLUDED
UNDER APPROACH ROAD CONTRACT

KALIHI PORTAL PLAN
SCALE 1/4" = 1'-0"

LAW & WILSON
ARCHITECTS & ENGINEERS
DEPARTMENT OF PUBLIC WORKS
CITY AND COUNTY OF HONOLULU
BUREAU OF PLANS
KALIHI TUNNEL
KALIHI PORTAL
PLAN

ENGINEER: L. S. W.
DRAFTSMAN: T. FRUDERA
SCALE: 1/4" = 1'-0"
APPROVED: *[Signature]*
CHIEF ENGINEER

DATE: JULY 15, 1993
CHECKED BY: *[Signature]*
TRACER:
APPROVED: *[Signature]*
BUREAU ENGINEER

W.S.	PROFILE	C.B.
CR. SEC.	F.B.	E.B.
W.M.B.V.	F.W.B.V.	S.B.V.

SECTION C JOB NO. 26-53 DWG. P-2