


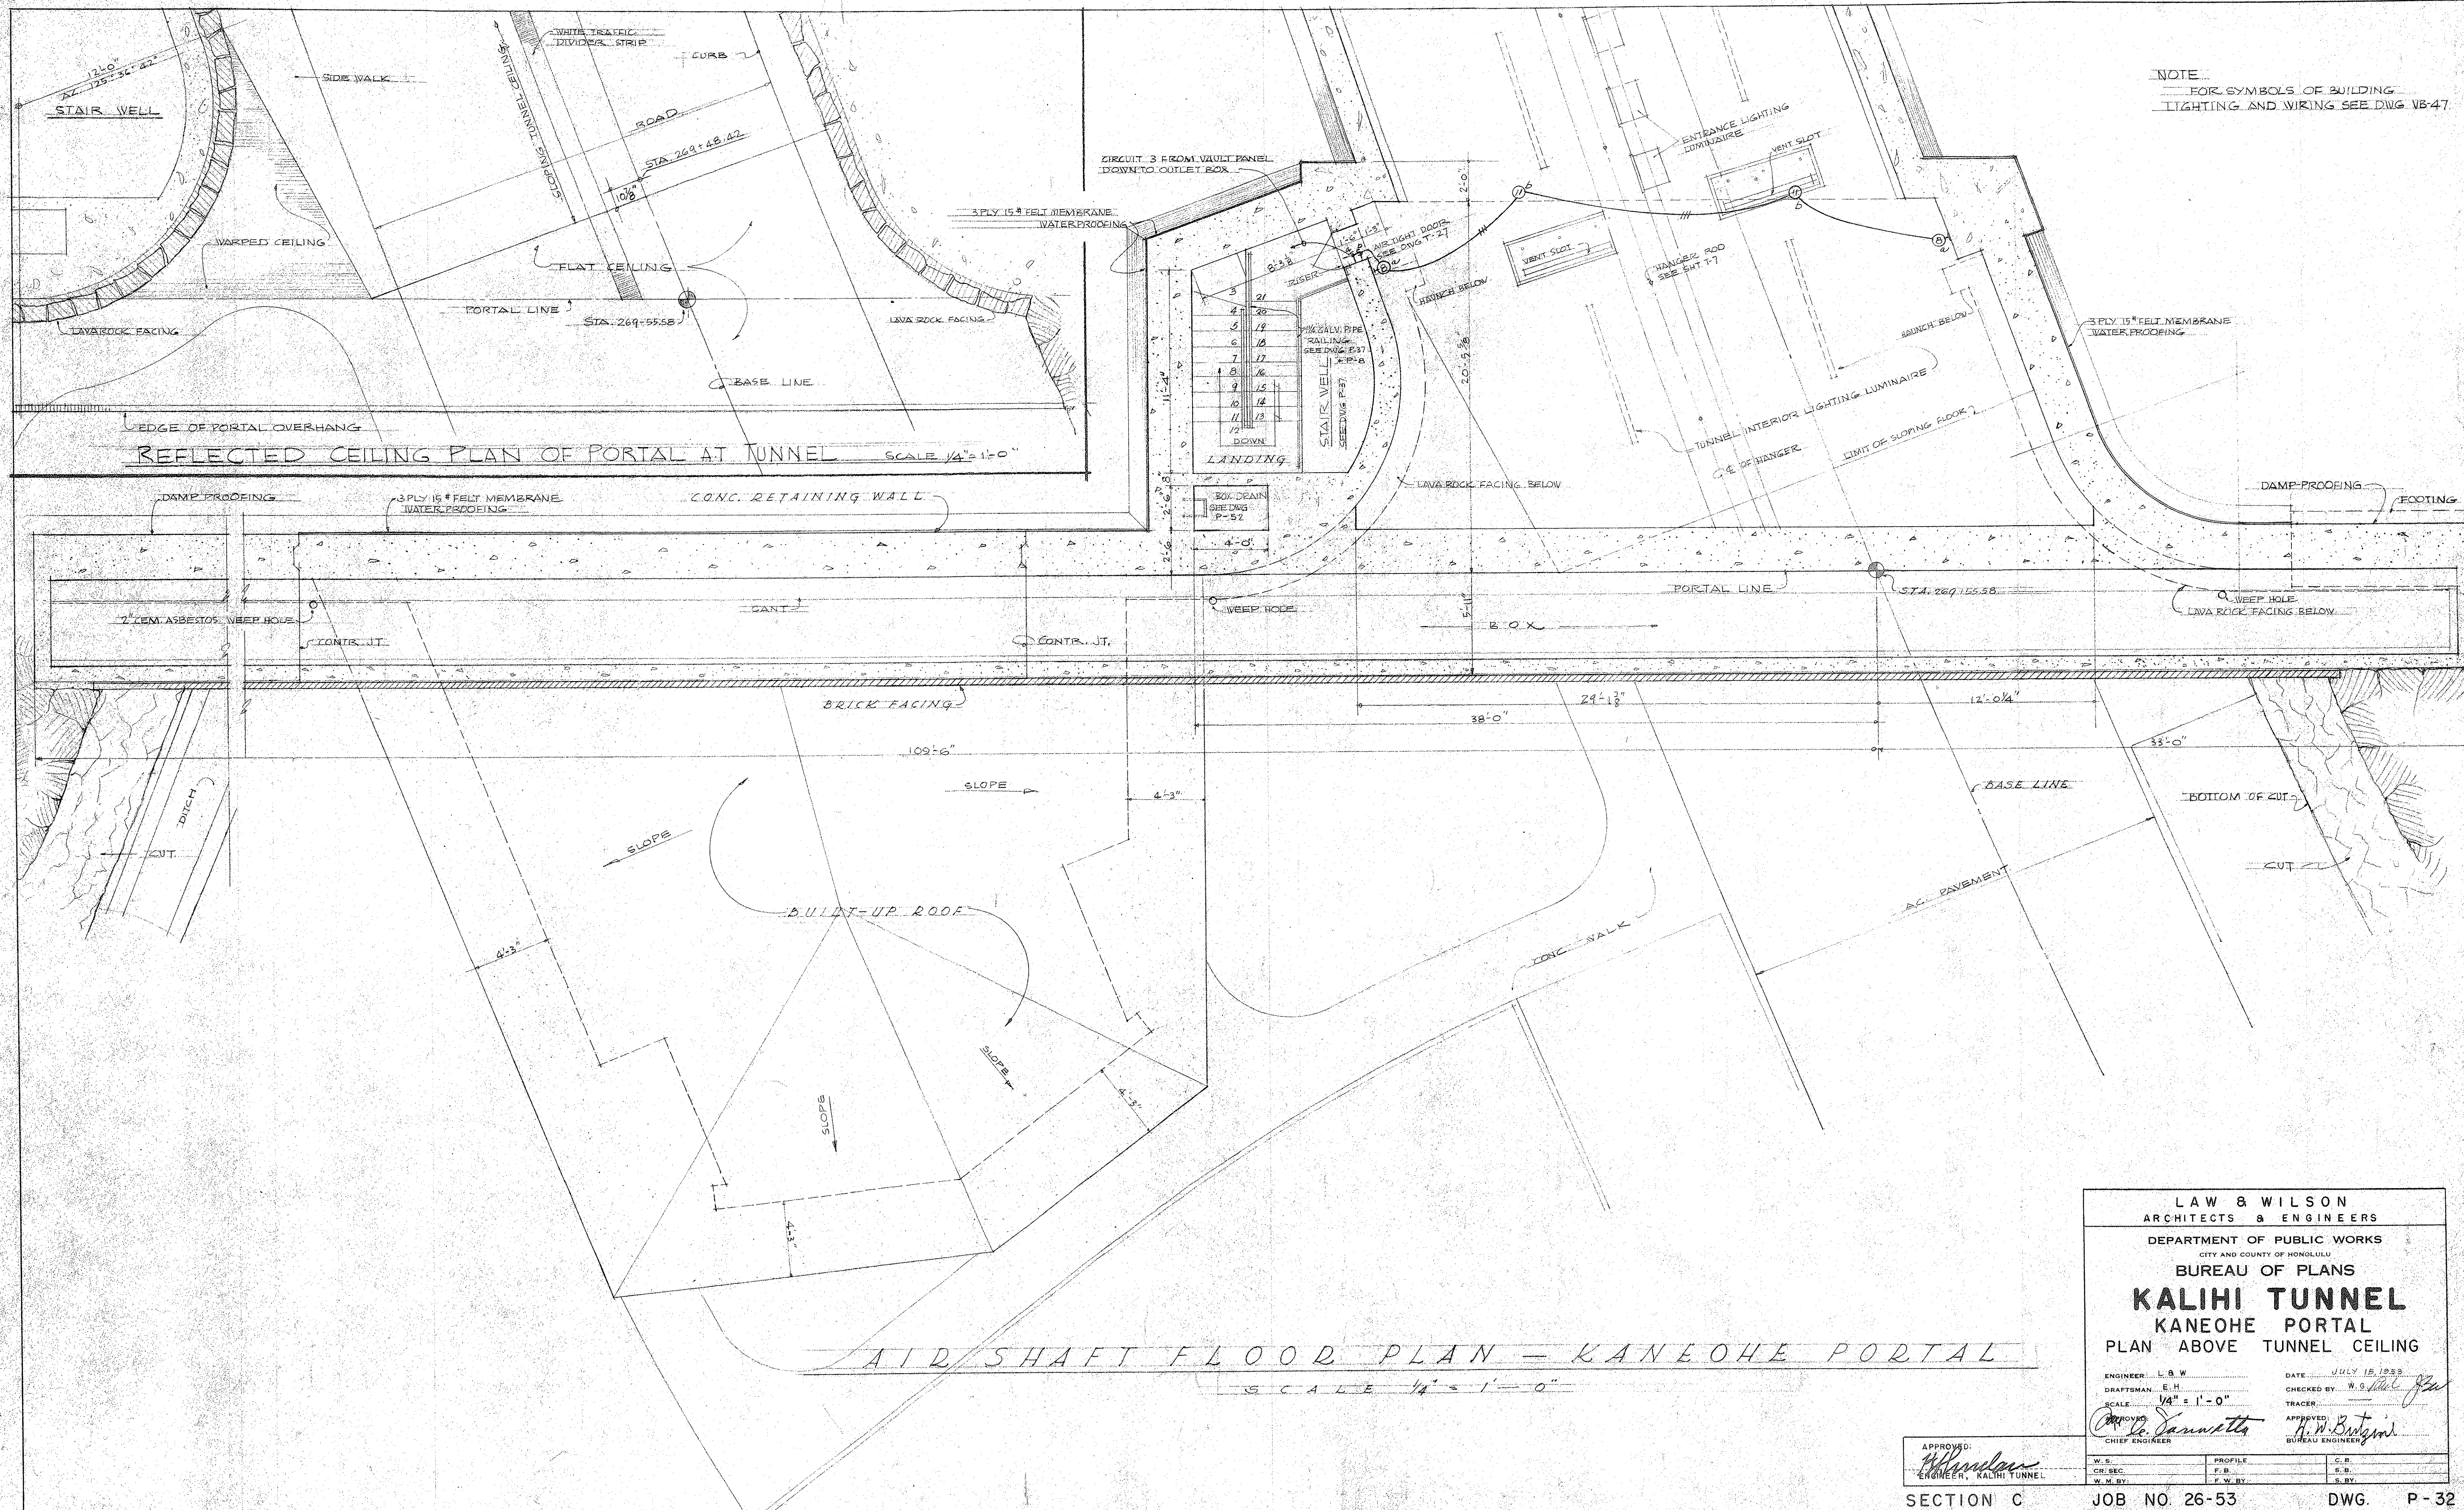

NOTE:
FOR SYMBOLS OF BUILDING
LIGHTING AND WIRING SEE DWG. VB-47

LAW & WILSON
ARCHITECTS & ENGINEERS
DEPARTMENT OF PUBLIC WORKS
CITY AND COUNTY OF HONOLULU
BUREAU OF PLANS
KALIHI TUNNEL
KANEOHE PORTAL
PLAN ABOVE TUNNEL CEILING

ENGINEER: L.B.W.
DRAFTSMAN: E.H.
SCALE: 1/4" = 1'-0"
APPROVED: *[Signature]*
CHIEF ENGINEER

DATE: JULY 15, 1933
CHECKED BY: *[Signature]*
TRACER:
APPROVED: *[Signature]*
BUREAU ENGINEER

W.S.	PROFILE	C.B.
CH. SEC.	P.B.	C.B.
W.W.B.V.	P.W.B.V.	S.B.V.

SECTION C JOB NO. 26-53 DWG. P-32