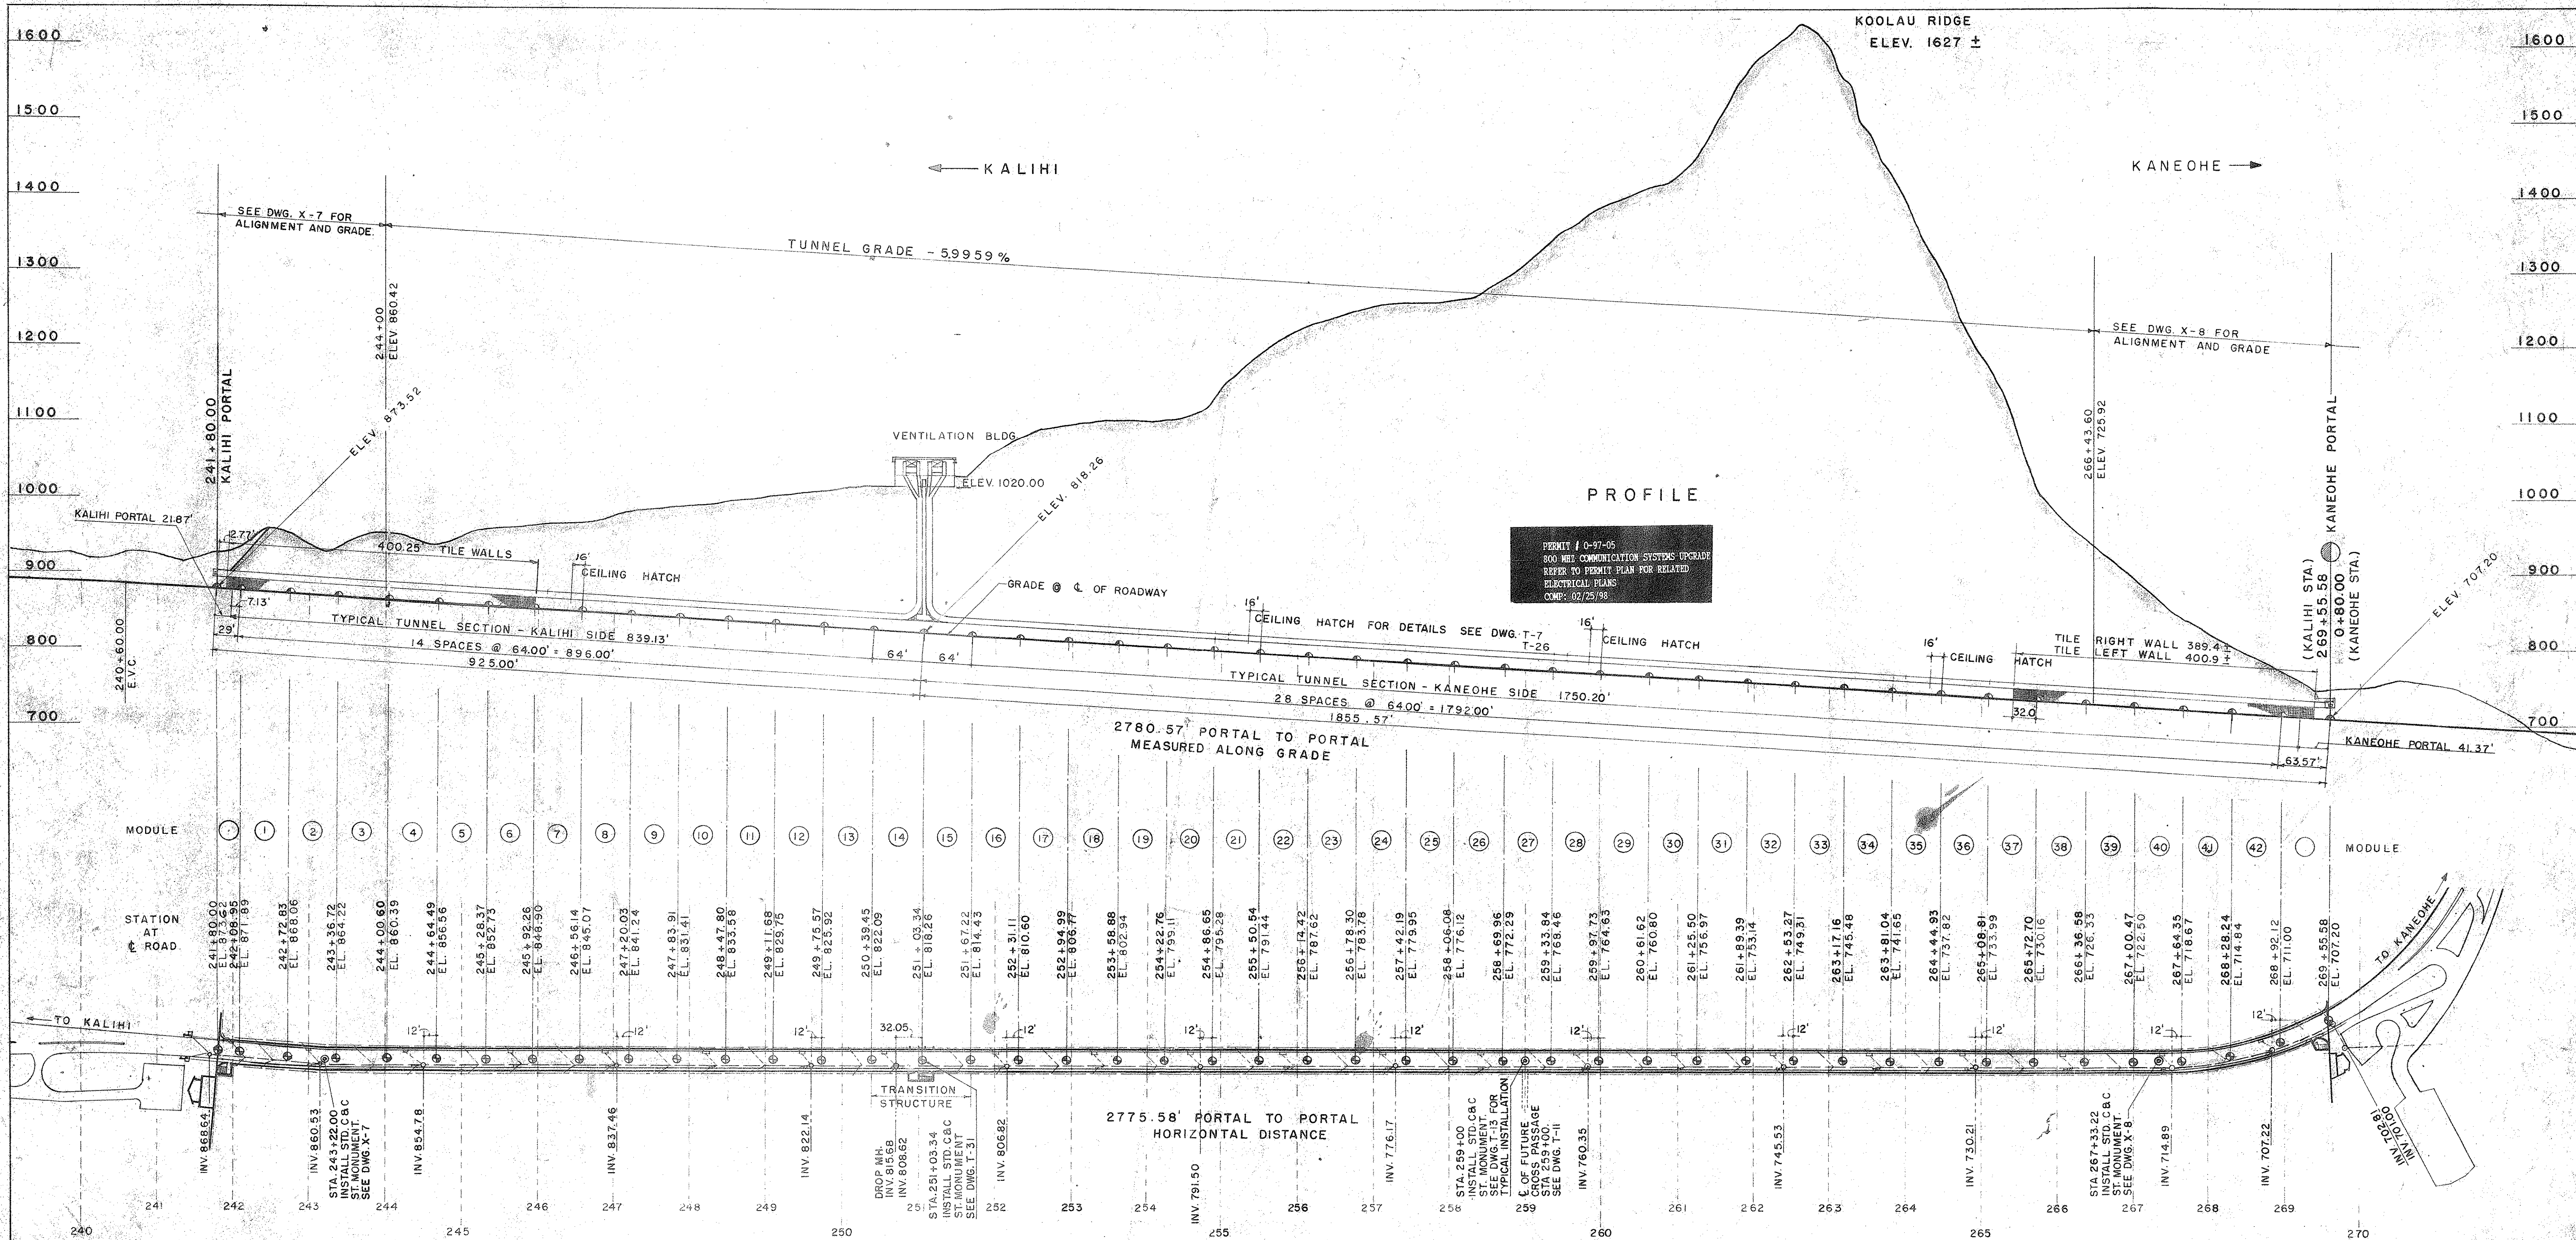


LAW & WILSON
ARCHITECTS & ENGINEERS
DEPARTMENT OF PUBLIC WORKS
CITY AND COUNTY OF HONOLULU
BUREAU OF PLANS
KALIHI TUNNEL
TUNNEL & SHAFT
PLAN & PROFILE

ENGINEER: *W. Lum* DATE: *JULY 18 1953*
DRAFTSMAN: *W.T.* CHECKED BY: *W. Lum*
SCALE: *1"=100'* TRACER: *K.M.*
APPROVED: *W. Lum* CHIEF ENGINEER
BUREAU ENGINEER

W.S.	PROFILE	C.B.
CR. SEC.	F.B.	S.B.
W.M. BY	F.W. BY	S. BY