


SECTION A-A
SCALE 1/2"=1'-0" SEE DWG. T-32

SECTION 'B-B'


SCALE 1/2" = 1' - 0" SEE DWG. T-32

REIN. FOR SHAFT
SCALE 5/8" = 1'-0"

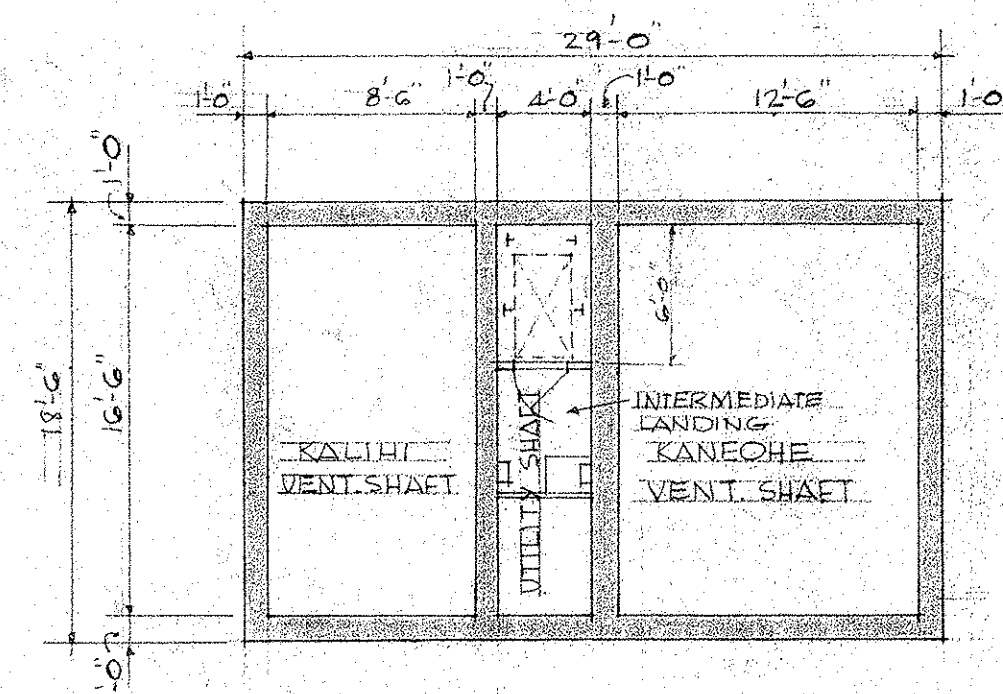


PLAN OF SHAFT

SCALE $\frac{1}{8}'' = 1' - 0''$

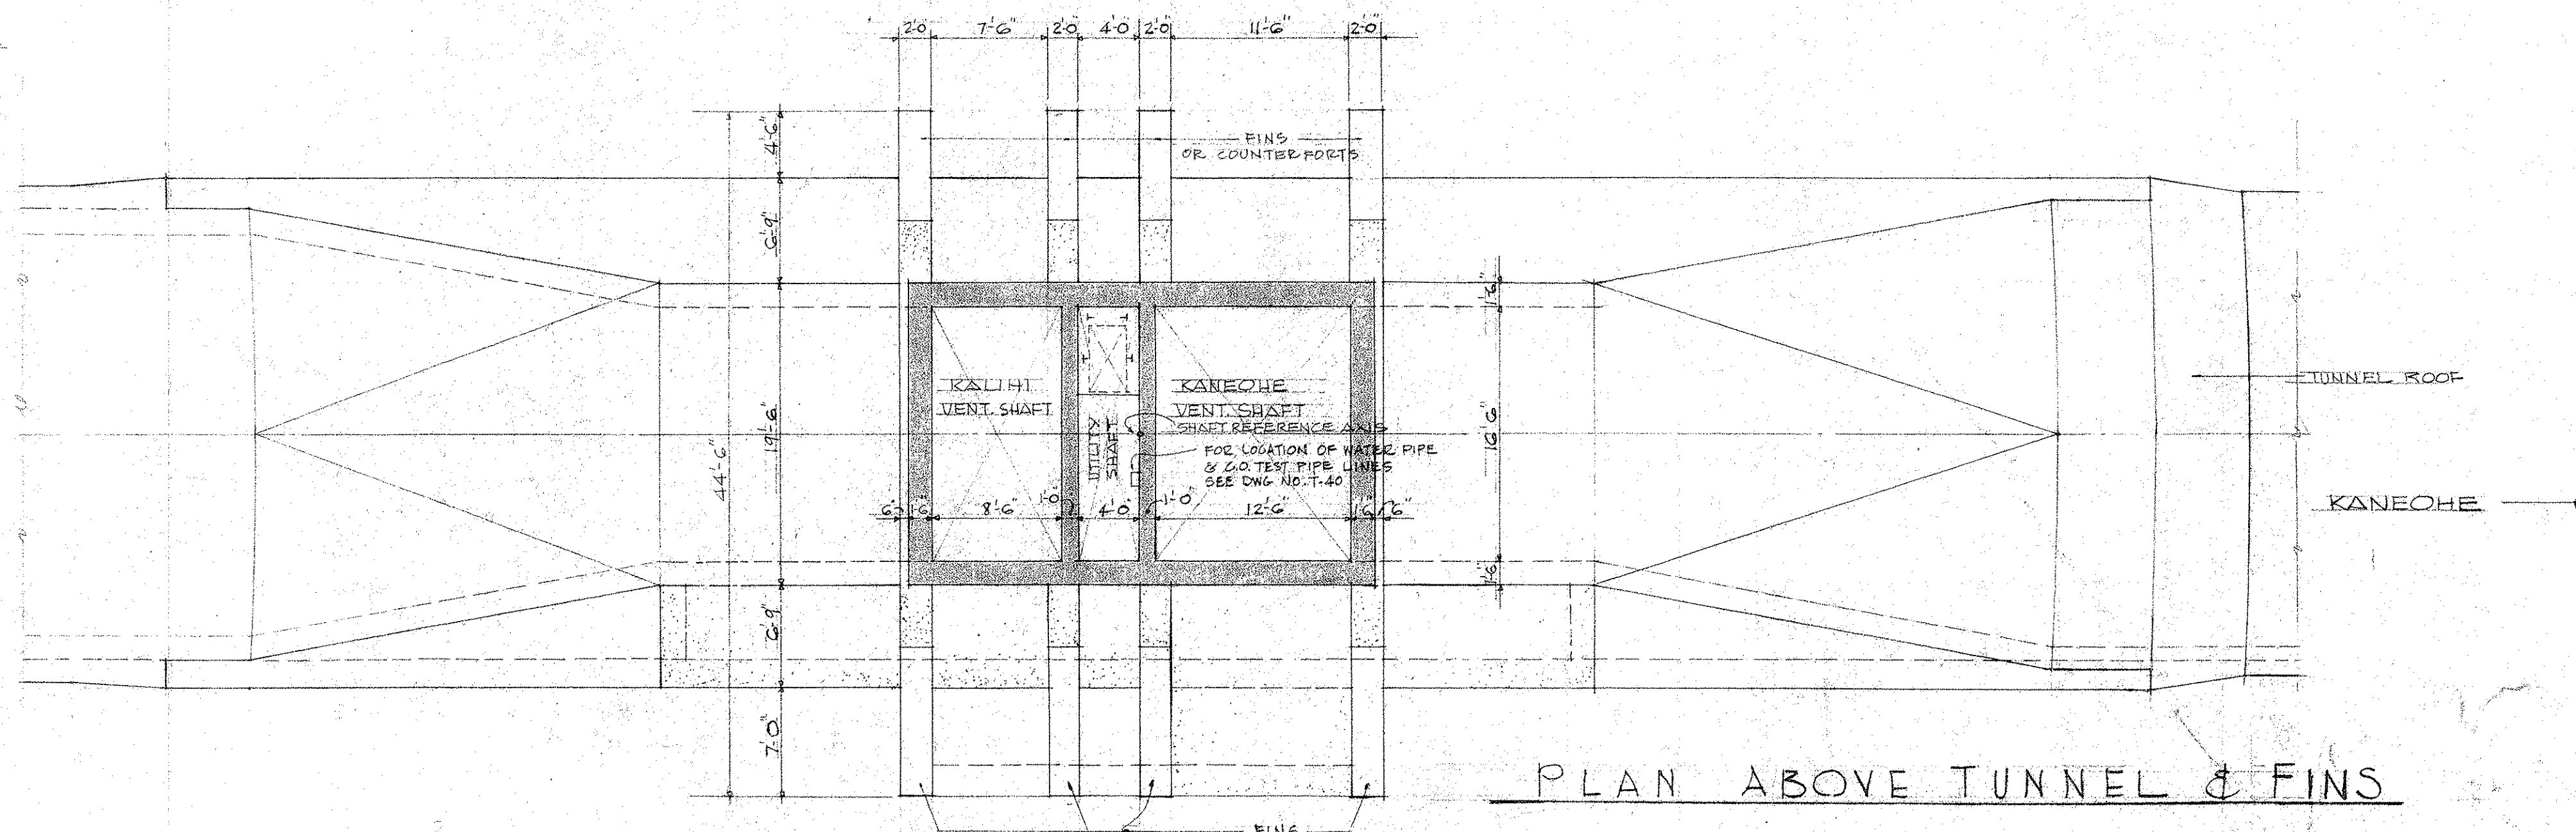

PLAN ABOVE TUNNEL & FINS

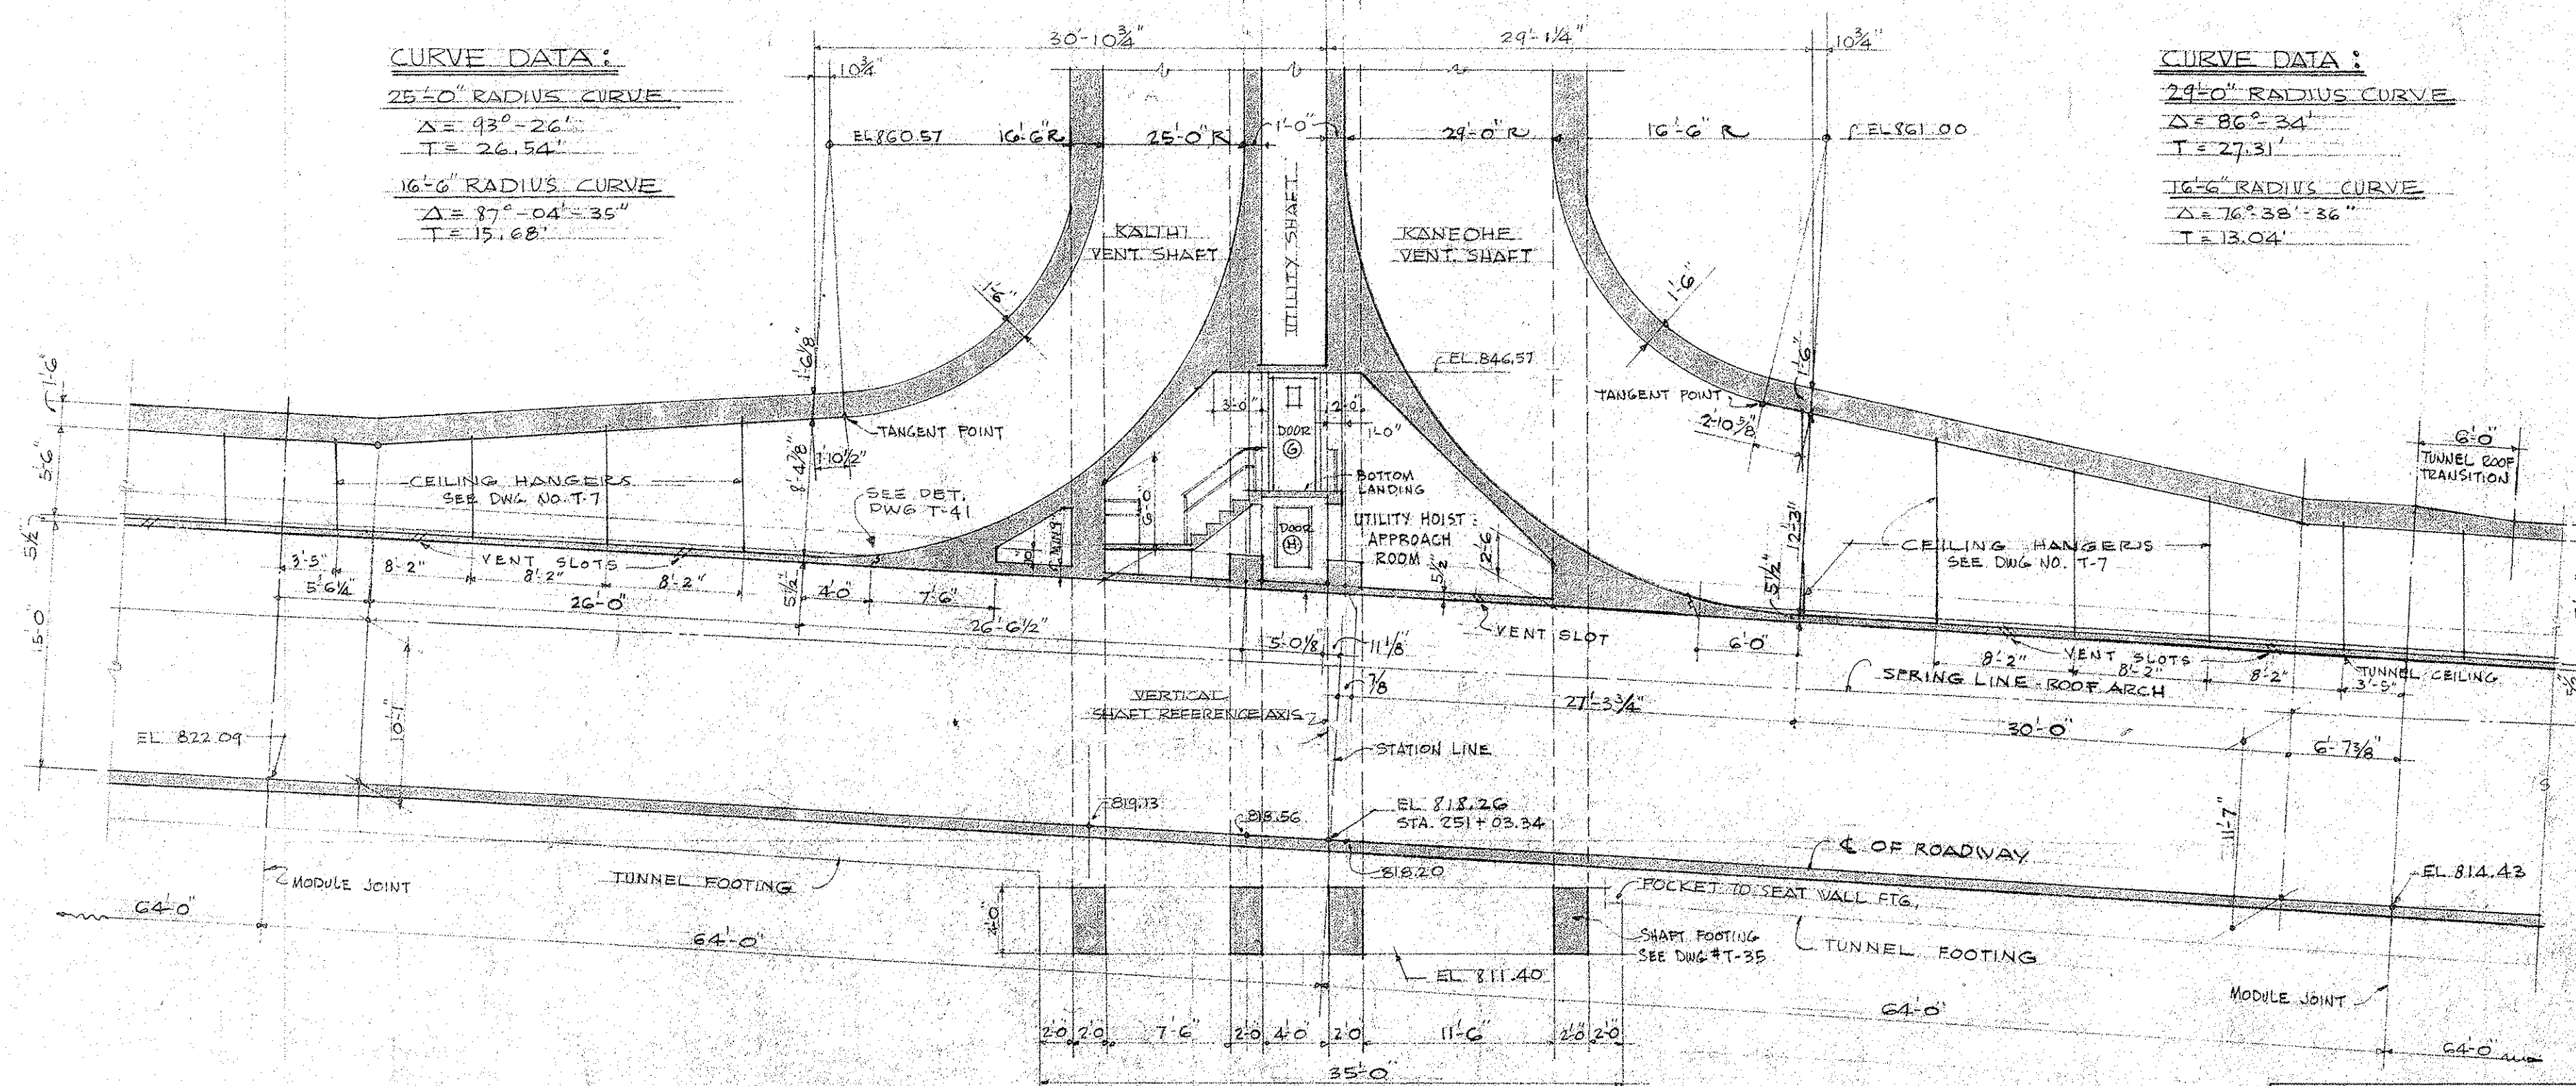

LONGITUDINAL SECTION
SCALE 1/8" = 1'-0"

DEPARTMENT OF PUBLIC WORKS
CITY AND COUNTY OF HONOLULU
BUREAU OF PLANS

KALIHI TUNNEL

TUNNEL & SHAFT - TRANSITION

PLANS ABOVE TUNNEL & SECTION

ENGINEER, W. LUM, P.E. DATE JULY 19, 1953
 DRAFTSMAN, R.C. CHECKED BY W. LUM, P.E.
 SCALE UNASSIGNED TRACER, P.K.
 APPROVED: [Signature] APPROVED: [Signature]
 CHIEF ENGINEER BUREAU ENGINEER

W. S.	PROFILE	C. S.
C.R. SEC.	F. B.	F. S.
W. M. BY	F. W. BY	S. BY

JOB NO. 26-53 DWG. T-33