


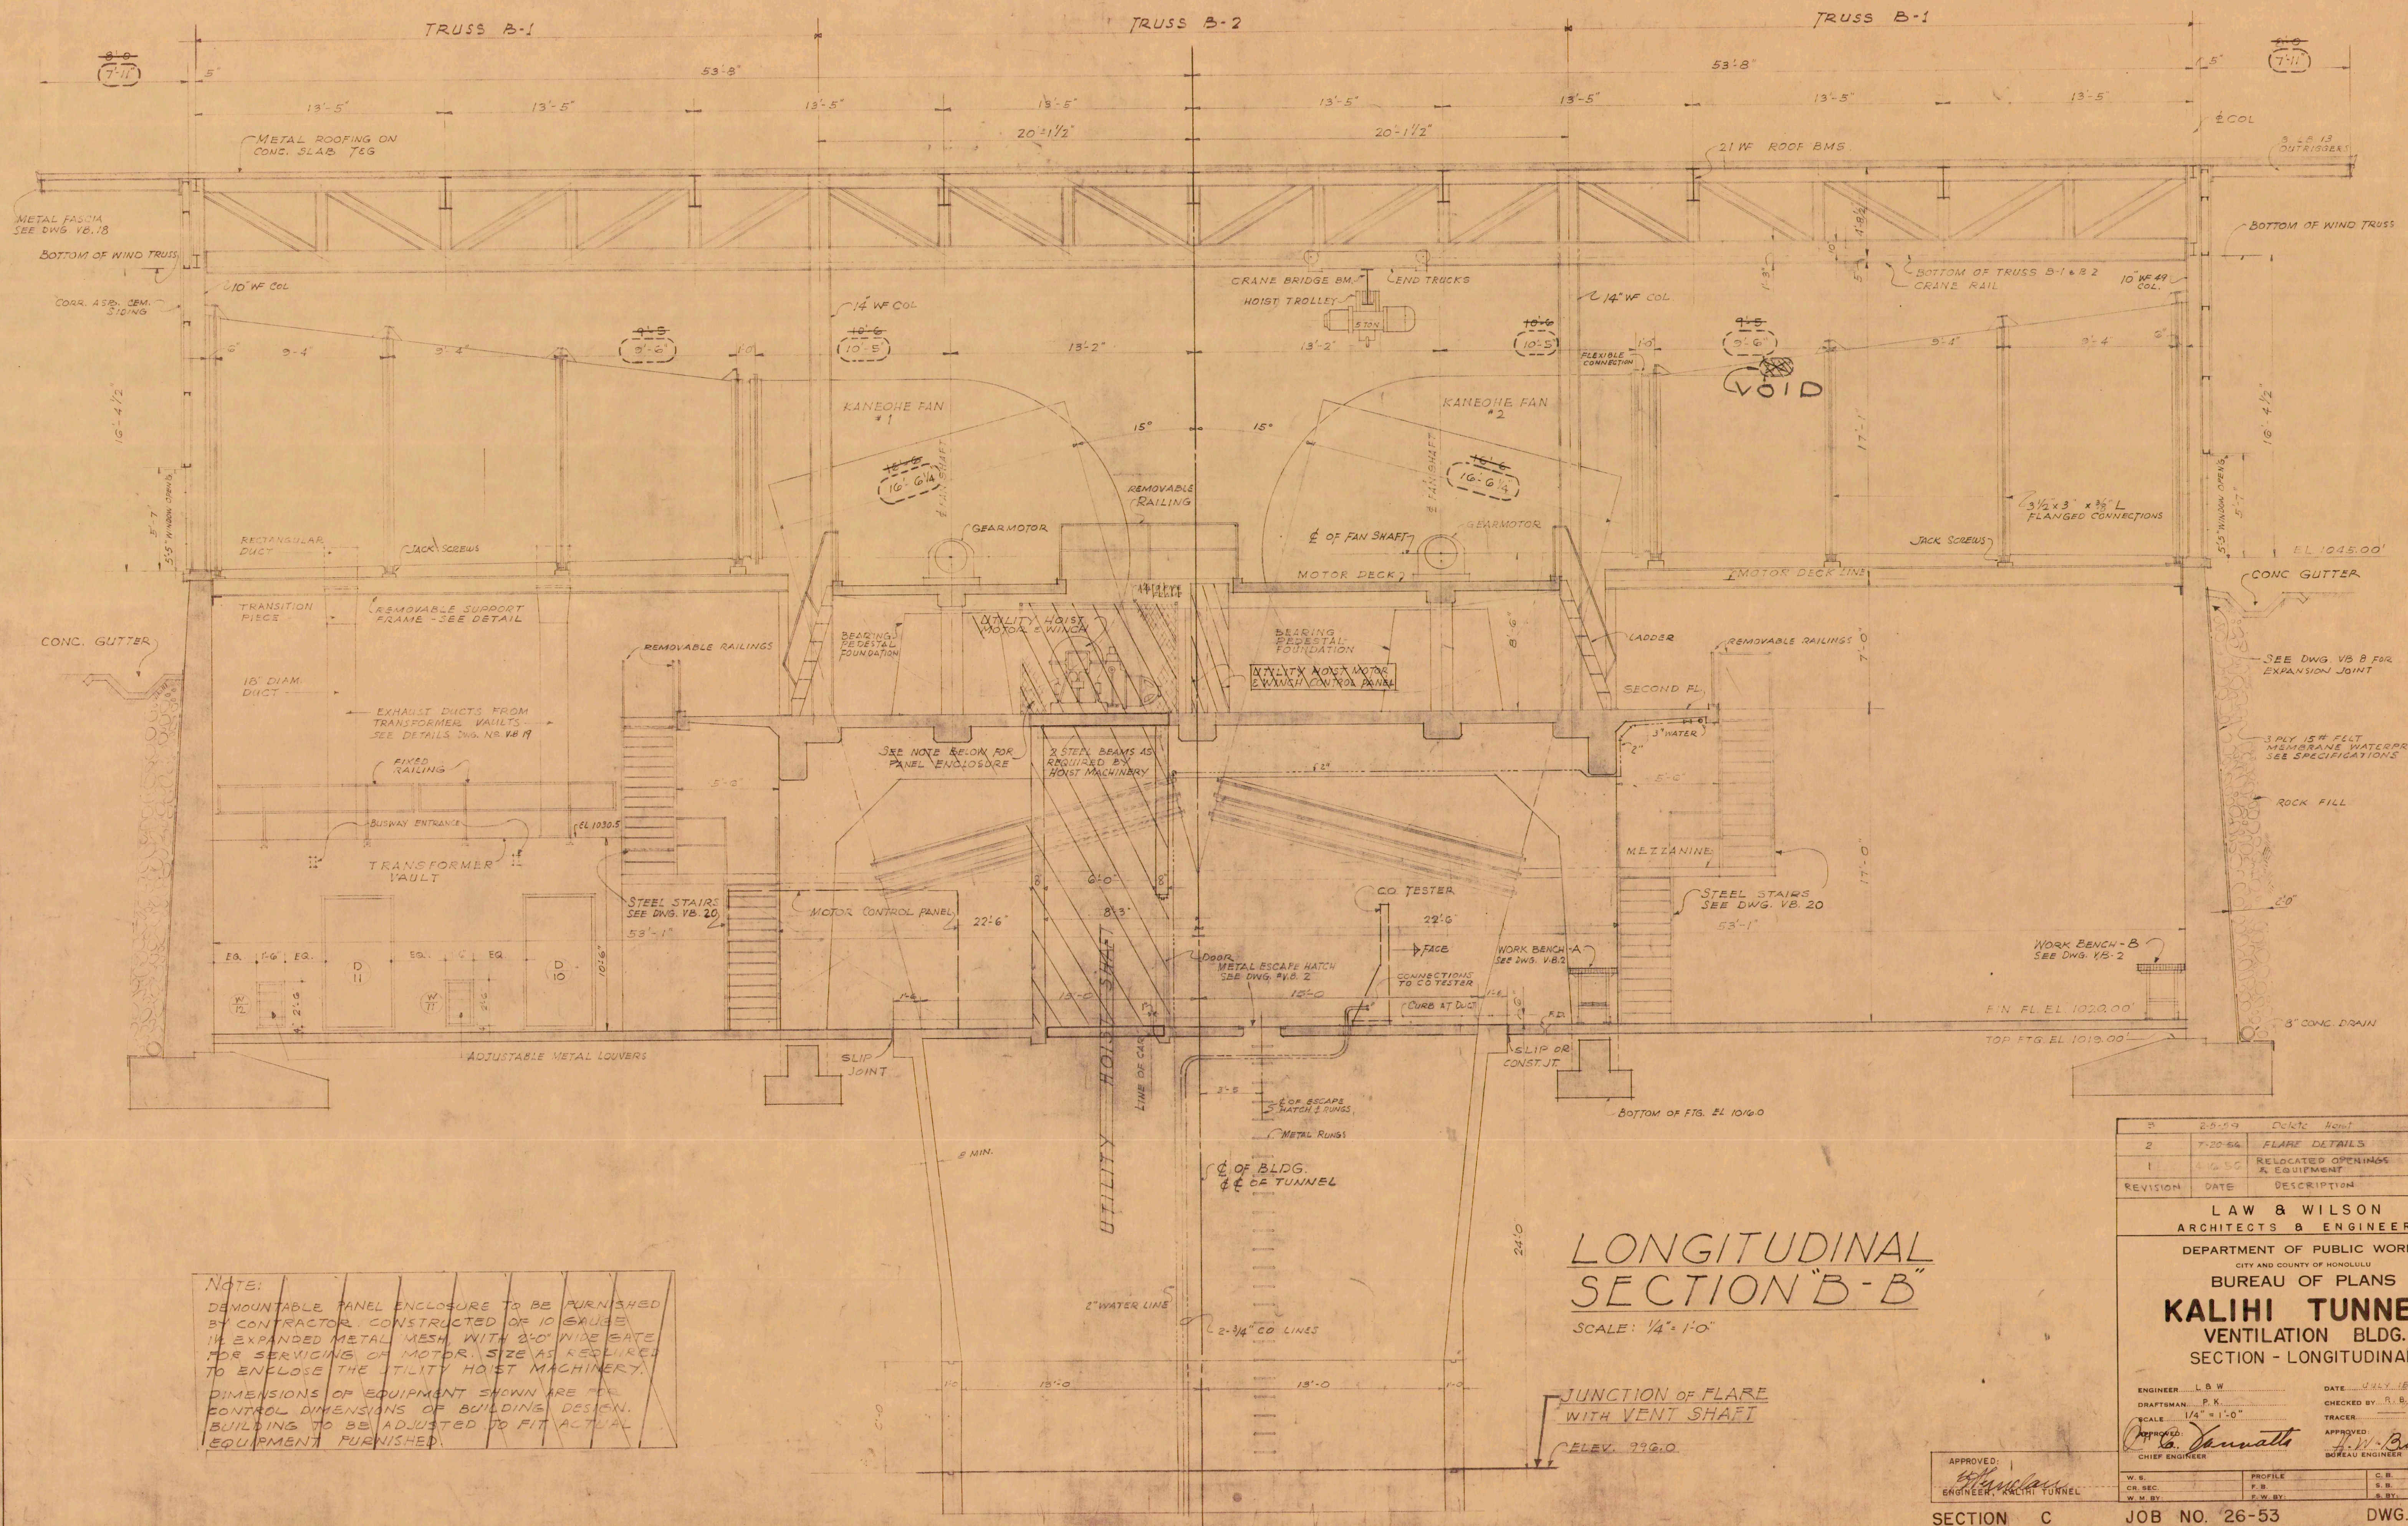

NOTE:
 DEMOUNTABLE PANEL ENCLOSURE TO BE FURNISHED BY CONTRACTOR. CONSTRUCTED OF 10 GAUGE 1/4" EXPANDED METAL MESH, WITH 2'-0" WIDE GATE FOR SERVICING OF MOTOR. SIZE AS REQUIRED TO ENCLOSE THE UTILITY HOIST MACHINERY.
 DIMENSIONS OF EQUIPMENT SHOWN ARE FOR CONTROL DIMENSIONS OF BUILDING DESIGN. BUILDING TO BE ADJUSTED TO FIT ACTUAL EQUIPMENT FURNISHED.

LONGITUDINAL SECTION "B-B" SCALE: 1/4" = 1'-0"

JUNCTION OF FLARE
 WITH VENT SHAFT
 ELEV. 996.0

REVISION	DATE	DESCRIPTION	MADE BY	CHECKED BY
3	2-2-59	DECK & HOIST	E. Miller	
2	7-20-56	FLARE DETAILS	RM	DO
1	4-16-56	RELOCATED OPENINGS & EQUIPMENT	E.V.	DO

LAW & WILSON
 ARCHITECTS & ENGINEERS
 DEPARTMENT OF PUBLIC WORKS
 CITY AND COUNTY OF HONOLULU
BUREAU OF PLANS
KALIHI TUNNEL
 VENTILATION BLDG.
 SECTION - LONGITUDINAL

ENGINEER: L.W. DATE: JULY 15, 1959
 DRAFTSMAN: P.K. CHECKED BY: R.B.
 SCALE: 1/4" = 1'-0" TRACER:
 APPROVED: *[Signature]* APPROVED: *[Signature]*
 CHIEF ENGINEER BUREAU ENGINEER

W.S.	PROFILE	C.B.
CR. SEC.	P.B.	S.B.
W.M. BY	F.W. BY	S.B.

SECTION C JOB NO. 26-53 DWG. VB-9