



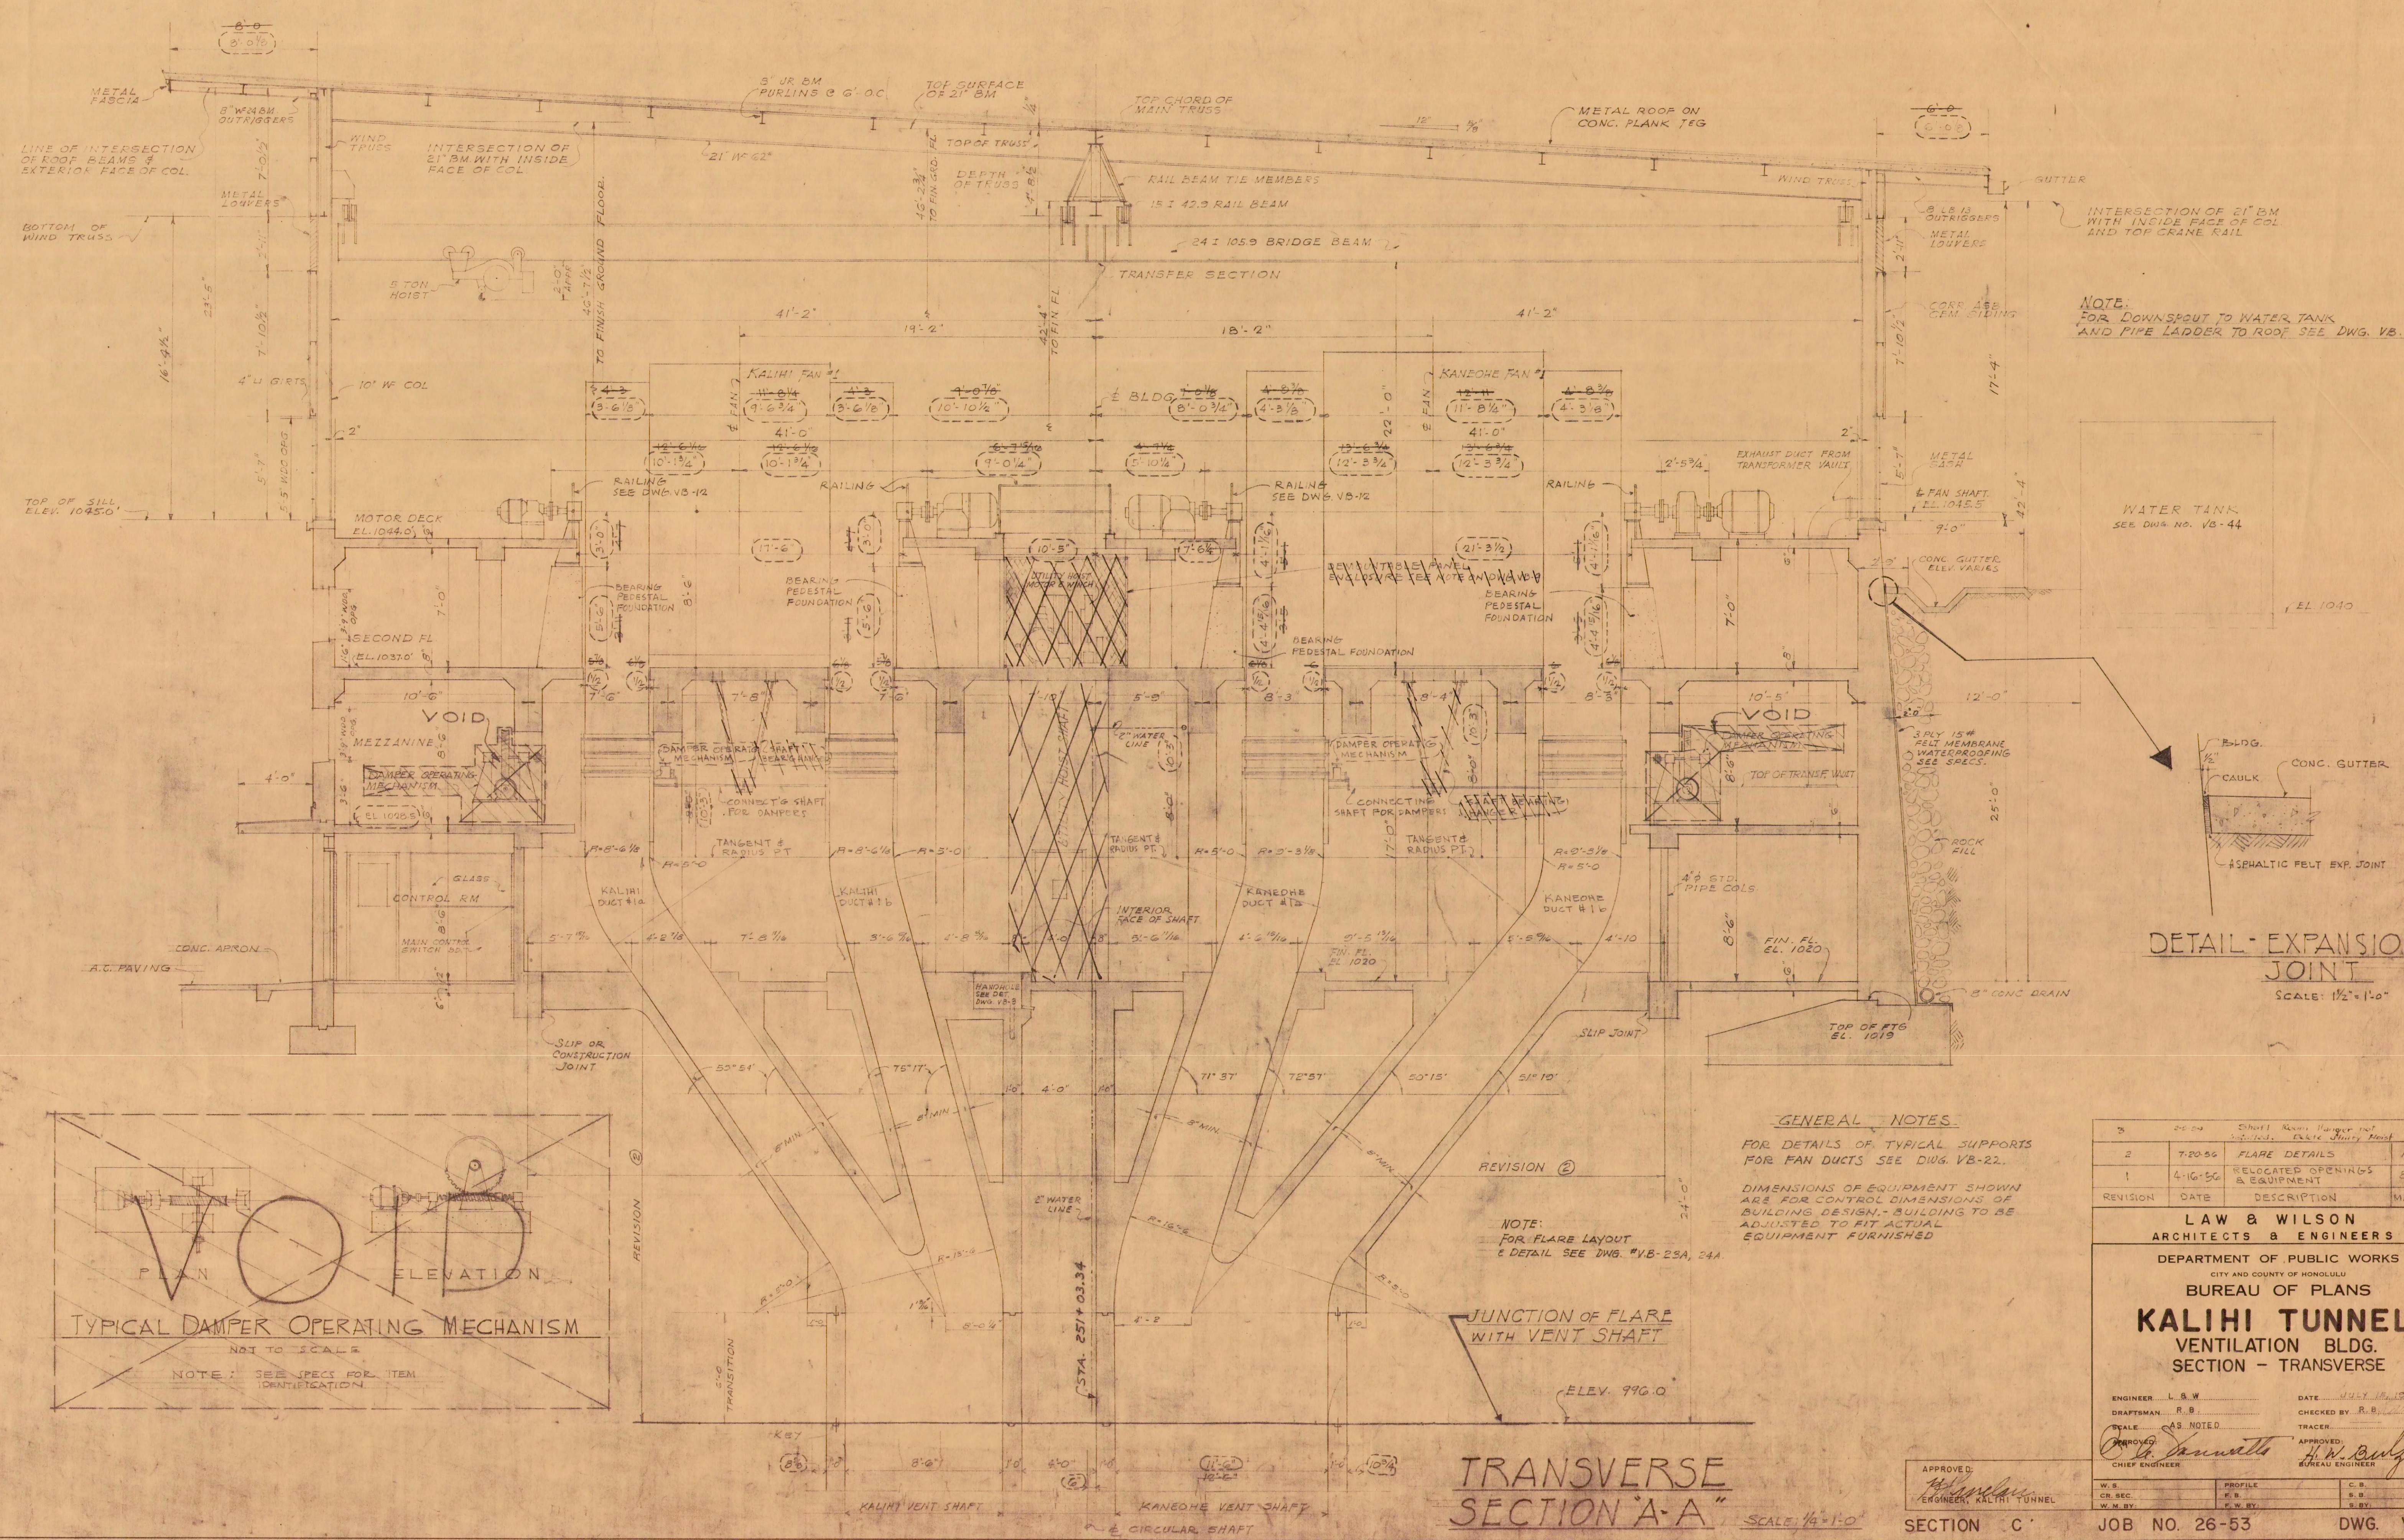

NOTE:
FOR DOWNSPOUT TO WATER TANK
AND PIPE LADDER TO ROOF SEE DWG. VB-18

WATER TANK
SEE DWG. NO. VB-44

DETAIL - EXPANSION
JOINT
SCALE: 1/2" = 1'-0"

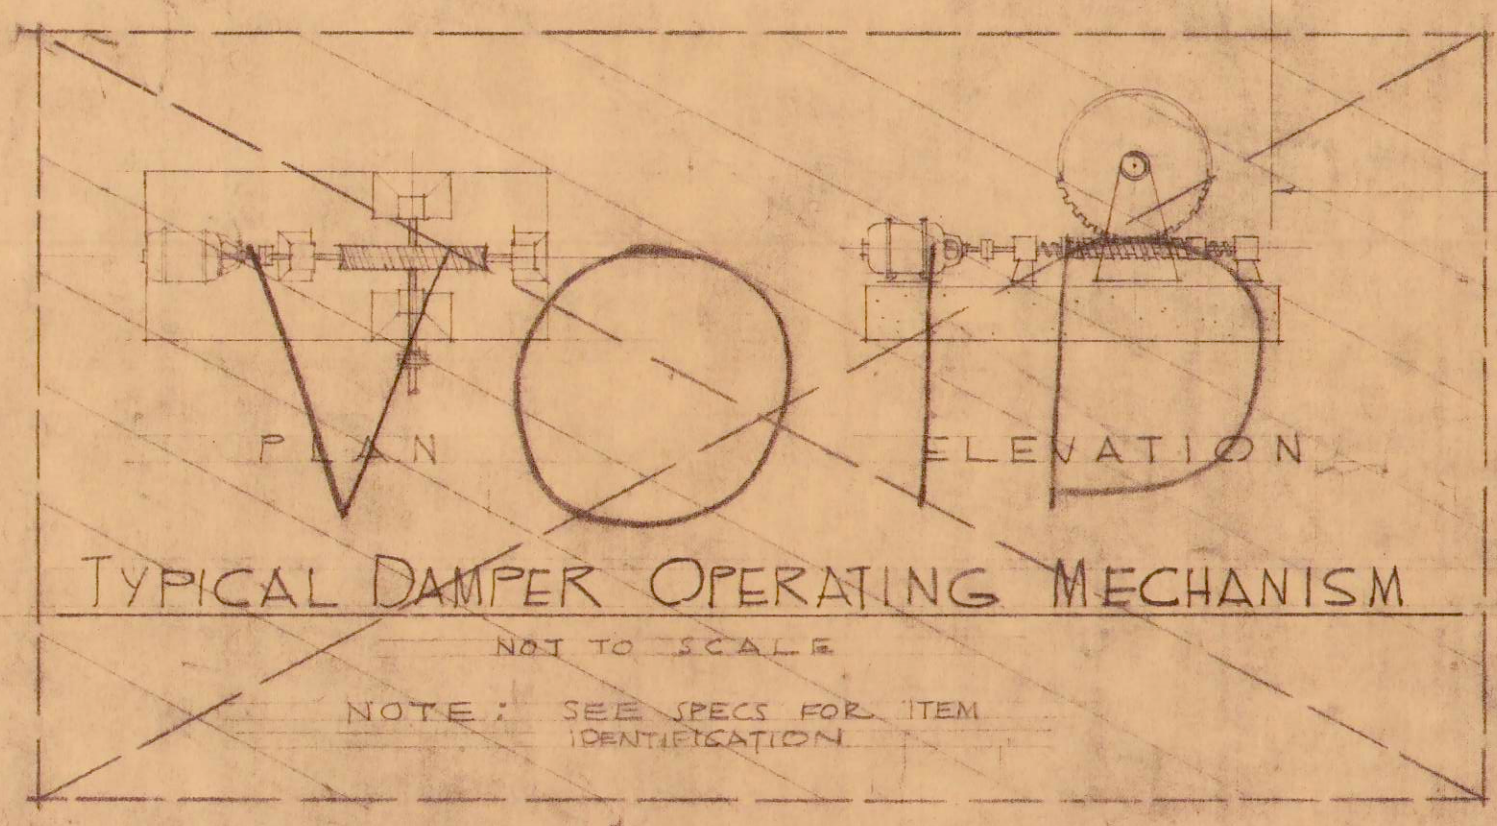

GENERAL NOTES
FOR DETAILS OF TYPICAL SUPPORTS
FOR FAN DUCTS SEE DWG. VB-22.
DIMENSIONS OF EQUIPMENT SHOWN
ARE FOR CONTROL DIMENSIONS OF
BUILDING DESIGN. BUILDING TO BE
ADJUSTED TO FIT ACTUAL
EQUIPMENT FURNISHED

TRANSVERSE
SECTION A-A
SCALE: 1/4" = 1'-0"

REVISION	DATE	DESCRIPTION	MADE BY	CHECKED BY
3	7-20-56	FLARE DETAILS	HM	JD
2	7-20-56	RELOCATED OPENINGS & EQUIPMENT	E.V.	JD
1	4-16-56			

LAW & WILSON
ARCHITECTS & ENGINEERS
DEPARTMENT OF PUBLIC WORKS
CITY AND COUNTY OF HONOLULU
BUREAU OF PLANS
KALIHI TUNNEL
VENTILATION BLDG.
SECTION - TRANSVERSE

ENGINEER: L.B.W. DATE: JULY 18, 1953
DRAFTSMAN: R.B. CHECKED BY: R.B.
SCALE: AS NOTED TRACER:
APPROVED: *[Signature]* APPROVED: *[Signature]*
CHIEF ENGINEER BUREAU ENGINEER

W.B. PROFILE C.B.
CR. SEC. P.B. S.B.
W.M. BY C.W. BY S.B.

SECTION C JOB NO. 26-53 DWG. VB-8