

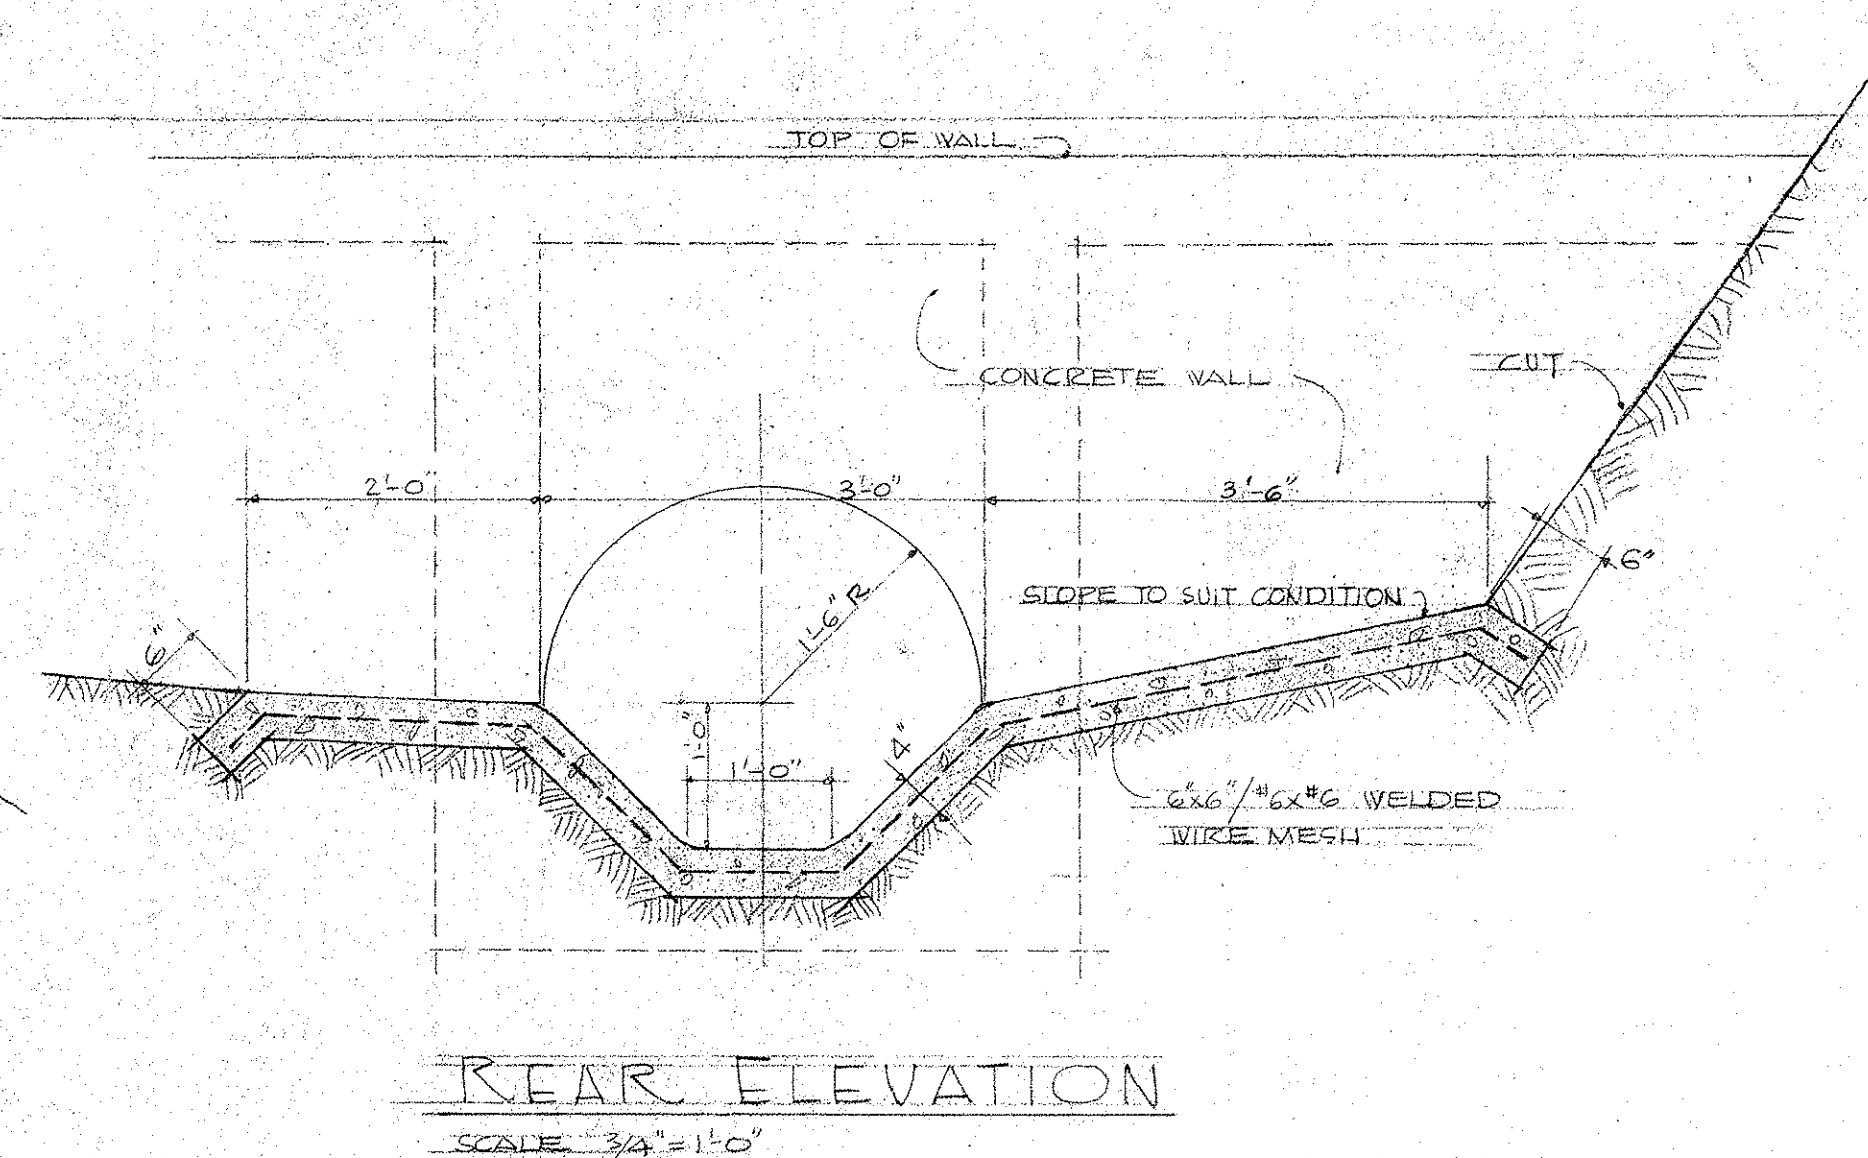
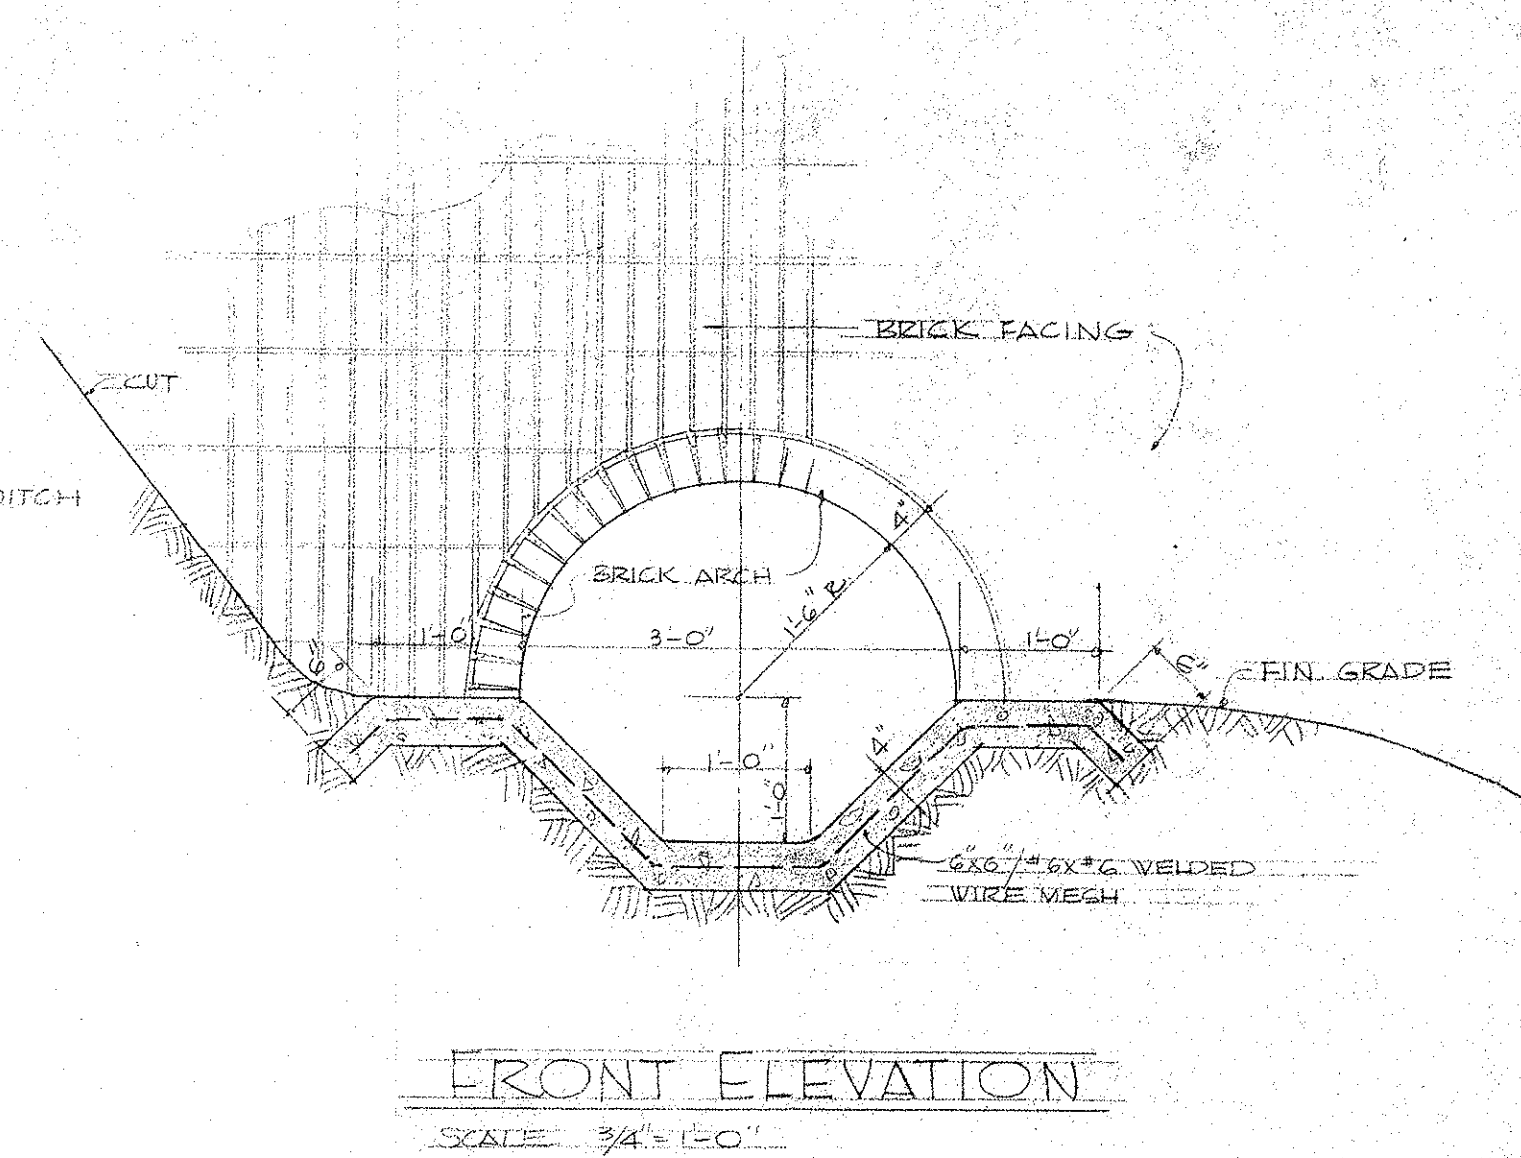
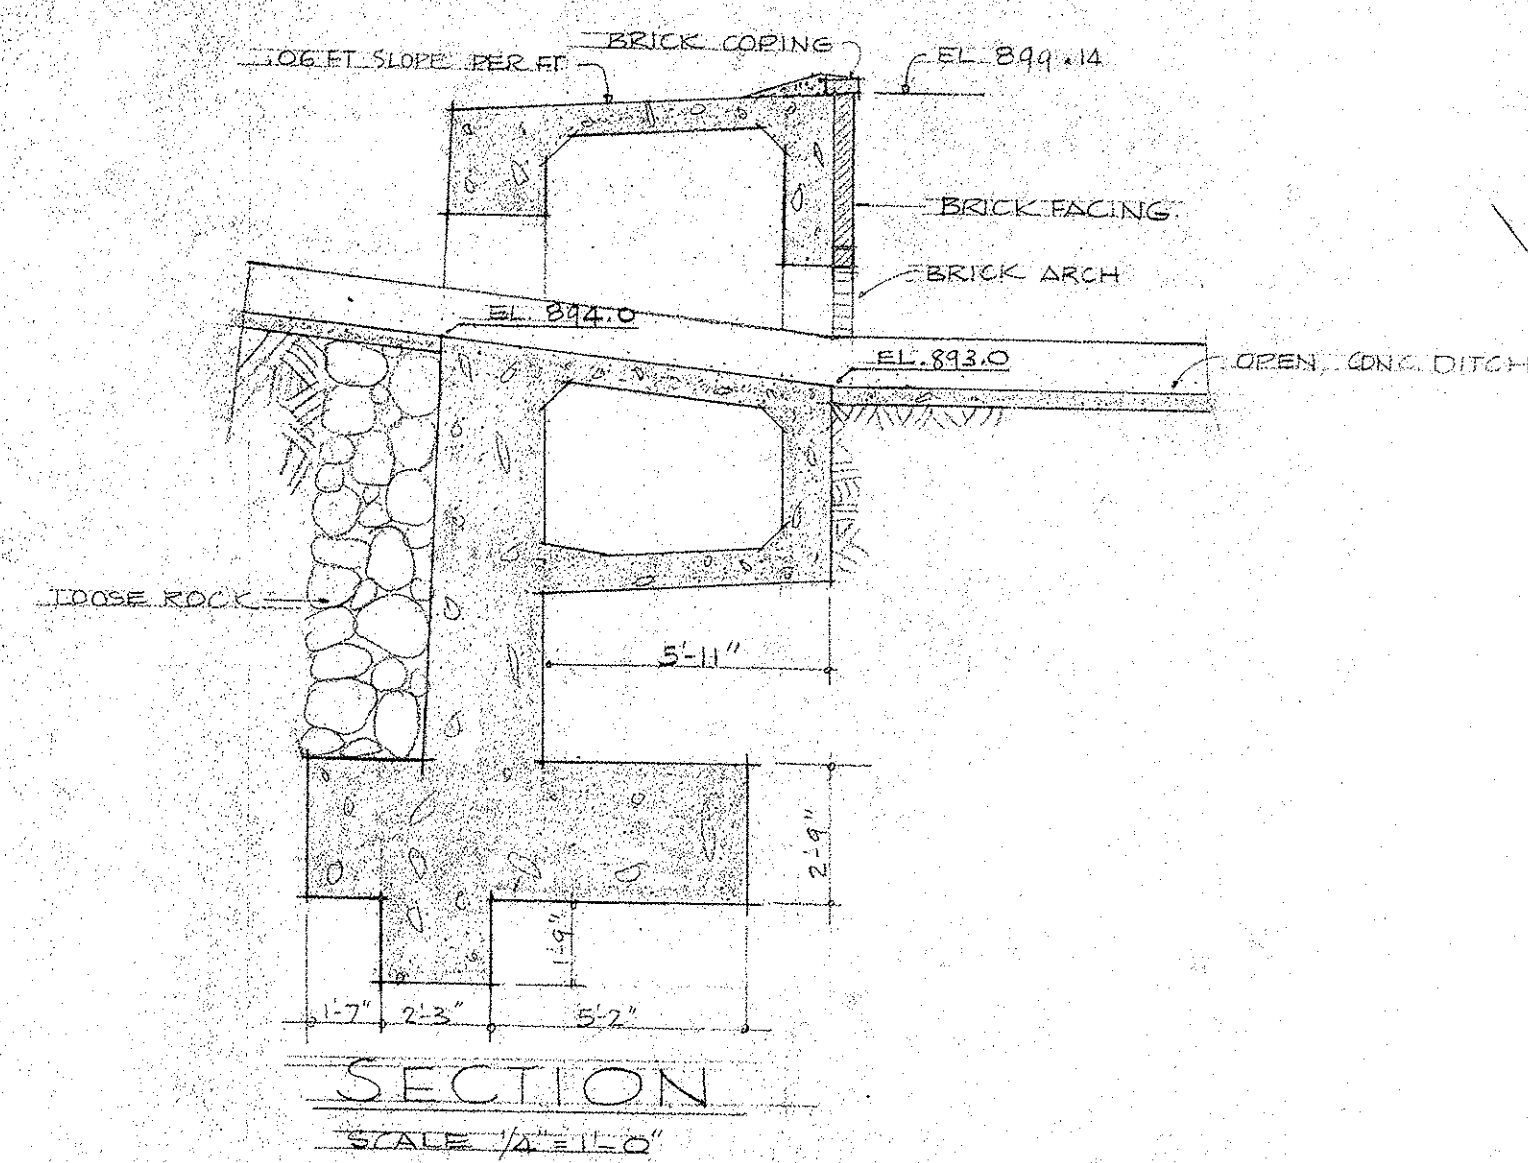


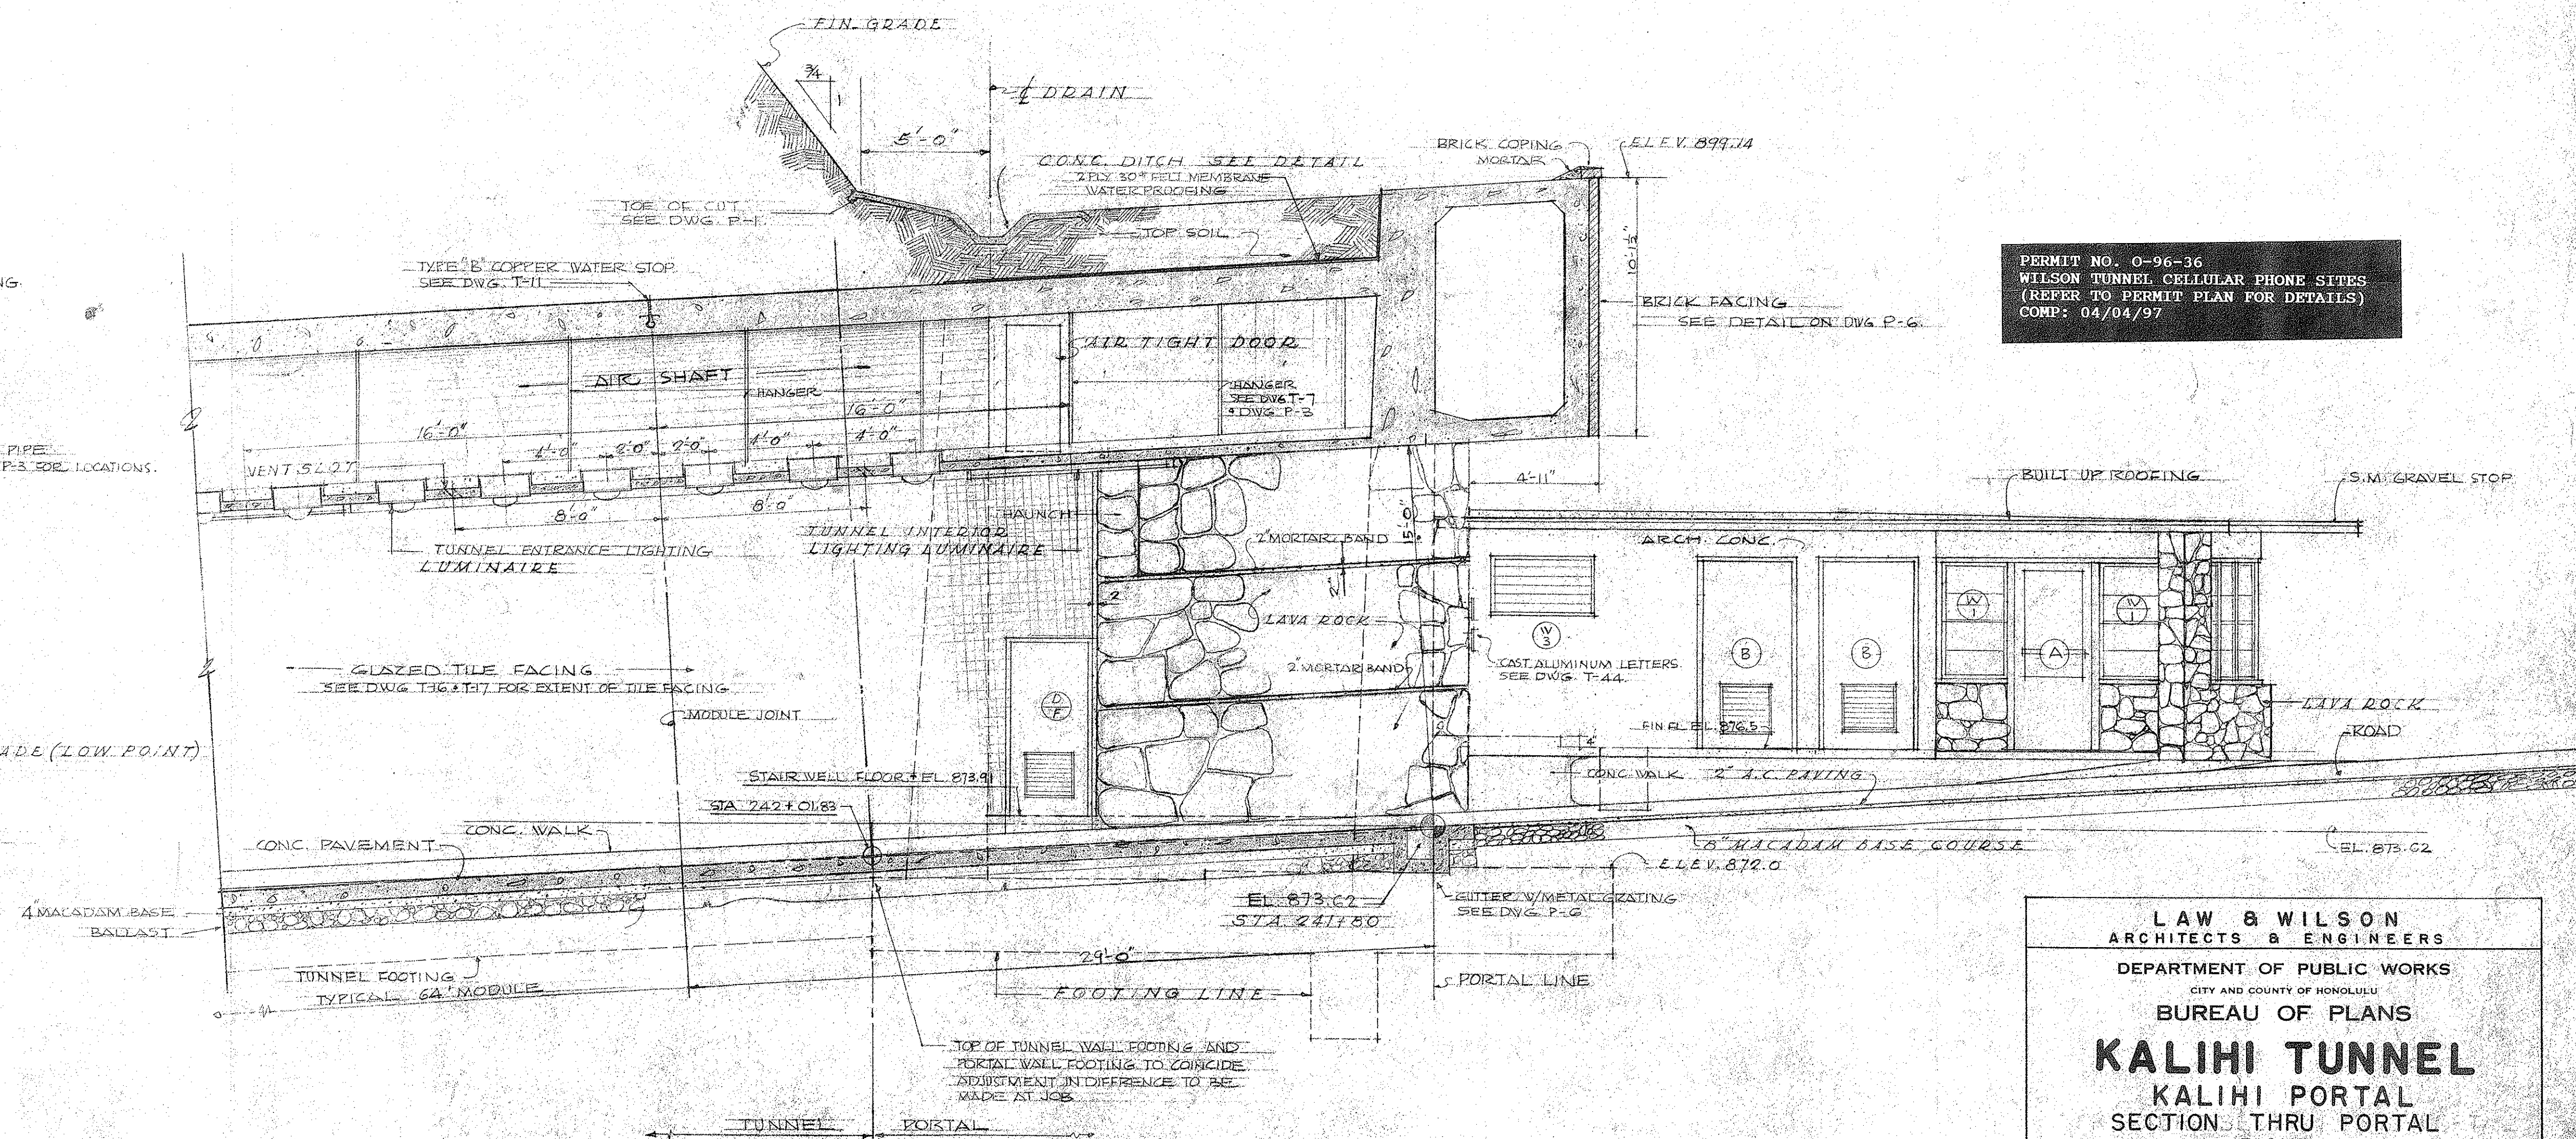

DETAIL OF BOX CULVERT THRU PORTAL AND OPEN CONC. DITCH

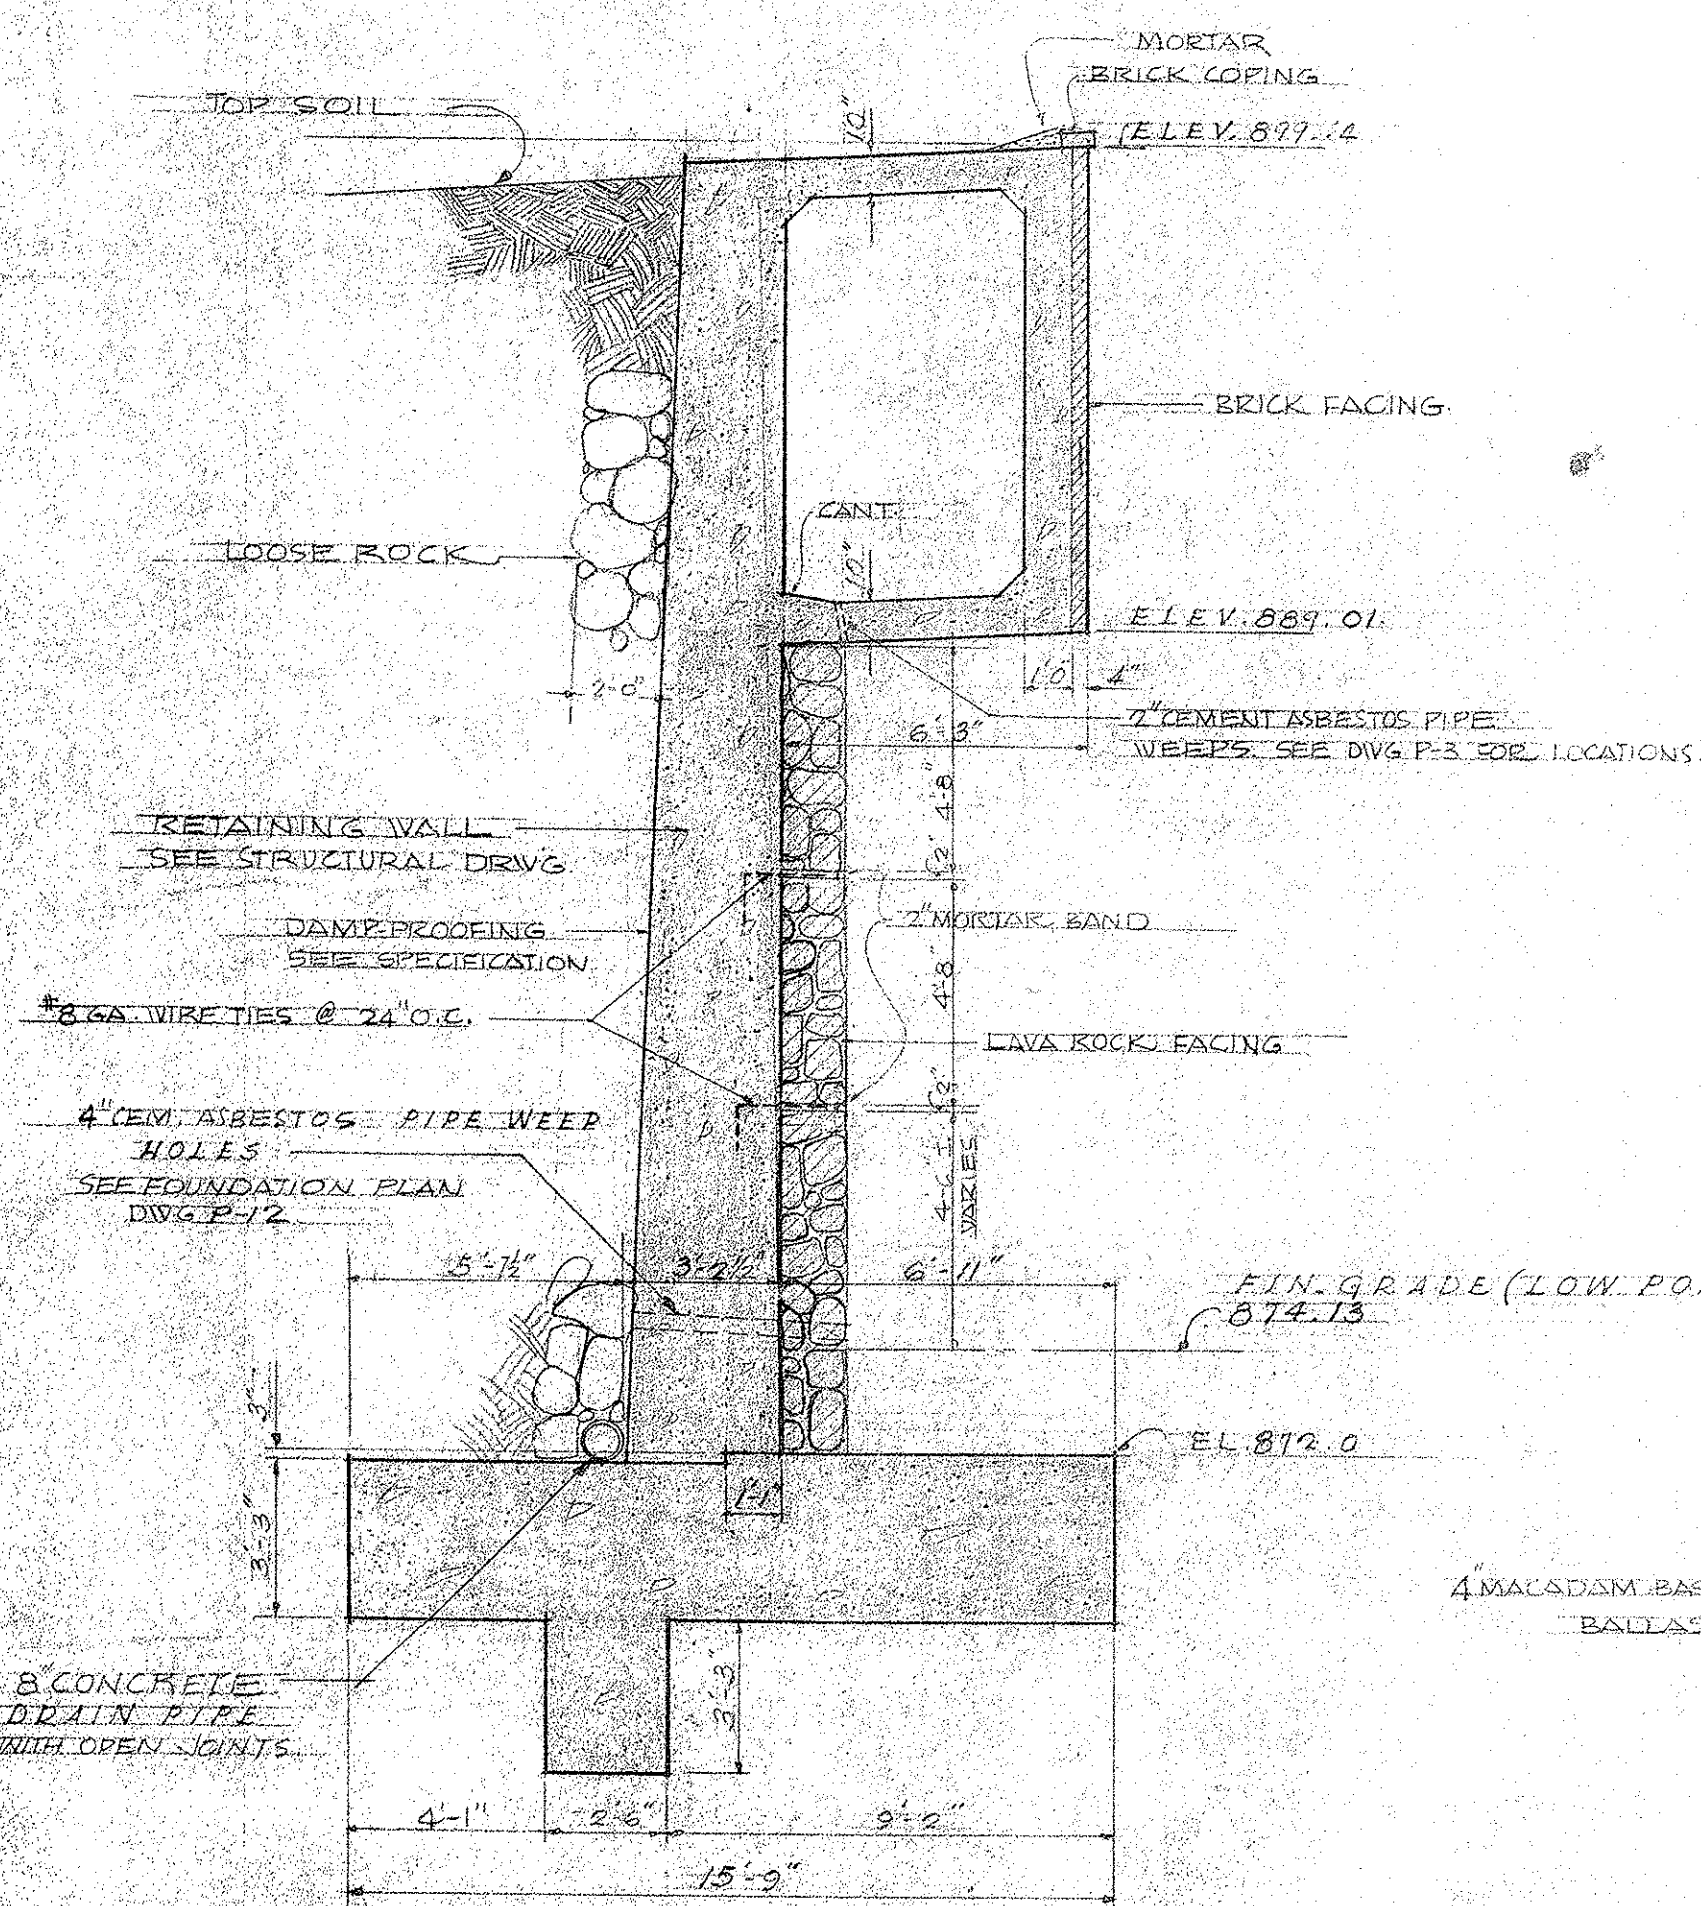

PERMIT NO. 0-96-36
WILSON TUNNEL CELLULAR PHONE SITES
(REFER TO PERMIT PLAN FOR DETAILS)
COMP: 04/04/97

LAW & WILSON
ARCHITECTS & ENGINEERS

DEPARTMENT OF PUBLIC WORKS
CITY AND COUNTY OF HONOLULU

BUREAU OF PLANS

KALIHI TUNNEL
KALIHI PORTAL
SECTION THRU PORTAL
RIGHT

ENGINEER L. B. W. DATE JULY 15 1953
DRAFTSMAN T. FURUDERA CHECKED BY T. F.
SCALE AS NOTED TRACER _____
APPROVED: [Signature] APPROVED: [Signature]
CHIEF ENGINEER BUREAU ENGINEER

APPROVED:
[Signature]
ENGINEER, KALIHI TUNNEL

SECTION C

JOB NO. 26-53

DWG. P-5

