
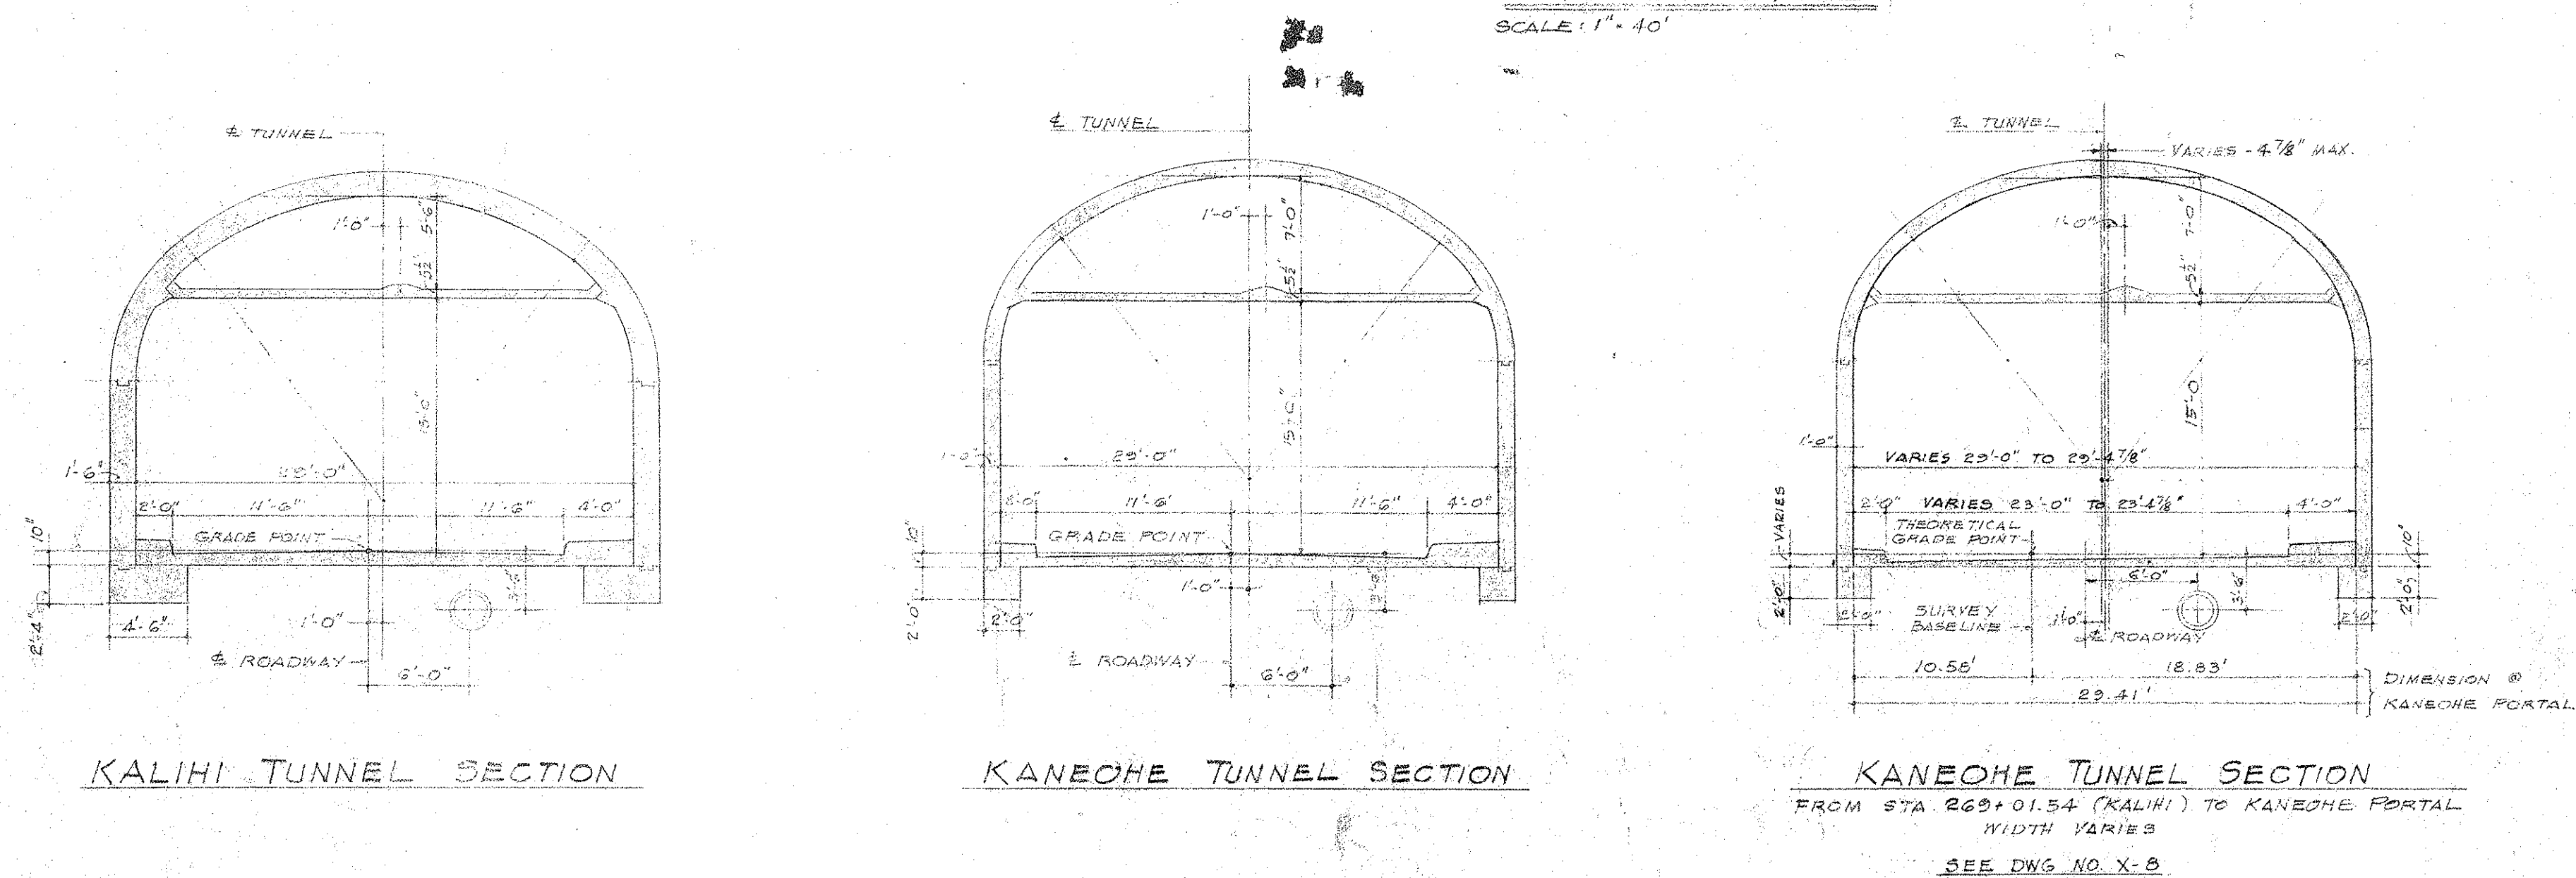


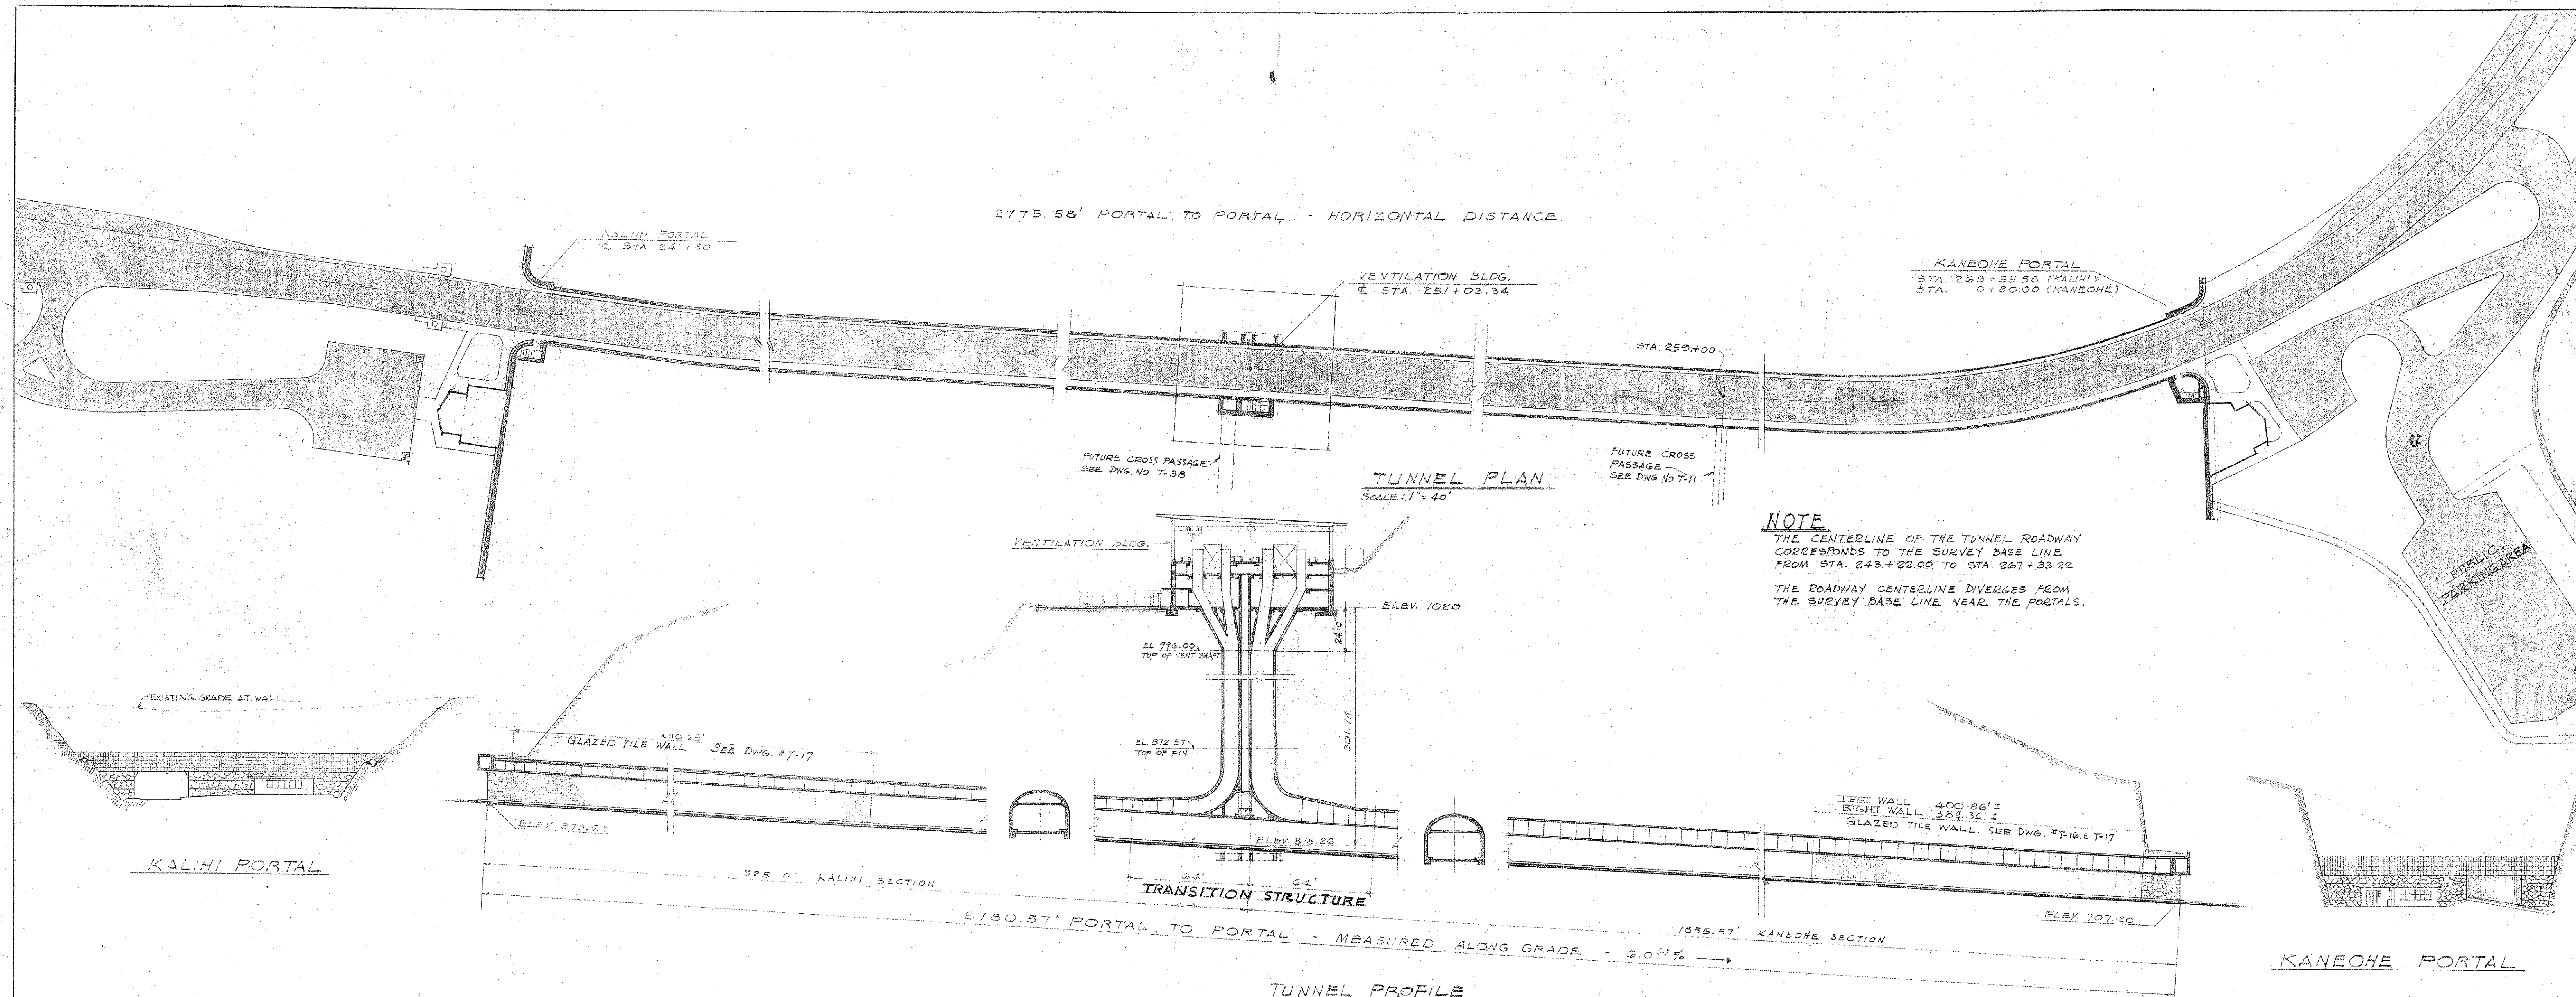

SCHEMATIC TUNNEL SECTIONS
SCALE: 1/8" = 1'-0"

LAW & WILSON ARCHITECTS & ENGINEERS			
DEPARTMENT OF PUBLIC WORKS CITY AND COUNTY OF HONOLULU			
BUREAU OF PLANS			
KALIHU TUNNEL			
TUNNEL & SHAFT			
SECTIONAL PLAN & PROFILE			
ENGINEER	W. Lum	DATE	JULY 15, 1953
DRAFTSMAN	K. N. RO	CHECKED BY	W. Lum, RO
SCALE	AS NOTED	TRACER	K. N.
APPROVED	R. J. Jannett	APPROVED	H. W. Bestgen
CHIEF ENGINEER		BUREAU ENGINEER	
W. S.	PROFILE	C. B.	
C. B. SEC.		S. B.	
W. M. BY.	F. W. BY.	S. BY.	

SECTION C JOB NO. 26-53 DWG. T-2