



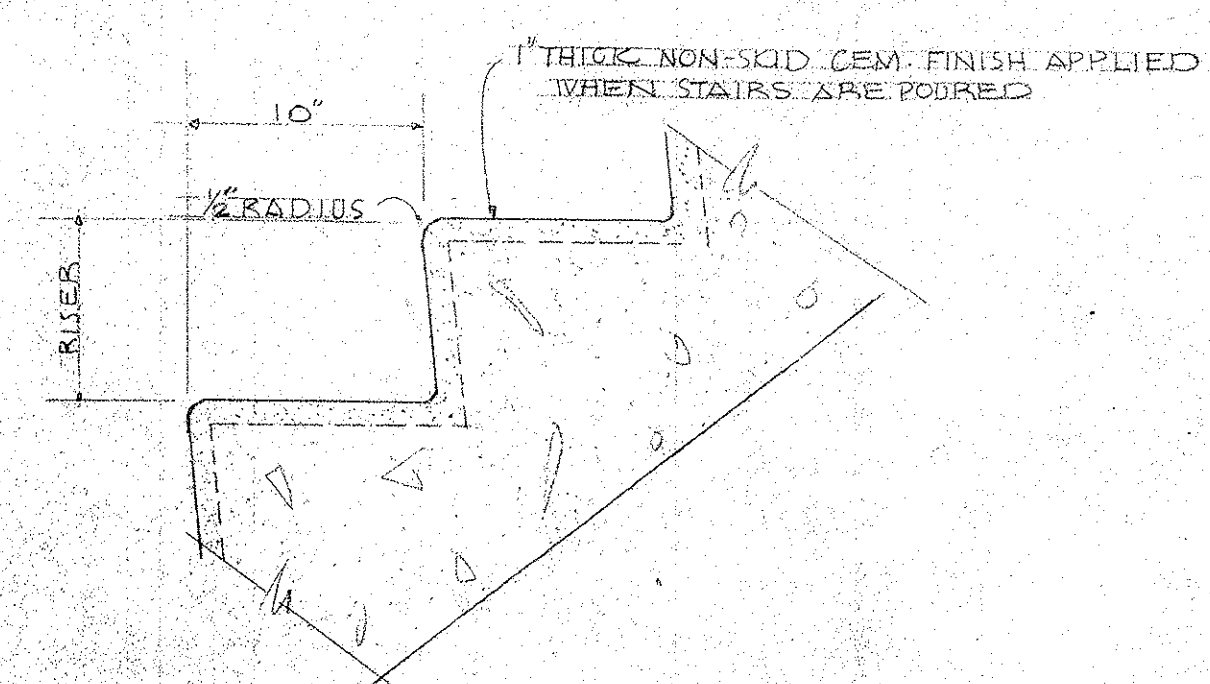


TREAD & RISER DETAIL
SCALE 1/2" = 1'-0"

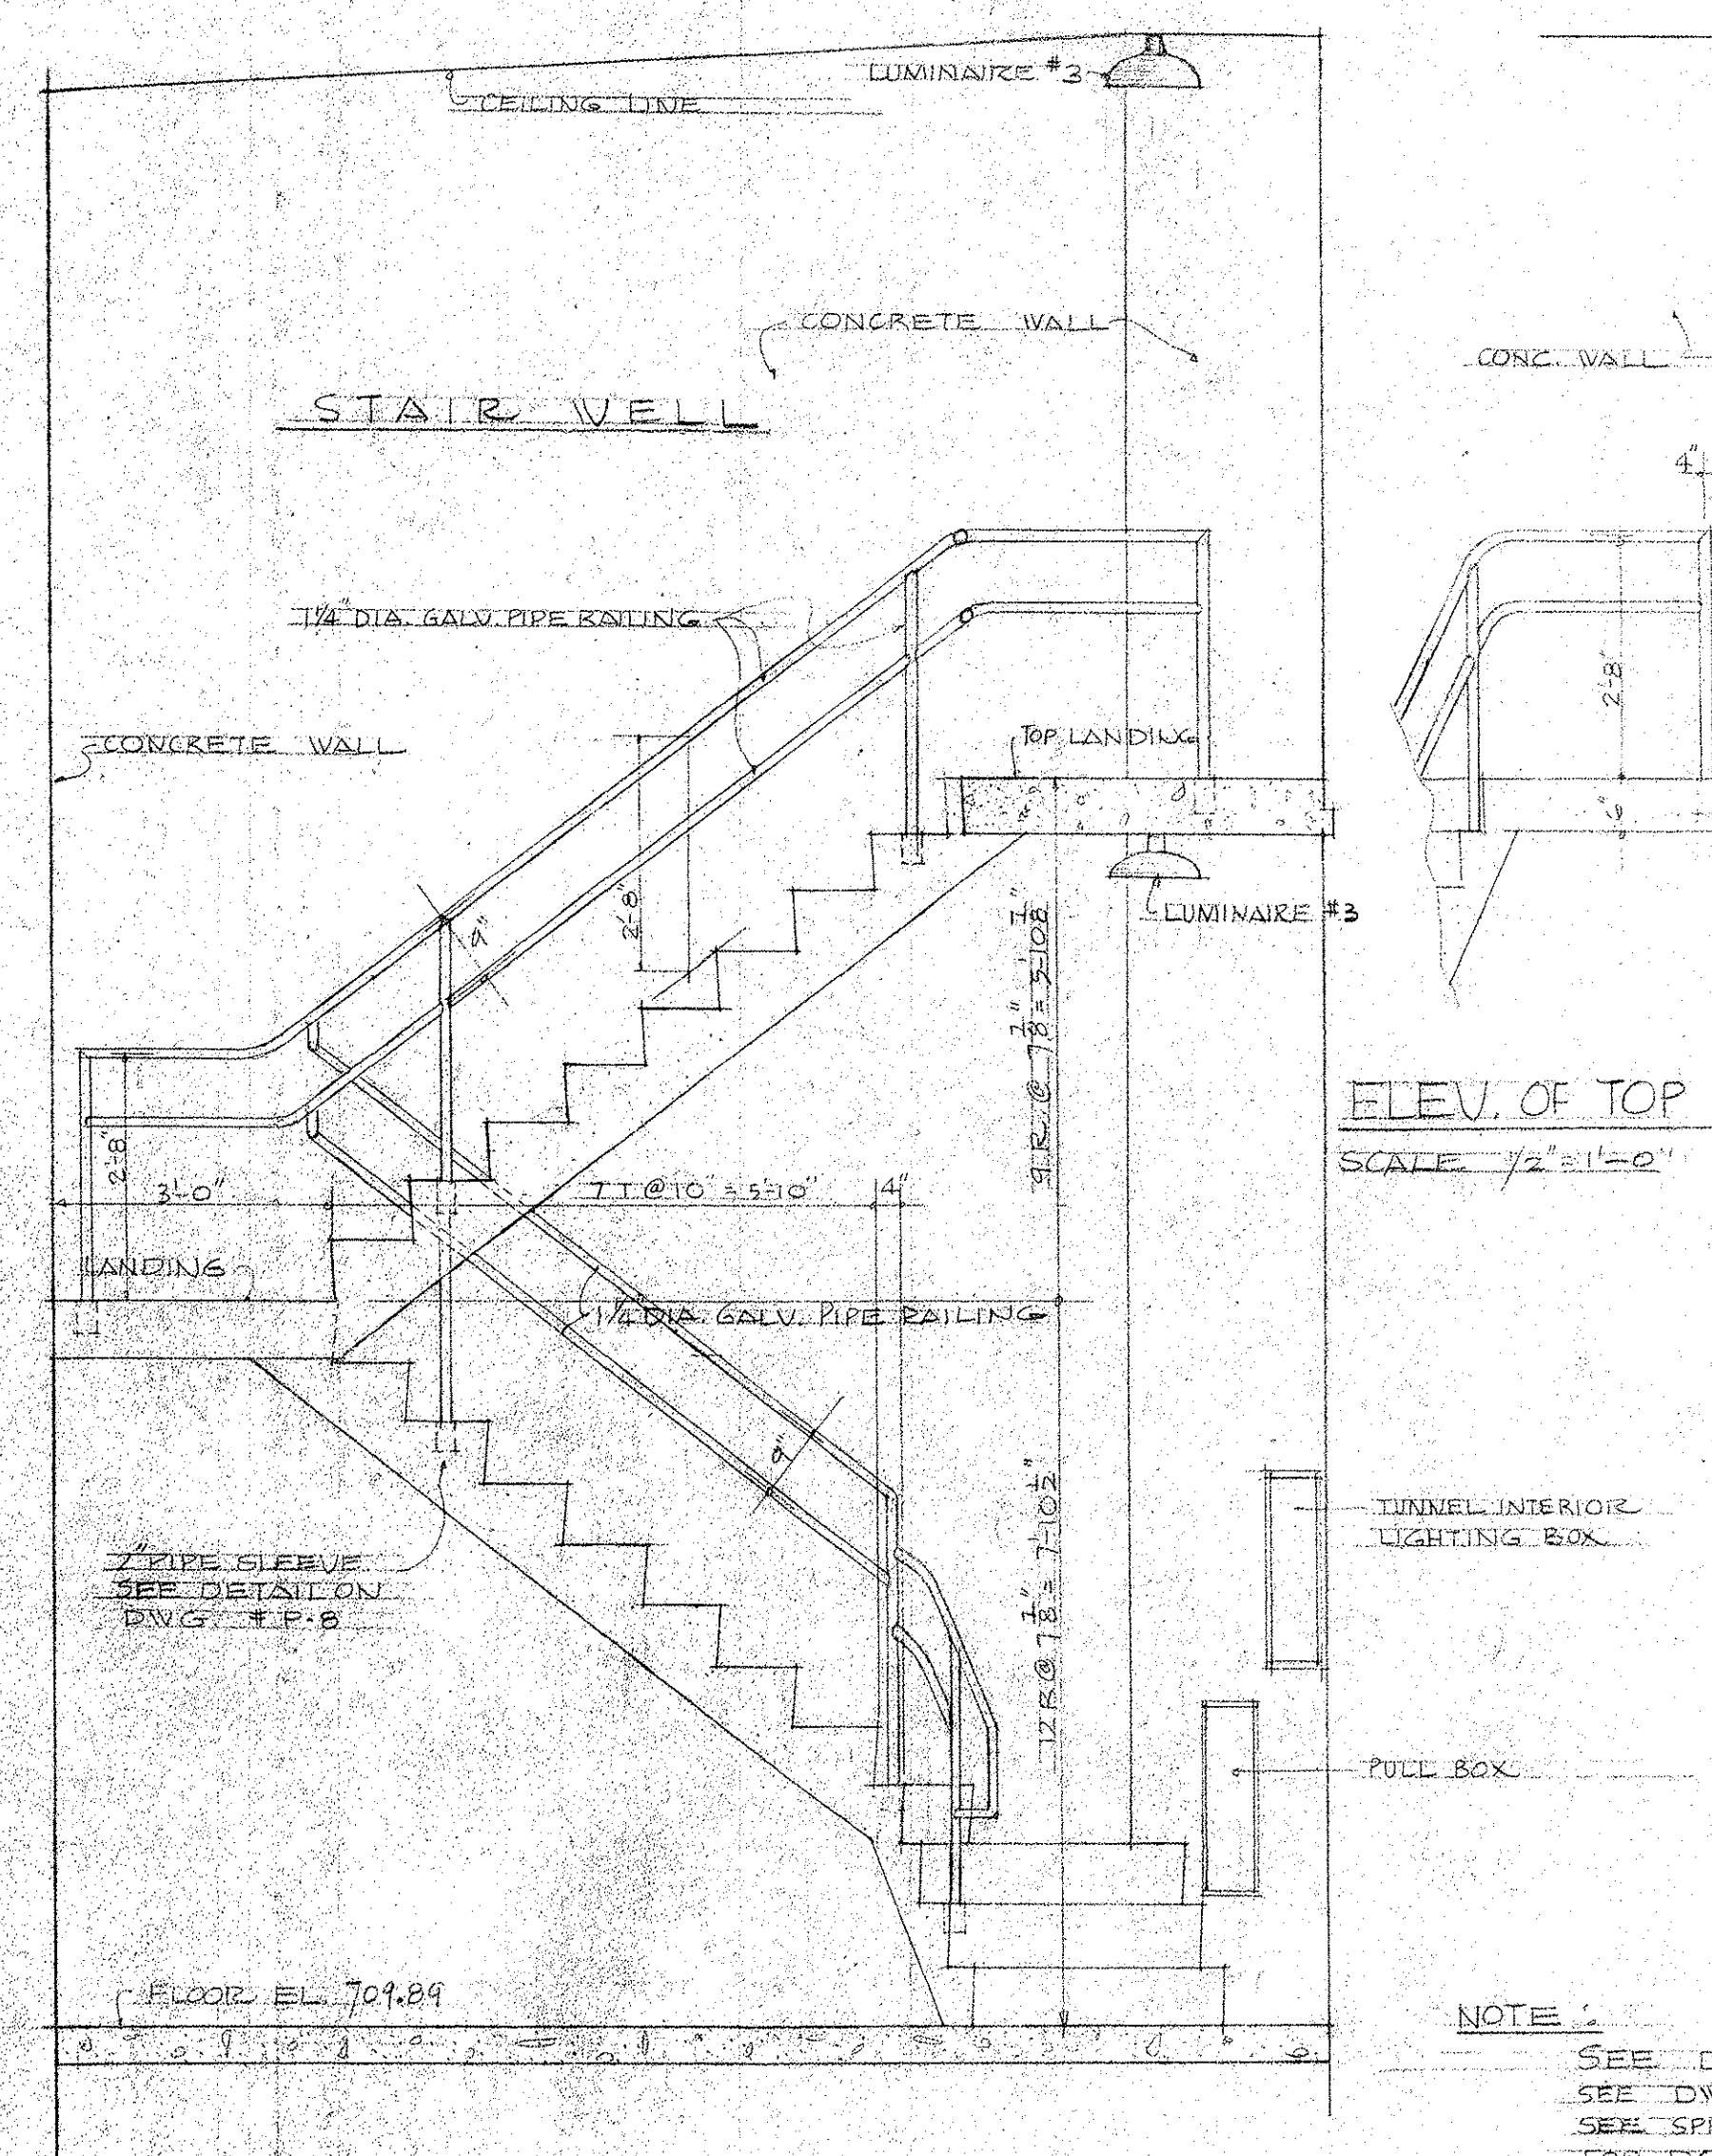


STAIR ELEVATION
SCALE 1/2" = 1'-0"


ELEV. OF TOP LANDING
SCALE 1/2" = 1'-0"

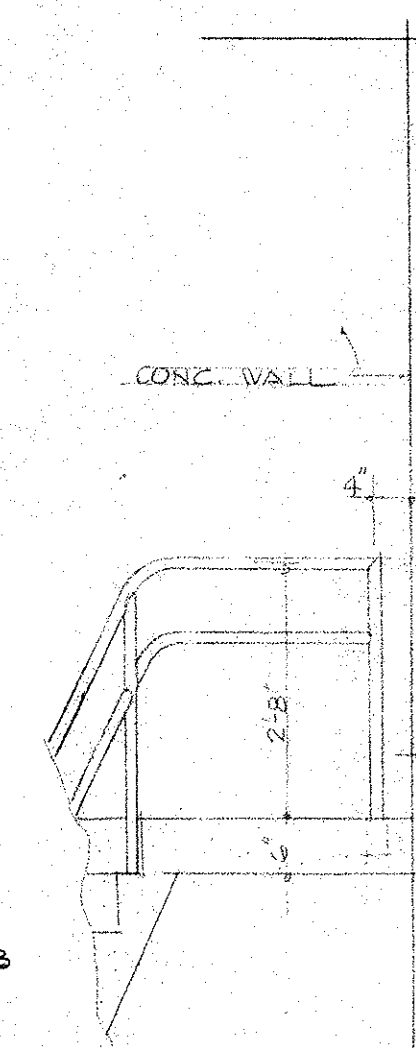

NOTE:
SEE DWG. # P-8 FOR PIPE RAILING DETAILS.
SEE DWG. P-44 FOR STRUCTURAL DETAILS.
SEE SPECIFICATION FOR NON-SKID FINISH ON TREADS.
FOR DOOR (F) SEE DWG. P-10 FOR SCHEDULE AND DWG. P-8 FOR FRAMING DETAILS.
FOR DIMENSIONS NOT SHOWN REFER TO DWG. P-31.
SEE DWG. P-44 FOR STRUCTURAL DETAILS.

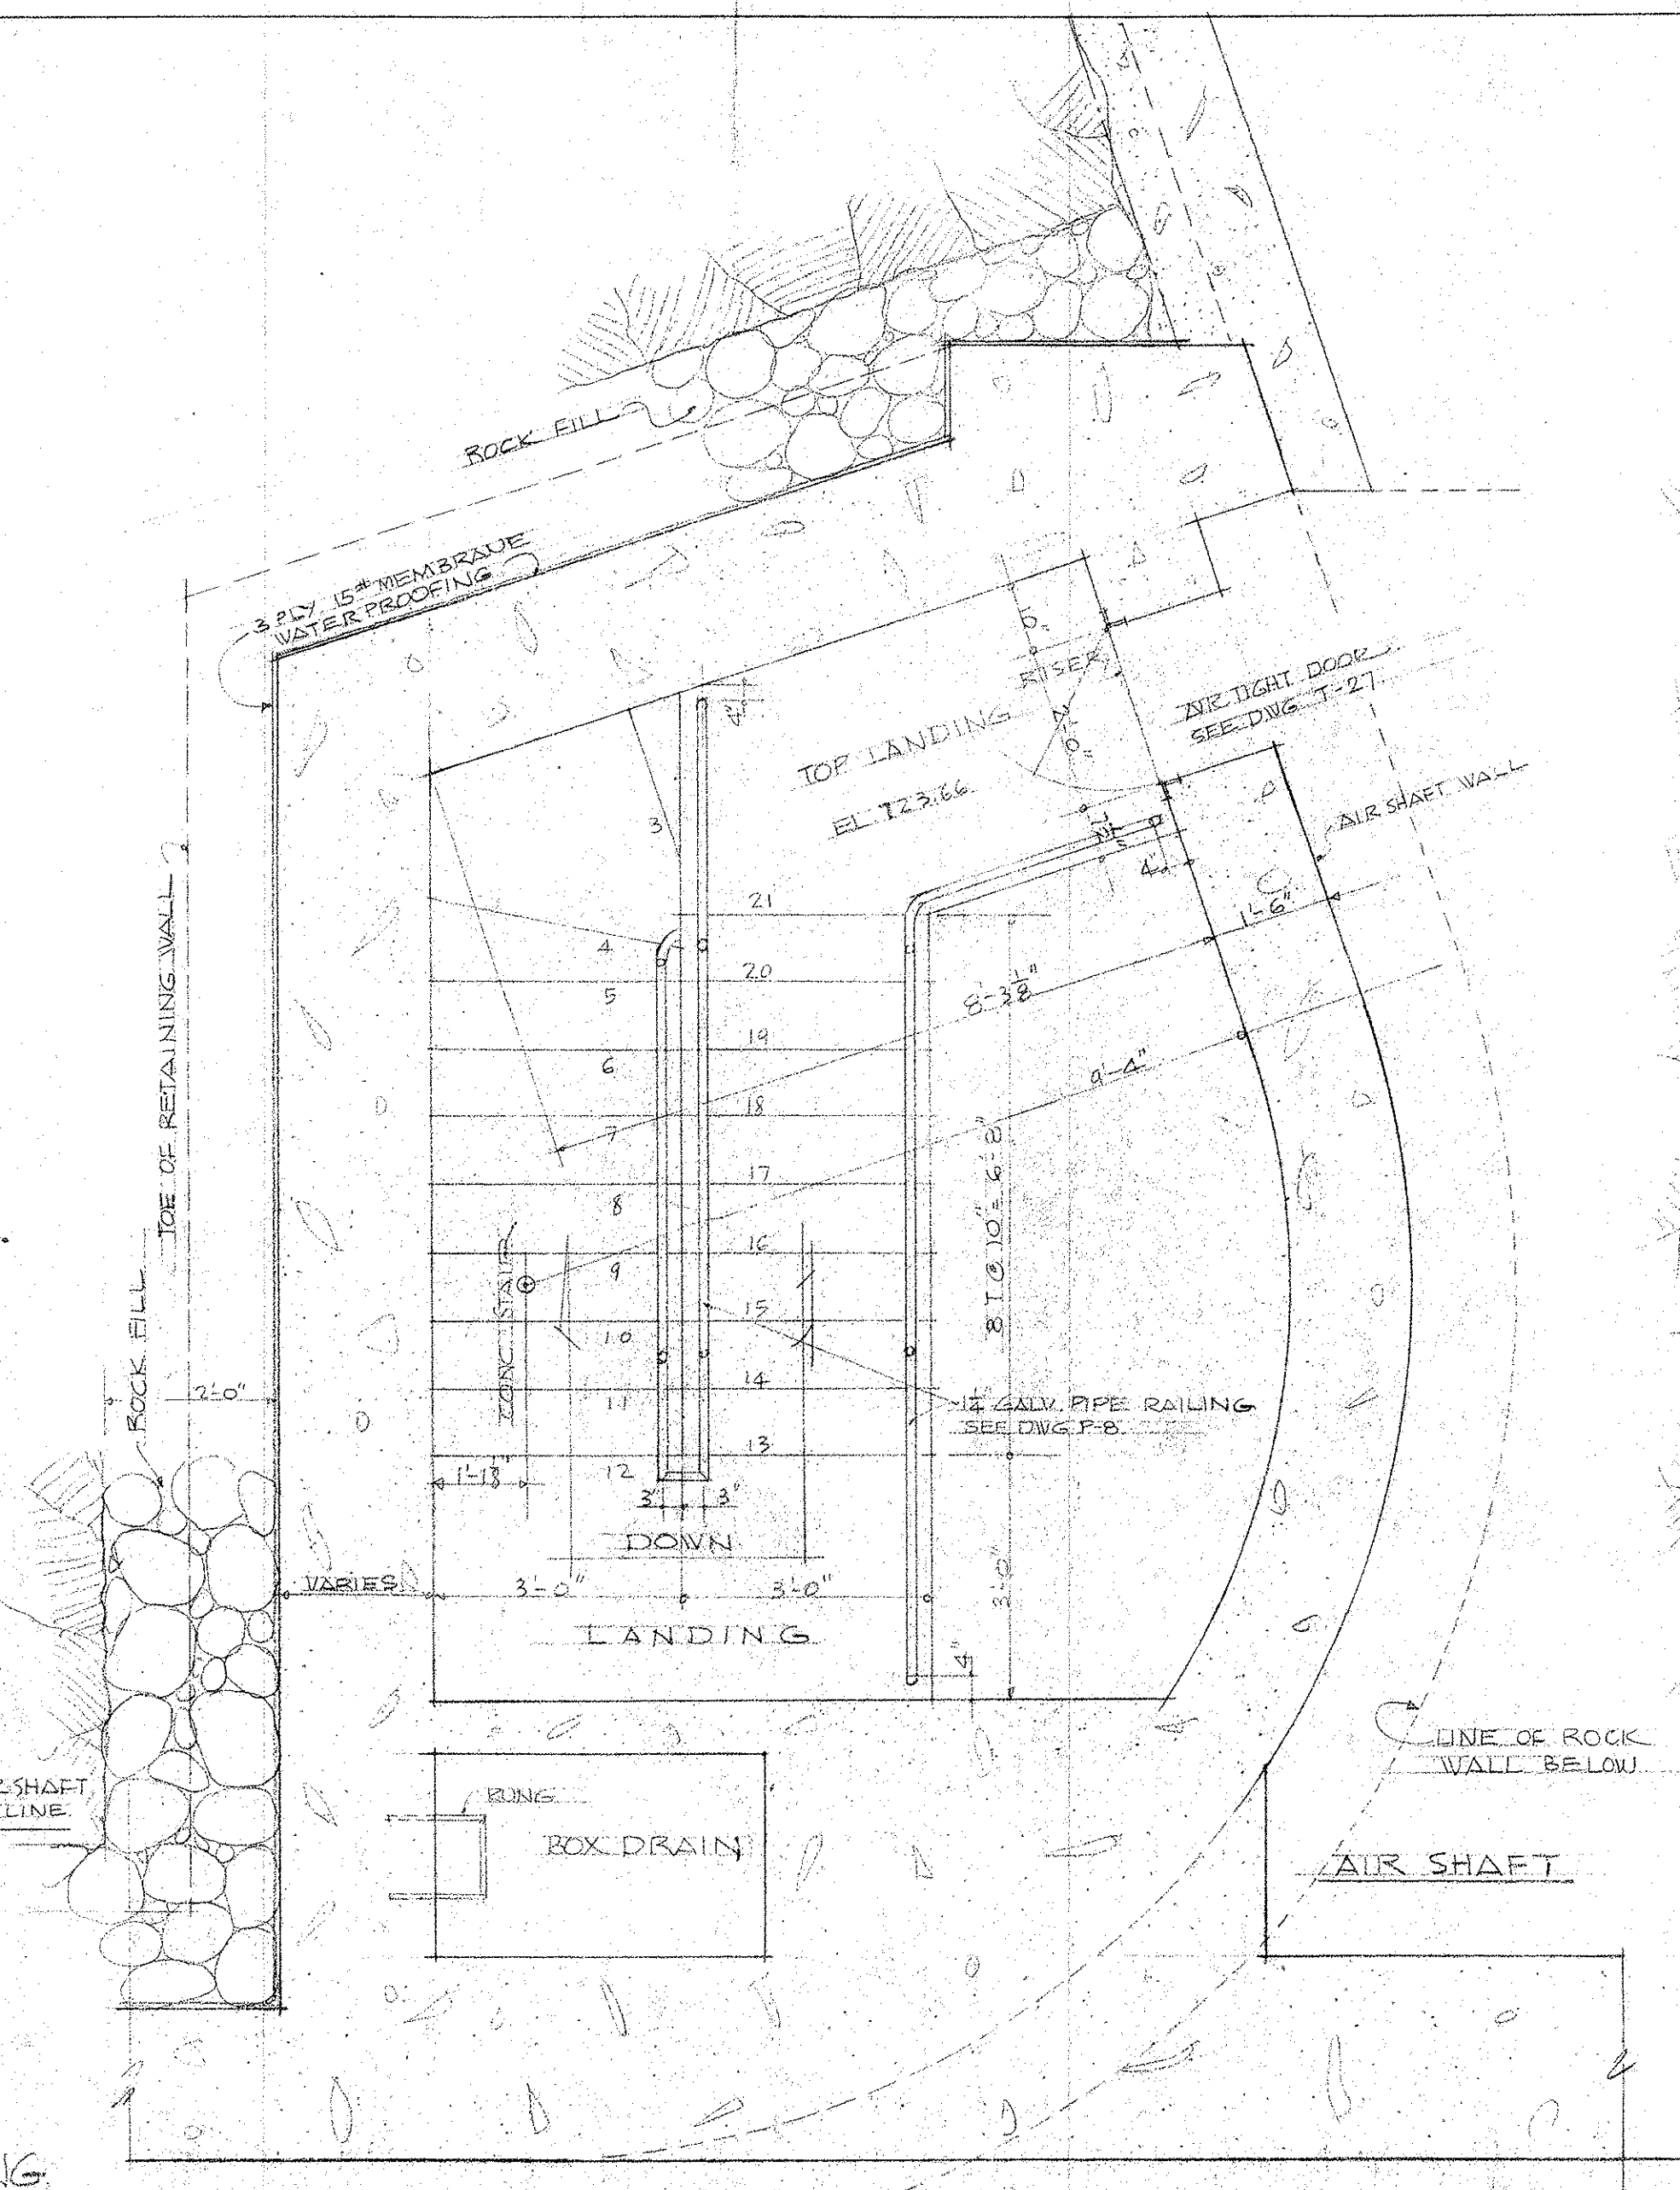

PLAN AT AIR SHAFT LEVEL
SCALE 1/2" = 1'-0"

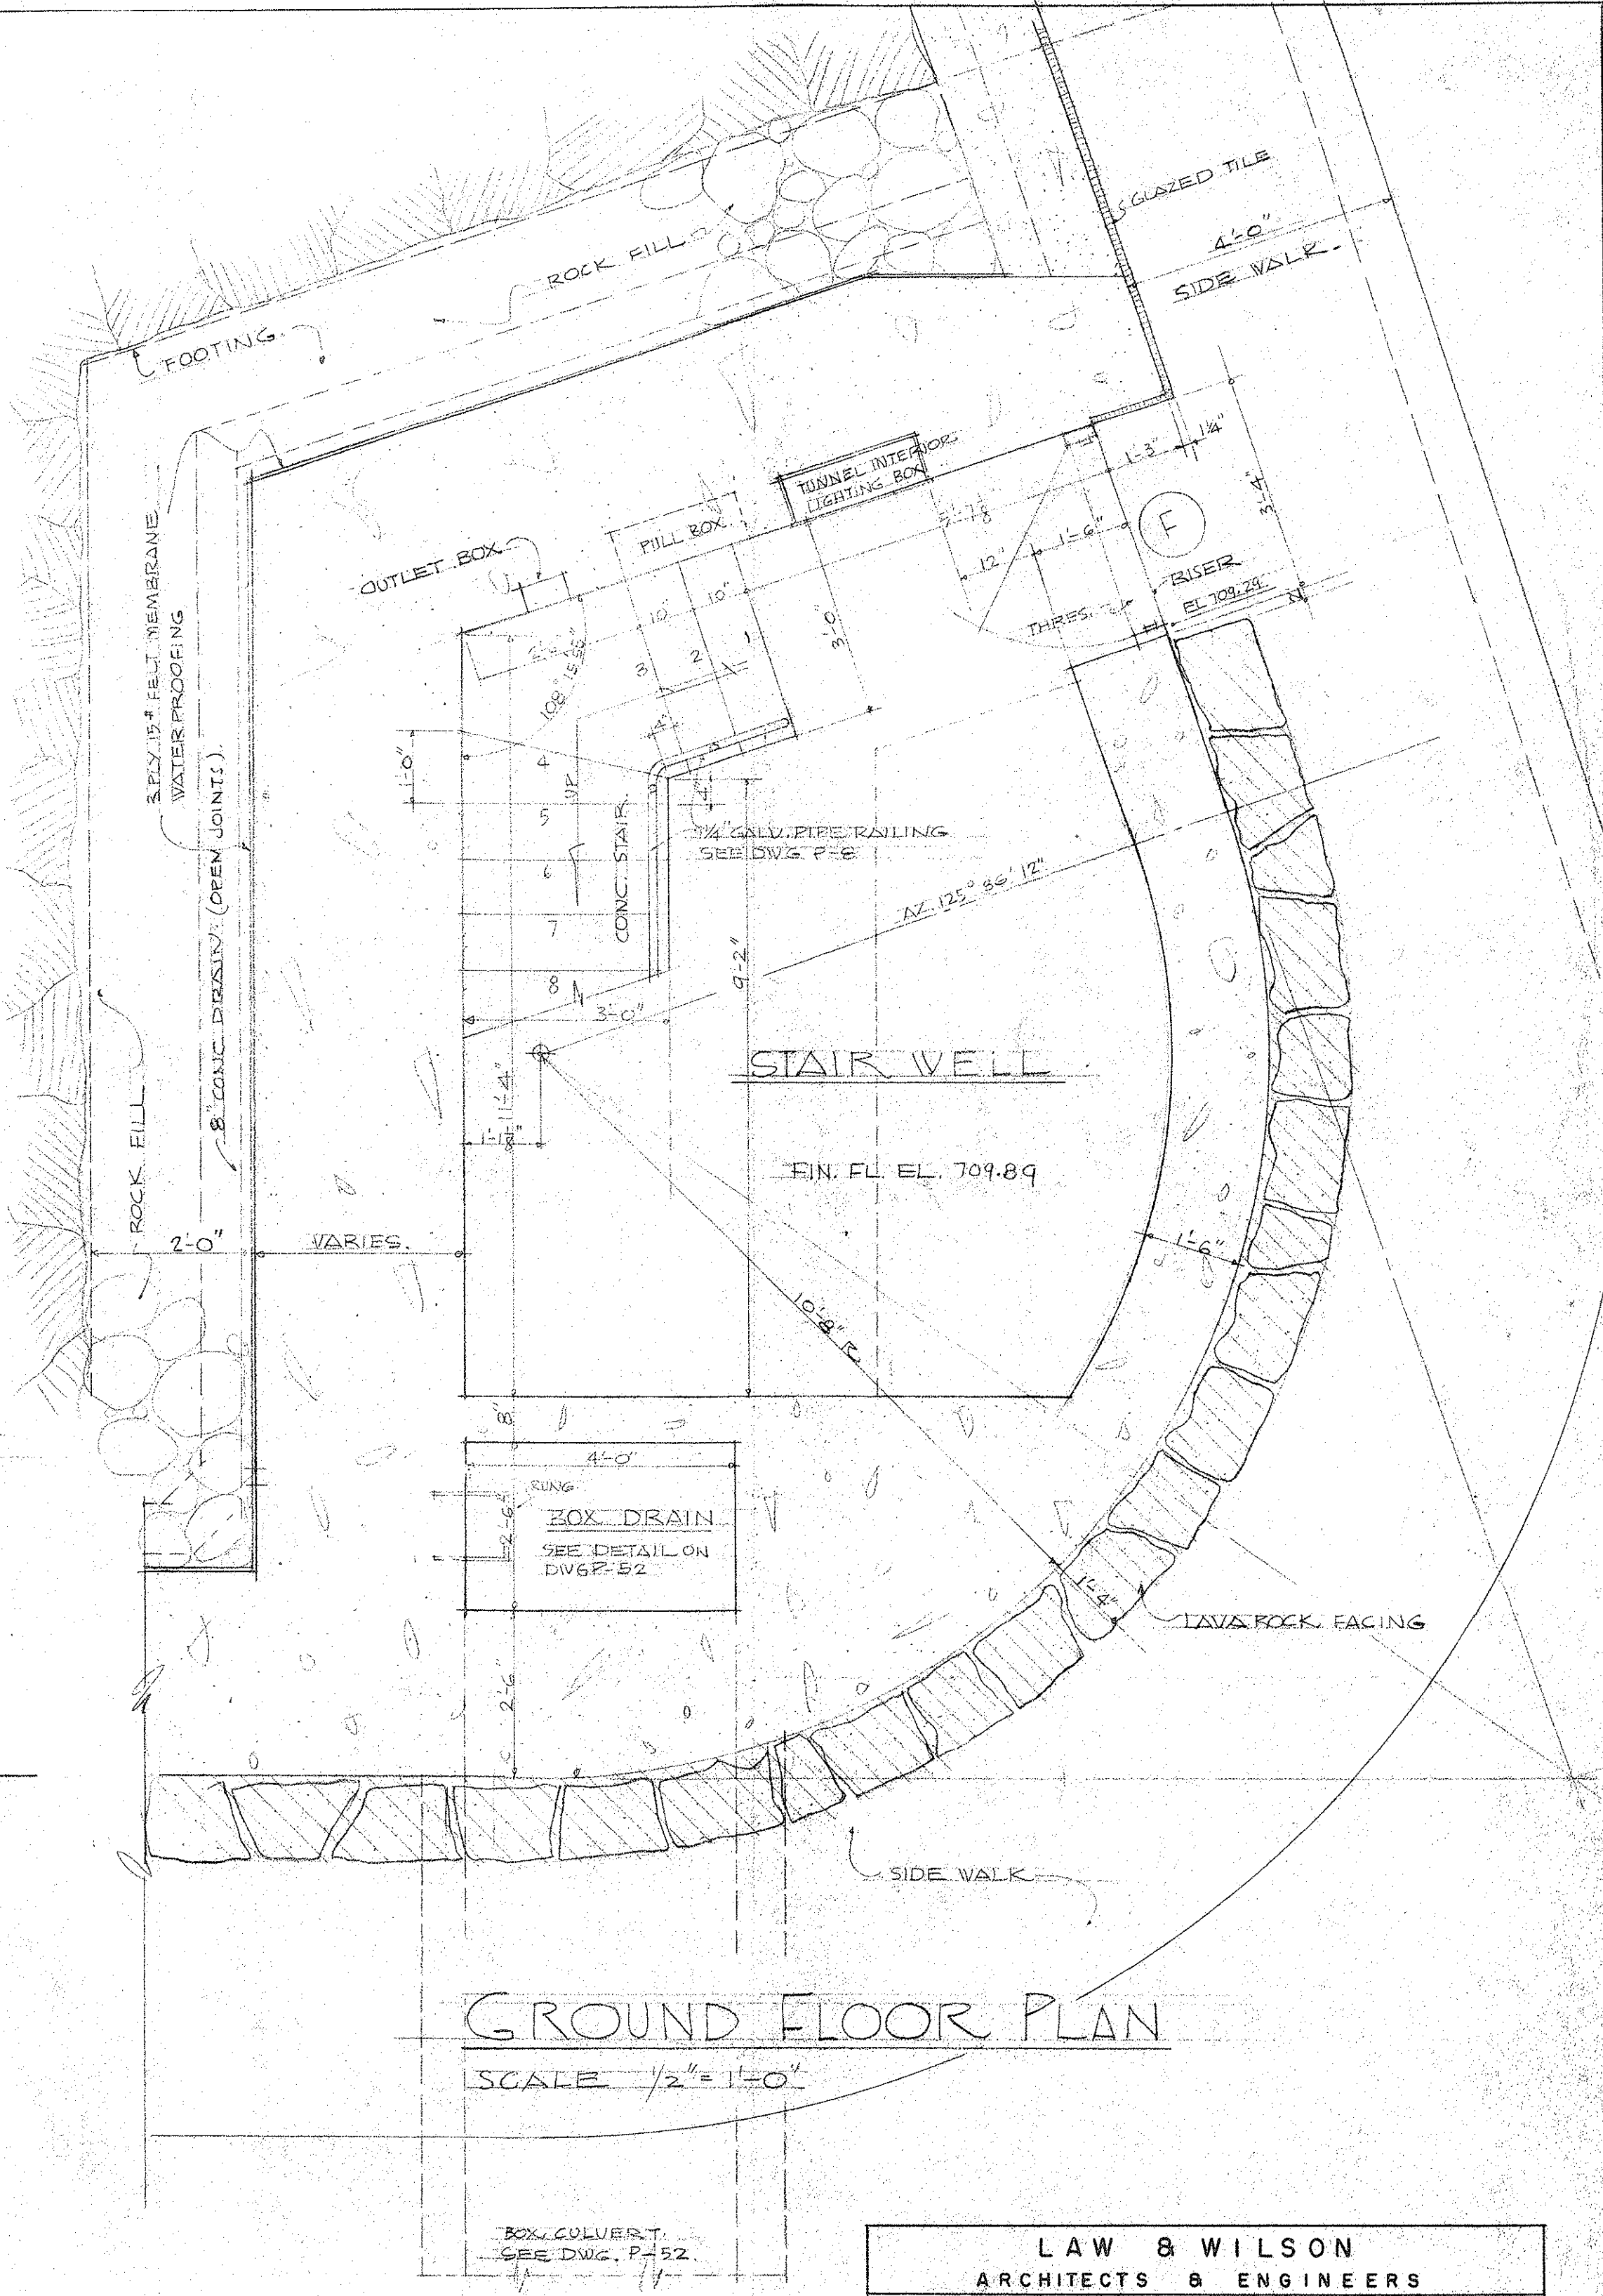

GROUND FLOOR PLAN
SCALE 1/2" = 1'-0"

LAW & WILSON ARCHITECTS & ENGINEERS			
DEPARTMENT OF PUBLIC WORKS CITY AND COUNTY OF HONOLULU BUREAU OF PLANS			
KALIHI TUNNEL KANEOHE PORTAL STAIR DETAILS			
ENGINEER: L. B. W.	DATE: JULY 18, 1983		
DRAFTSMAN: T. F.	CHECKED BY: W. G. [Signature]		
AS NOTED	TRACER:		
APPROVED: [Signature] CHIEF ENGINEER	APPROVED: [Signature] BUREAU ENGINEER		
W.S. CR. SEC. W.M. BY.	PROFILE P.S. P.W. BY.	C.B. R.S. B.B.Y.	

APPROVED: [Signature]
ENGINEER, KALIHI TUNNEL

SECTION C JOB NO. 26-53 DWG. P-37