


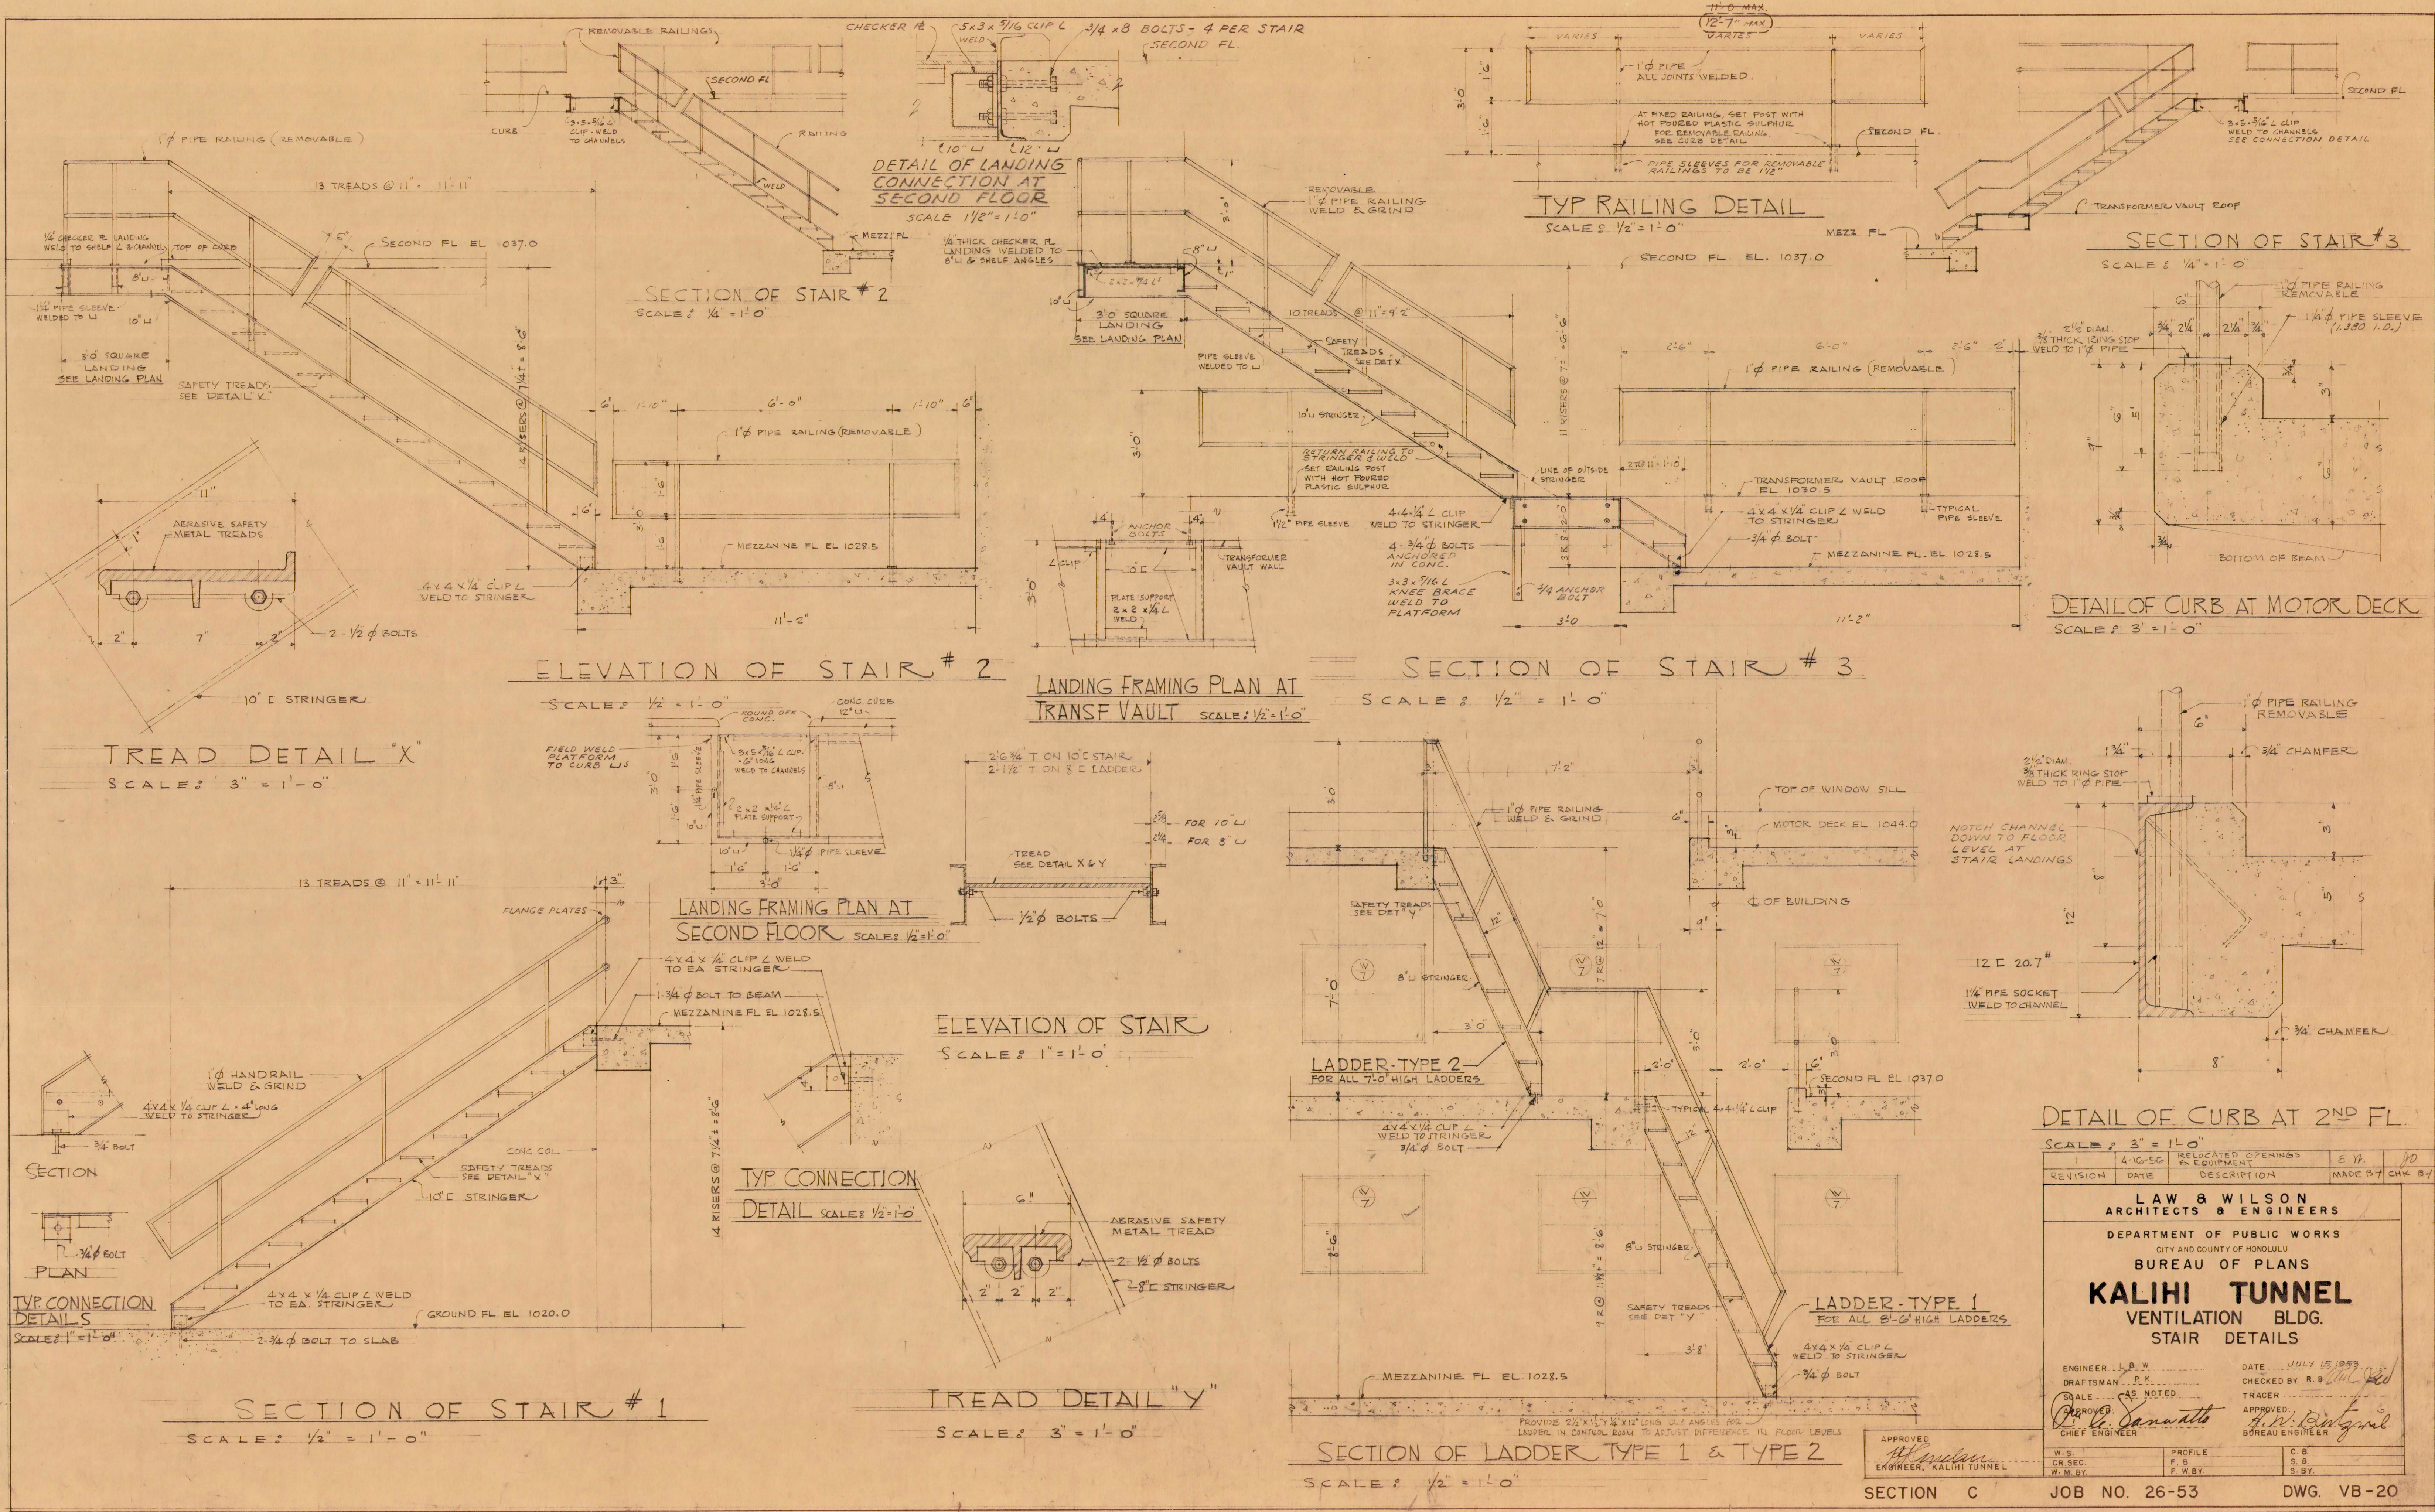

DETAIL OF CURB AT 2ND FL.

REVISION	DATE	DESCRIPTION	MADE BY	CHK BY
1	4-10-56	RELOCATED OPENINGS & EQUIPMENT	E. W.	W.

LAW & WILSON
ARCHITECTS & ENGINEERS

DEPARTMENT OF PUBLIC WORKS
CITY AND COUNTY OF HONOLULU

BUREAU OF PLANS

KALIHI TUNNEL
VENTILATION BLDG.
STAIR DETAILS

ENGINEER: J. B. W.
DRAFTSMAN: P. K.
SCALE: AS NOTED
APPROVED: *[Signature]*
CHIEF ENGINEER

DATE: JULY 15, 1953
CHECKED BY: R. B. *[Signature]*
TRACER: *[Signature]*
APPROVED: *[Signature]*
BUREAU ENGINEER

W.S.	CR. SEC.	W.M. BY	PROFILE	F.W. BY	C.B.	S.B.	S.B.Y.

SECTION C JOB NO. 26-53 DWG. VB-20