


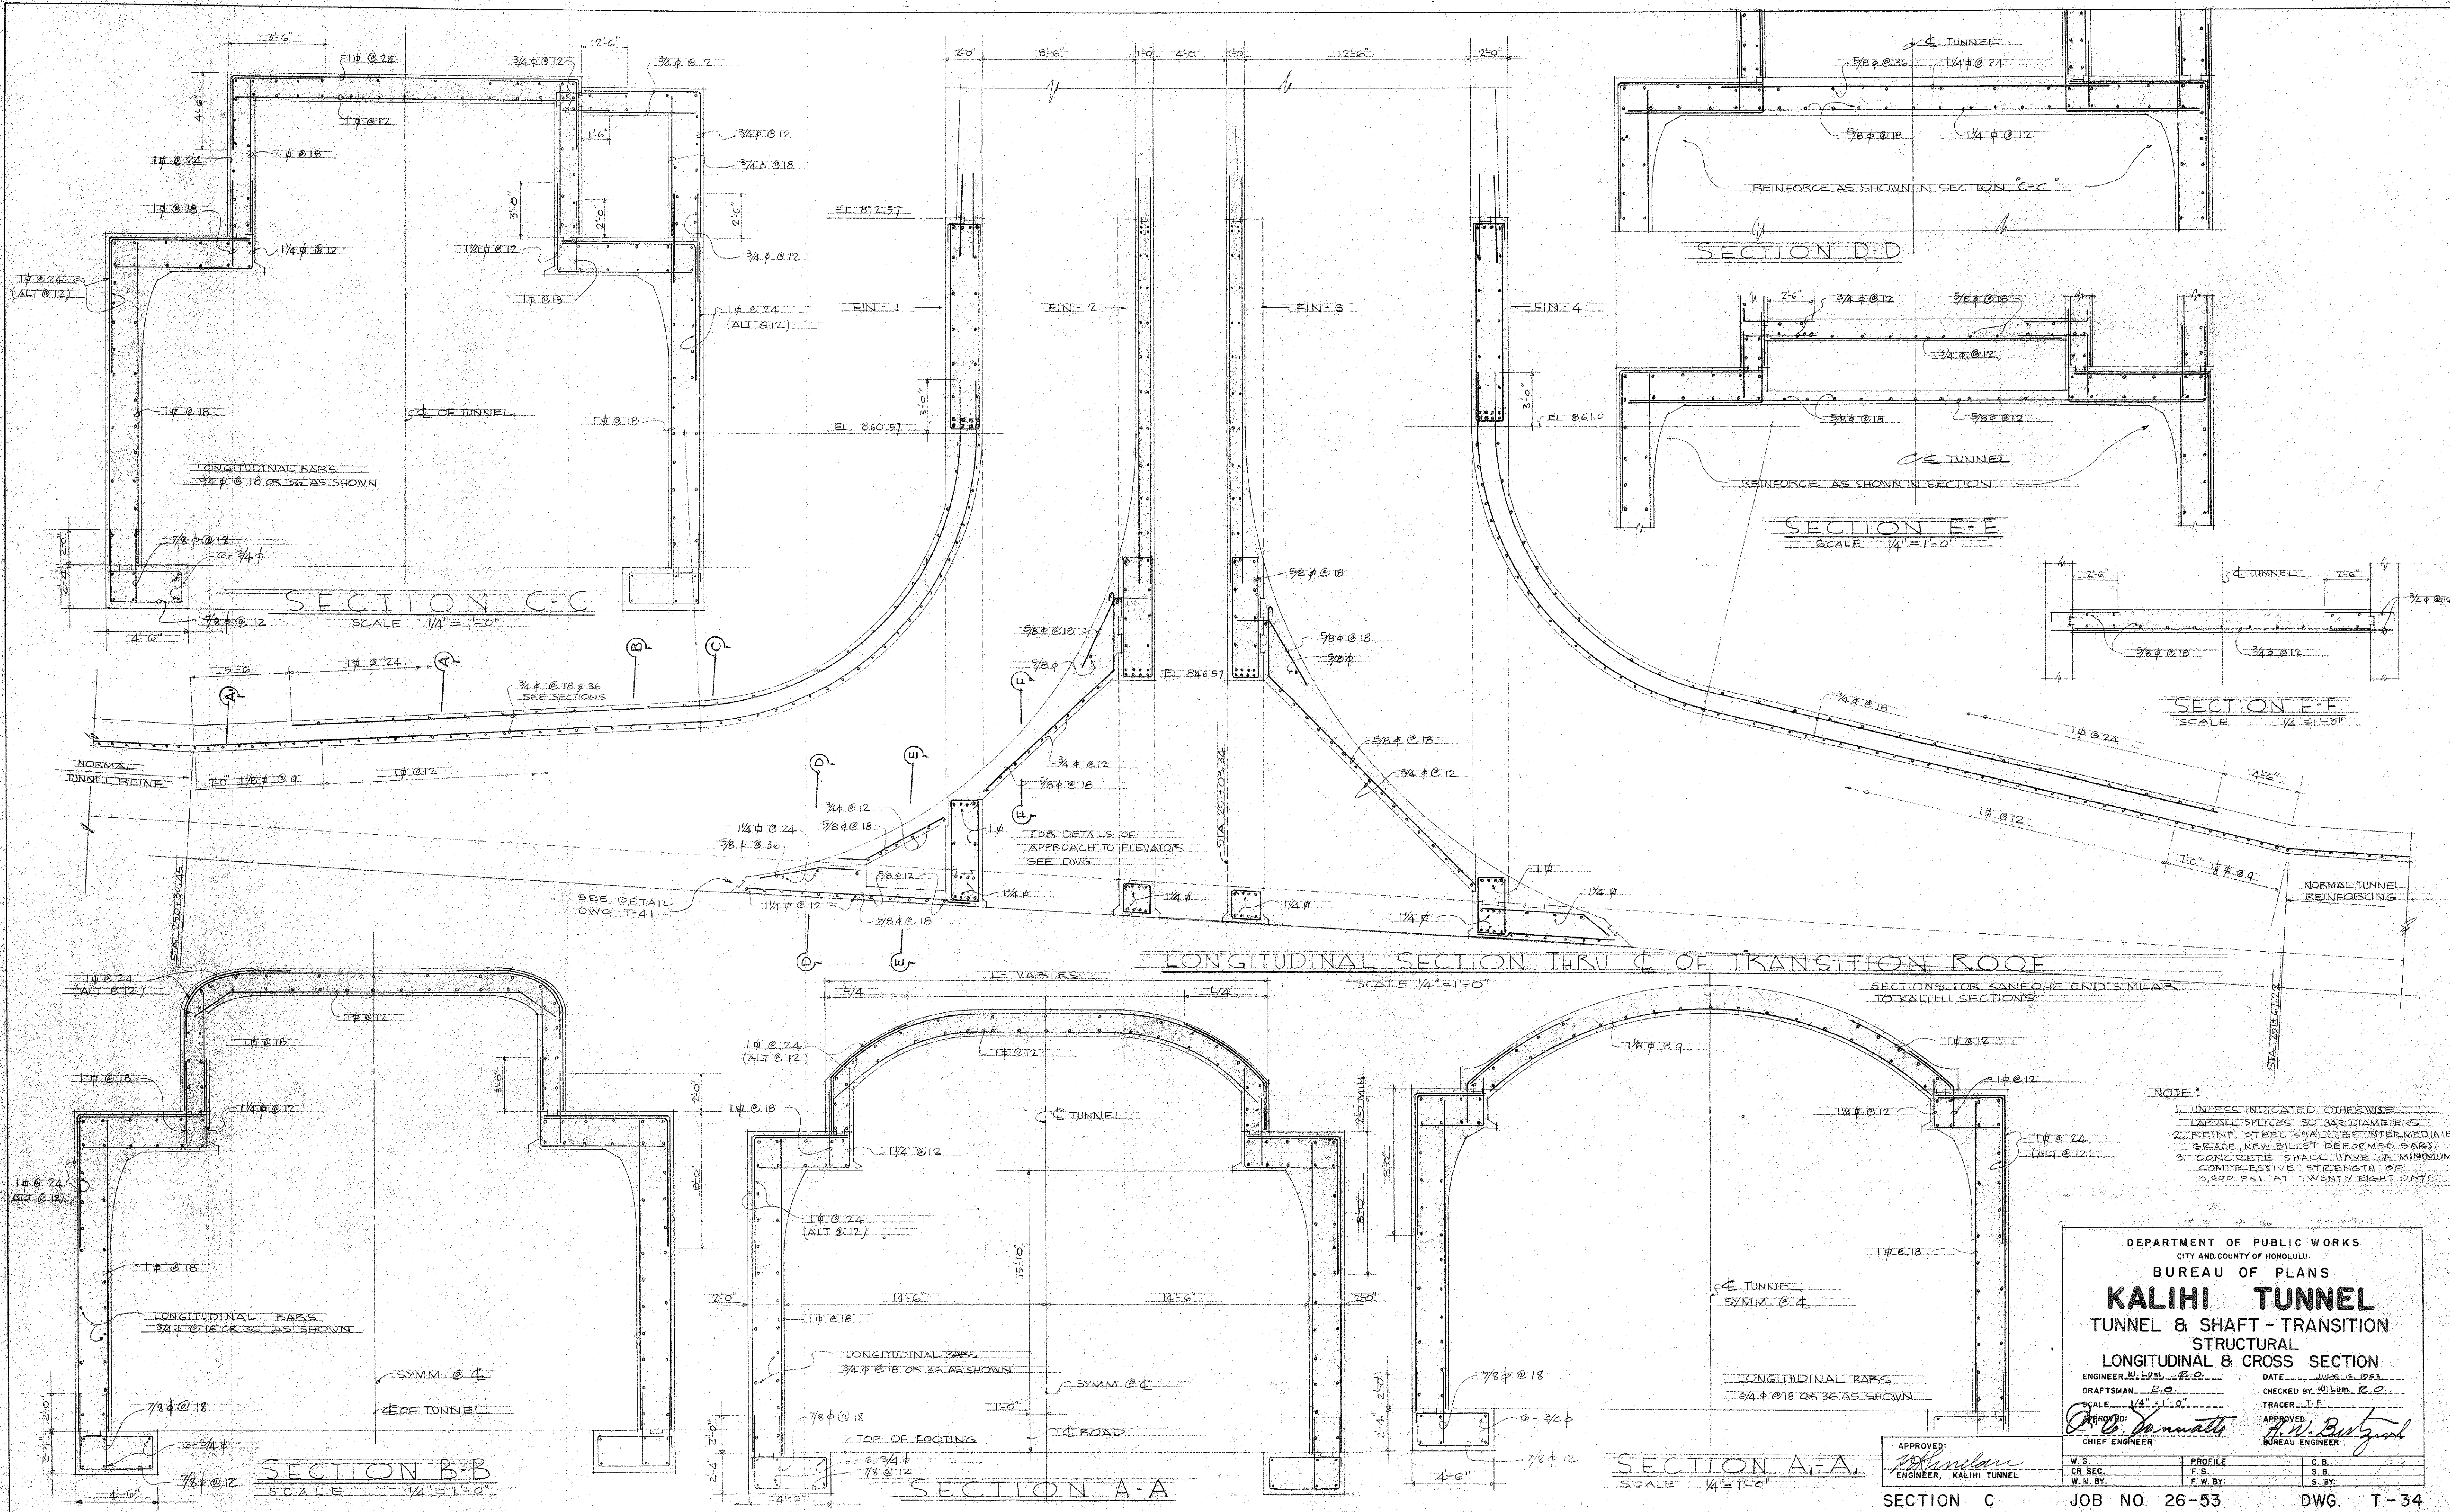

DEPARTMENT OF PUBLIC WORKS
CITY AND COUNTY OF HONOLULU
BUREAU OF PLANS

KALIHI TUNNEL
TUNNEL & SHAFT - TRANSITION
STRUCTURAL
LONGITUDINAL & CROSS SECTION

ENGINEER: *[Signature]* DATE: 10/25/53
DRAFTSMAN: *[Signature]* CHECKED BY: *[Signature]*
SCALE: 1/4" = 1'-0" TRACER: T.F.
APPROVED: *[Signature]* APPROVED: *[Signature]*
CHIEF ENGINEER BUREAU ENGINEER

W.S.	PROFILE	C.B.
CR. SEC.	F.B.	S.B.
W.M. BY:	F.W. BY:	S. BY:

SECTION C JOB NO. 26-53 DWG. T-34

FILE	POCKET	FOLDER	NO.
7	F	3	34