




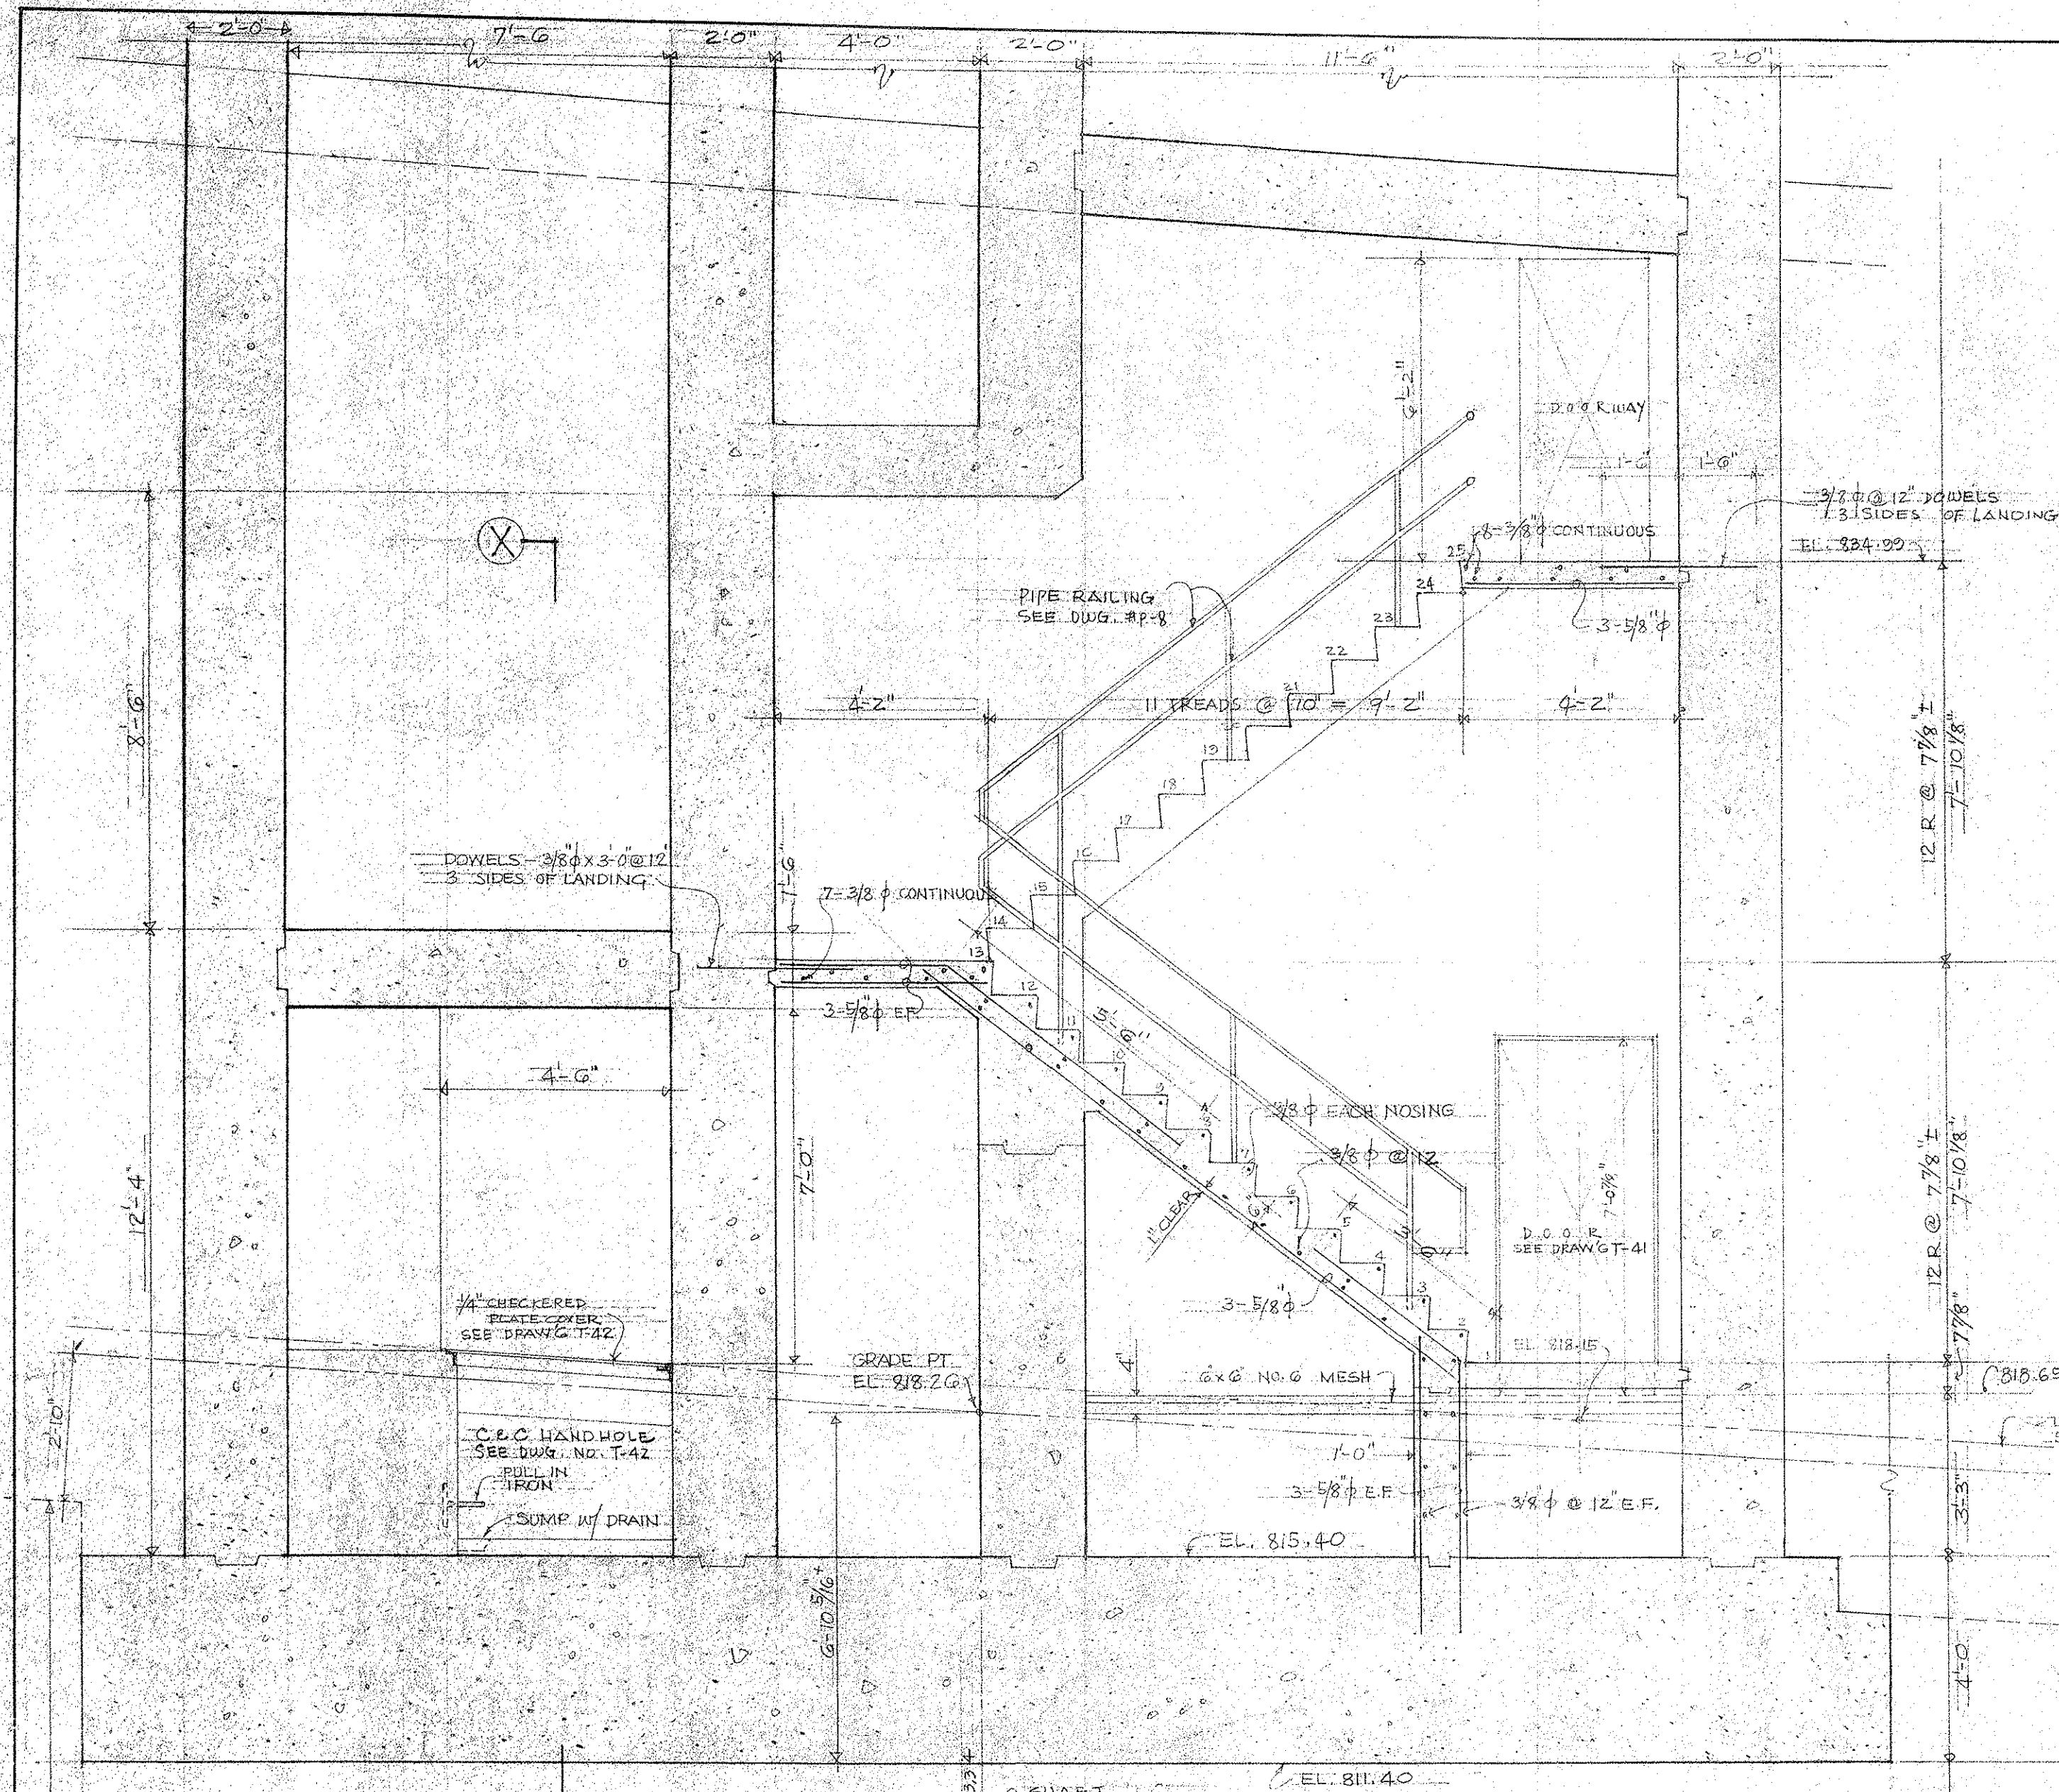


SECTION Y-Y

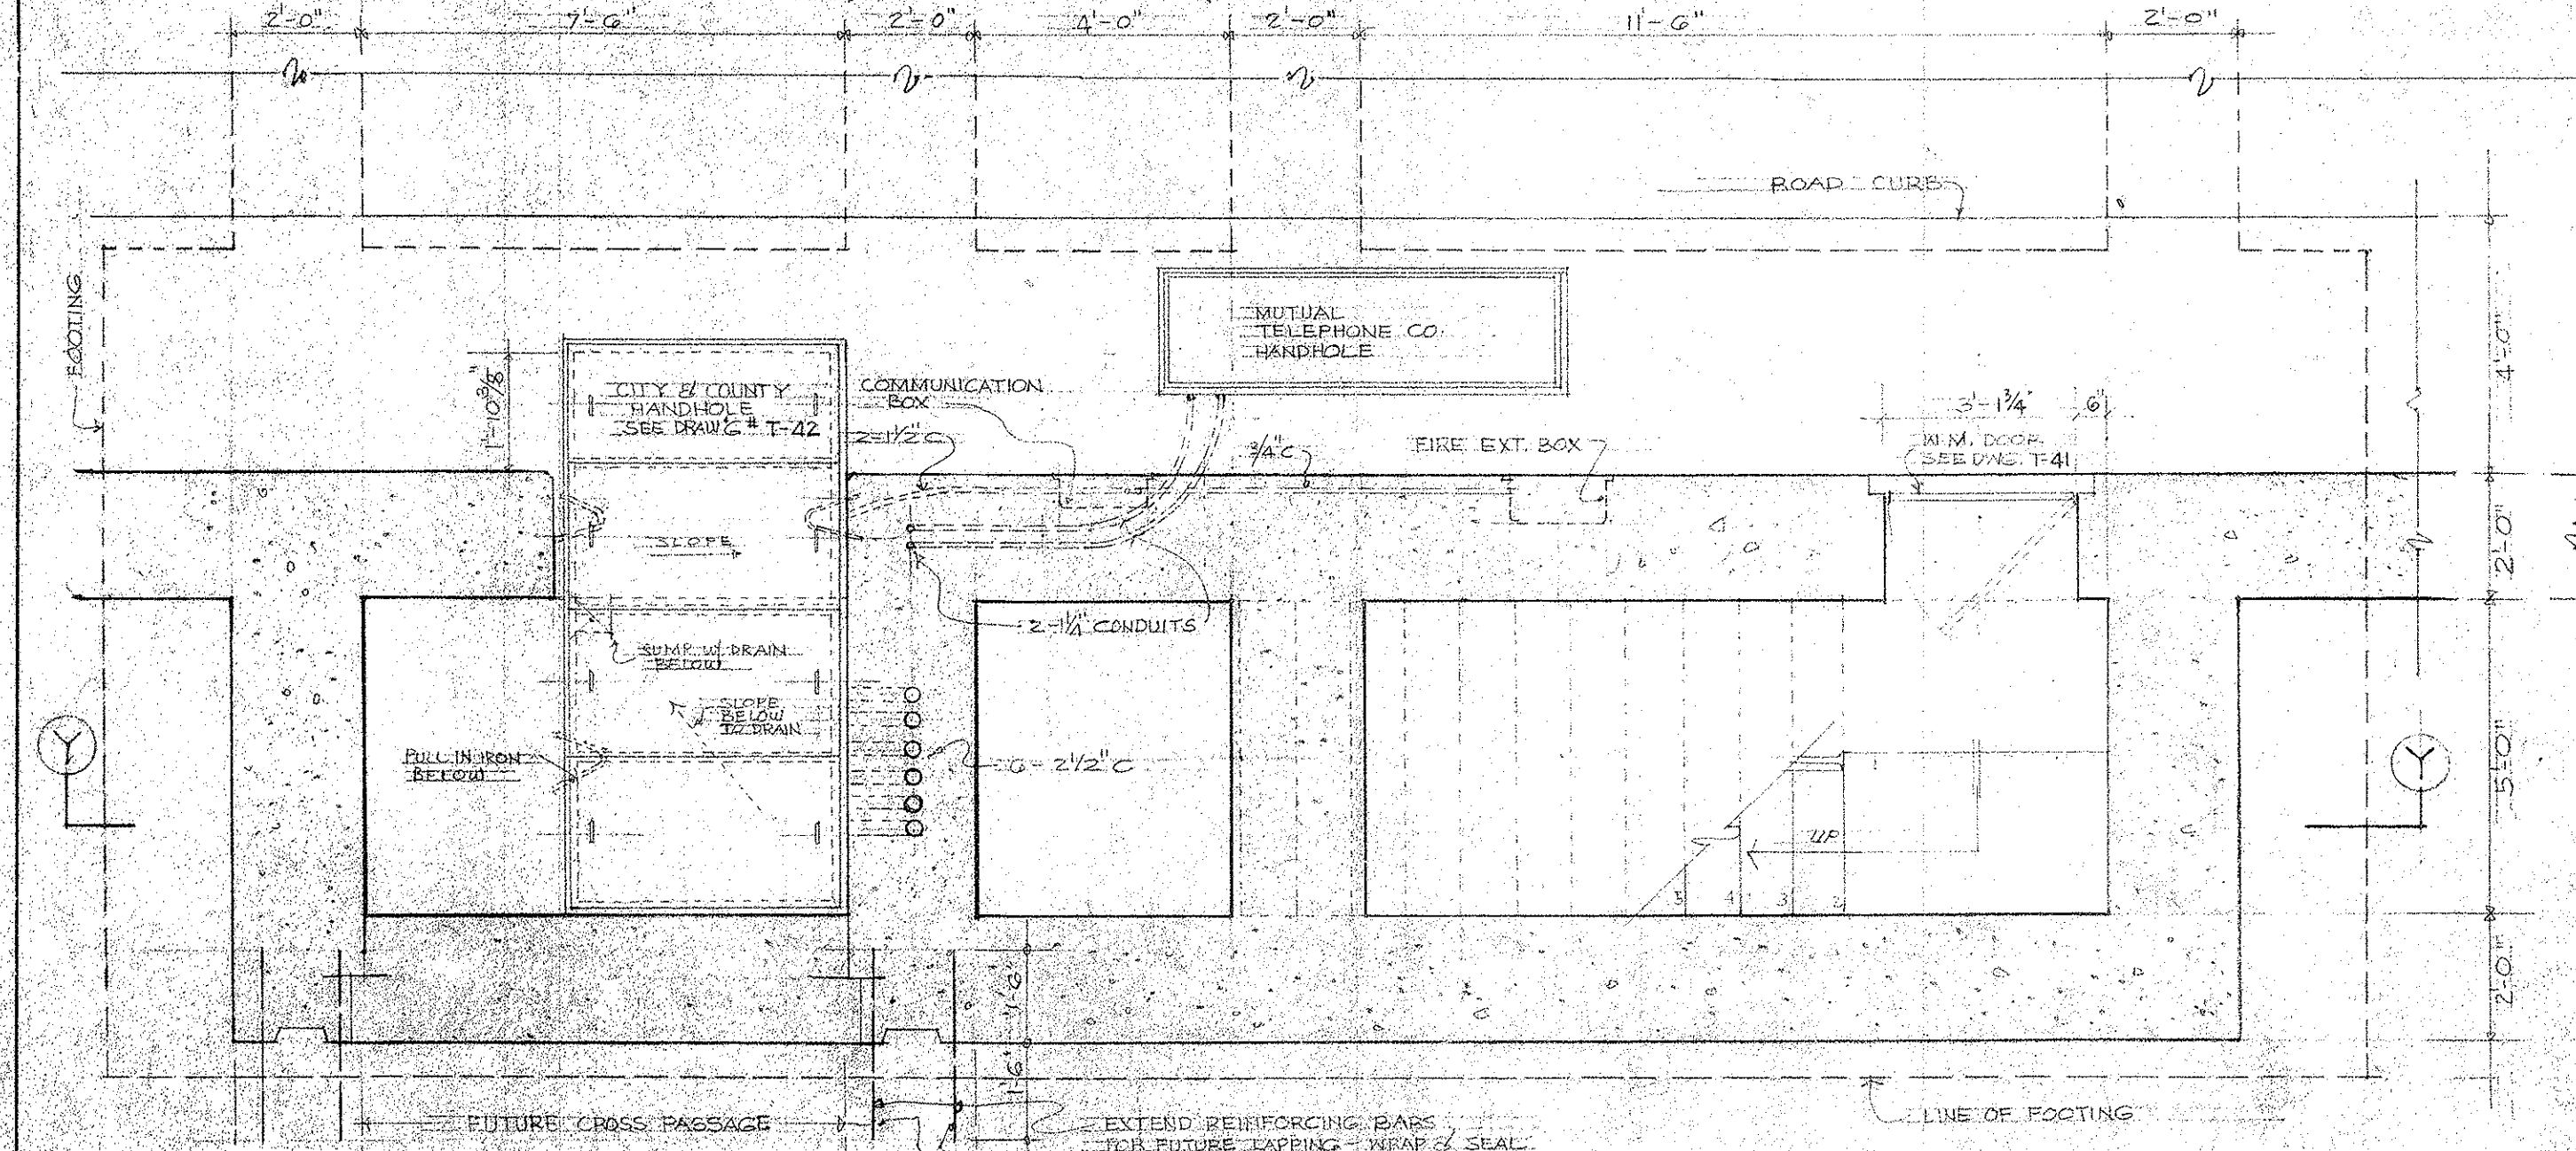


GROUND FLOOR PLAN

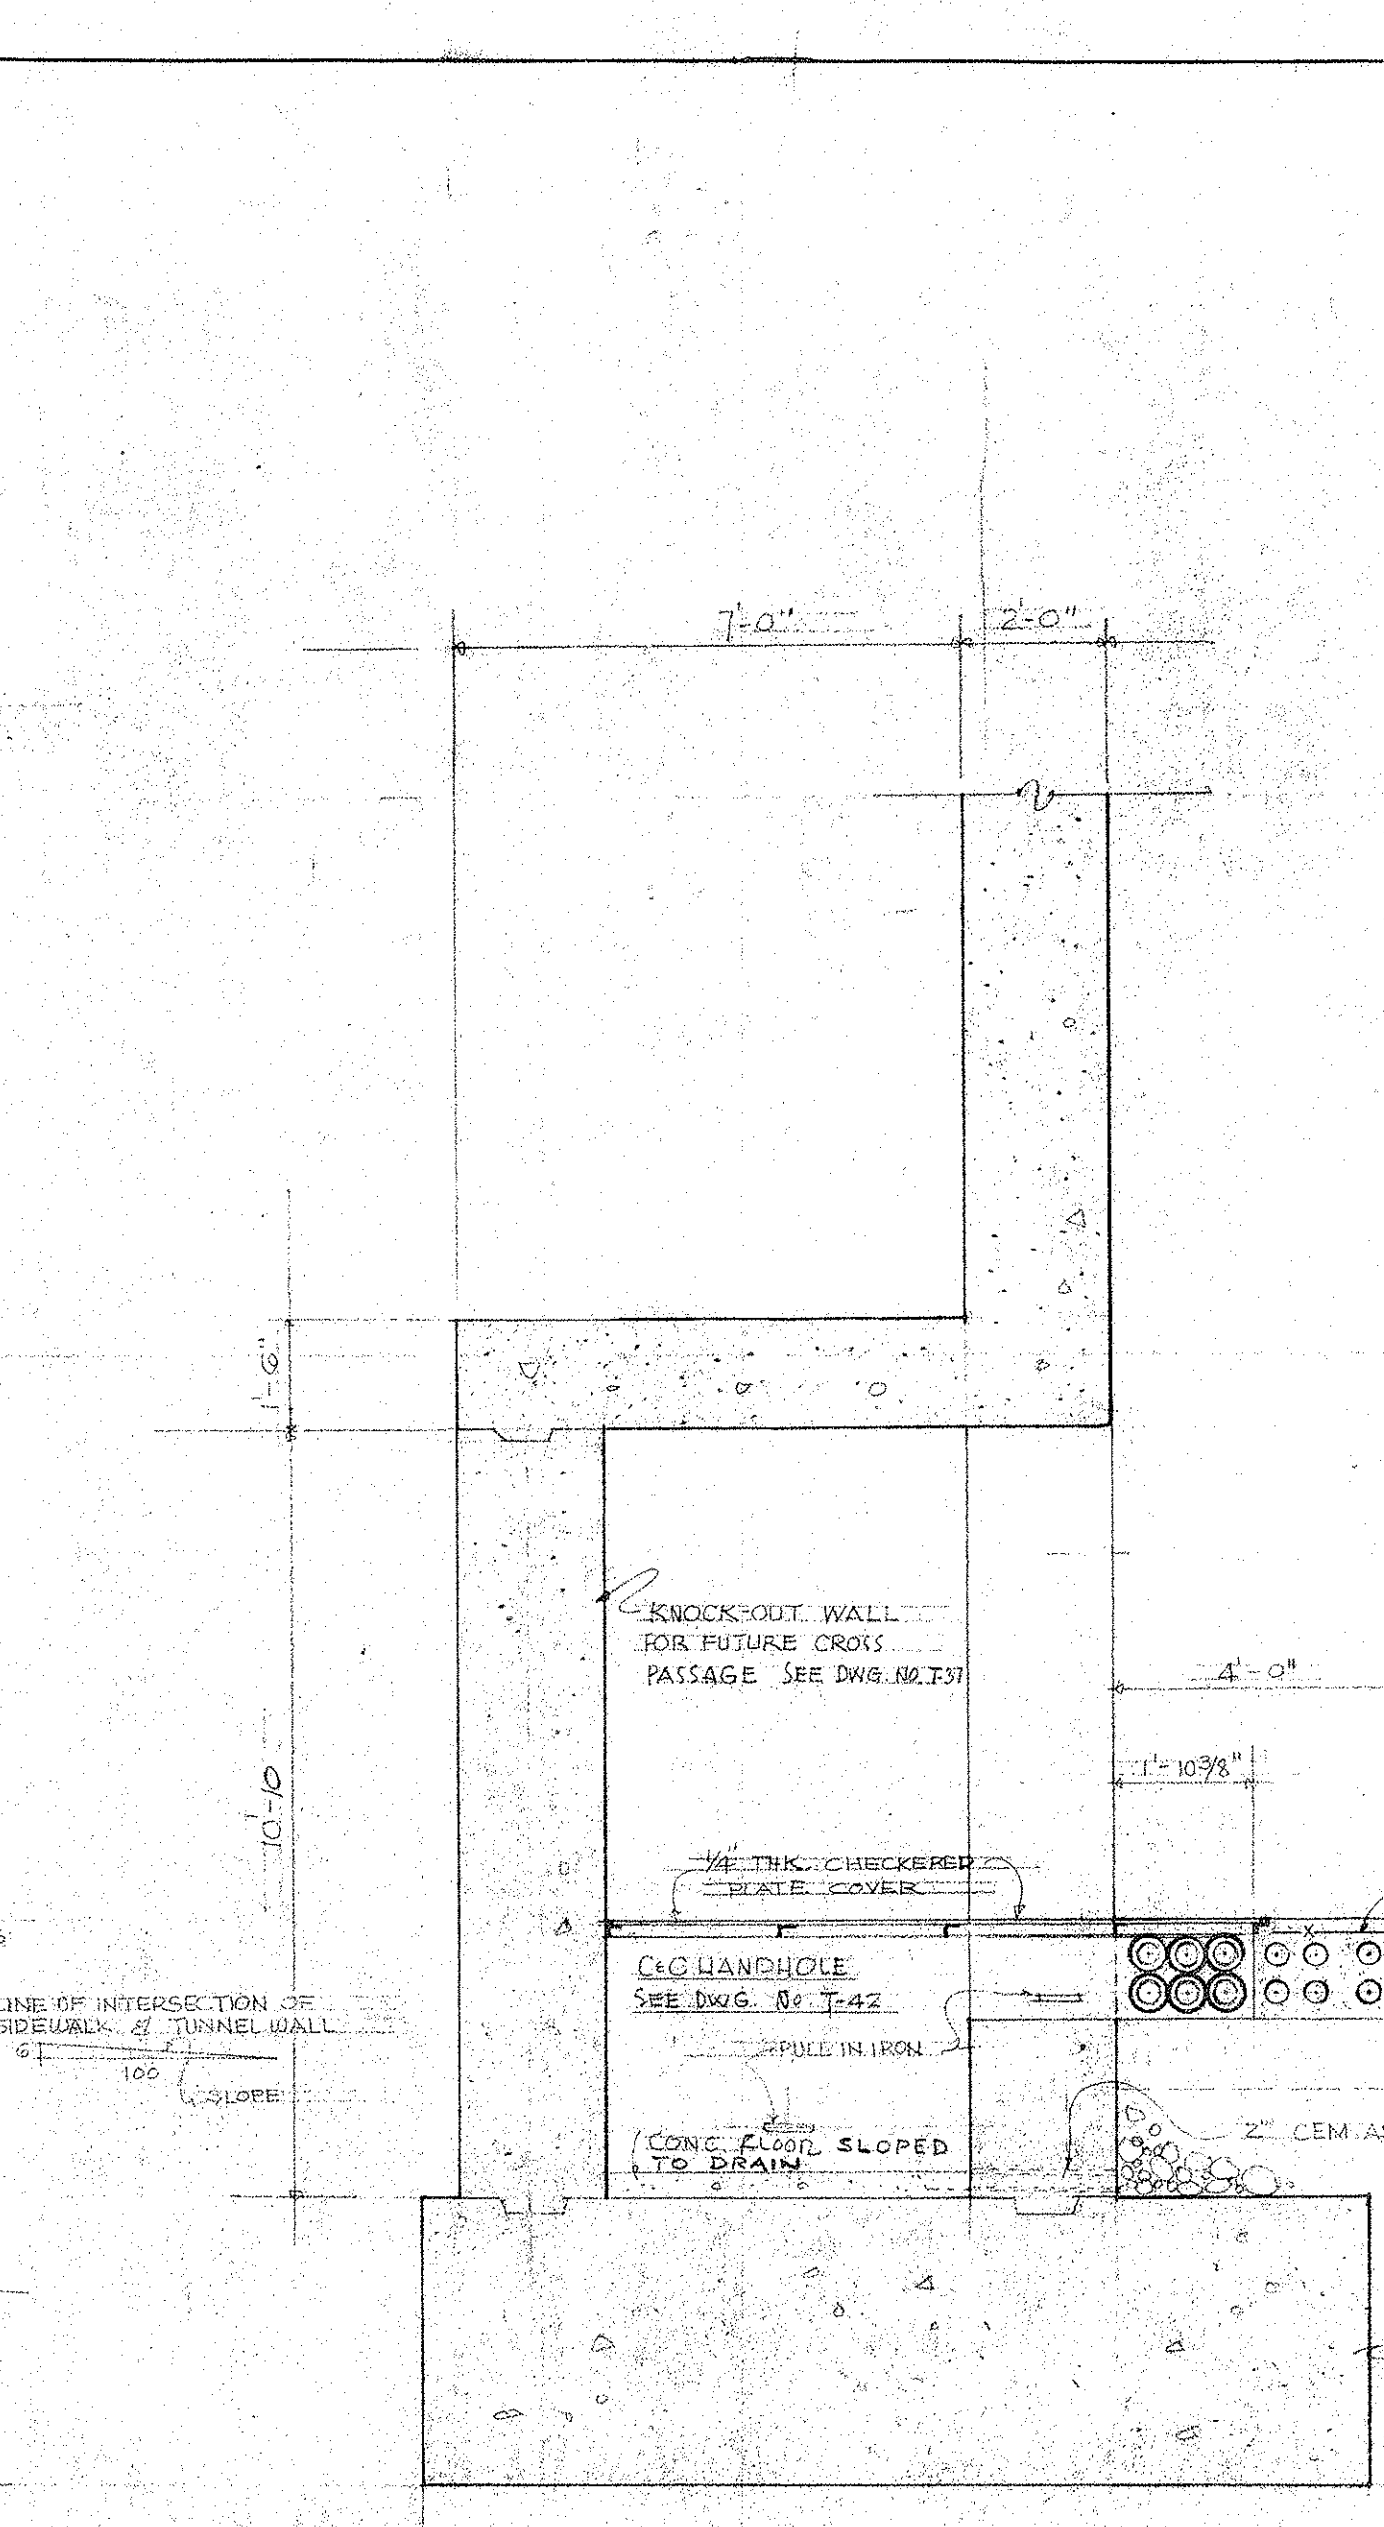


SECTION X-X

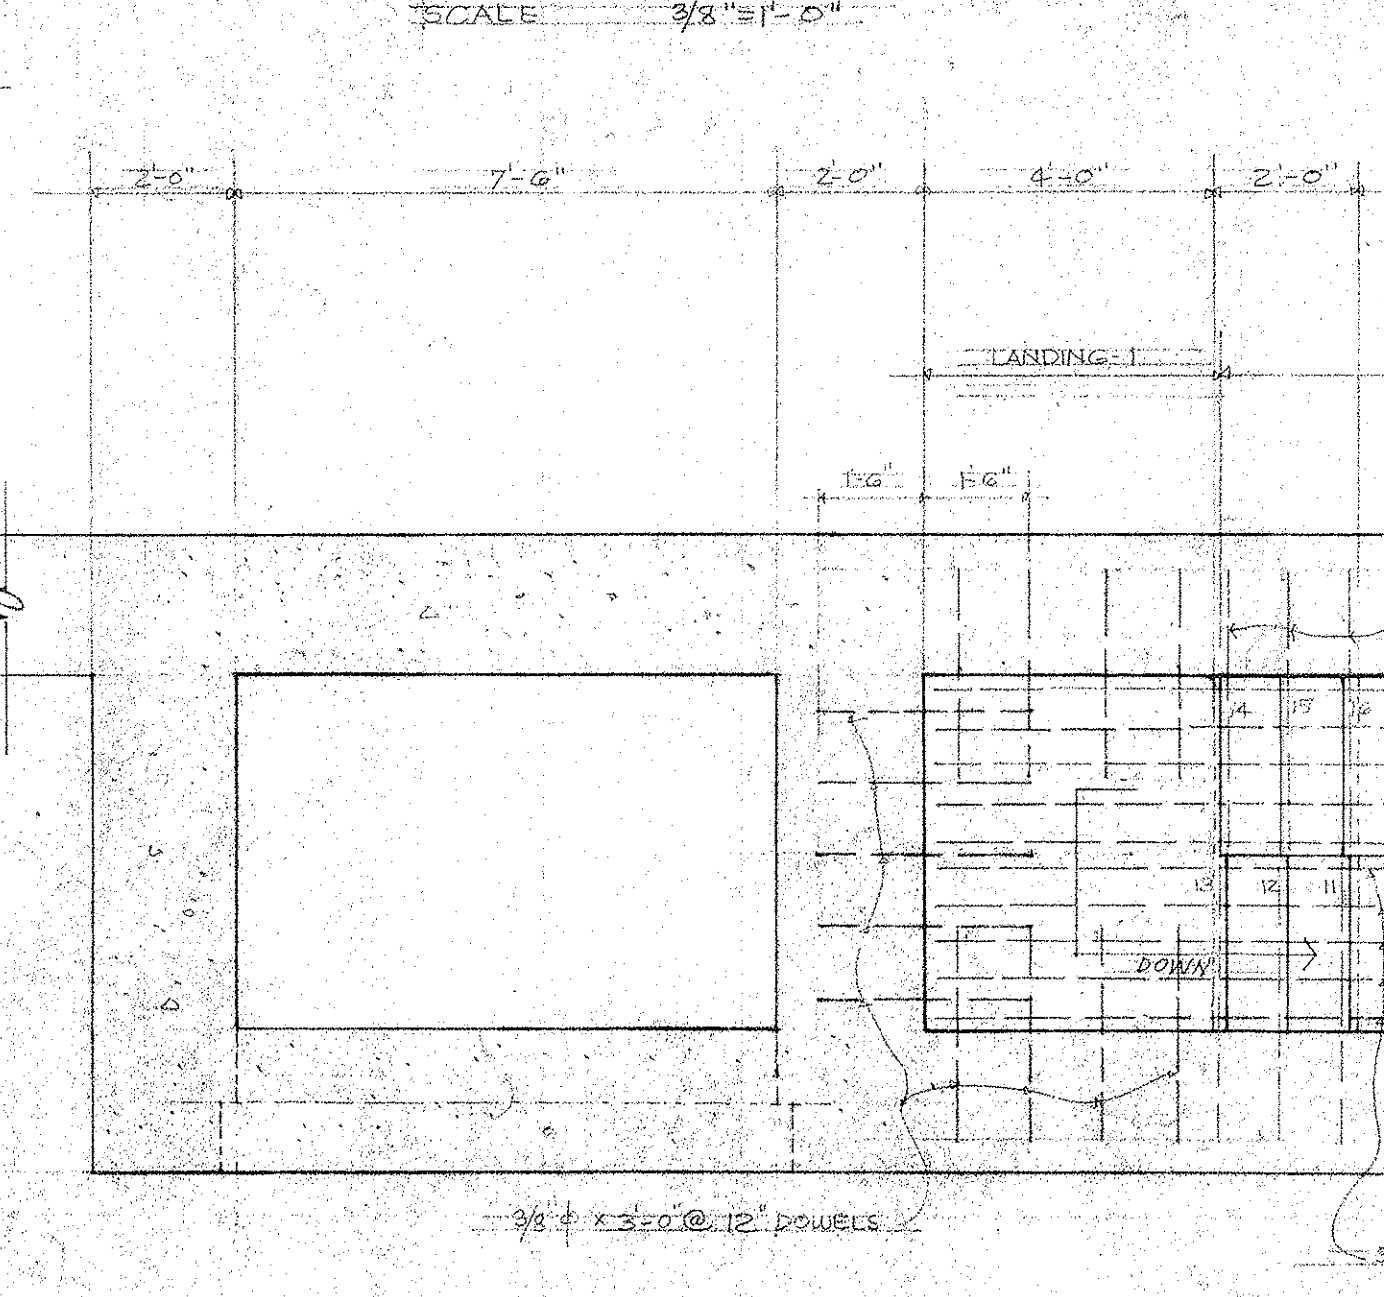

PLAN AT AIR SHAFT

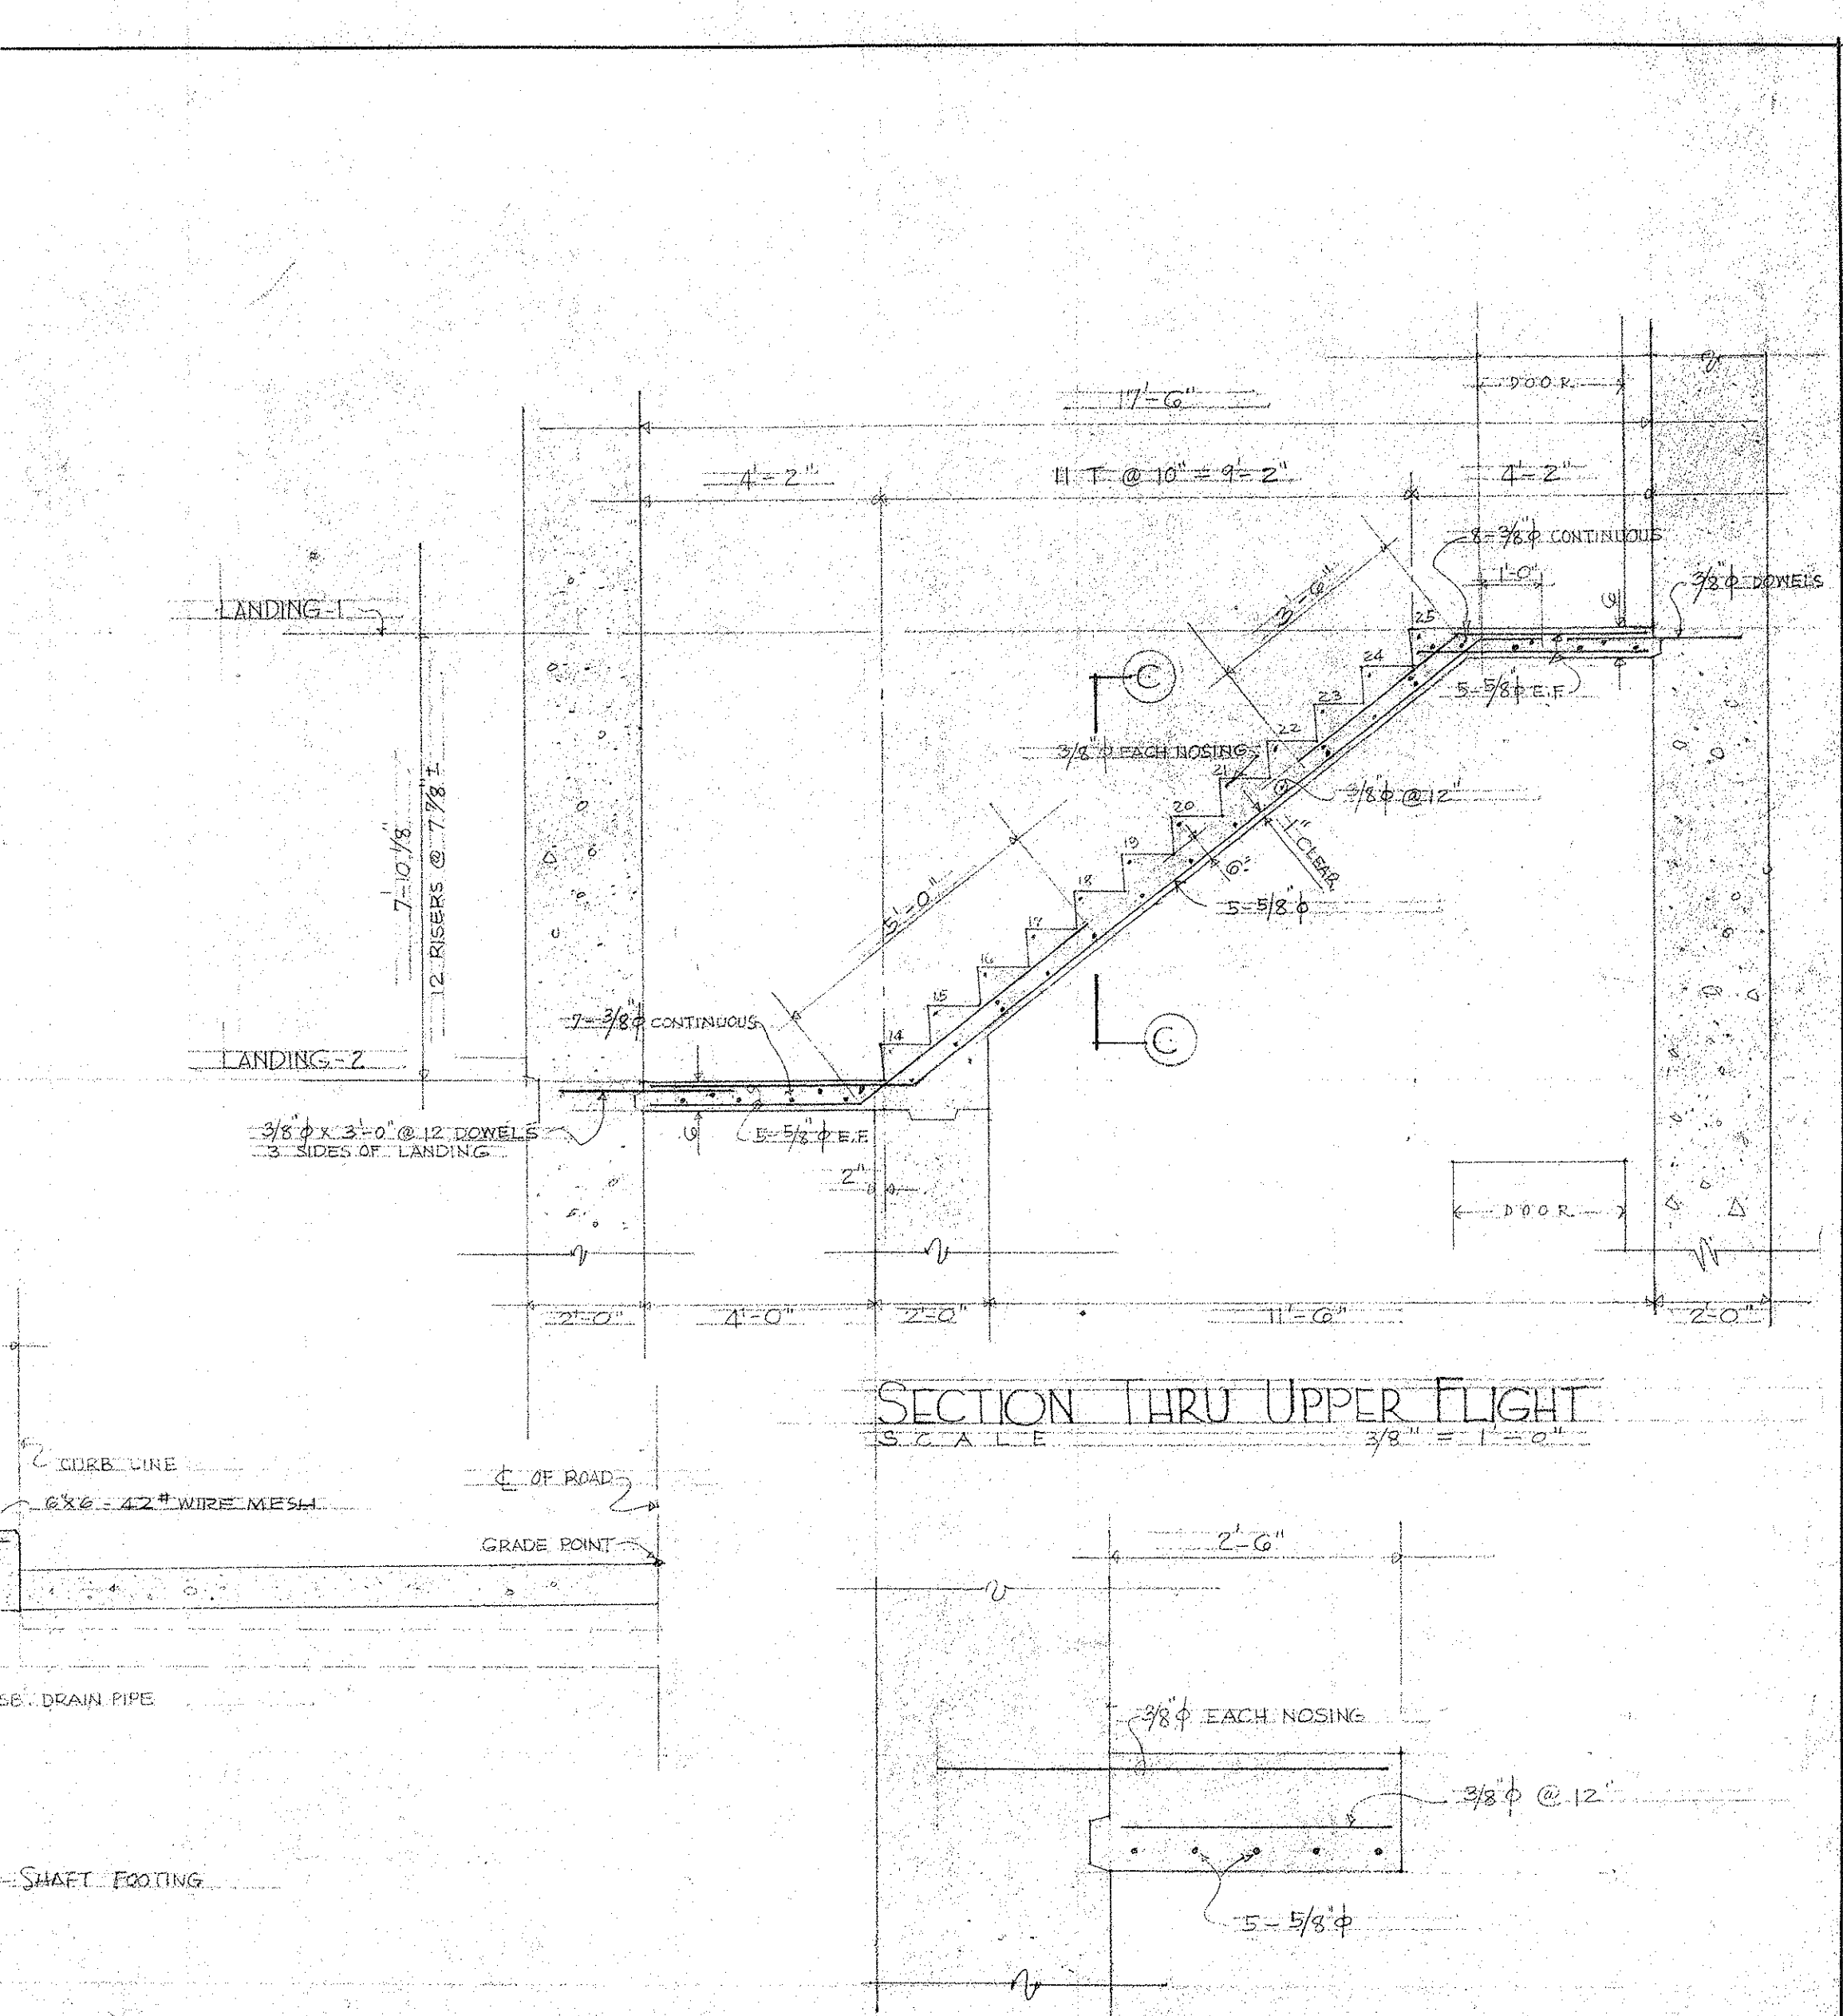

SECTION C-C AT WALL

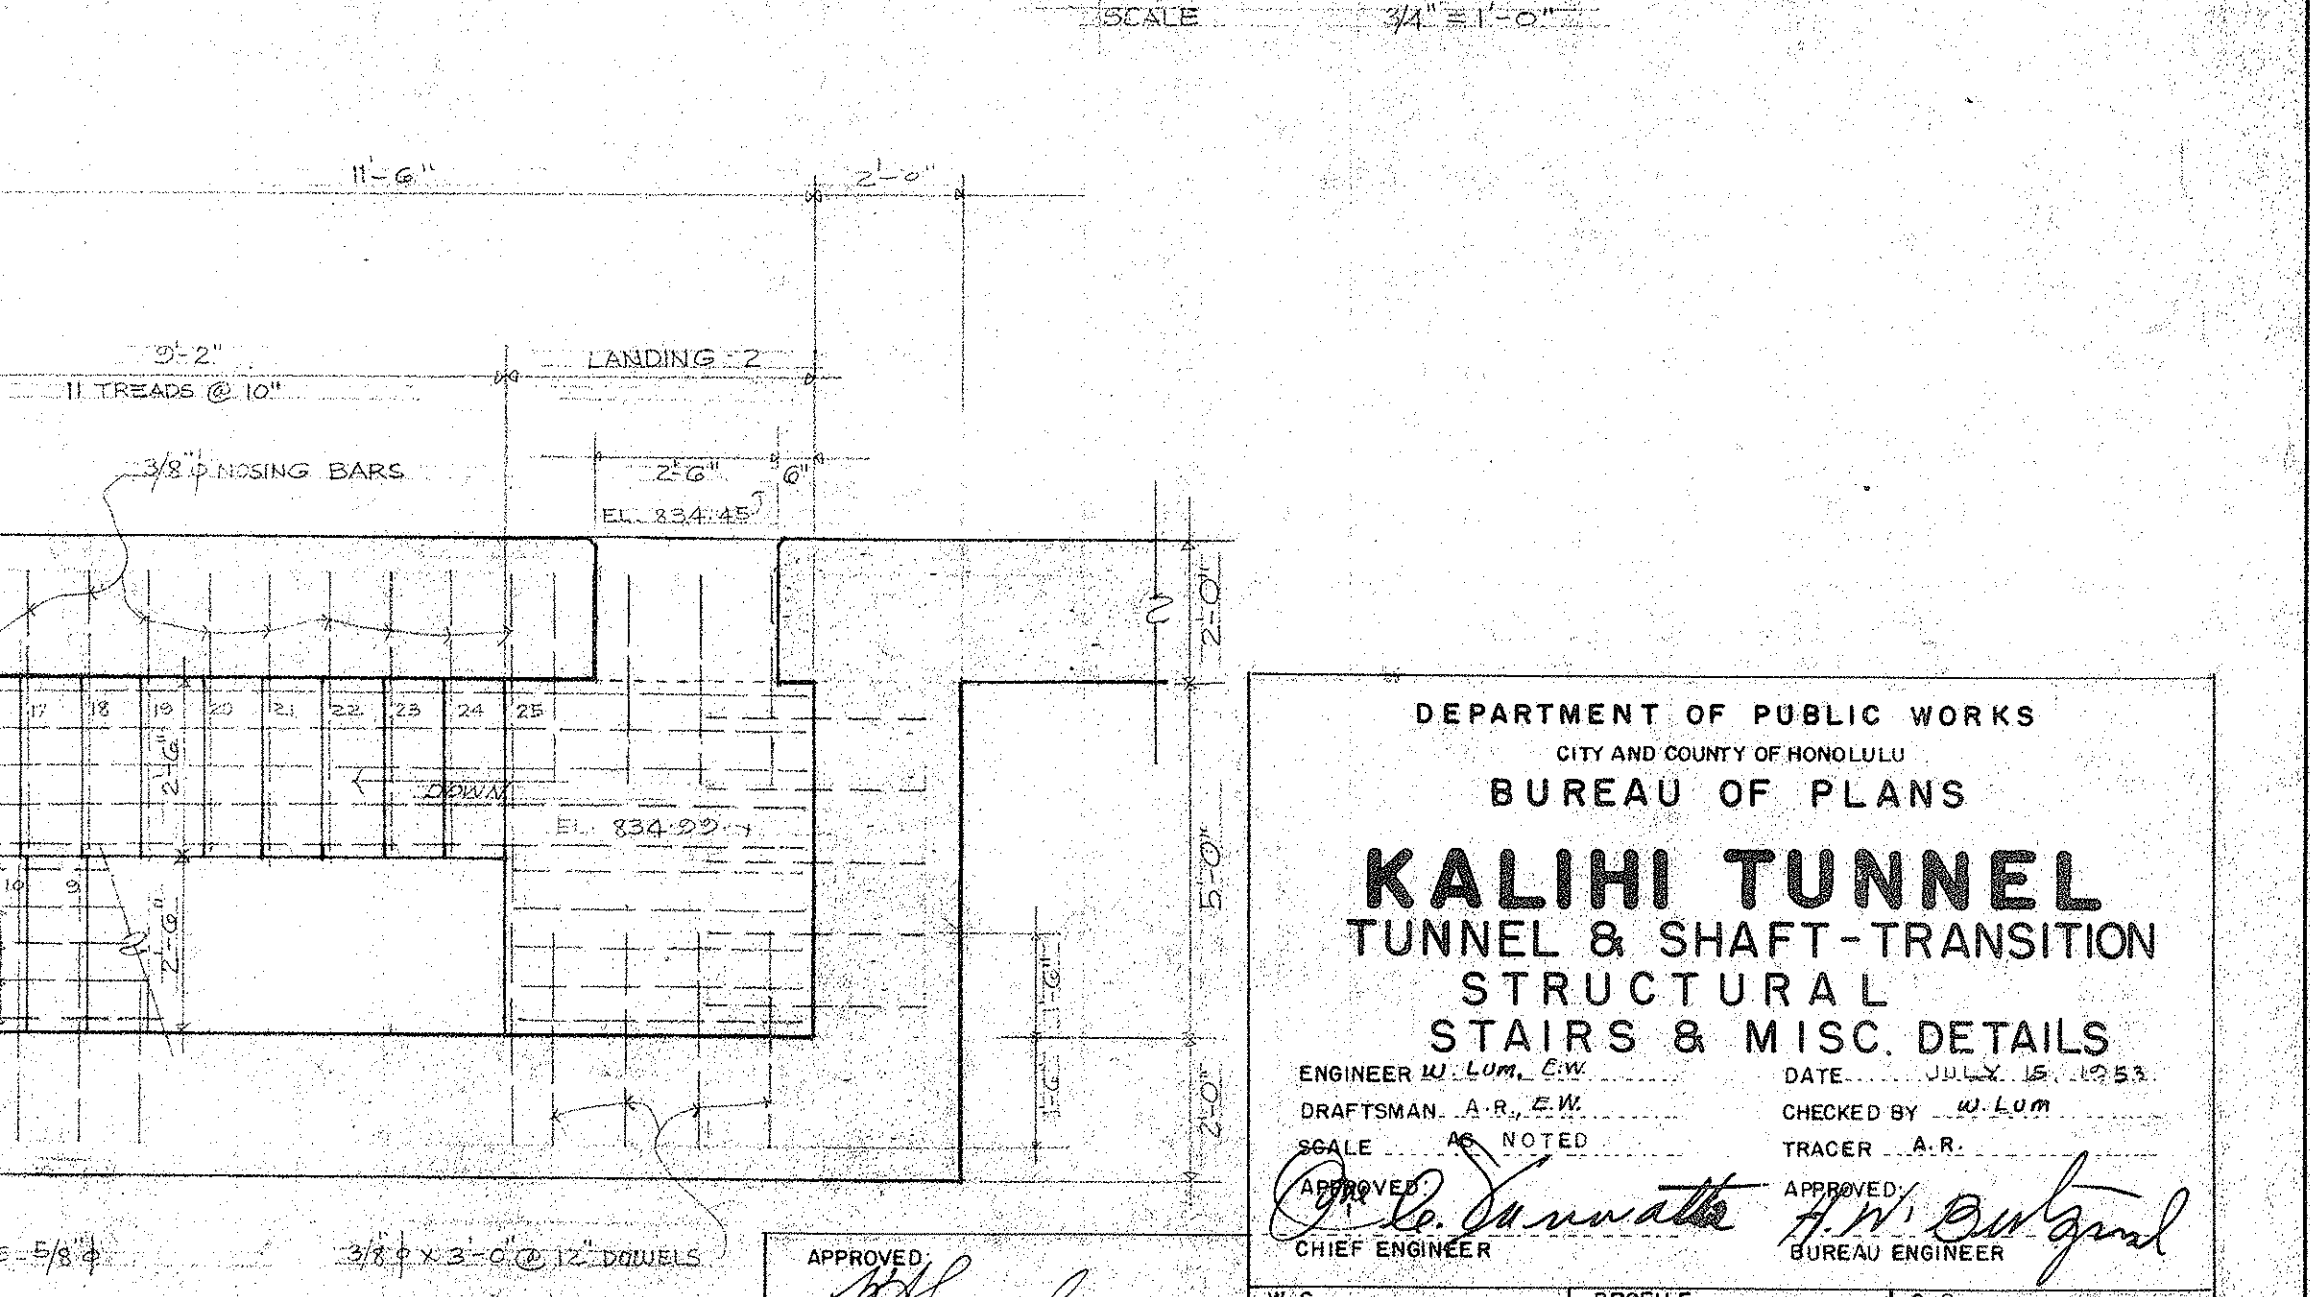

APPROVED
ENGINEER
KALIH TUNNEL

DEPARTMENT OF PUBLIC WORKS
CITY AND COUNTY OF HONOLULU
BUREAU OF PLANS
KALIH TUNNEL
TUNNEL & SHAFT-TRANSITION
STRUCTURAL
STAIRS & MISC. DETAILS
ENGINEER W. LUM, CIV. DATE JULY 15, 1953
DRAFTSMAN A. R. E. W. CHECKED BY W. LUM
SCALE AS NOTED TRACER A. R.
APPROVED BY *[Signature]* APPROVED BY *[Signature]*
CHIEF ENGINEER BUREAU ENGINEER

W.S.	PROFILE	C.B.
CR. SEC.	P.W.	S.B.
W.M. BY	P.W. BY	S.B. BY

SECTION C JOB NO. 26-53 DWG. T-38