




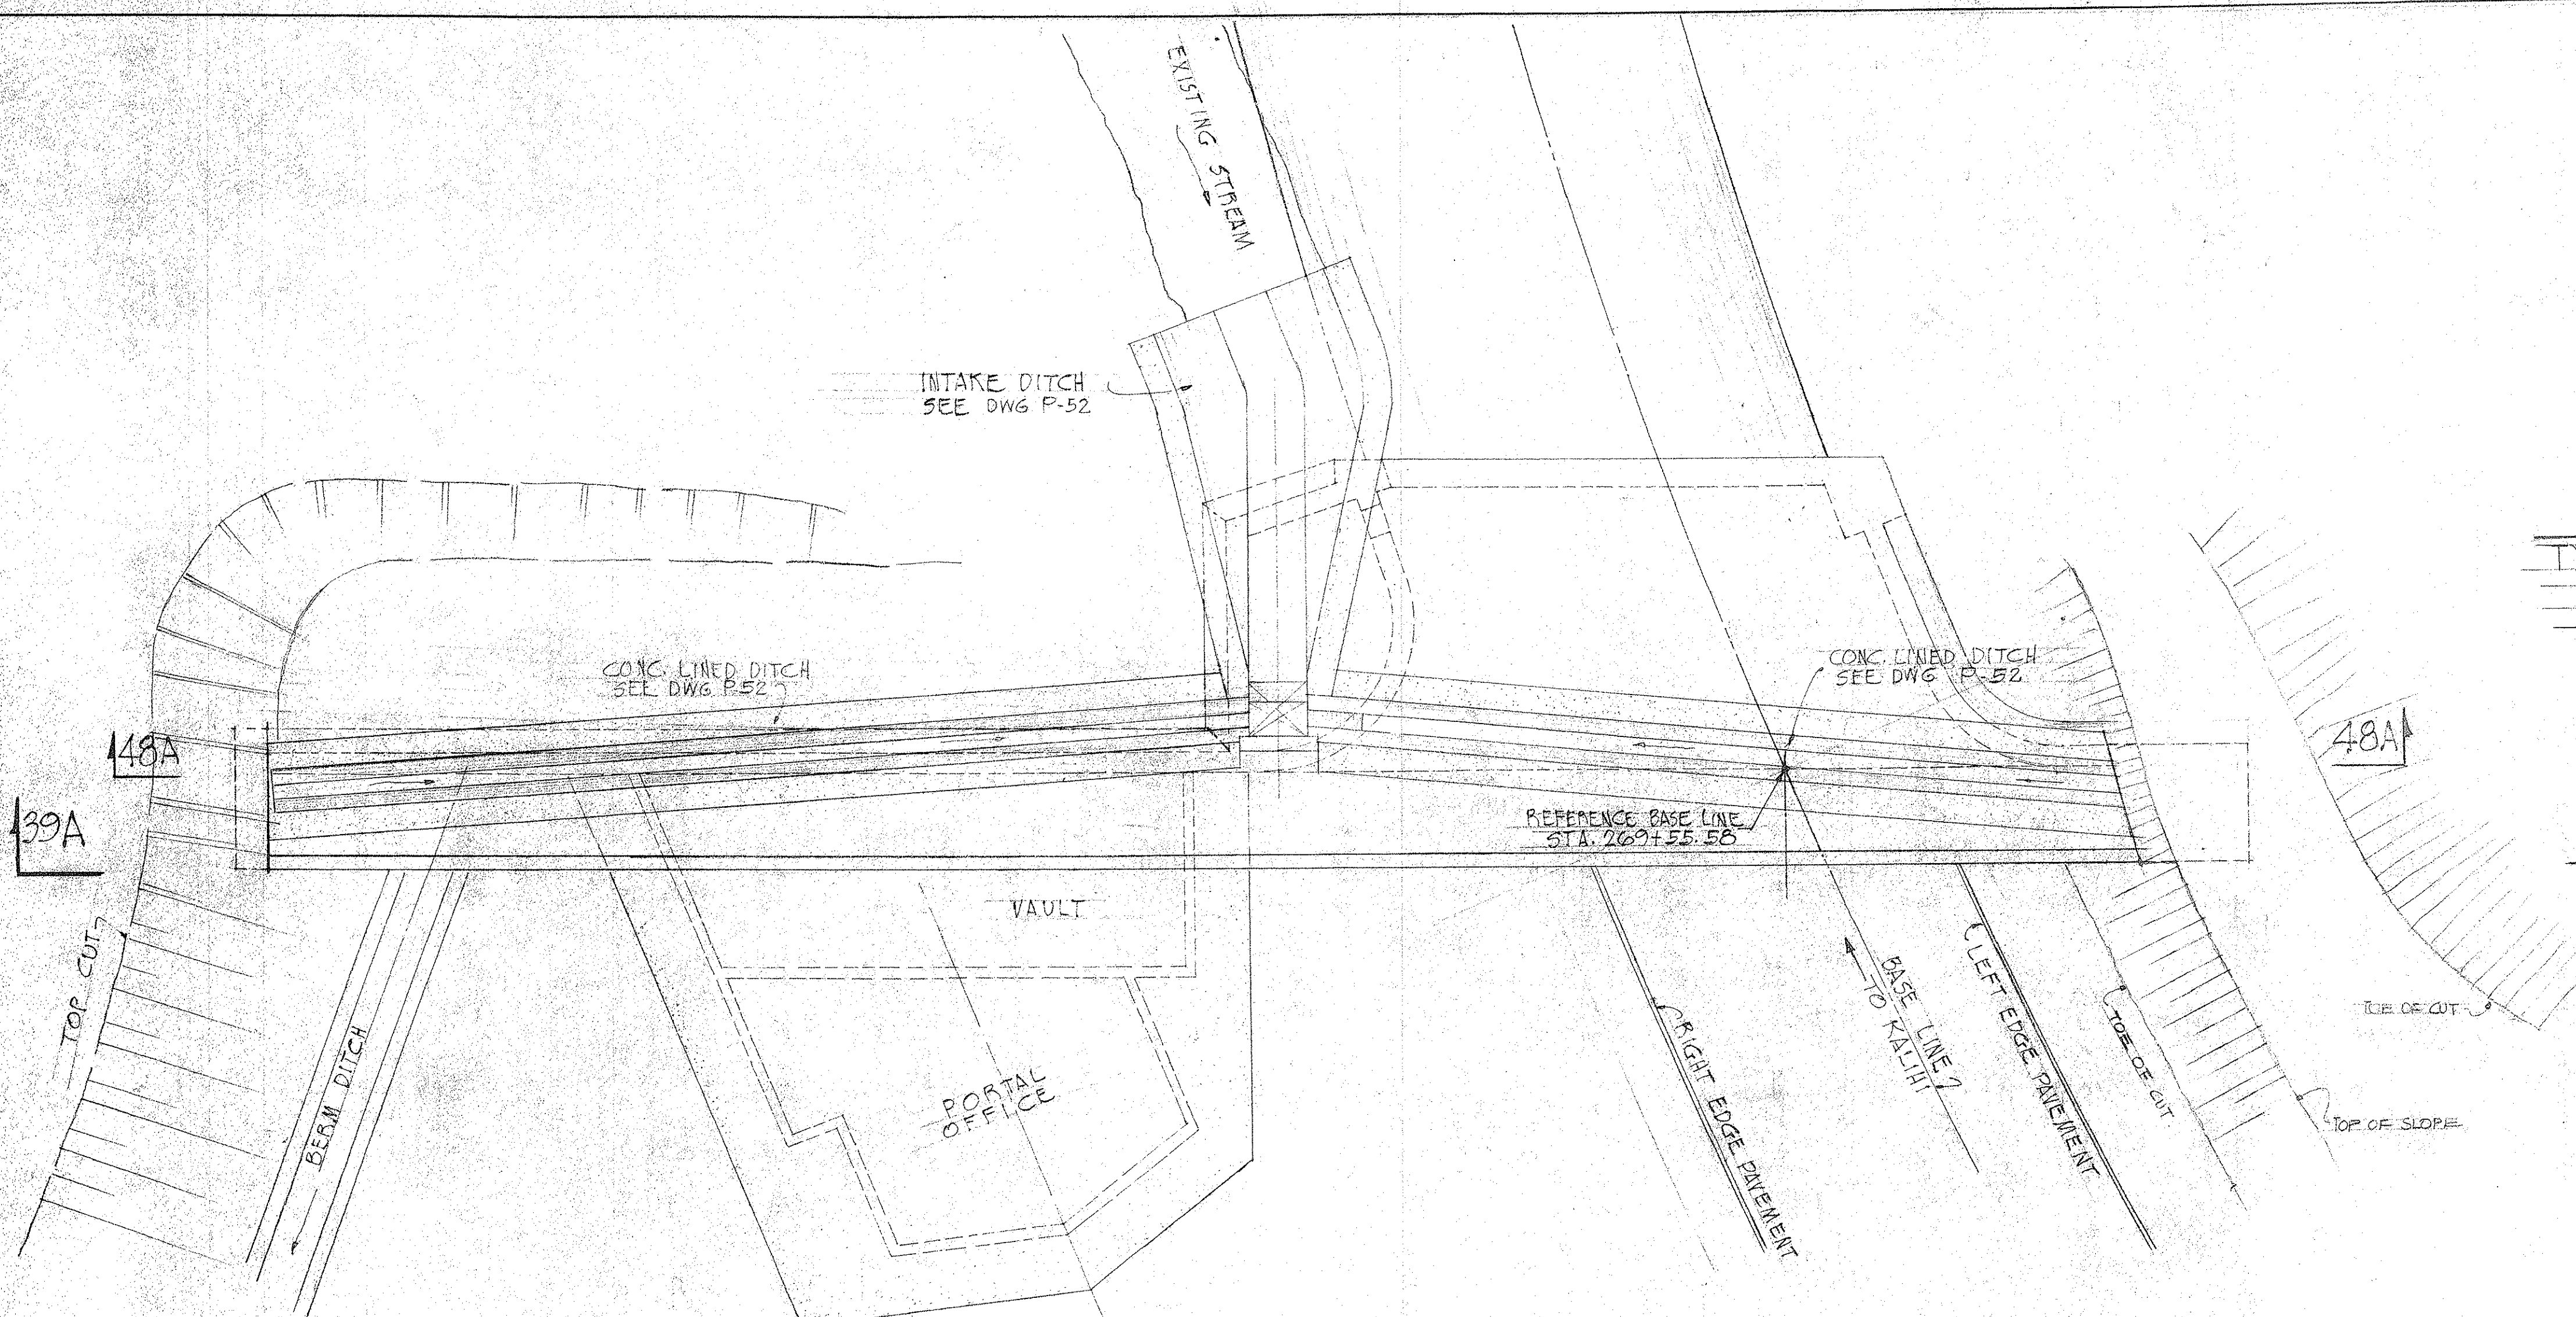

LAYOUT PLAN . . KANE OHE PORTAL . . SCALE: 1/8"=1'-0"

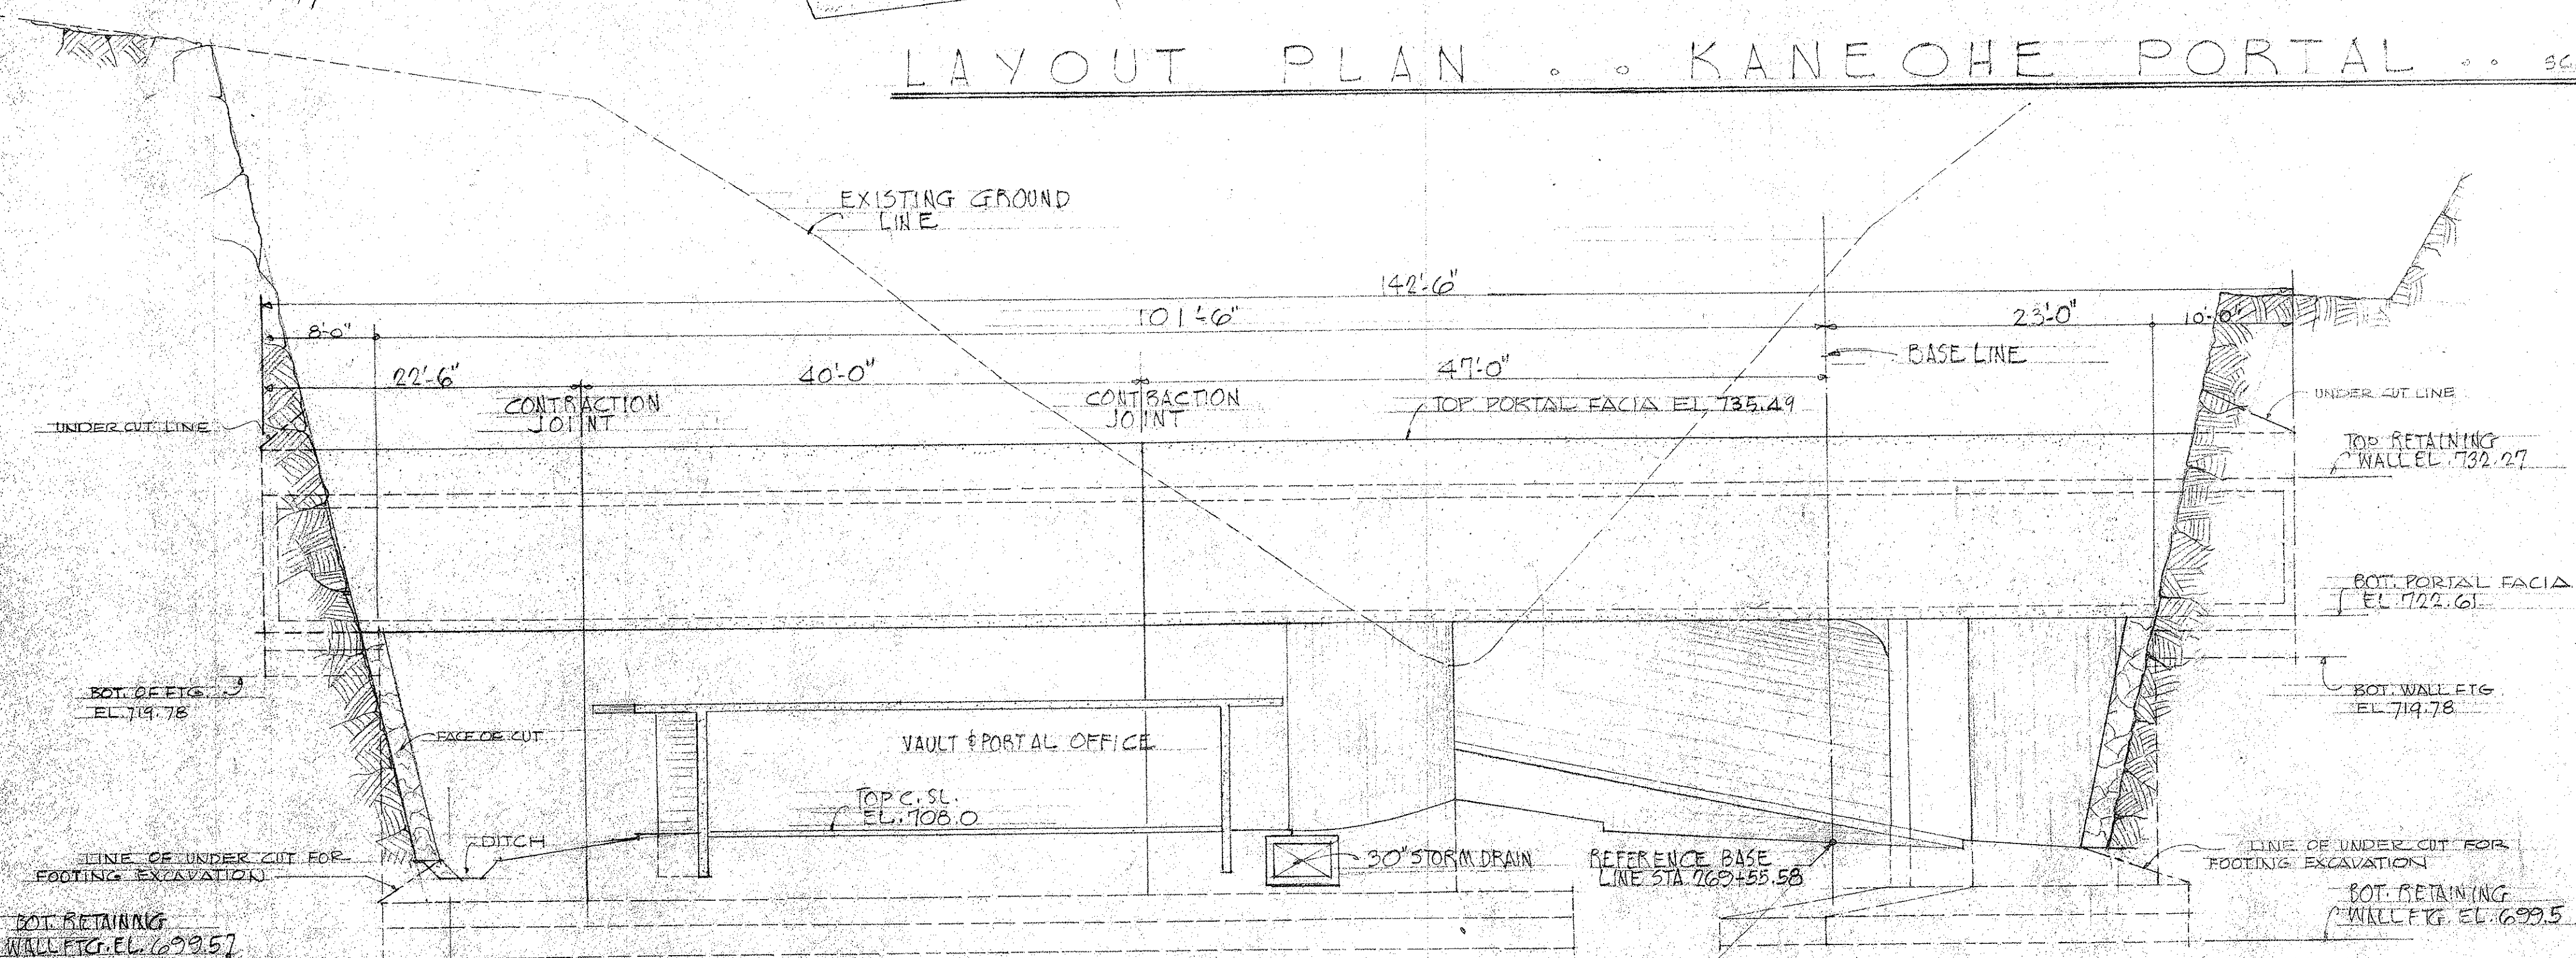


SECTION "39A-39A" . . PORTAL ELEVATION . . SCALE: 1/8"=1'-0"

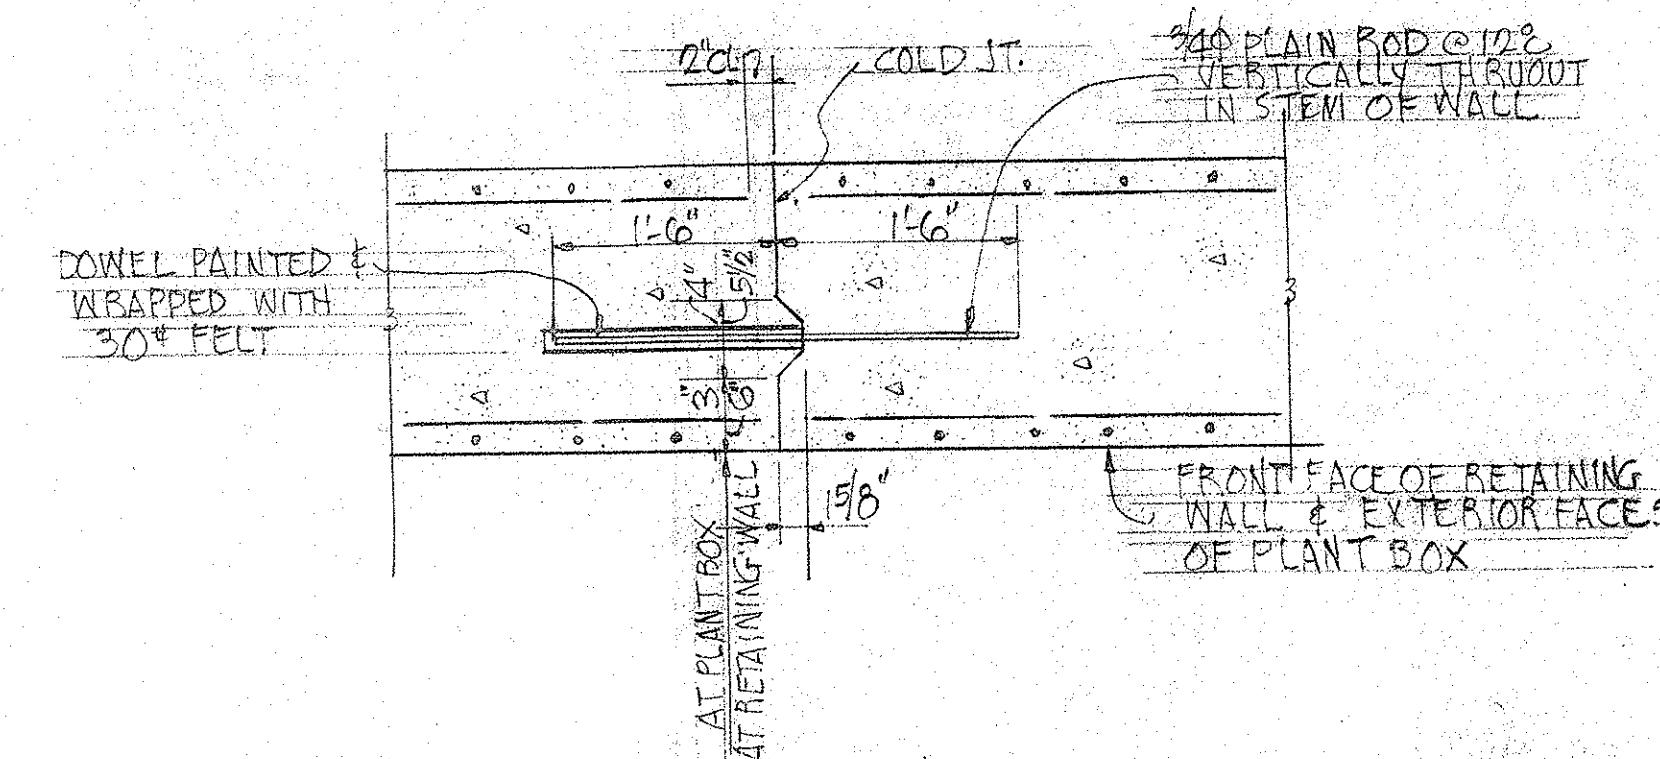

TYPICAL DETAIL OF VERTICAL CONTRACTION JOINTS
FOR RETAINING WALL AND BOX

SCALE: 3/4"=1'-0"

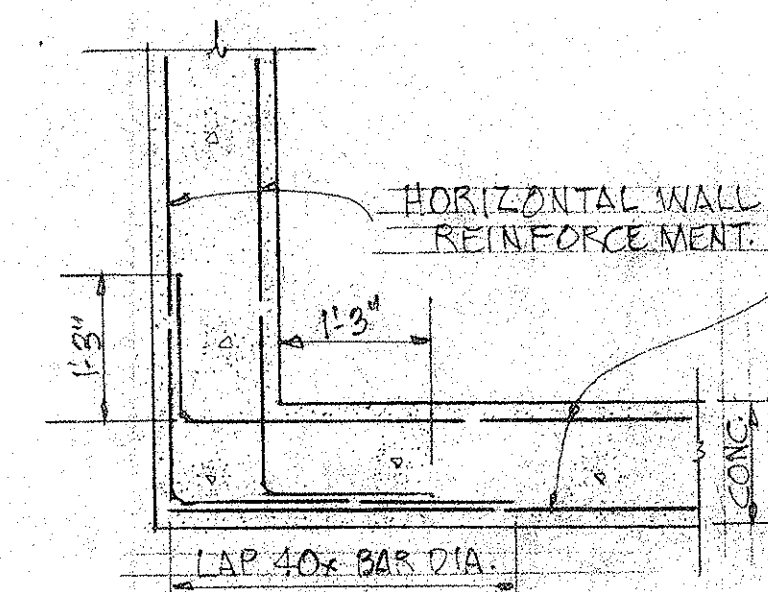

TYPICAL CORNER DETAIL
AT WALLS & BOX

NOTES

GENERAL:

FOR LOCATION OF WEED HOLES SEE ARCH. DRNGS.

LAW & WILSON ARCHITECTS & ENGINEERS	
DEPARTMENT OF PUBLIC WORKS CITY AND COUNTY OF HONOLULU	
BUREAU OF PLANS	
KALIHI TUNNEL	
KANE OHE PORTAL-STRUCTURAL	
LAYOUT PLAN	
ELEVATION & DETAILS	
ENGINEER L.B.W./D.L.	DATE JULY 15, 1953
DRAFTSMAN J.Y.L.	CHECKED BY D.L. [Signature]
SCALE AS NOTED	TRACER
APPROVED: [Signature] CHIEF ENGINEER	APPROVED: [Signature] BUREAU ENGINEER

APPROVED:
[Signature]
ENGINEER, KALIHI TUNNEL

W.S.	PROFILE	C.S.
CR. SEC.	F.B.	S.B.
W.M.B.Y.	F.W.B.Y.	S.B.Y.

SECTION C JOB NO. 26-53 DWG. P-39