




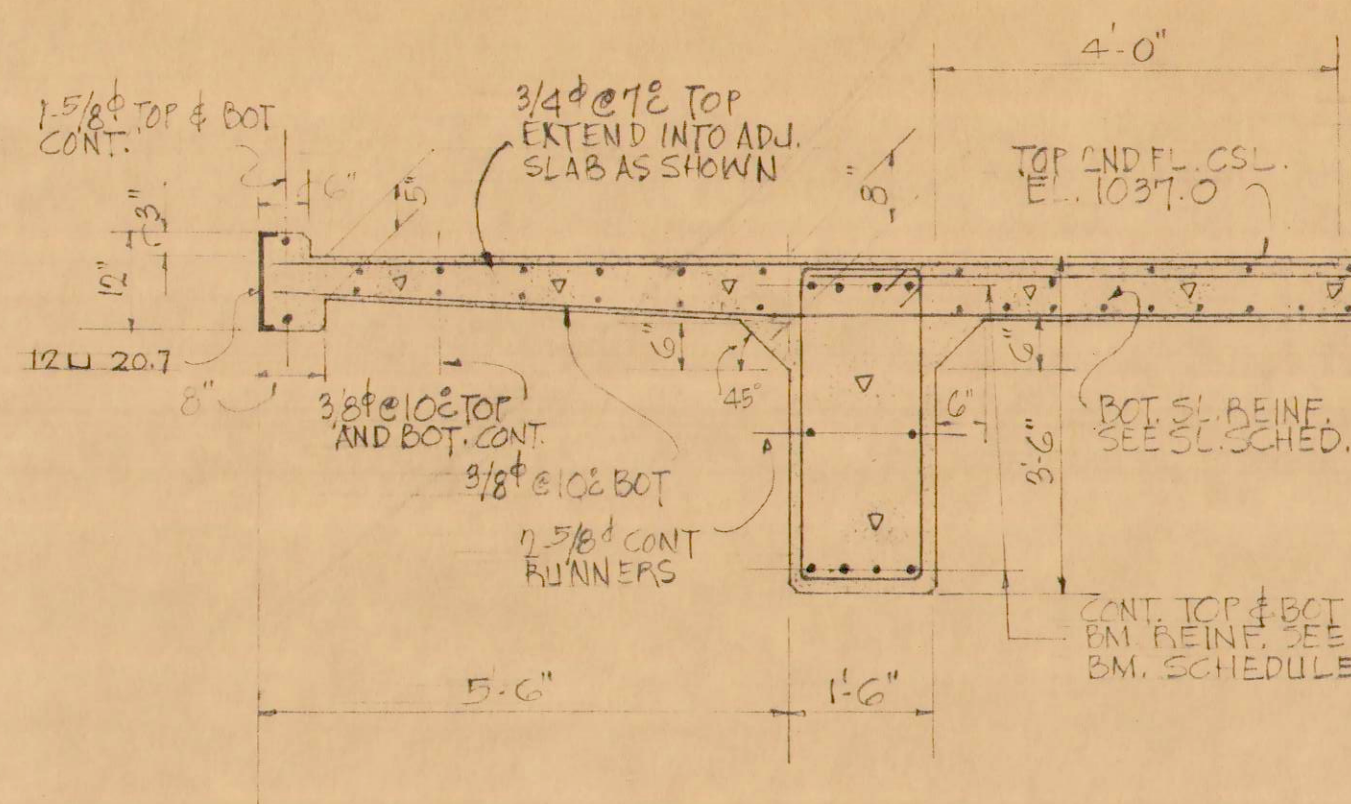


SECTION "30A-30A"
SCALE: 1/2"=1'-0"

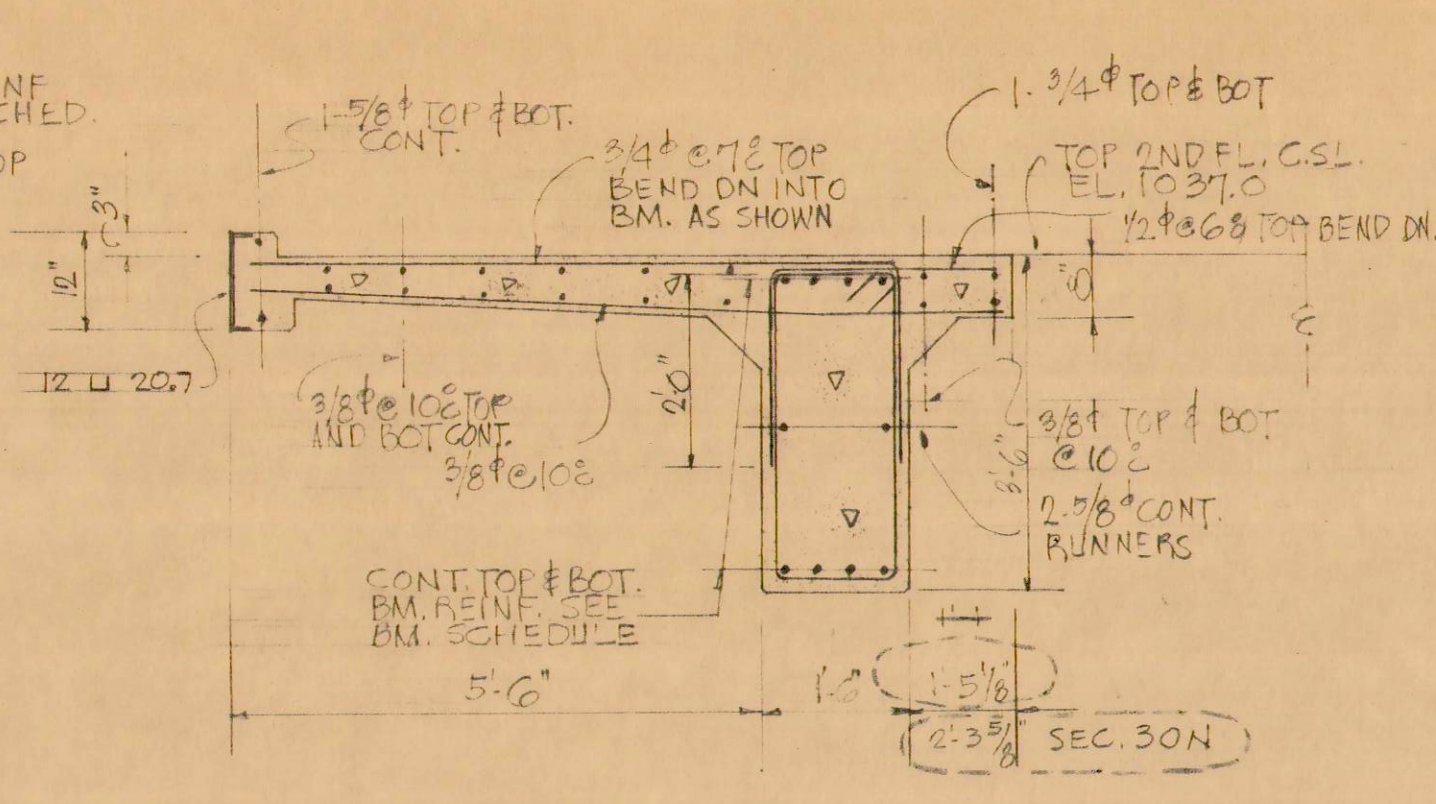


SECTION "30B-30B"
SCALE: 1/2"=1'-0"
(SECTION 30N-30N SIMILAR EXCEPT AS NOTED)

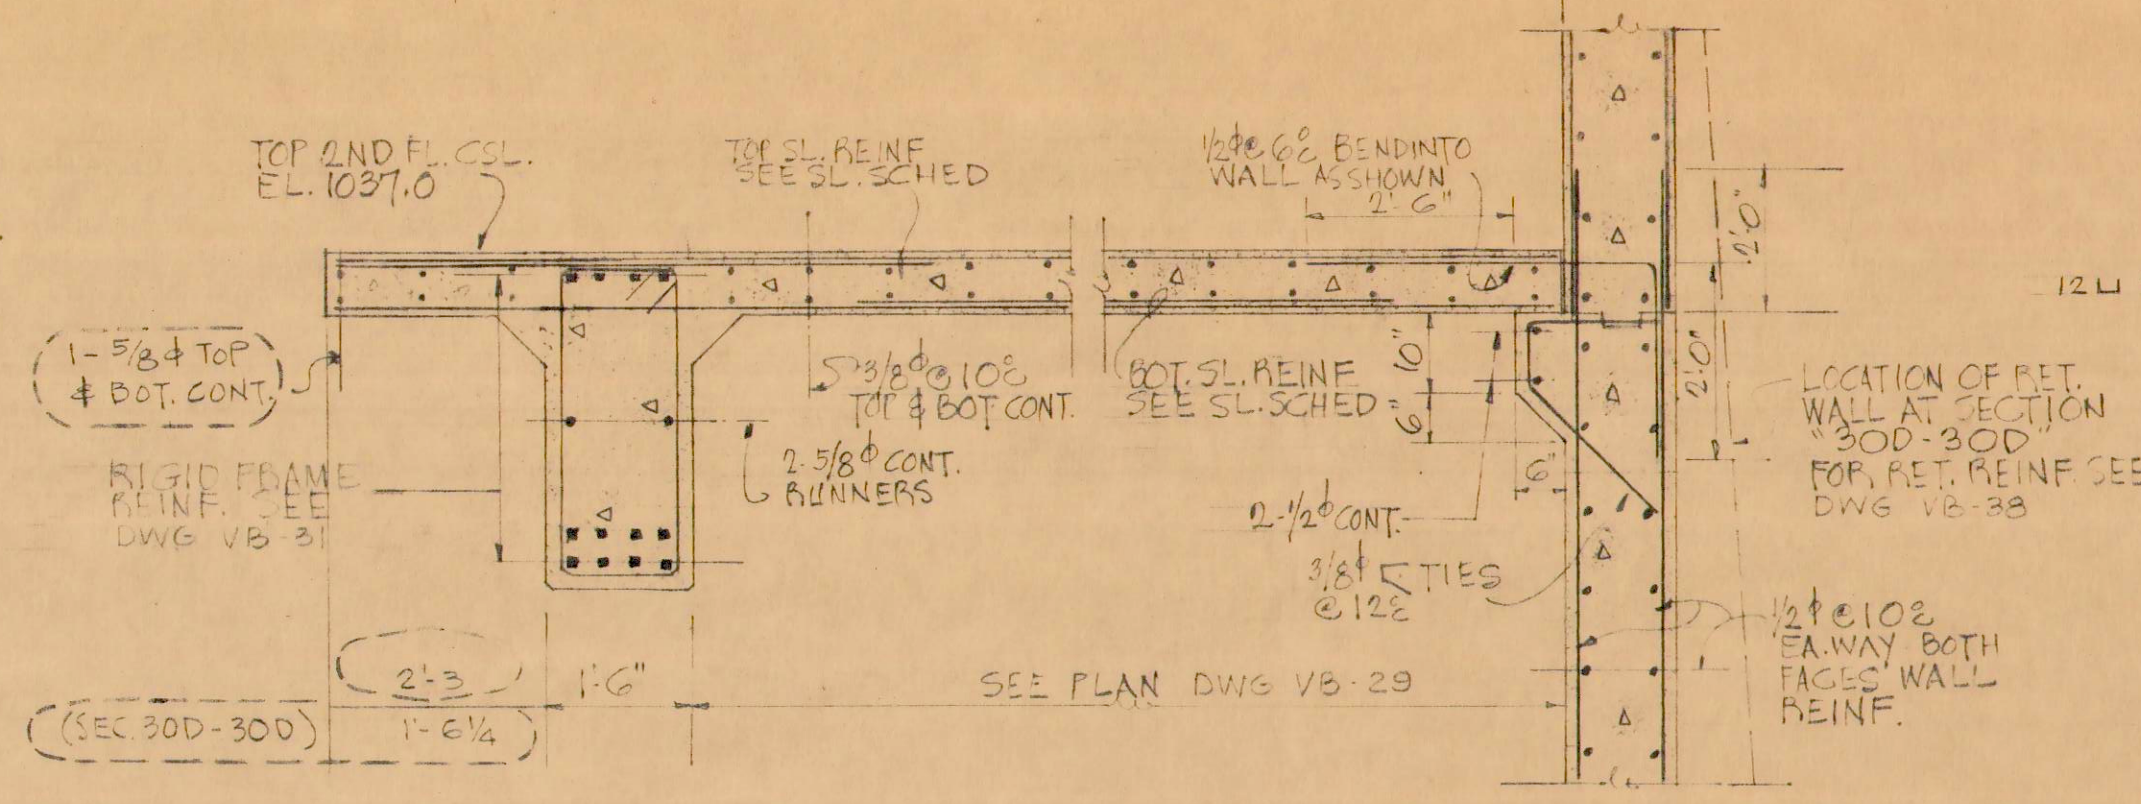


SECTION "30C-30C"
(SECTION "30D-30D" SIMILAR EXCEPT AS NOTED)
SCALE: 1/2"=1'-0"

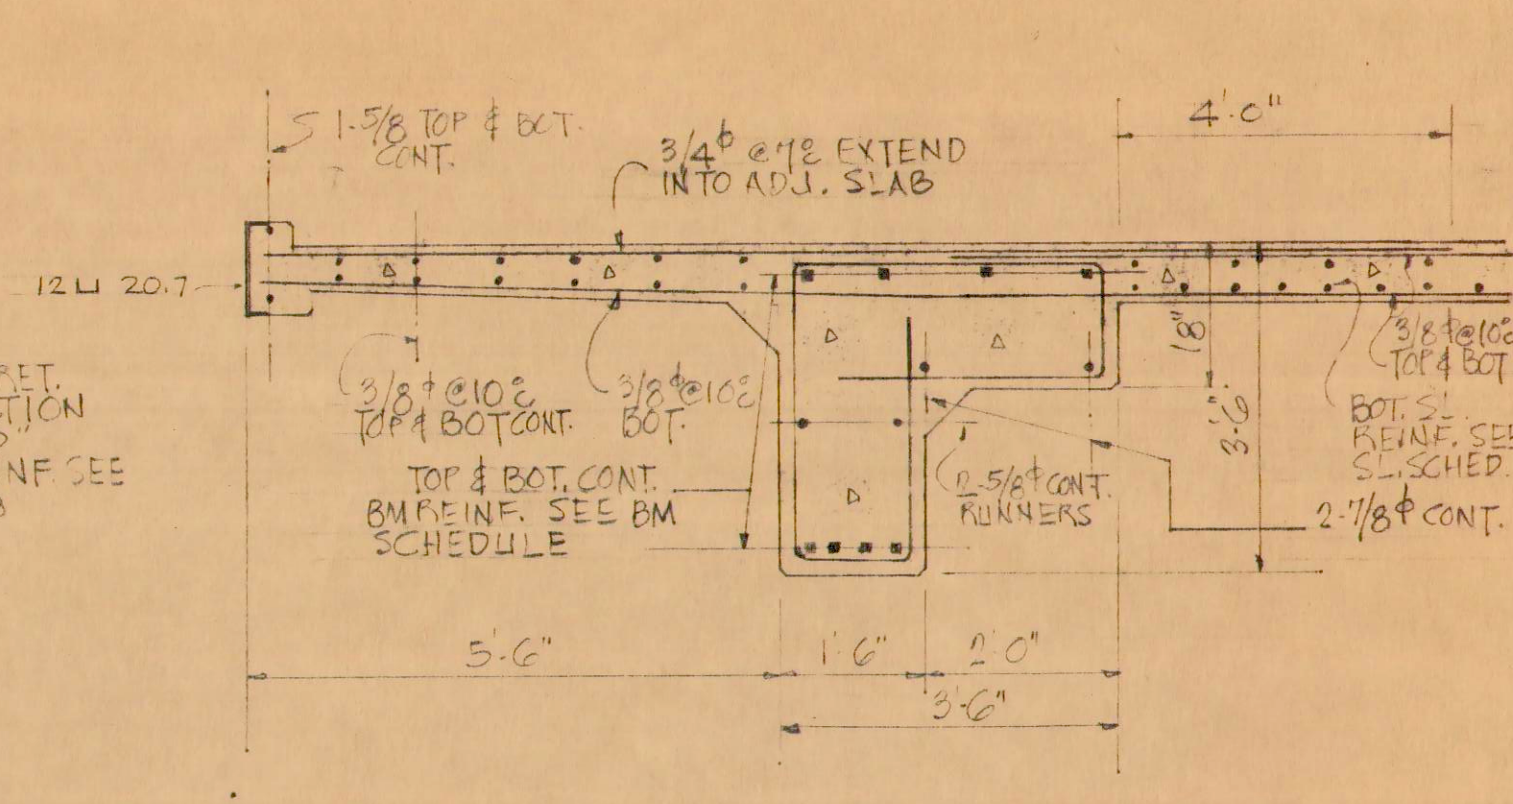


SECTION "30E-30E"
SCALE: 1/2"=1'-0"

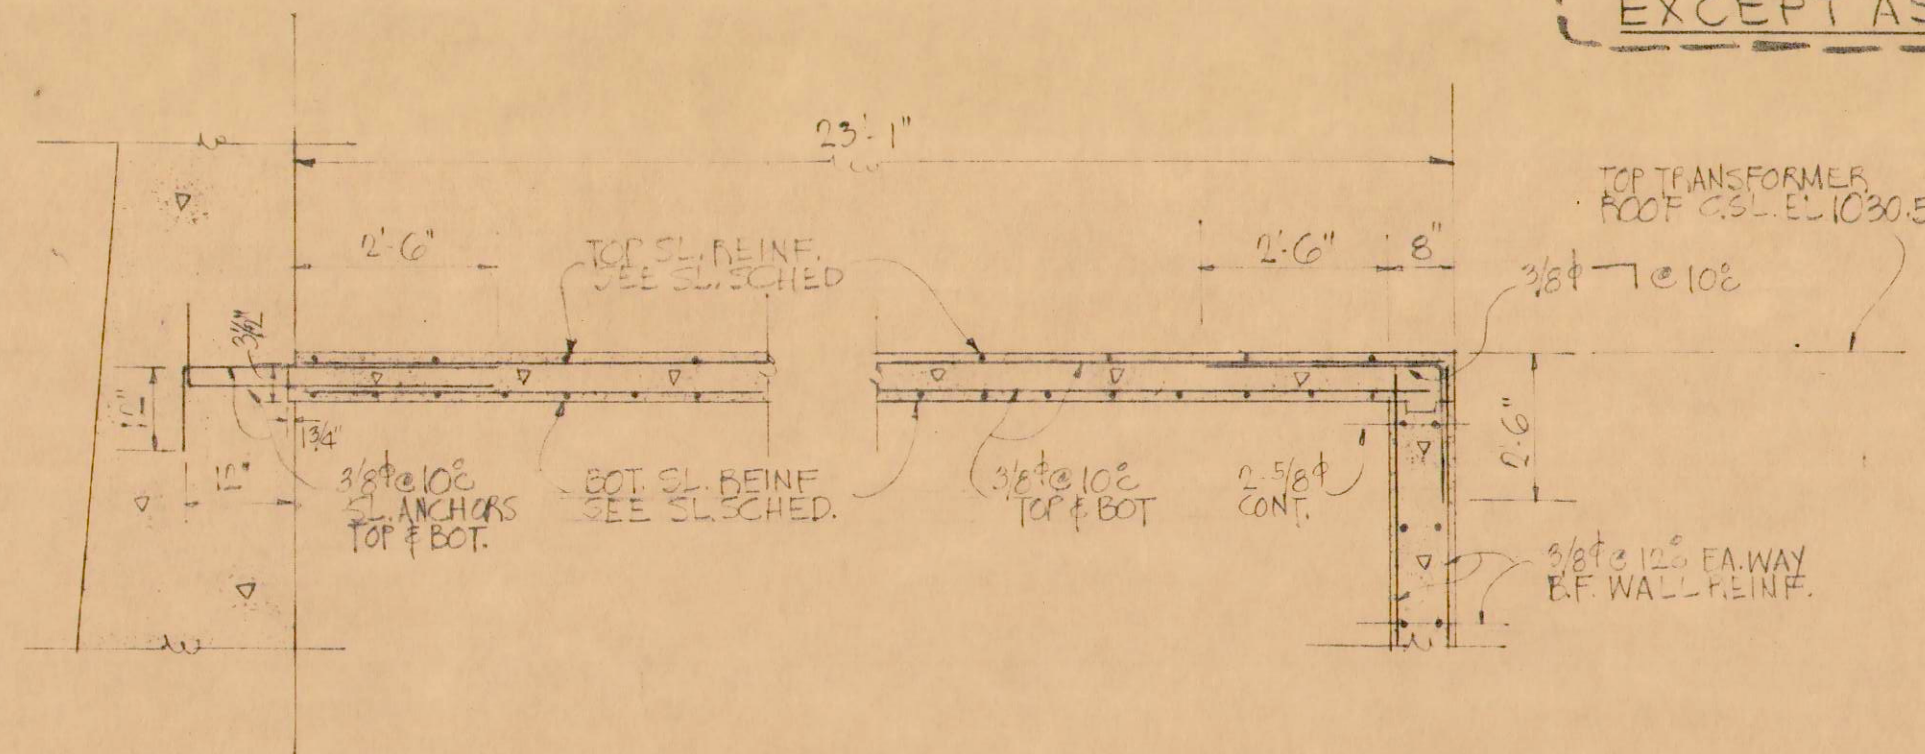


SECTION "30F-30F"
SCALE: 1/2"=1'-0"

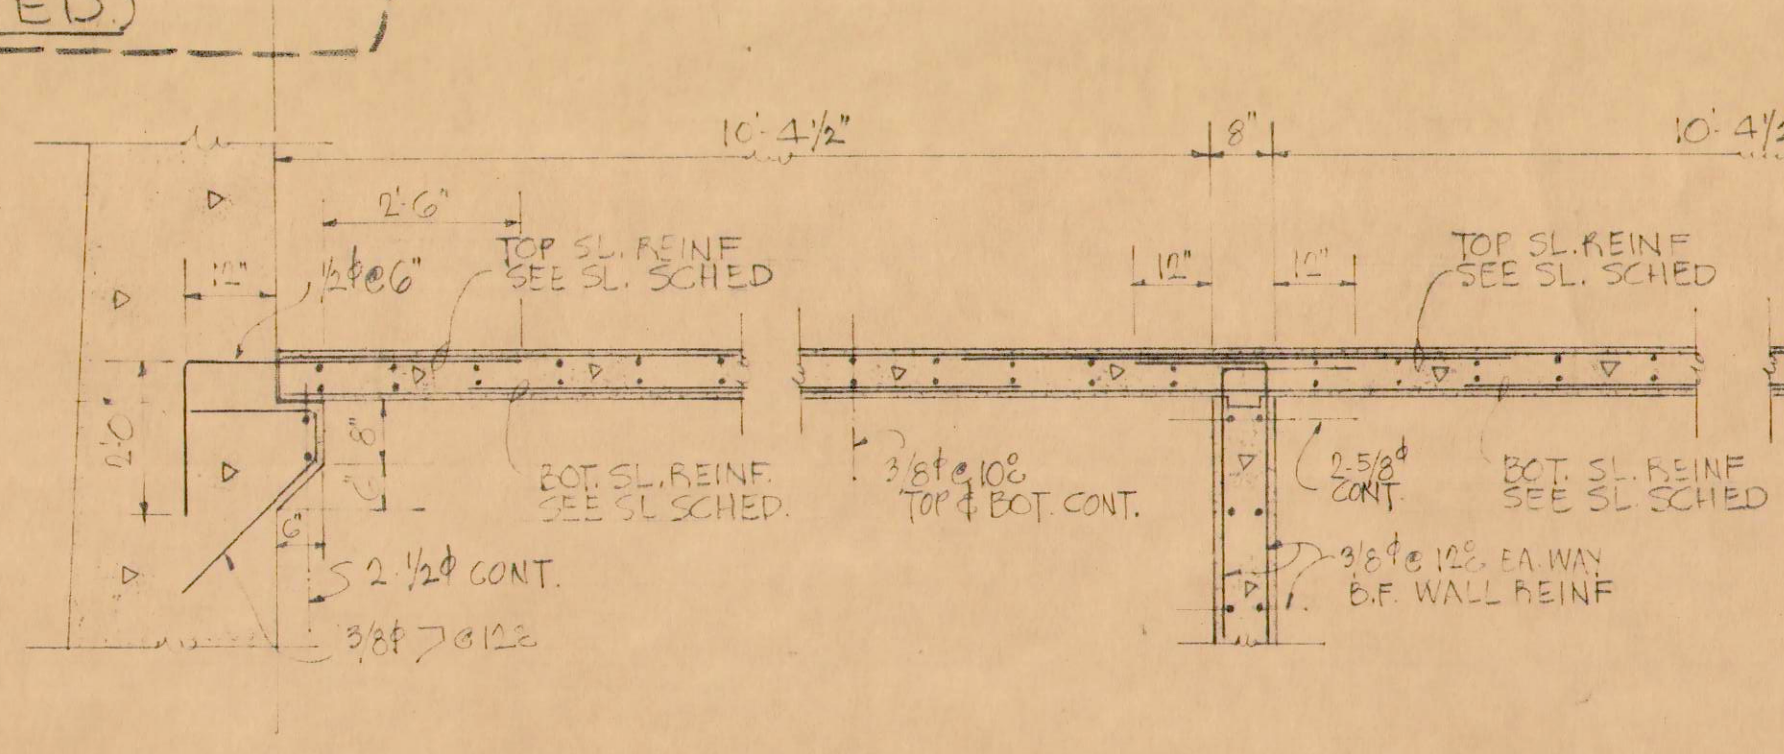


SECTION "30G-30G"
SCALE: 1/2"=1'-0"

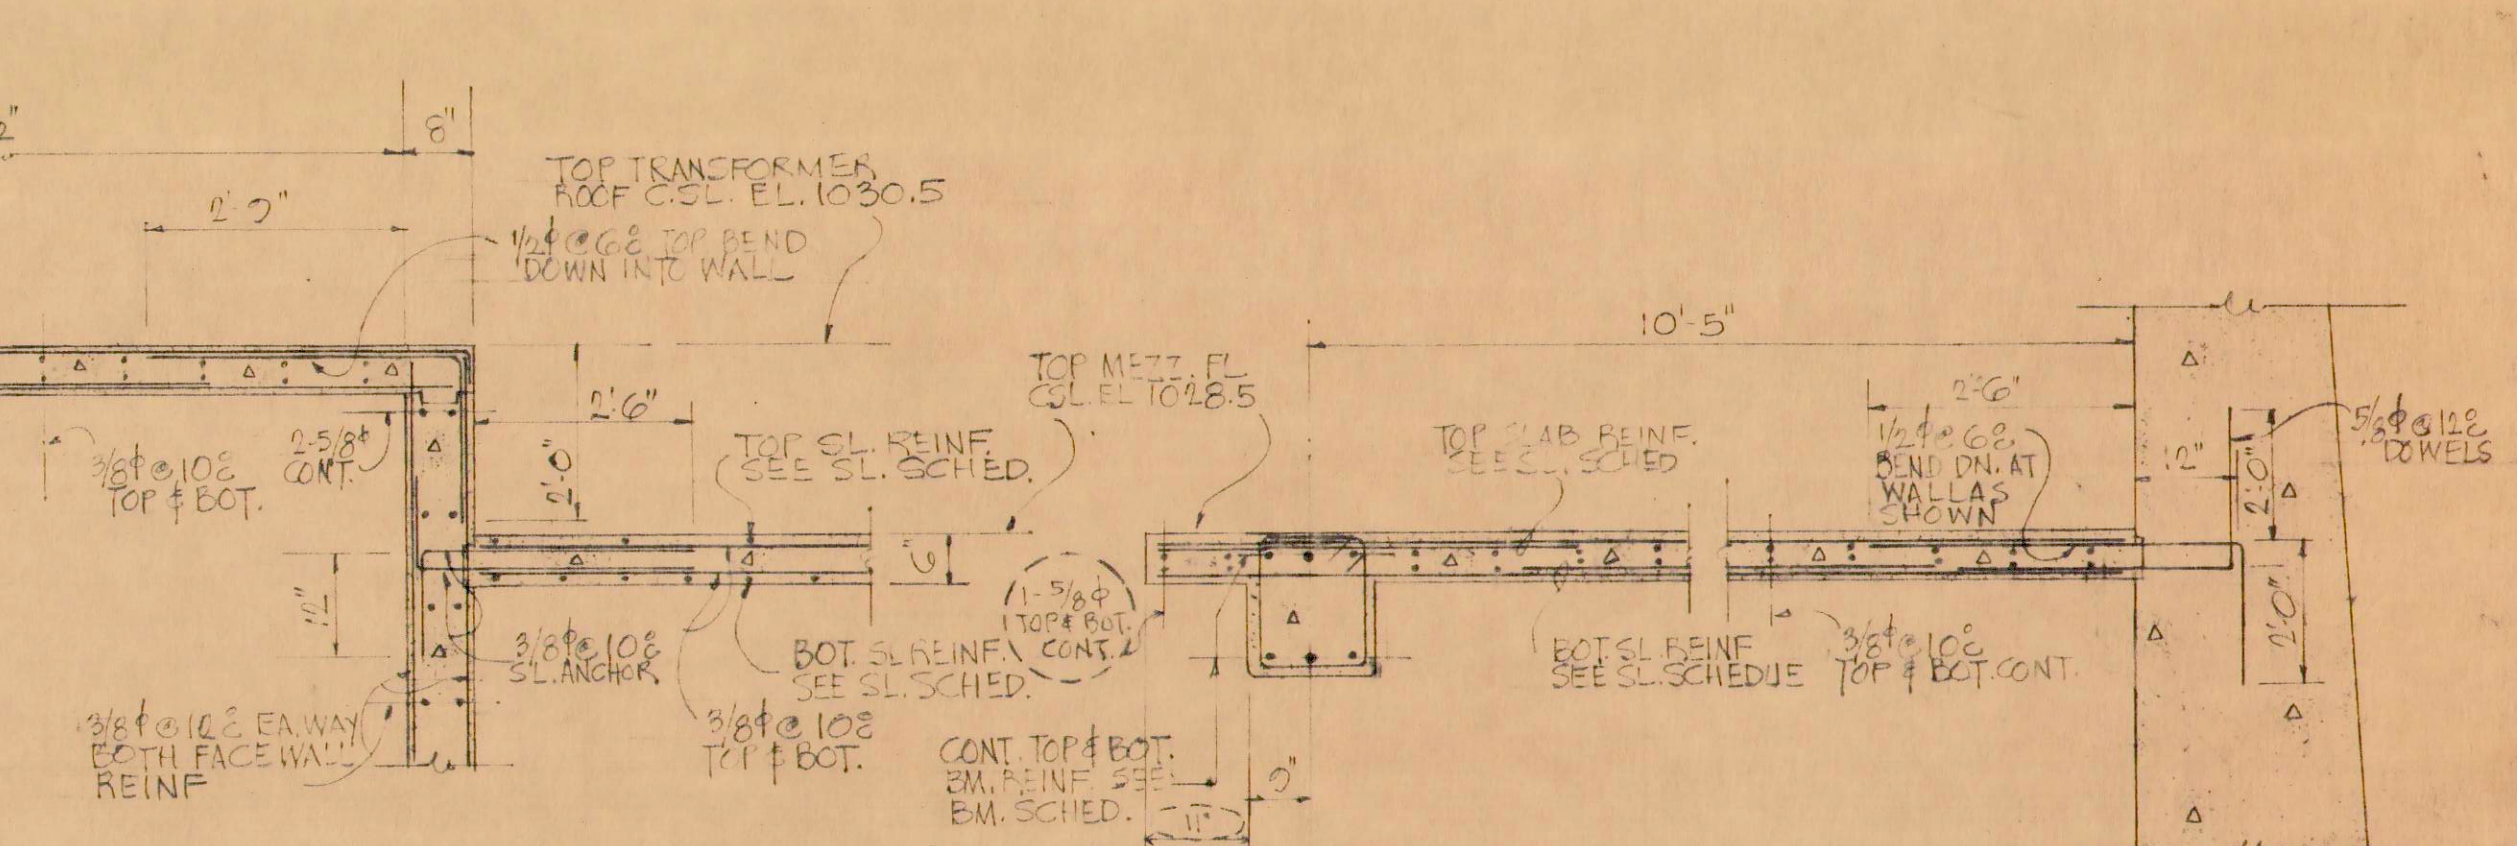


SECTION "30H-30H"
SCALE: 1/2"=1'-0"

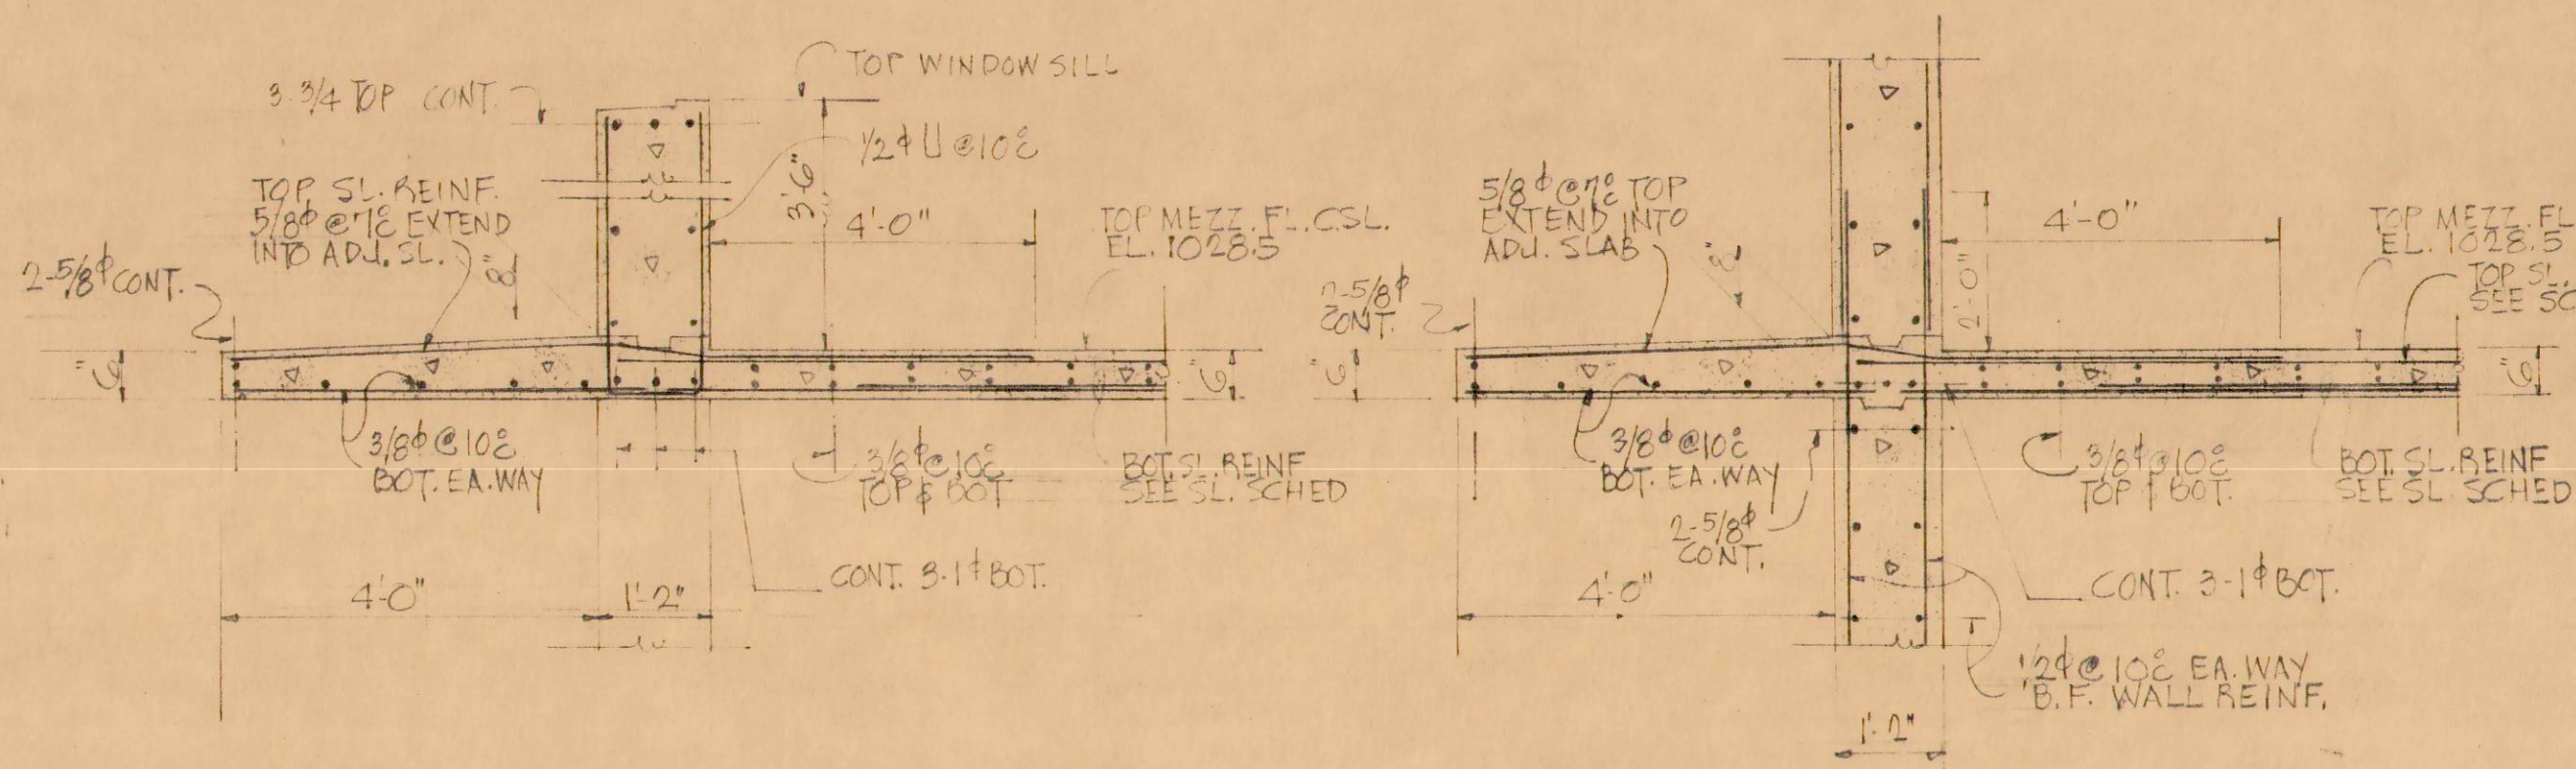


SECTION "30I-30I"
SCALE: 1/2"=1'-0"

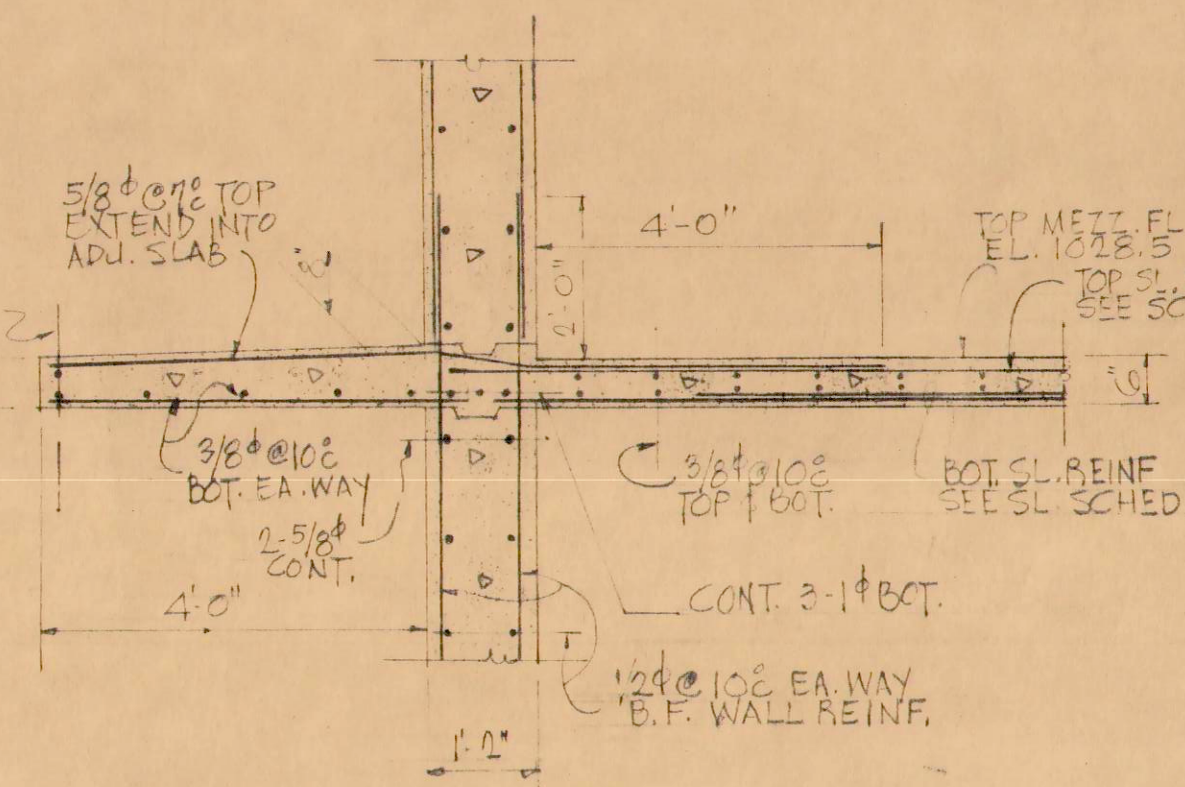

SECTION "30K-30K"
SCALE: 1/2"=1'-0"

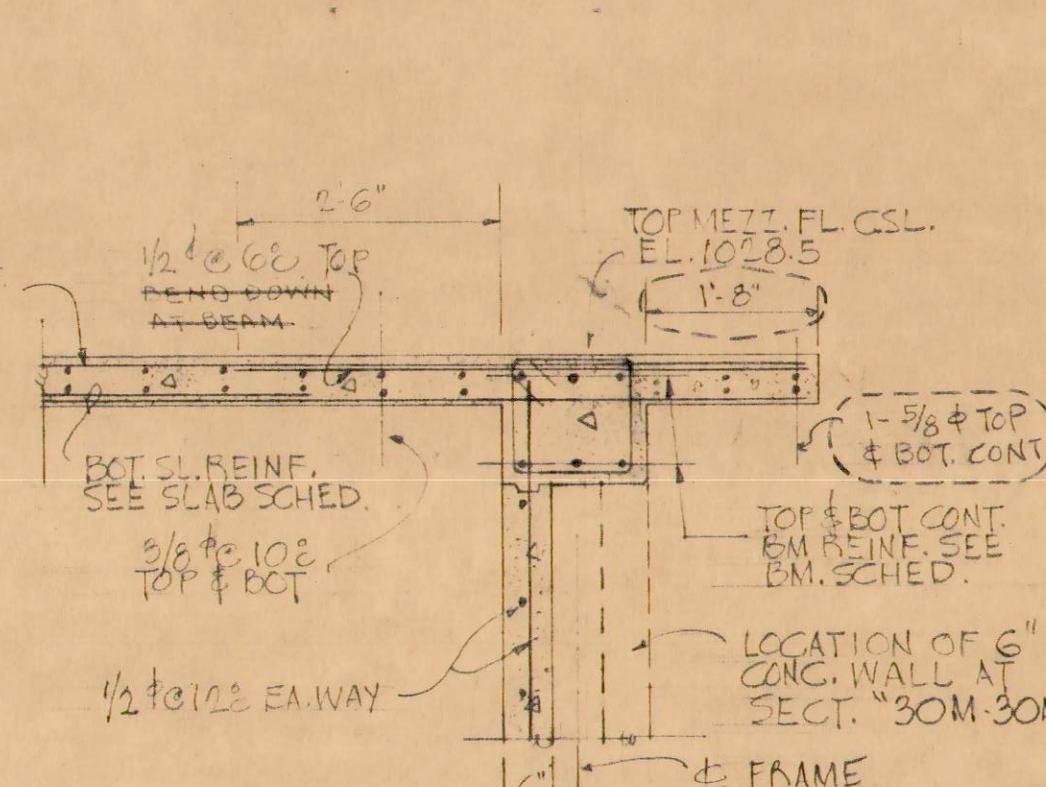

SECTION "30L-30L"
SCALE: 1/2"=1'-0"
(SECTION "30M-30M" SIMILAR EXCEPT AS NOTED)

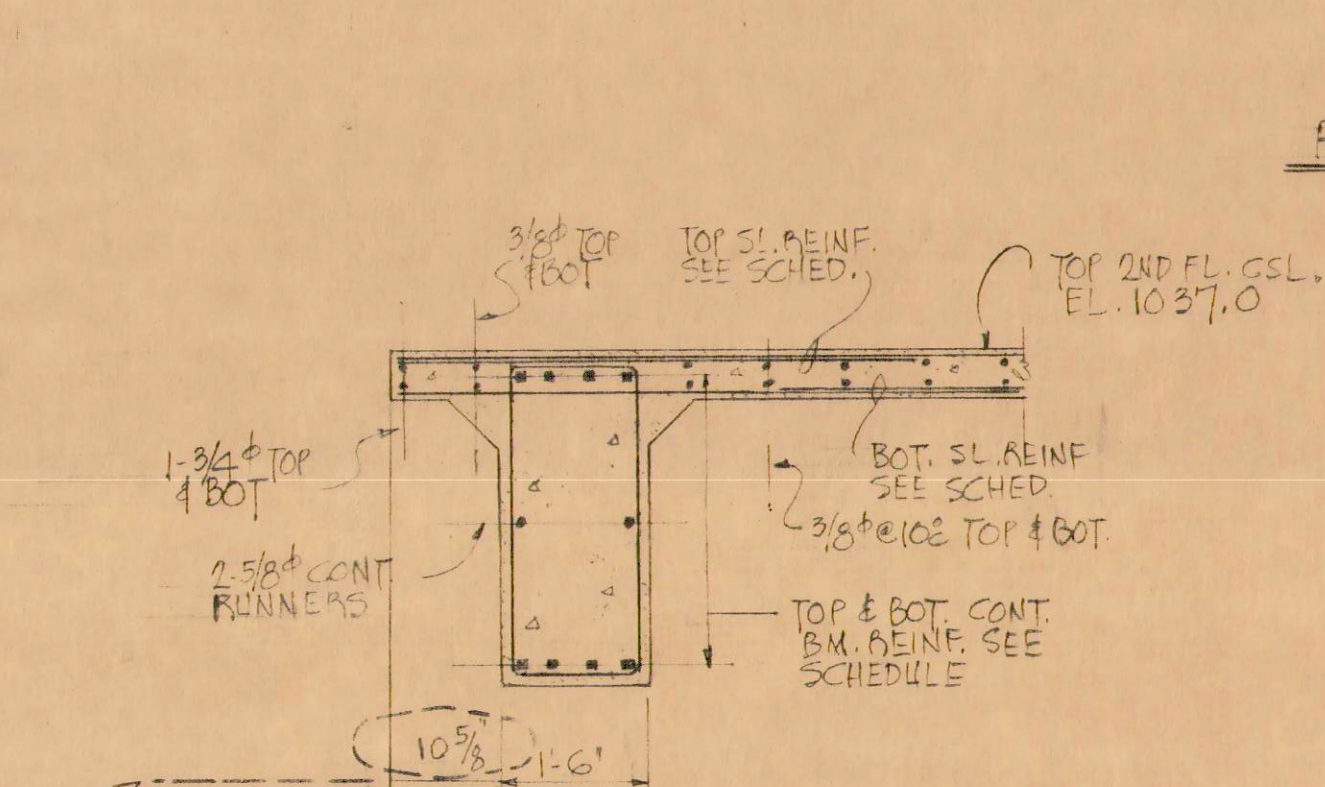

SECTION "30P-30P"
SCALE: 1/2"=1'-0"
(SECTION 30Q-30Q SIMILAR EXCEPT AS NOTED)

NOTES

REFERENCE:

FOR LOCATION OF CORRESPONDING SECTIONS "30A-30A" THRU "30E-30E" INCL.; "30M-30M" SEE DRWG. NO. VB-29.

FOR LOCATION OF CORRESPONDING SECTIONS "30F-30F" THRU "30K-30K" INCL.; SEE SHT. NO. VB-27.

REVISION	DATE	DESCRIPTION	MADE BY	CHK BY
1	4-16-56	RELOCATED OPENINGS AND SIZE	E.V.	JO
LAW & WILSON ARCHITECTS & ENGINEERS DEPARTMENT OF PUBLIC WORKS CITY AND COUNTY OF HONOLULU BUREAU OF PLANS KALIHI TUNNEL VENTILATION BLDG. - STRUCTURAL MEZZANINE & 2ND FLOOR DETAILS				
ENGINEER: L.A.W./D.L.		DATE: JULY 18, 1956		
DRAFTSMAN: F.C.		CHECKED BY: D.L. [Signature]		
SCALE: 1/2"=1'-0"		TRACER: [Signature]		
APPROVED: [Signature]		APPROVED: [Signature]		
CHIEF ENGINEER		BUREAU ENGINEER		

W.S.	PROFILE	C.B.
CR. SEC.	F.B.	S.B.
W.F. BY:	W.F. BY:	S.B. BY:

SECTION C JOB NO. 26-53 DWG. VB-30