
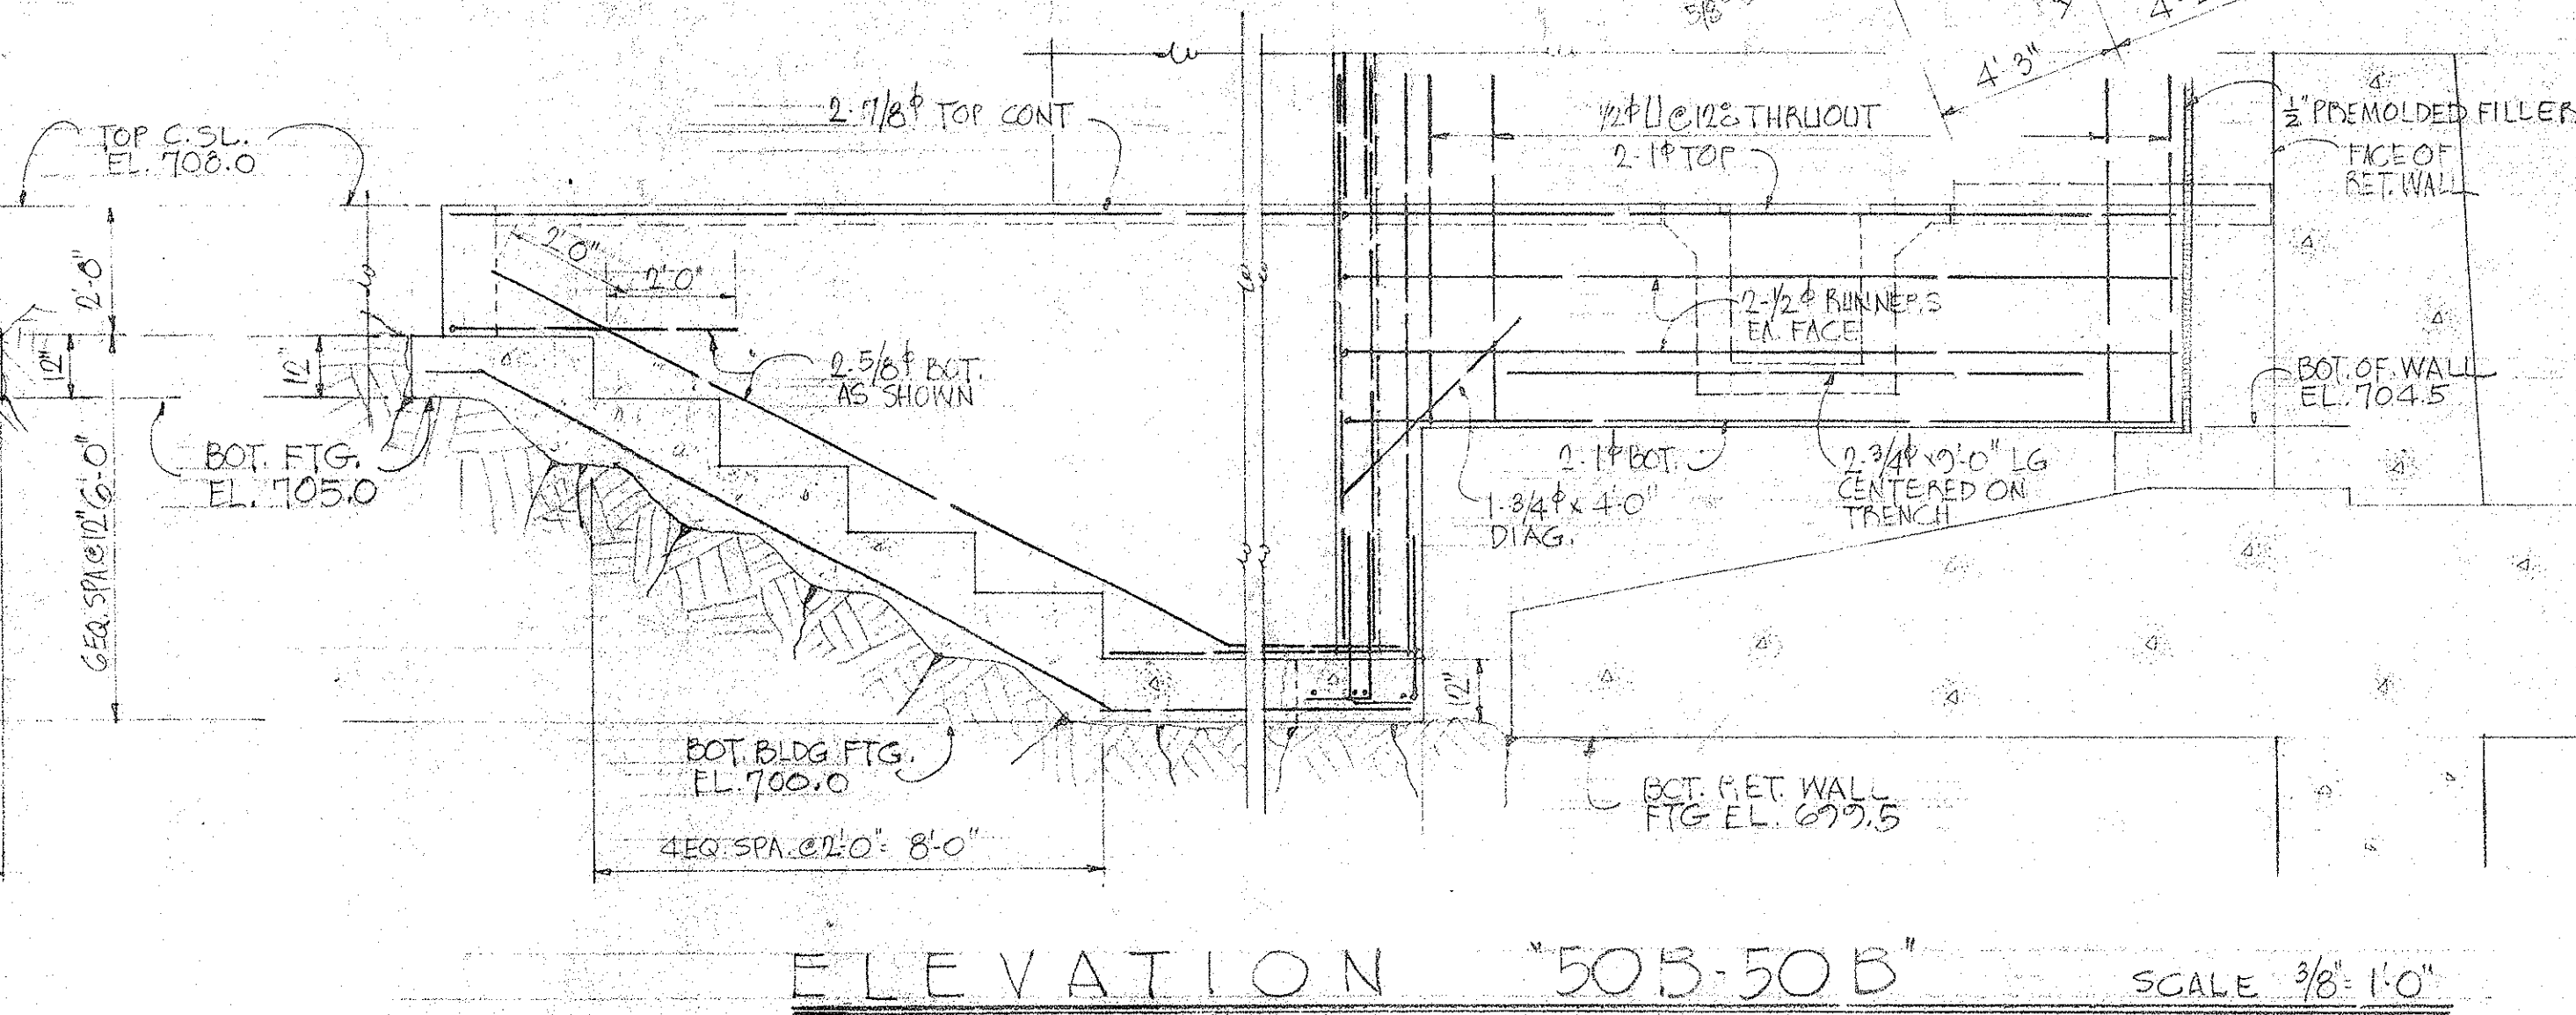
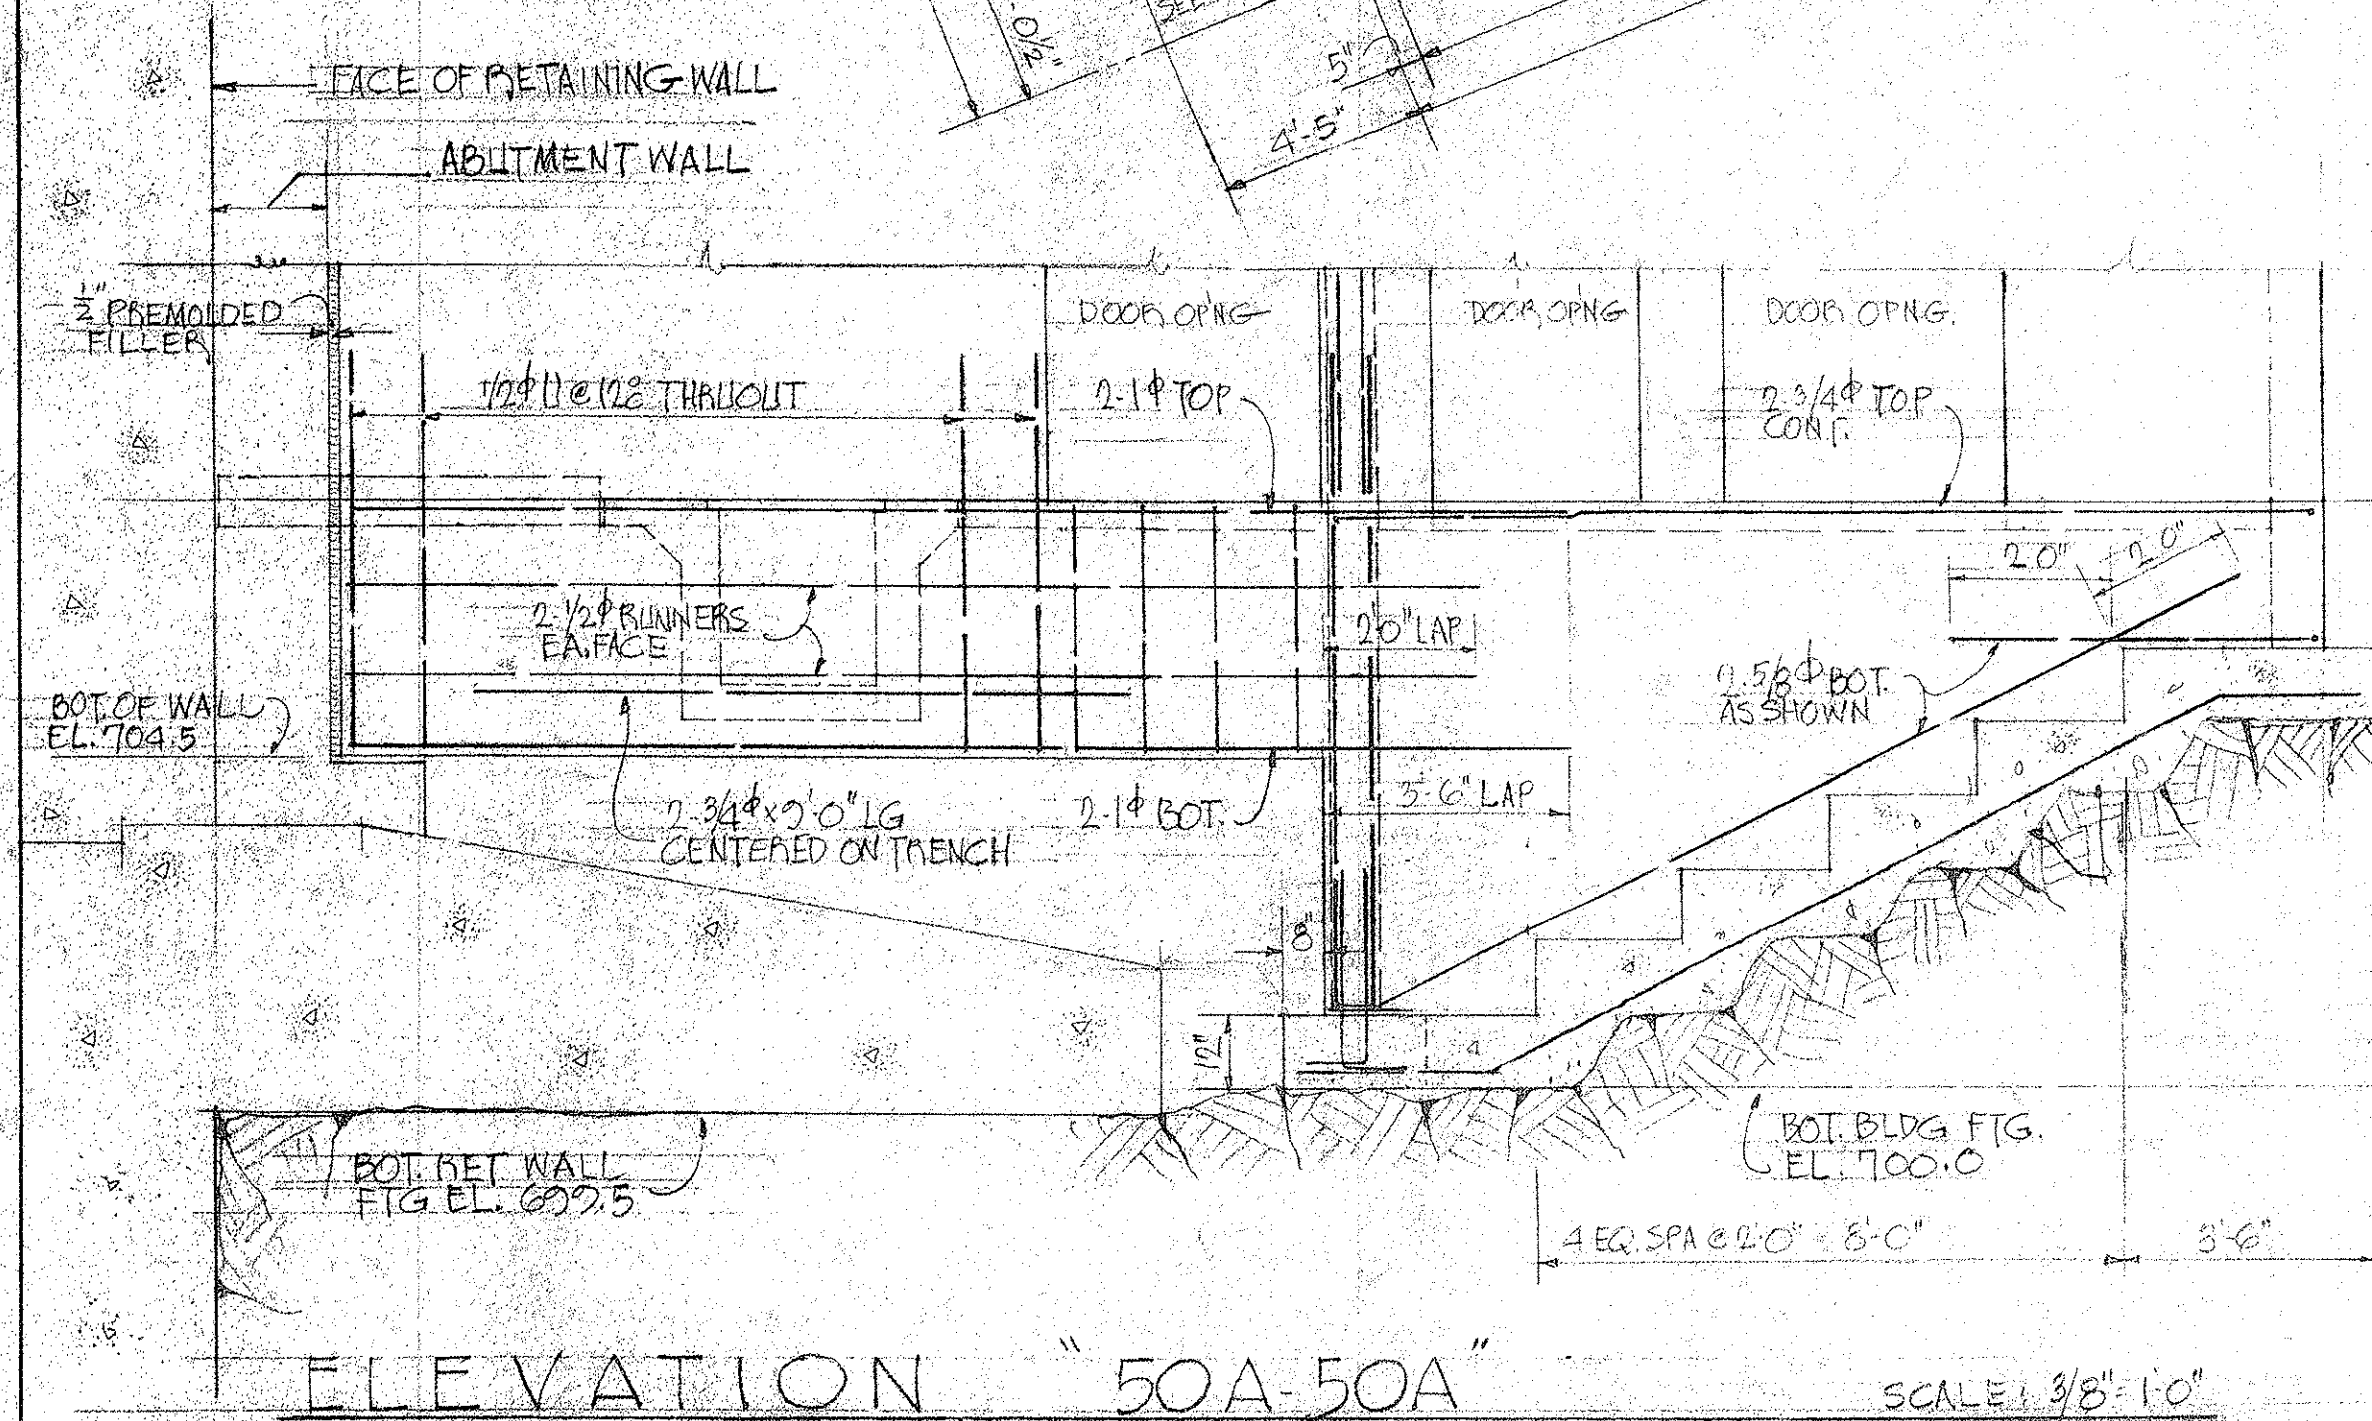
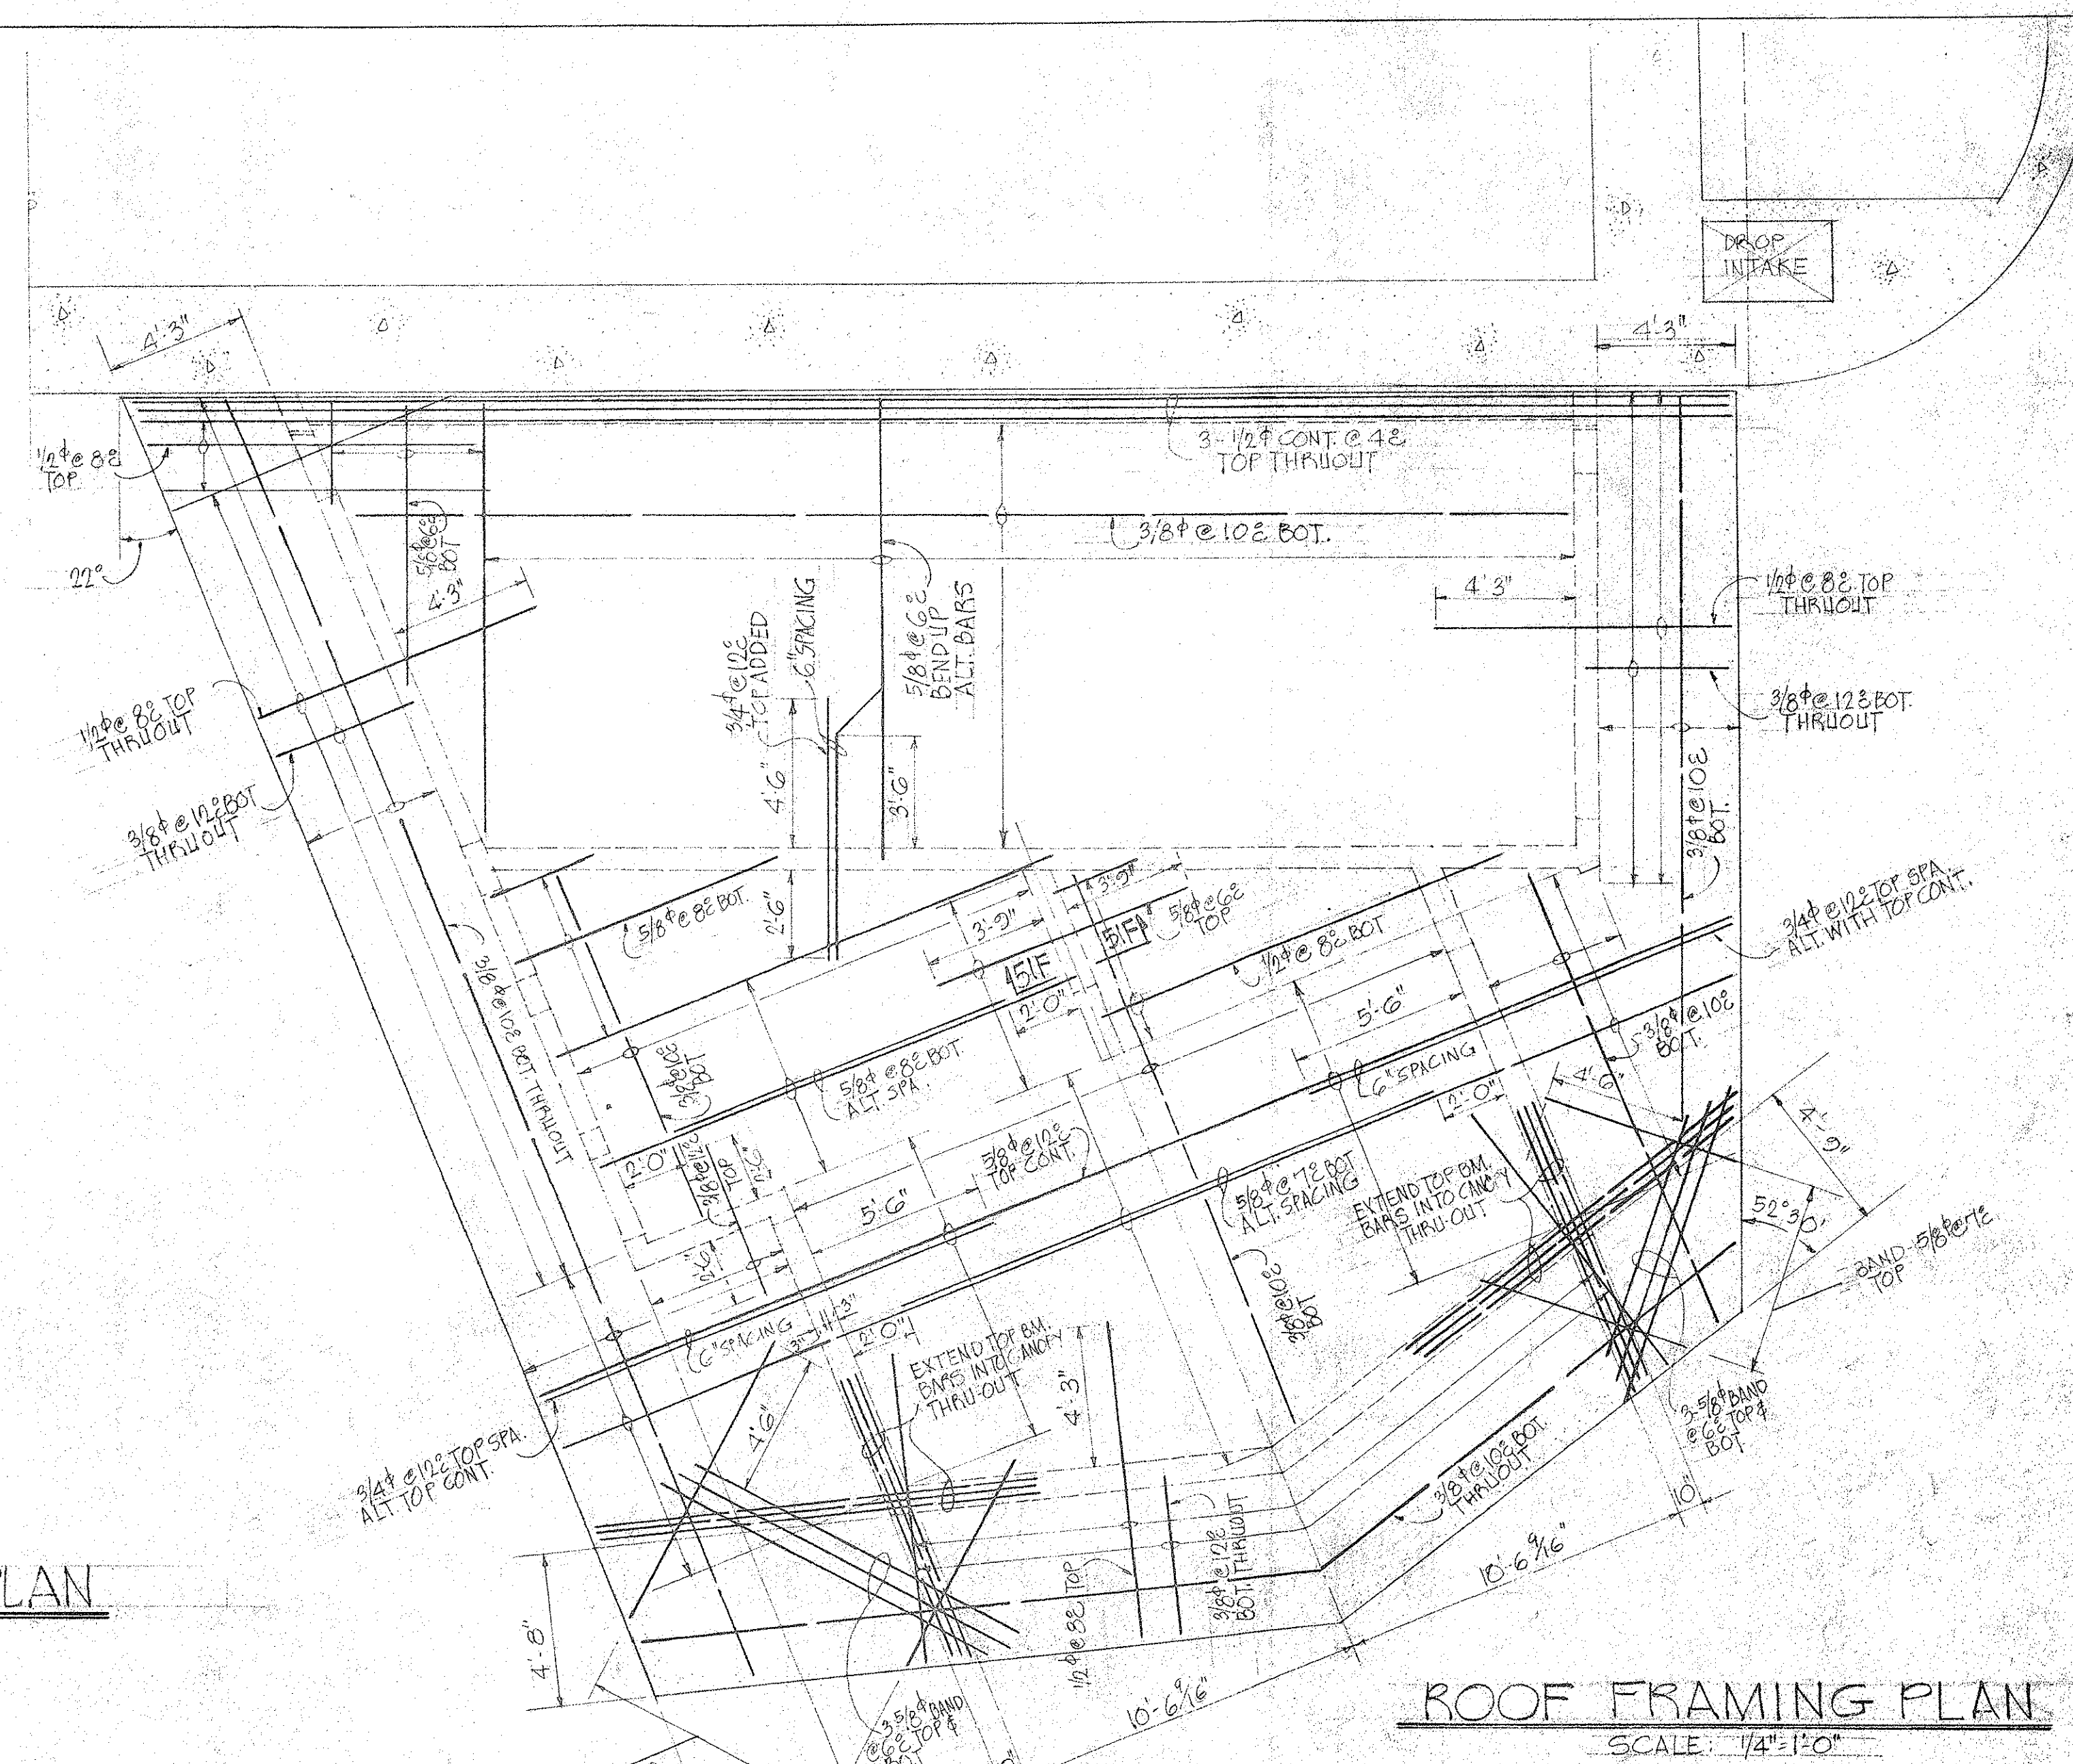


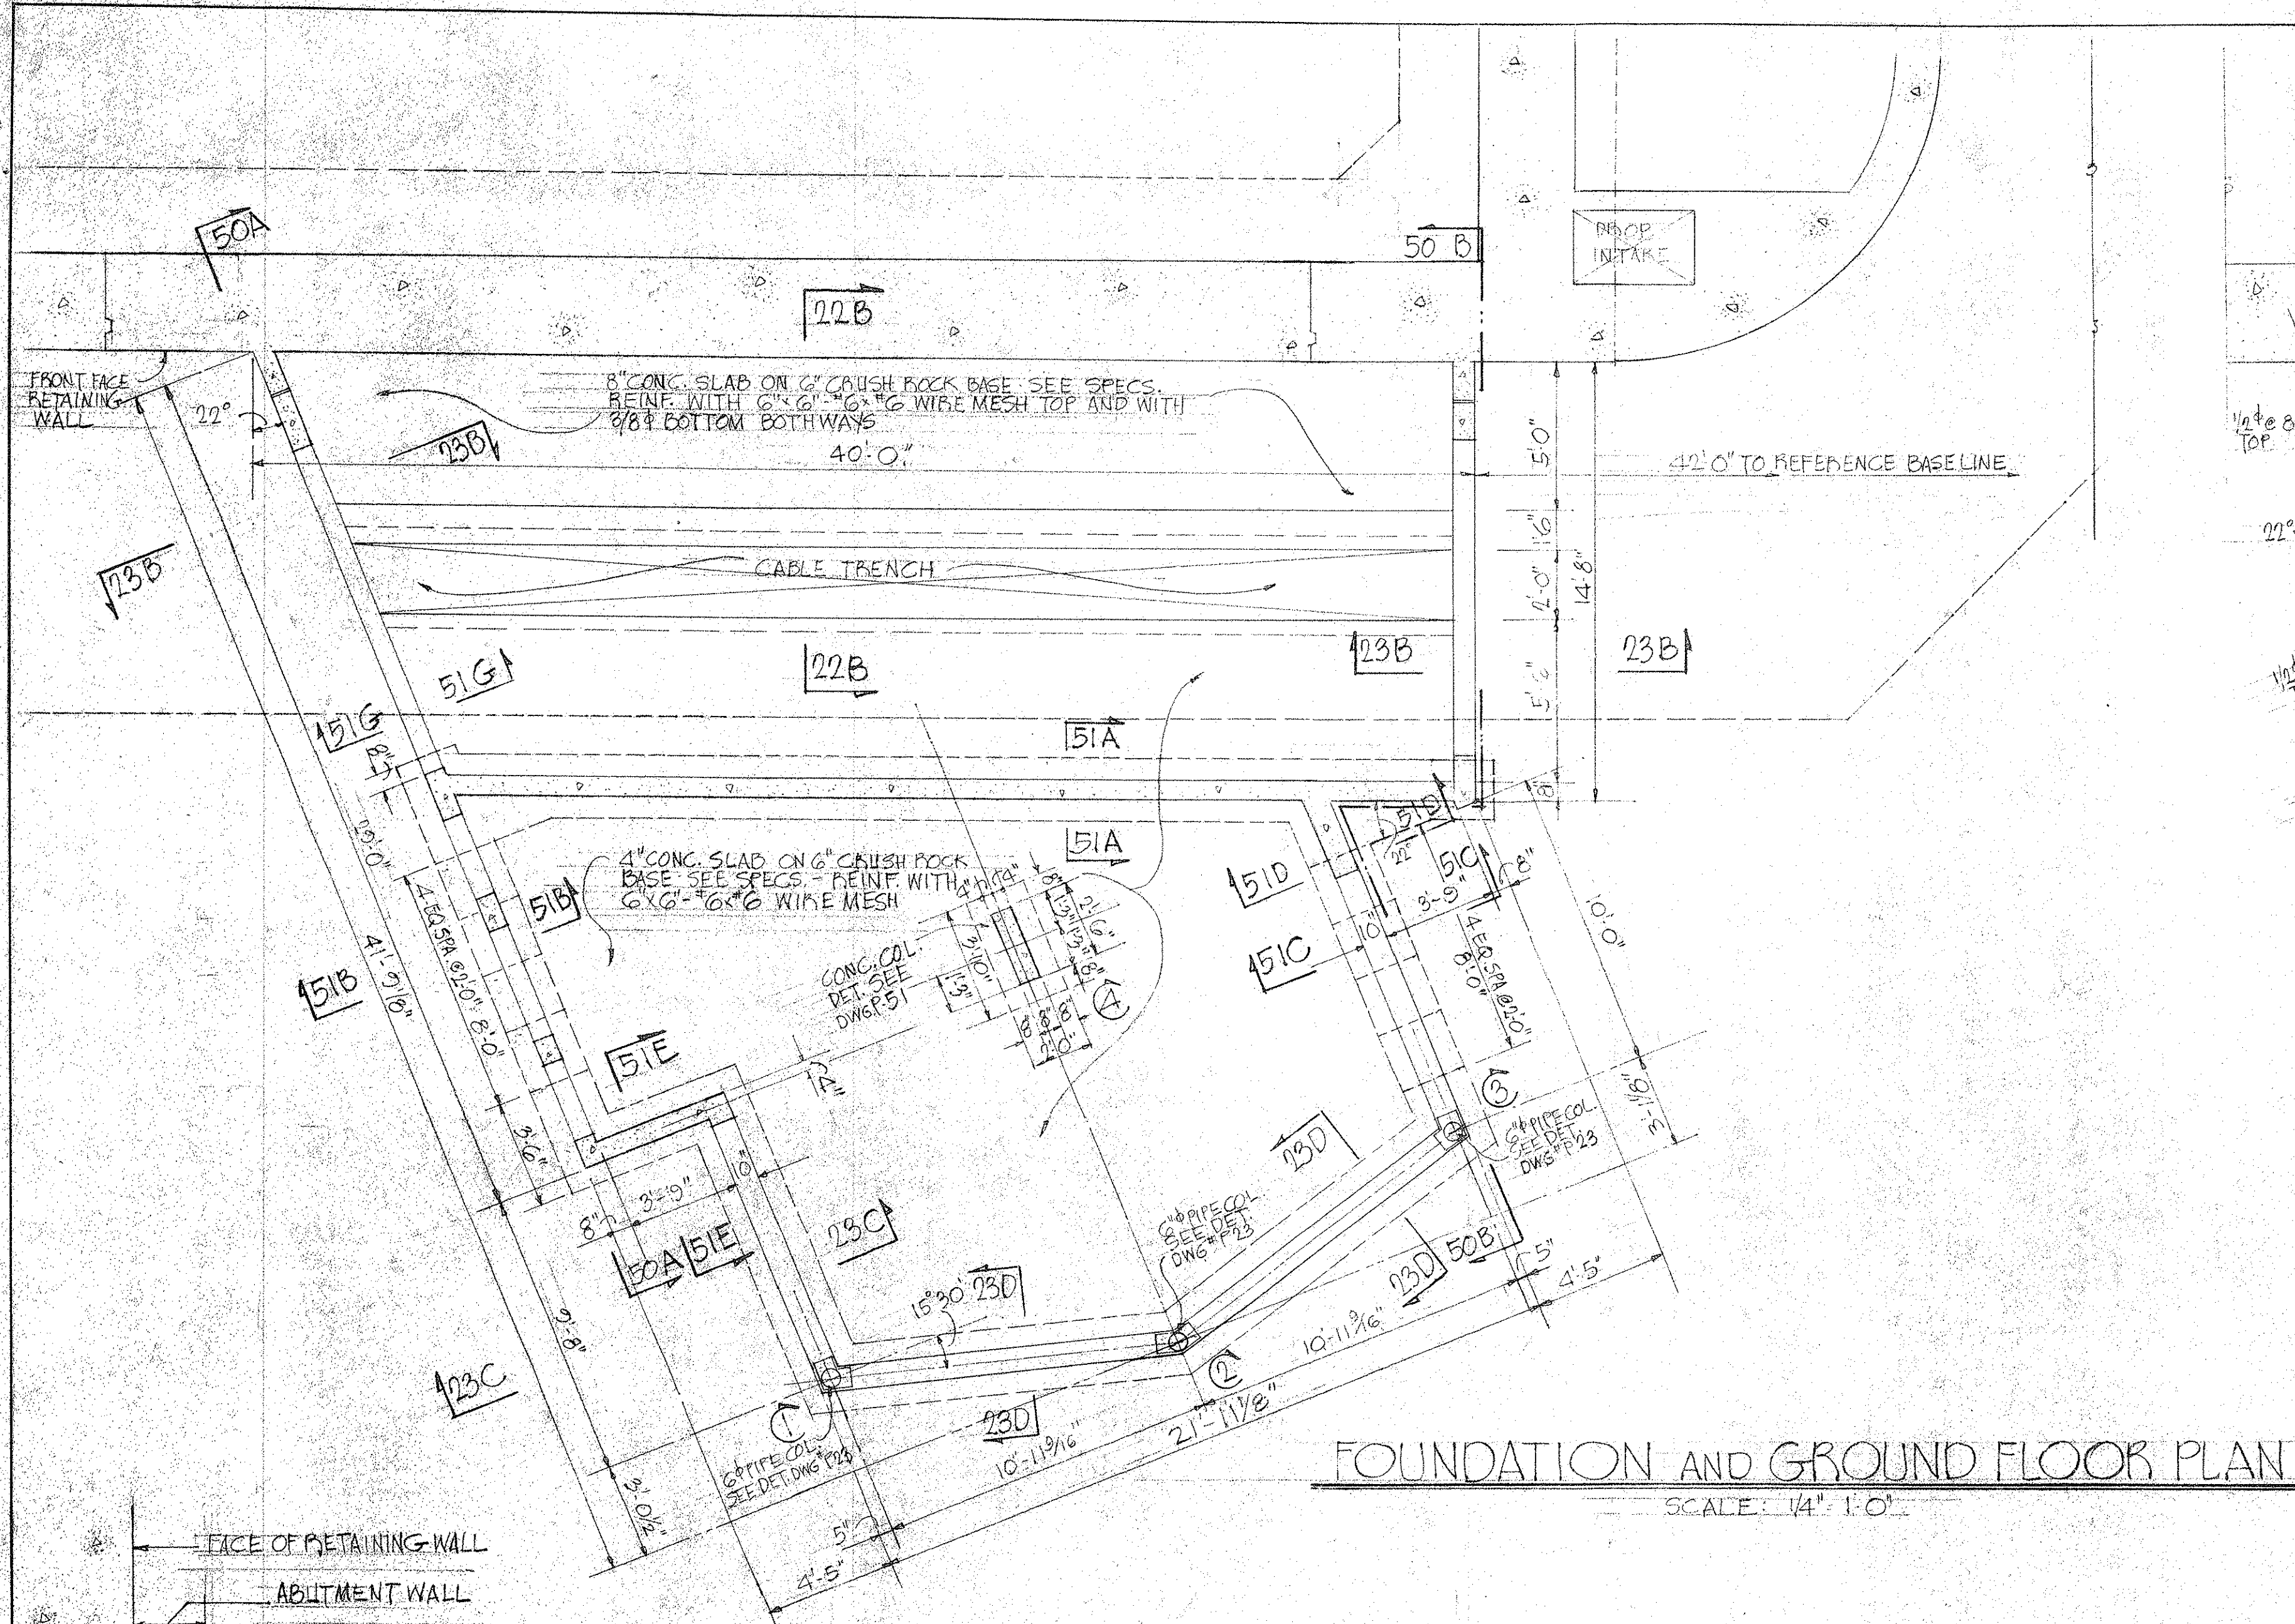

REFERENCE NOTES:

FOR TYPICAL DETAILS OF WALL CORNER OR GRADE BEAM CORNER
REINF. AND DETAILS TO SECTIONS "22B-22B"
SEE DWG. "P22".

FOR CORRESPONDING TYPICAL DETAILS OF CONC BEAMS, SPANDREL BEAMS, ADDED REINFORCEMENT AT OPENINGS, PIPE COLS AND DETAILS TO SECTIONS "23B-23B", 23C-23C & 23D-23D SEE DWG. "P 23".

FOR DETAILS OF SECTIONS 51A-51A", 51B-51B", 51C-51C",
51D-51D", 51E-51E", 51F-51F", & 51G-51G
SEE DWG P51

LAW & WILSON
ARCHITECTS & ENGINEERS
DEPARTMENT OF PUBLIC WORKS

CITY AND COUNTY OF HONOLULU
BUREAU OF PLANS
KALIHI TUNNEL
KANEHOE PORTAL-STRUCTURAL
OFFICE & VAULT
PLANS & DETAILS

ENGINEER L. W. / P. L. DATE JULY 15, 1953
DRAFTSMAN J. Y. L. CHECKED BY D. L. [Signature]
SCALE AS NOTED TRACER _____
APPROVED: [Signature] APPROVED: [Signature]
CHIEF ENGINEER BUREAU ENGINEER

APPROVED:
[Signature]
ENGINEER, KALINI TUNNEL

W. S.	PROFILE	C. B.
CR. SEC.	F. B.	S. B.
W. M. BY:	F. W. BY:	S. BY:

SECTION C JOB NO. 26-53 DWG. P-50

Sheet No. 132 of 252 Sheets

FILE	POCKET	FOLDER	NO.
7	6	1	50