
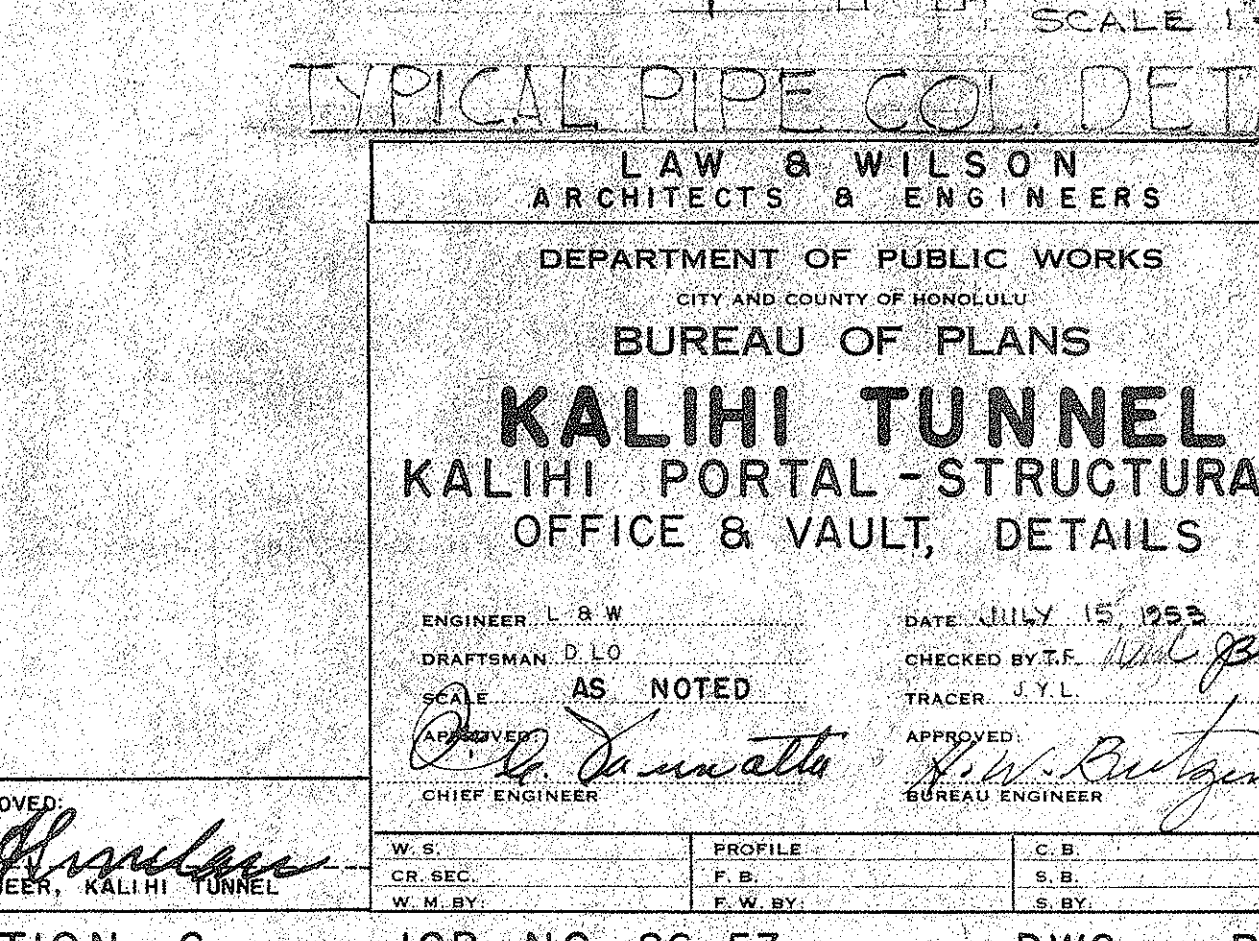
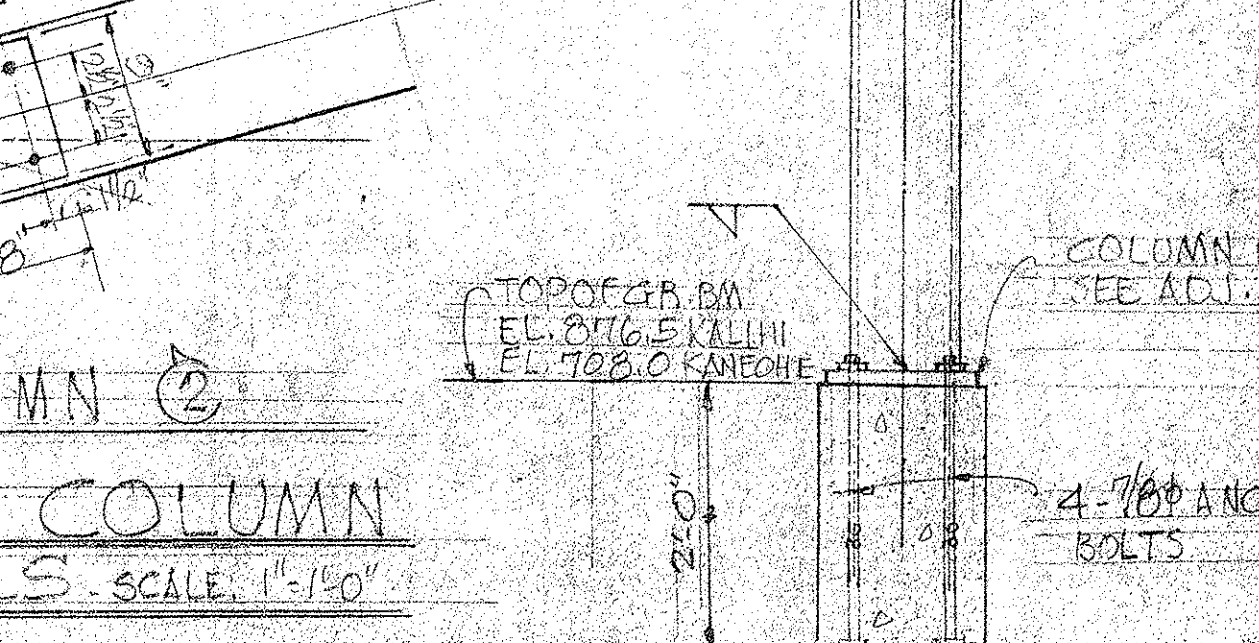
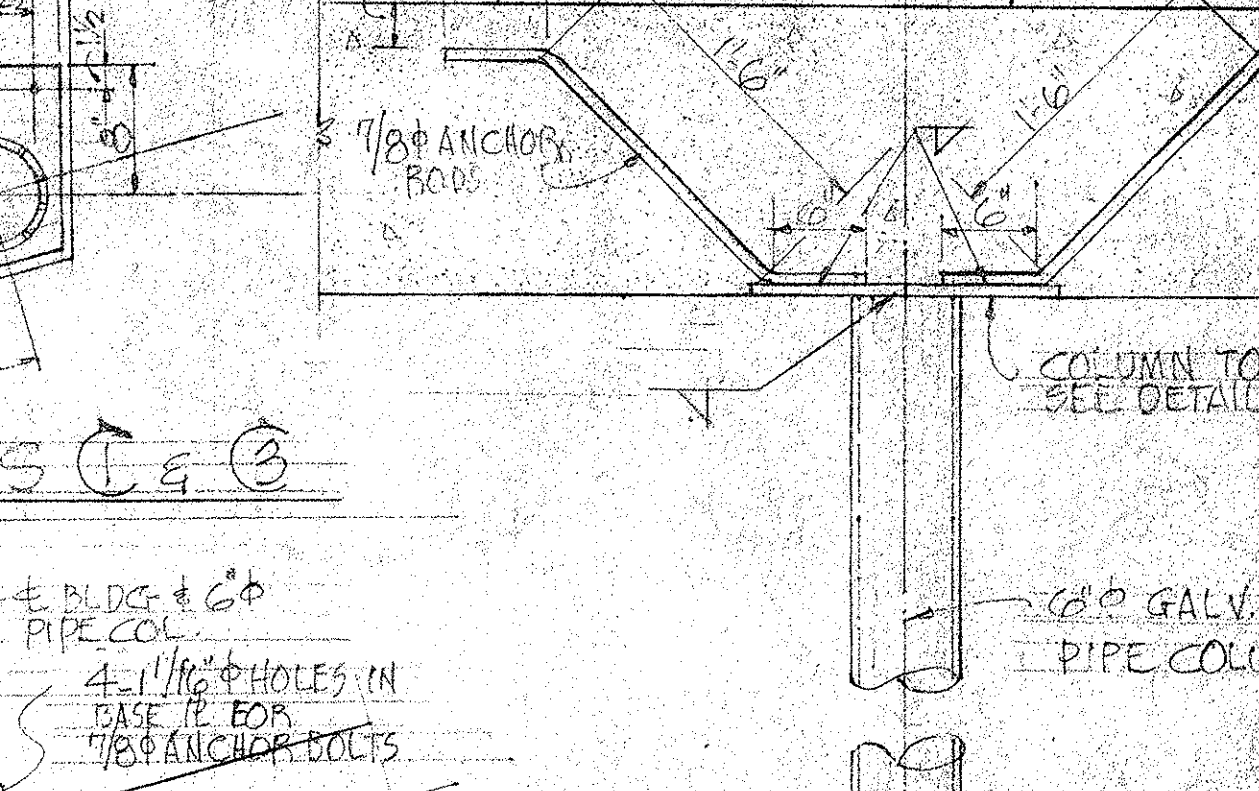
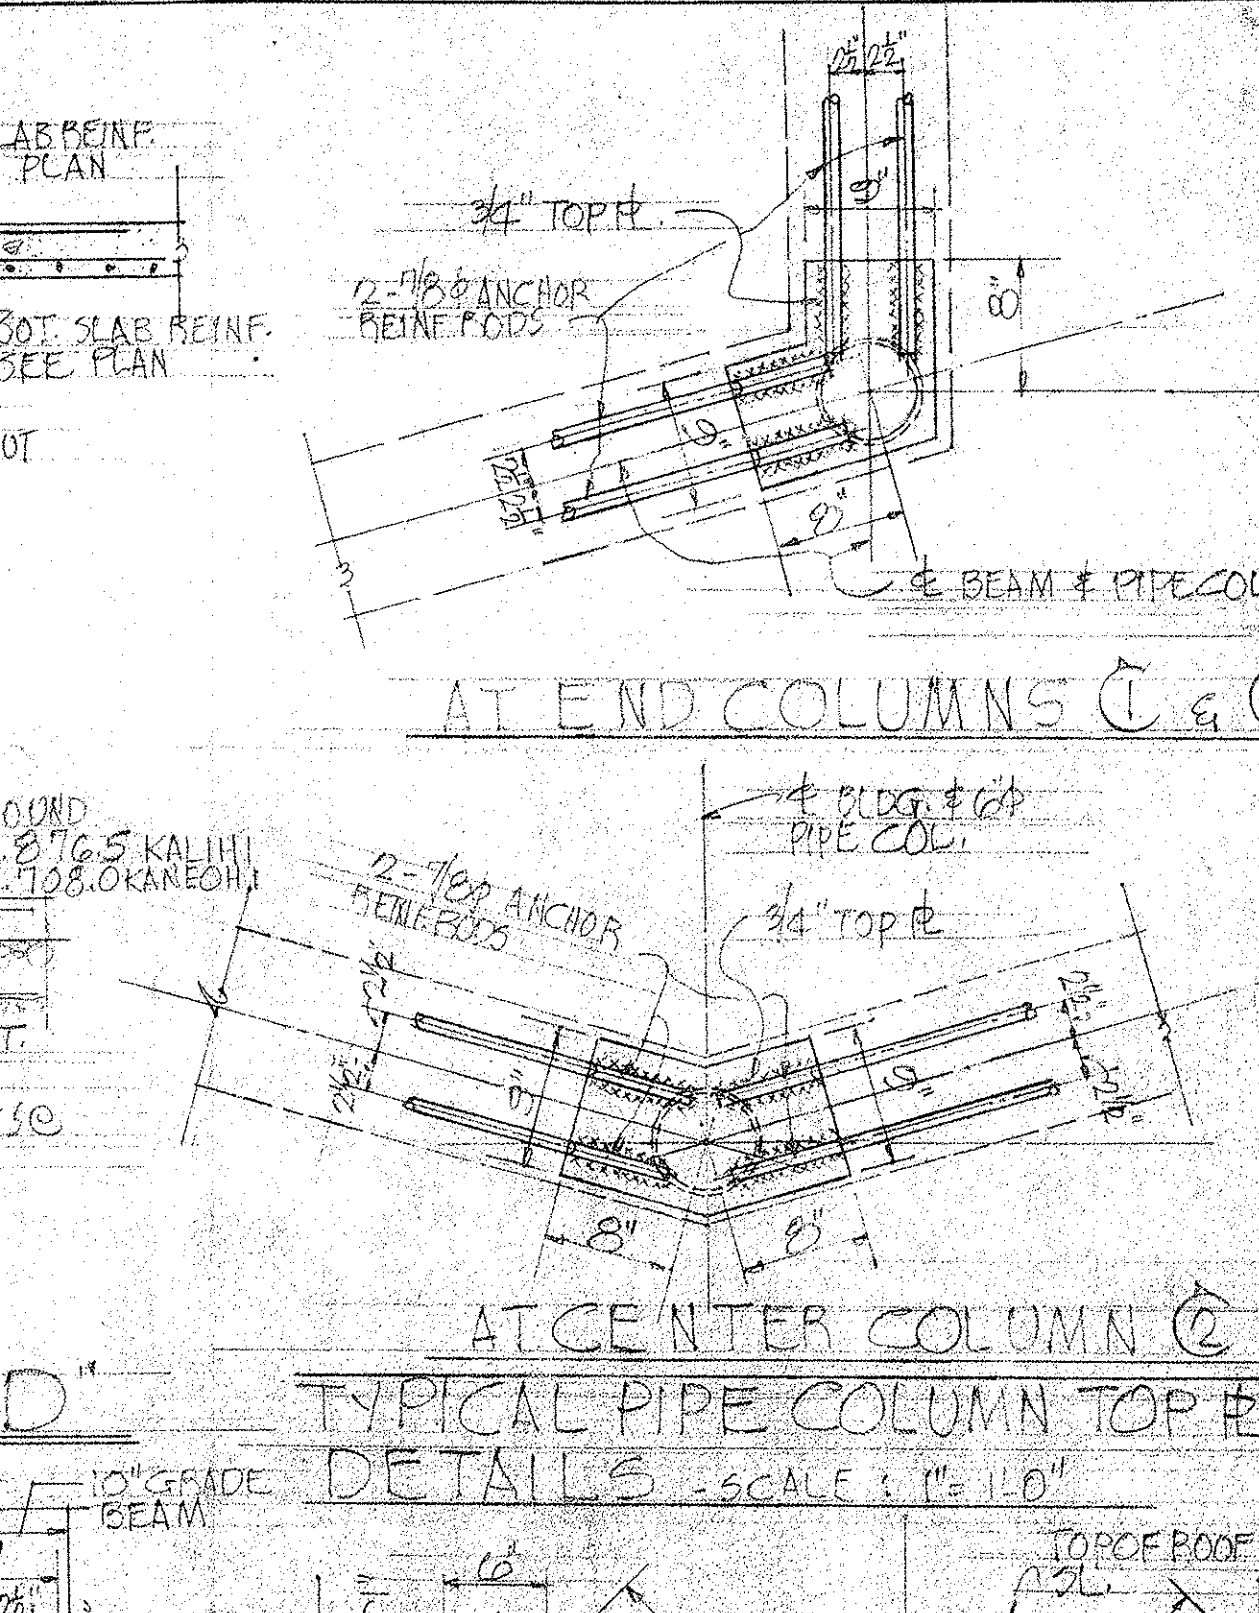
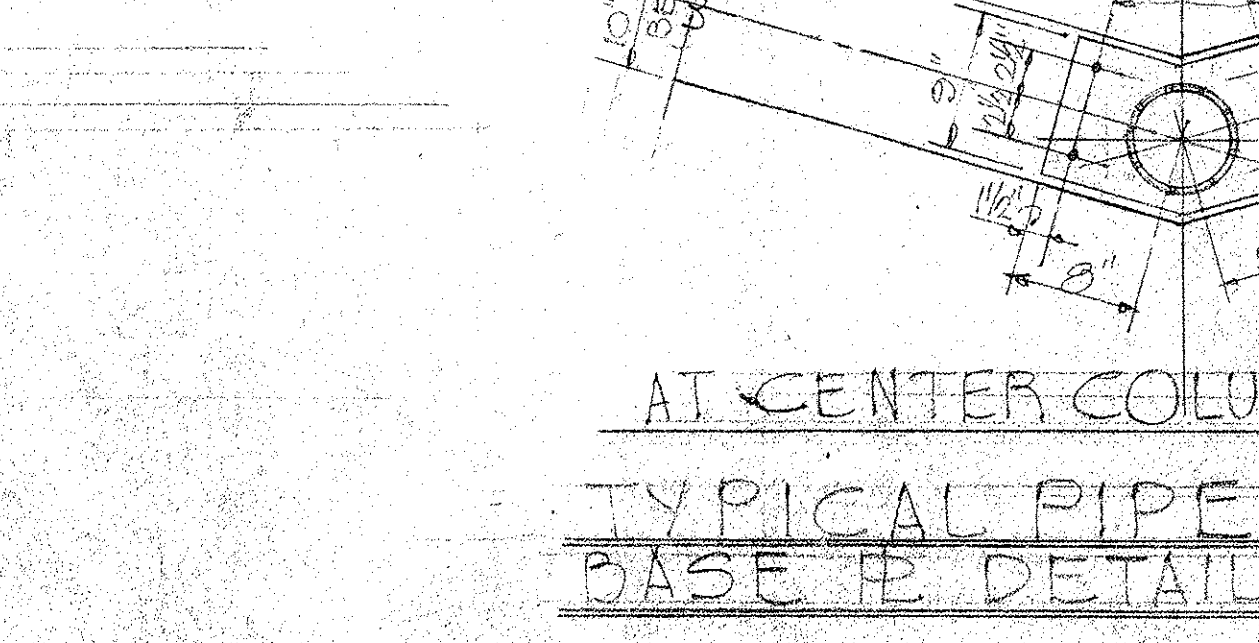
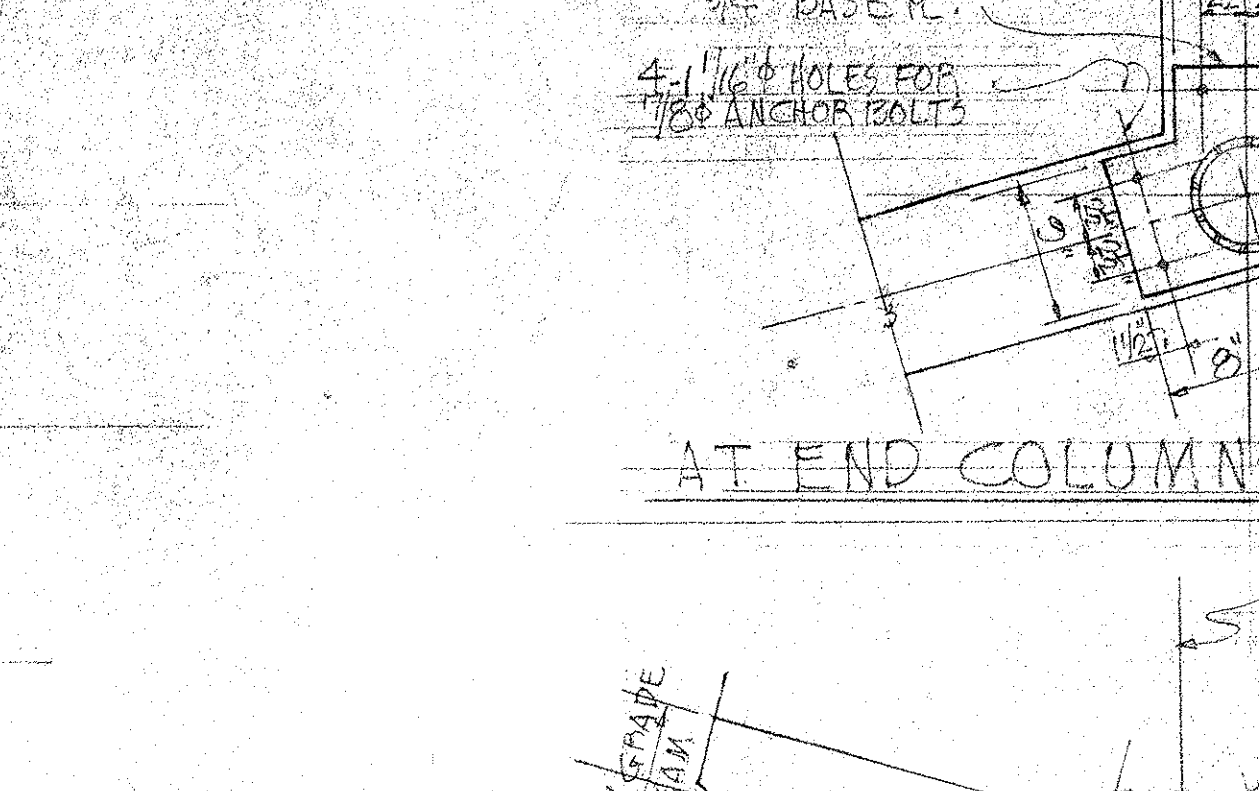
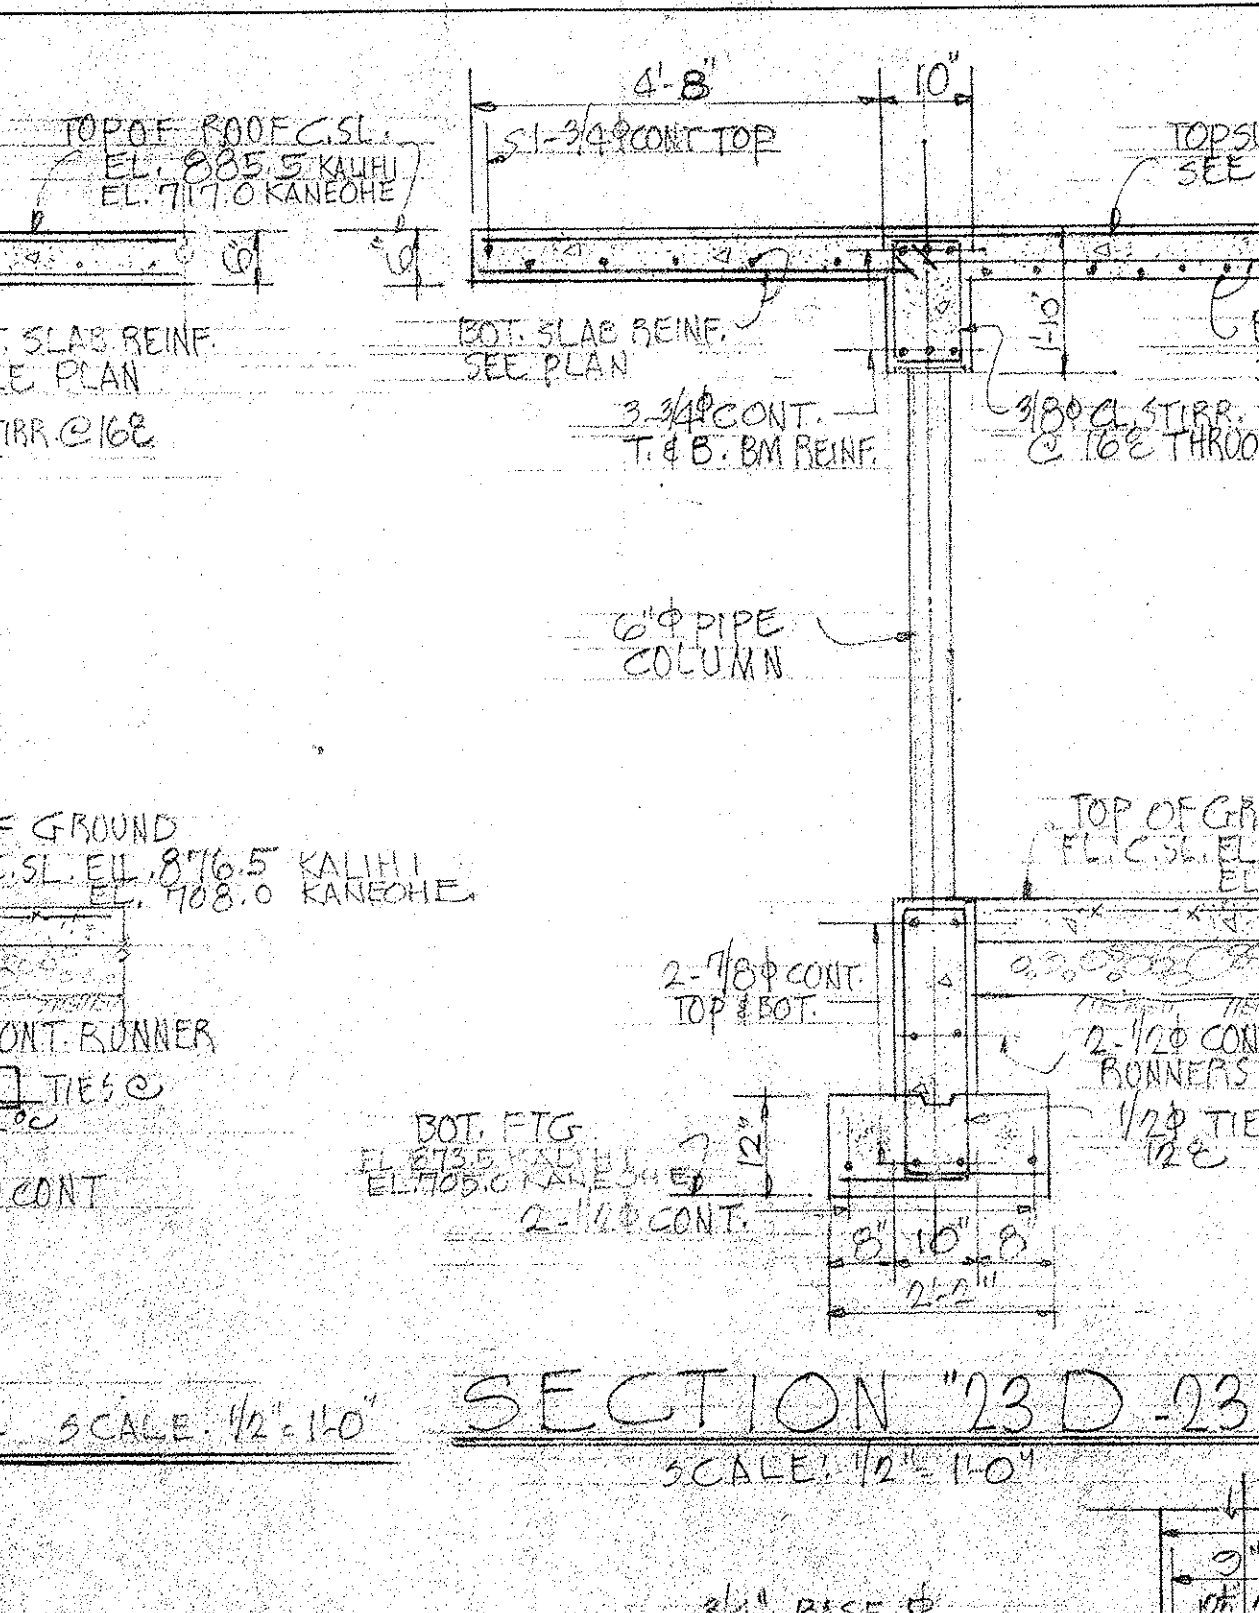
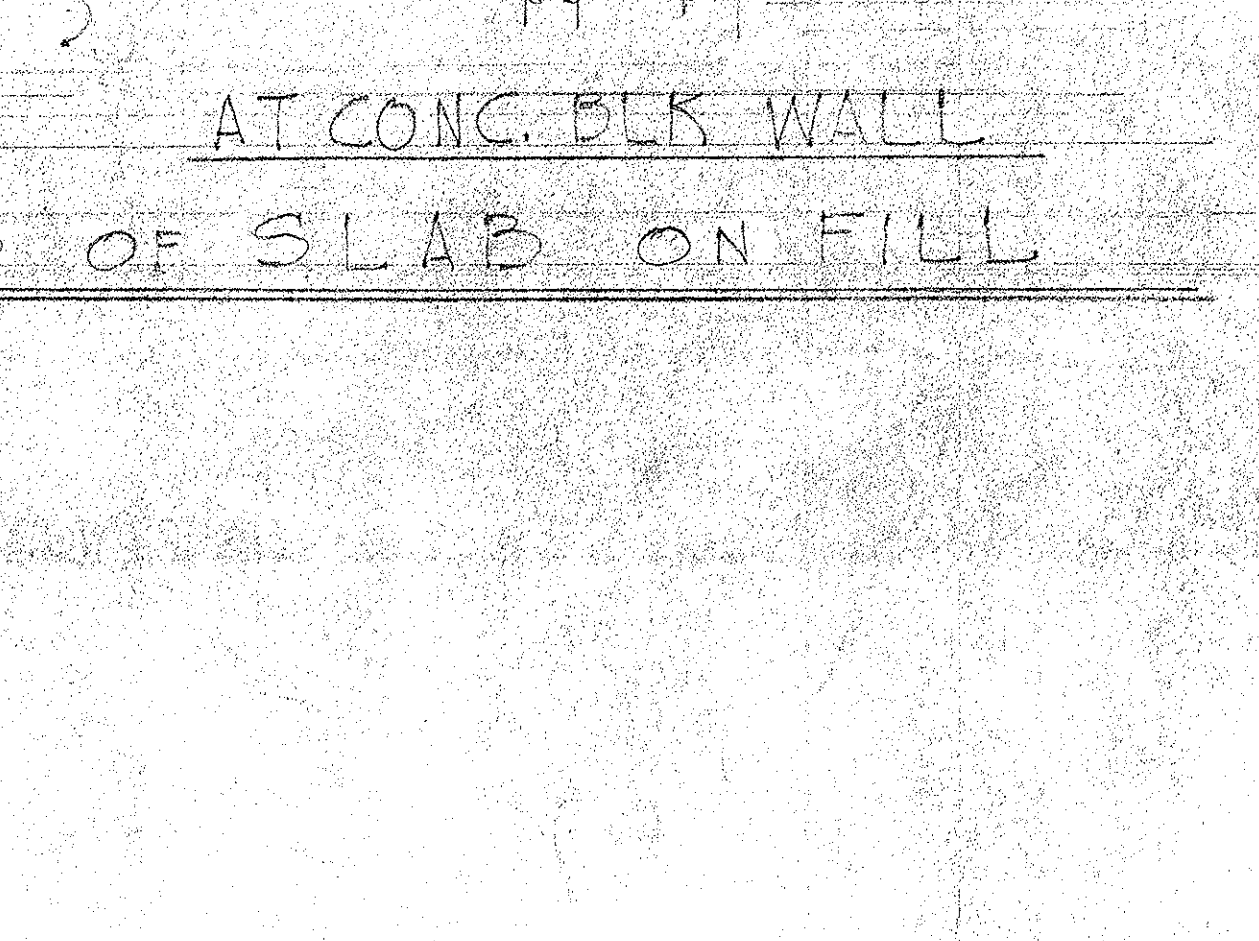
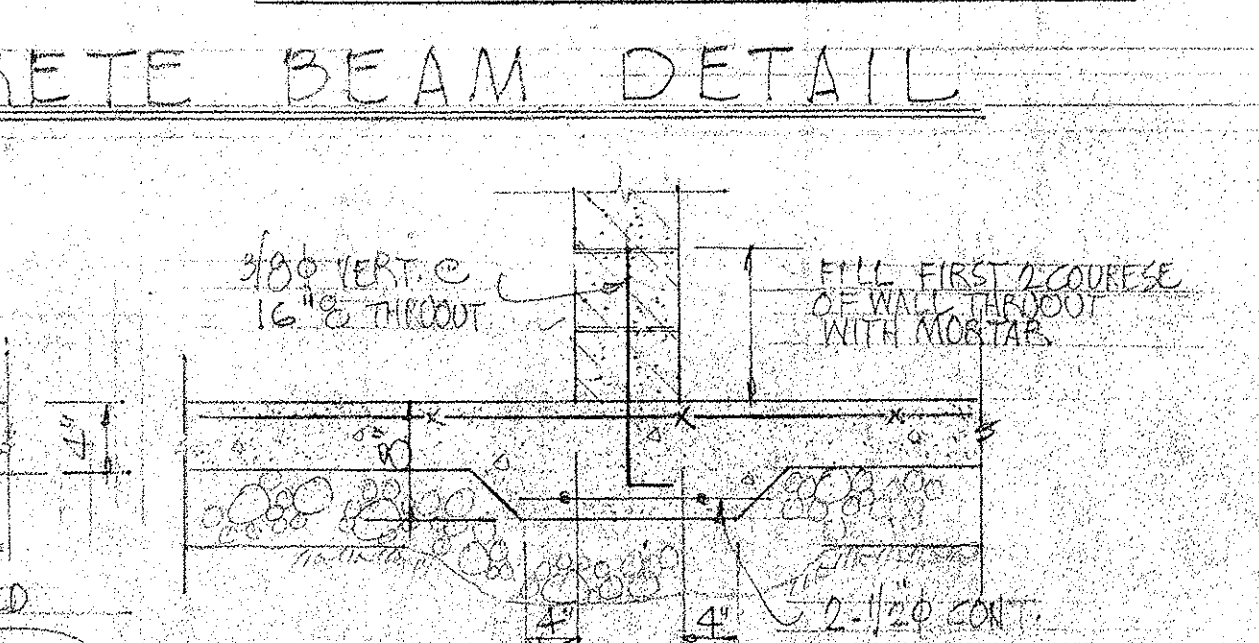
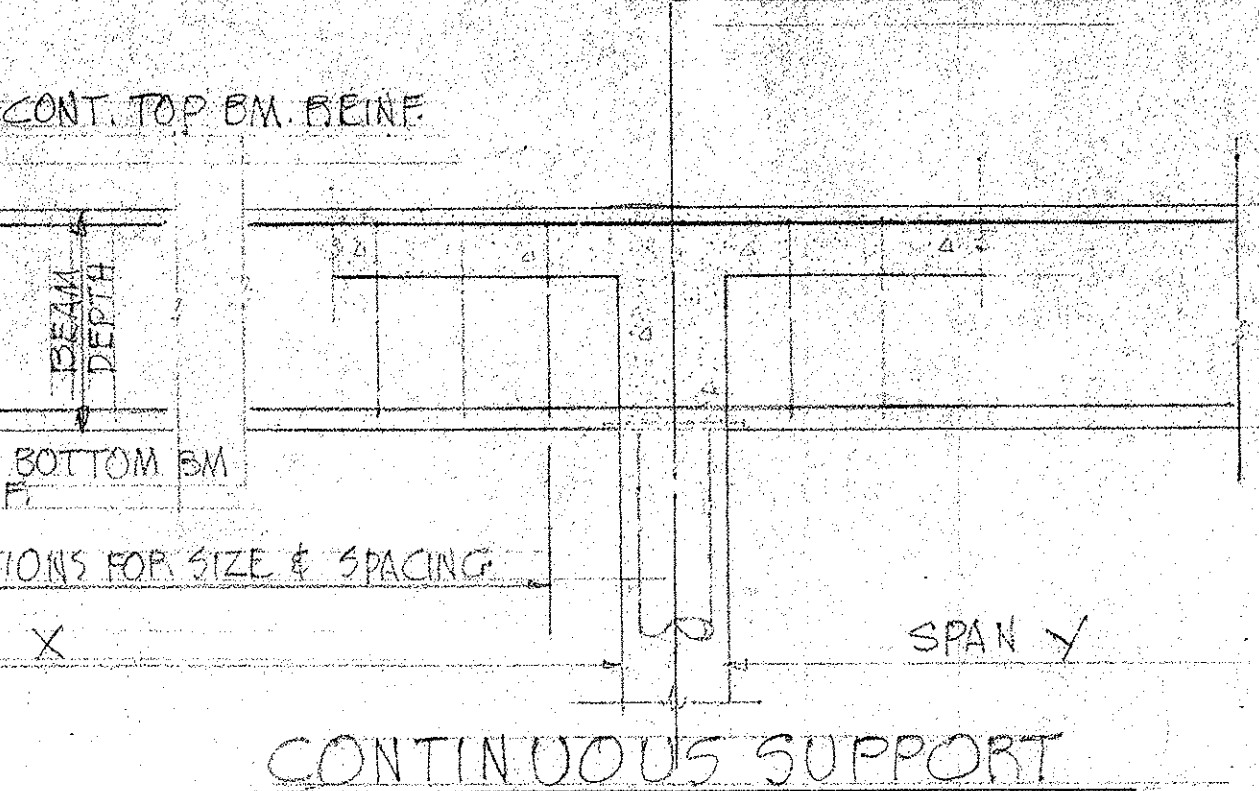
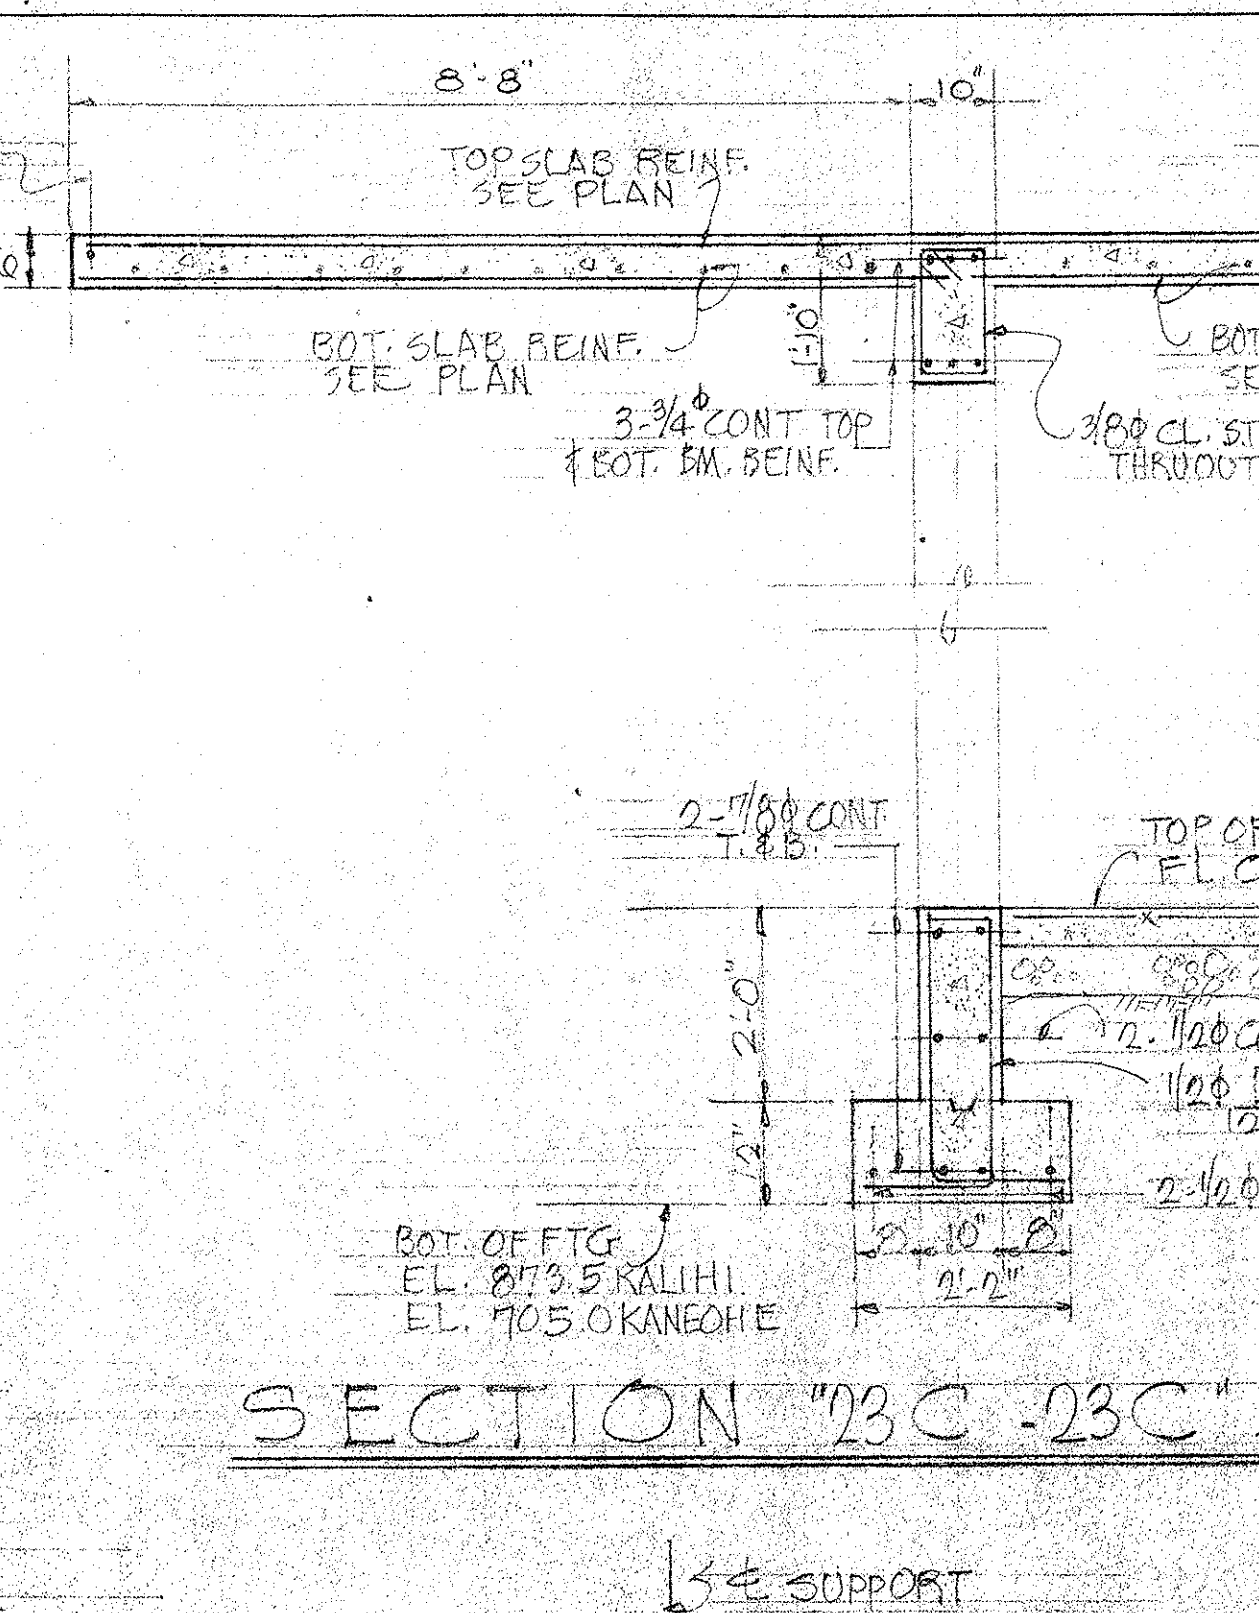
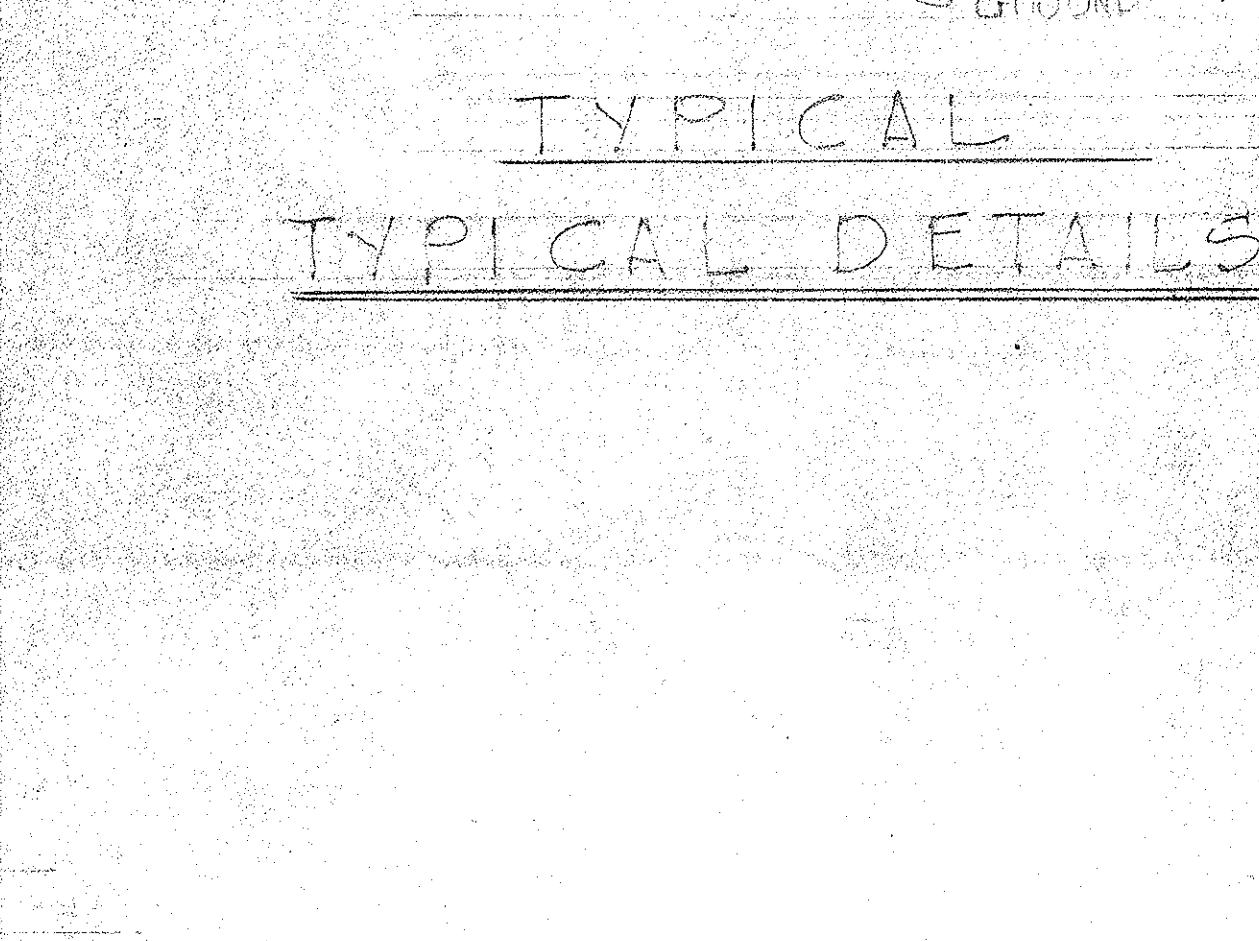
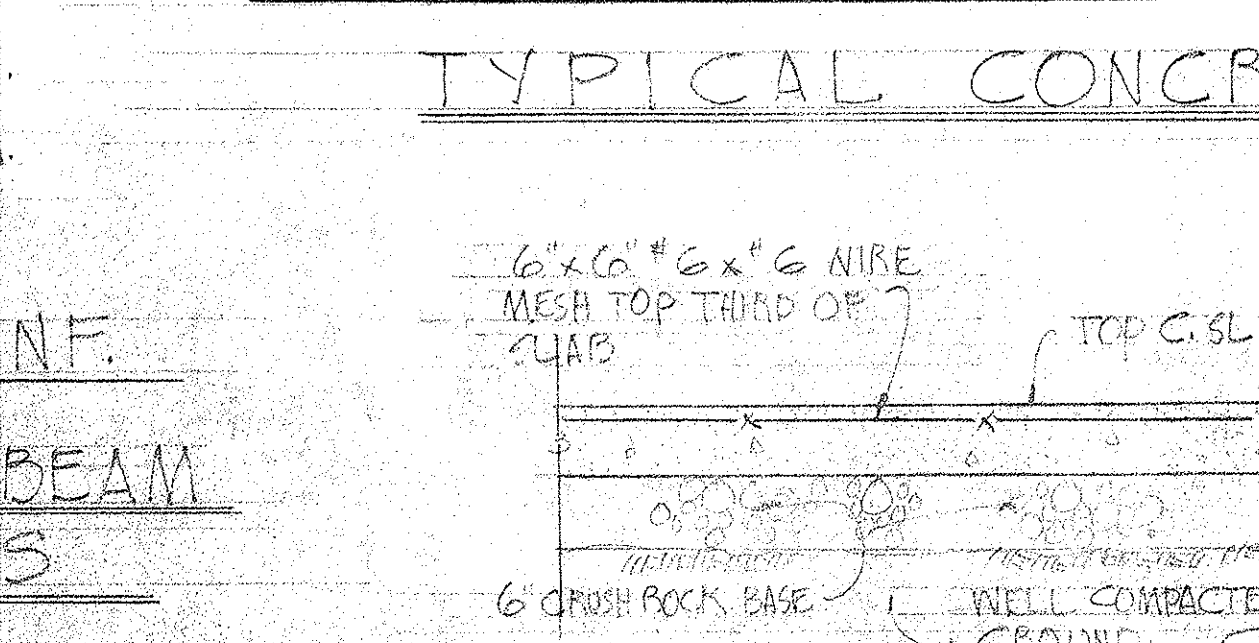
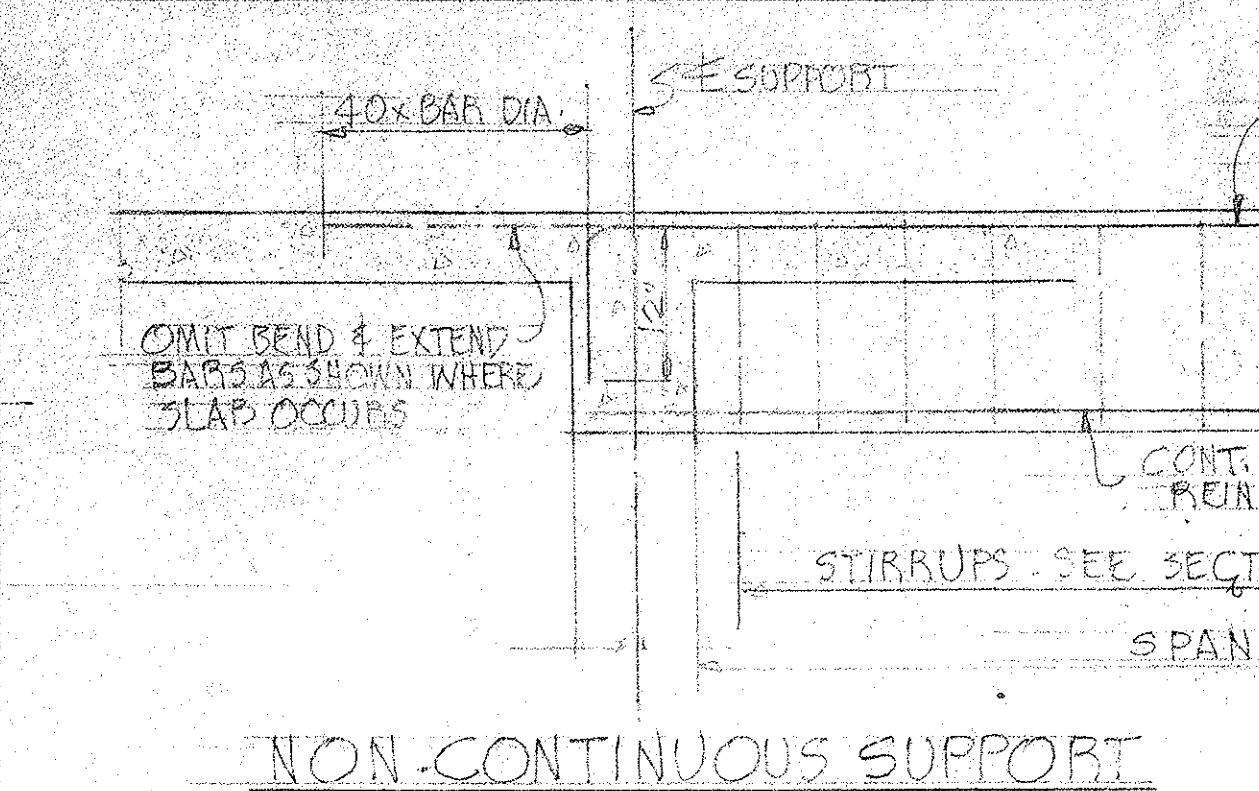
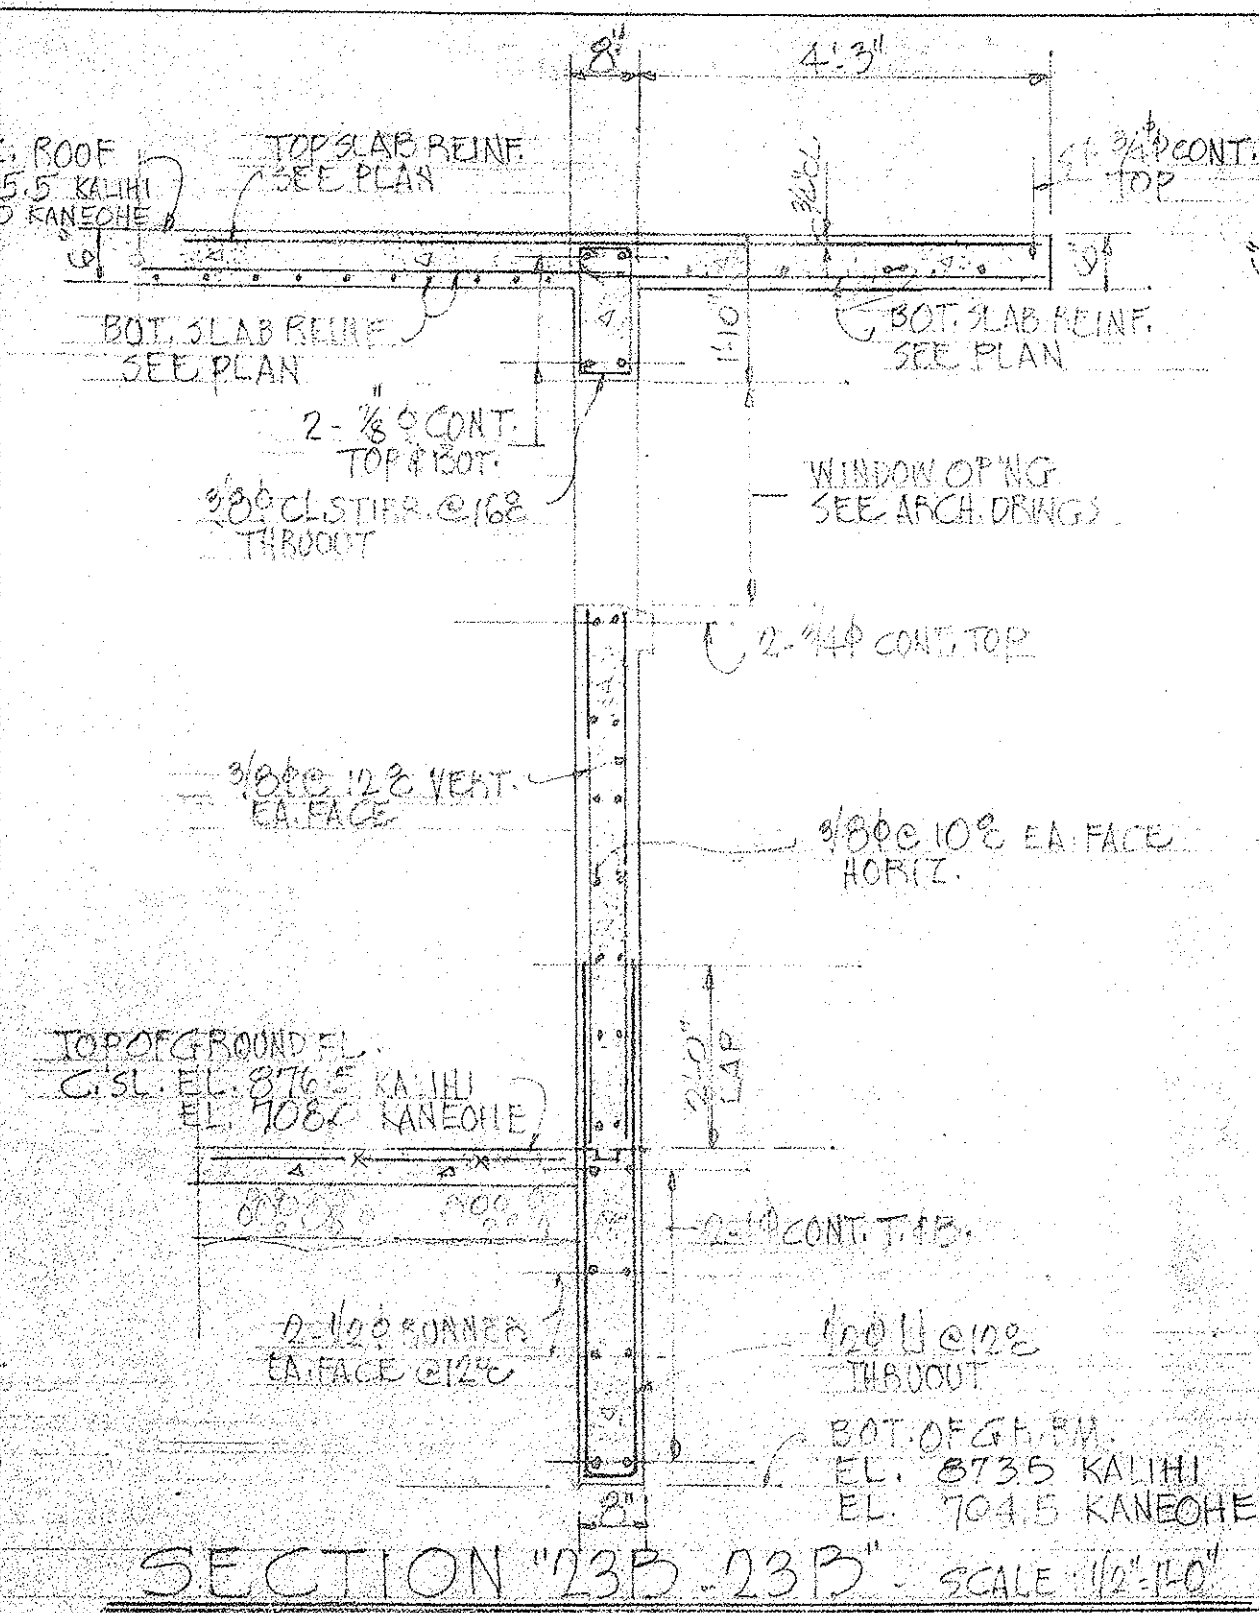
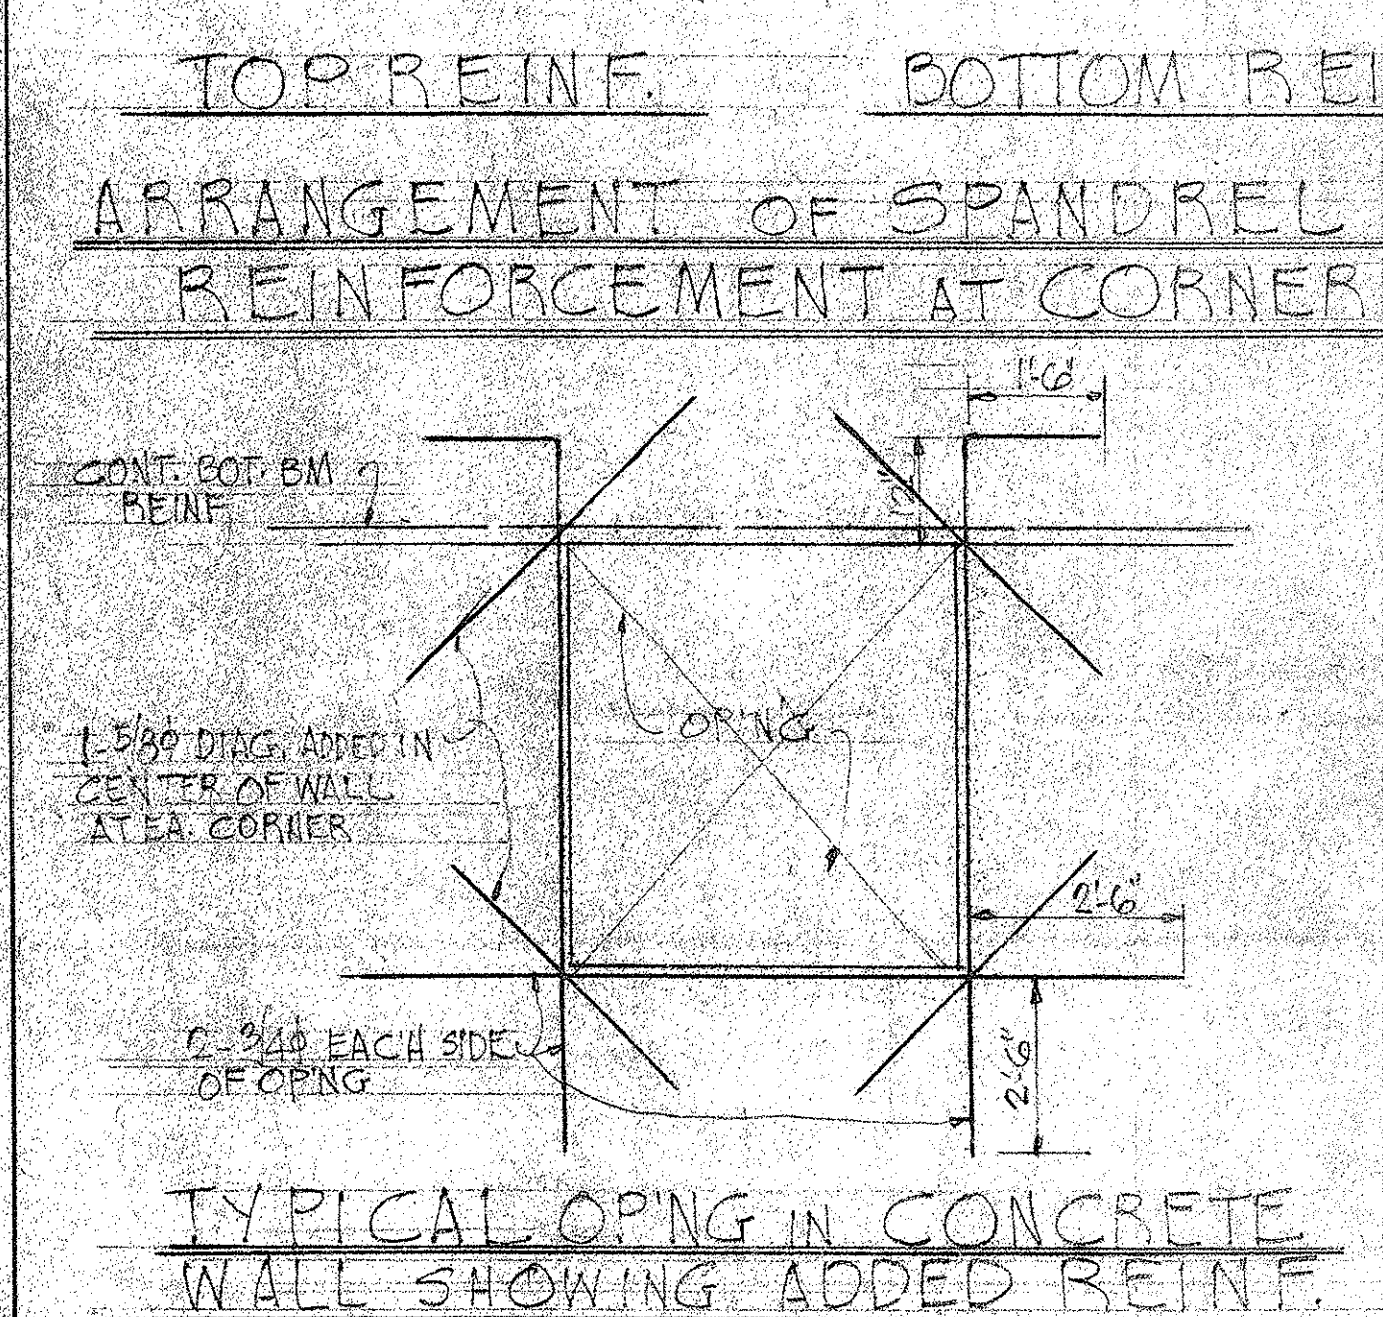
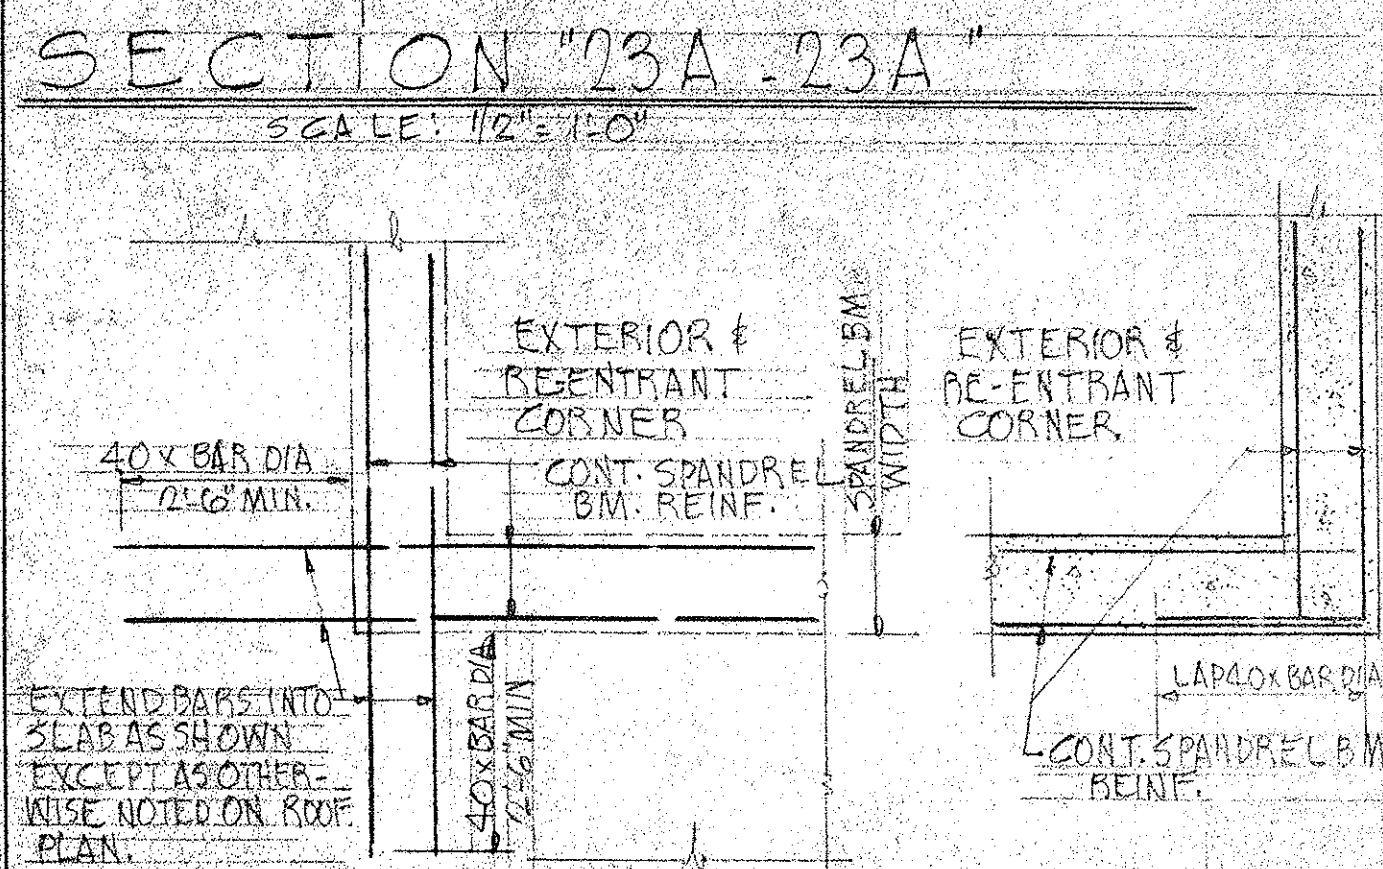


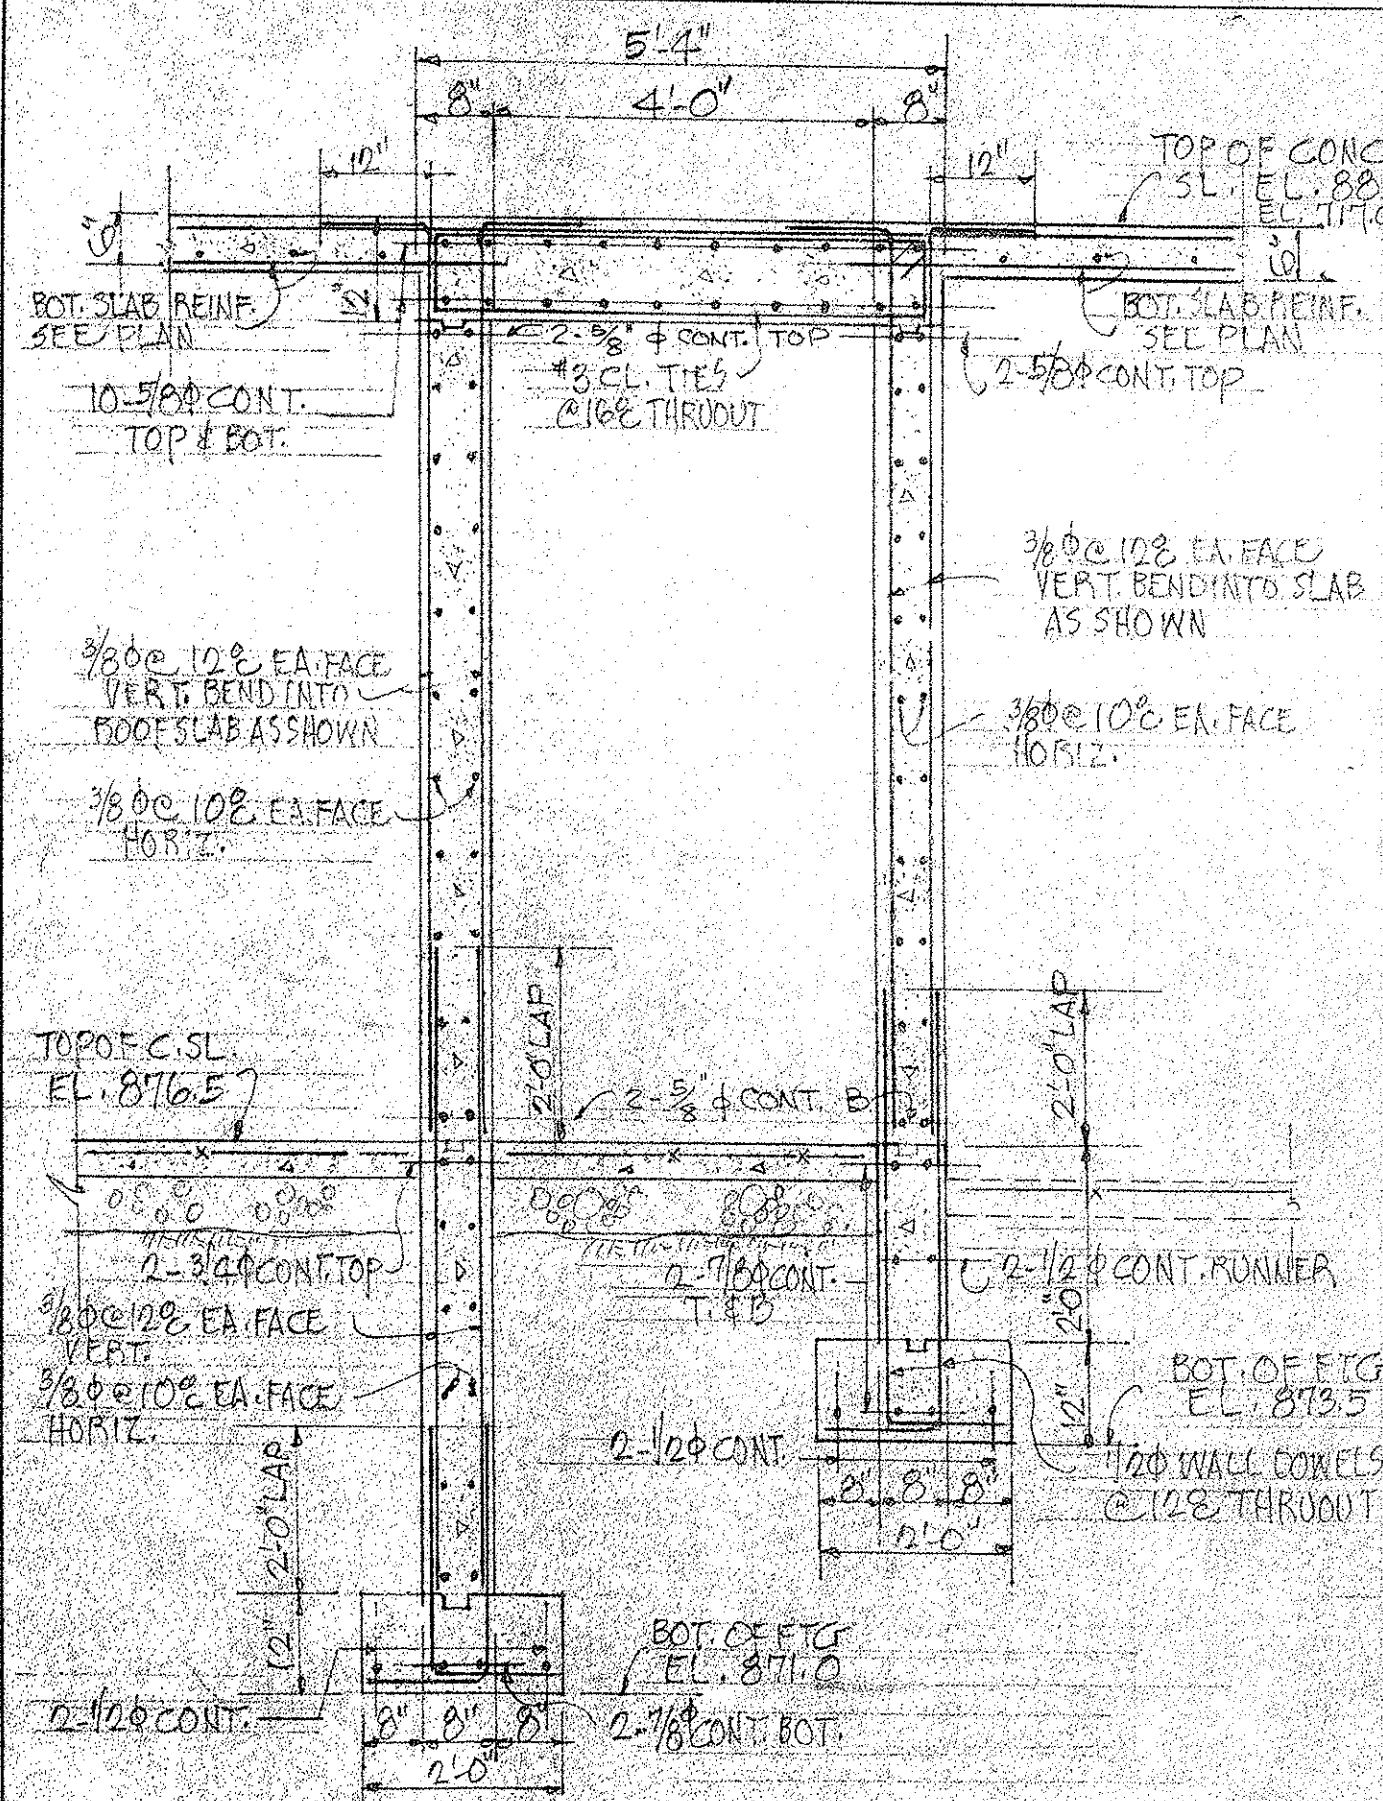

LAW & WILSON
ARCHITECTS & ENGINEERS
DEPARTMENT OF PUBLIC WORKS
CITY AND COUNTY OF HONOLULU
BUREAU OF PLANS
KALIHI TUNNEL
KALIHI PORTAL - STRUCTURAL
OFFICE & VAULT, DETAILS

ENGINEER: L. B. W.
DRAFTSMAN: P. L. O.
CHECKED BY: J. E. F.
DATE: JULY 15, 1953
AS NOTED
TRACER: J. Y. L.
APPROVED: *[Signature]*
CHIEF ENGINEER

W. S. PROFILE C. B.
C. B. SEC. P. B. S. B.
W. M. BY. P. W. BY.

SECTION C JOB NO. 26-53 DWG. P-23