
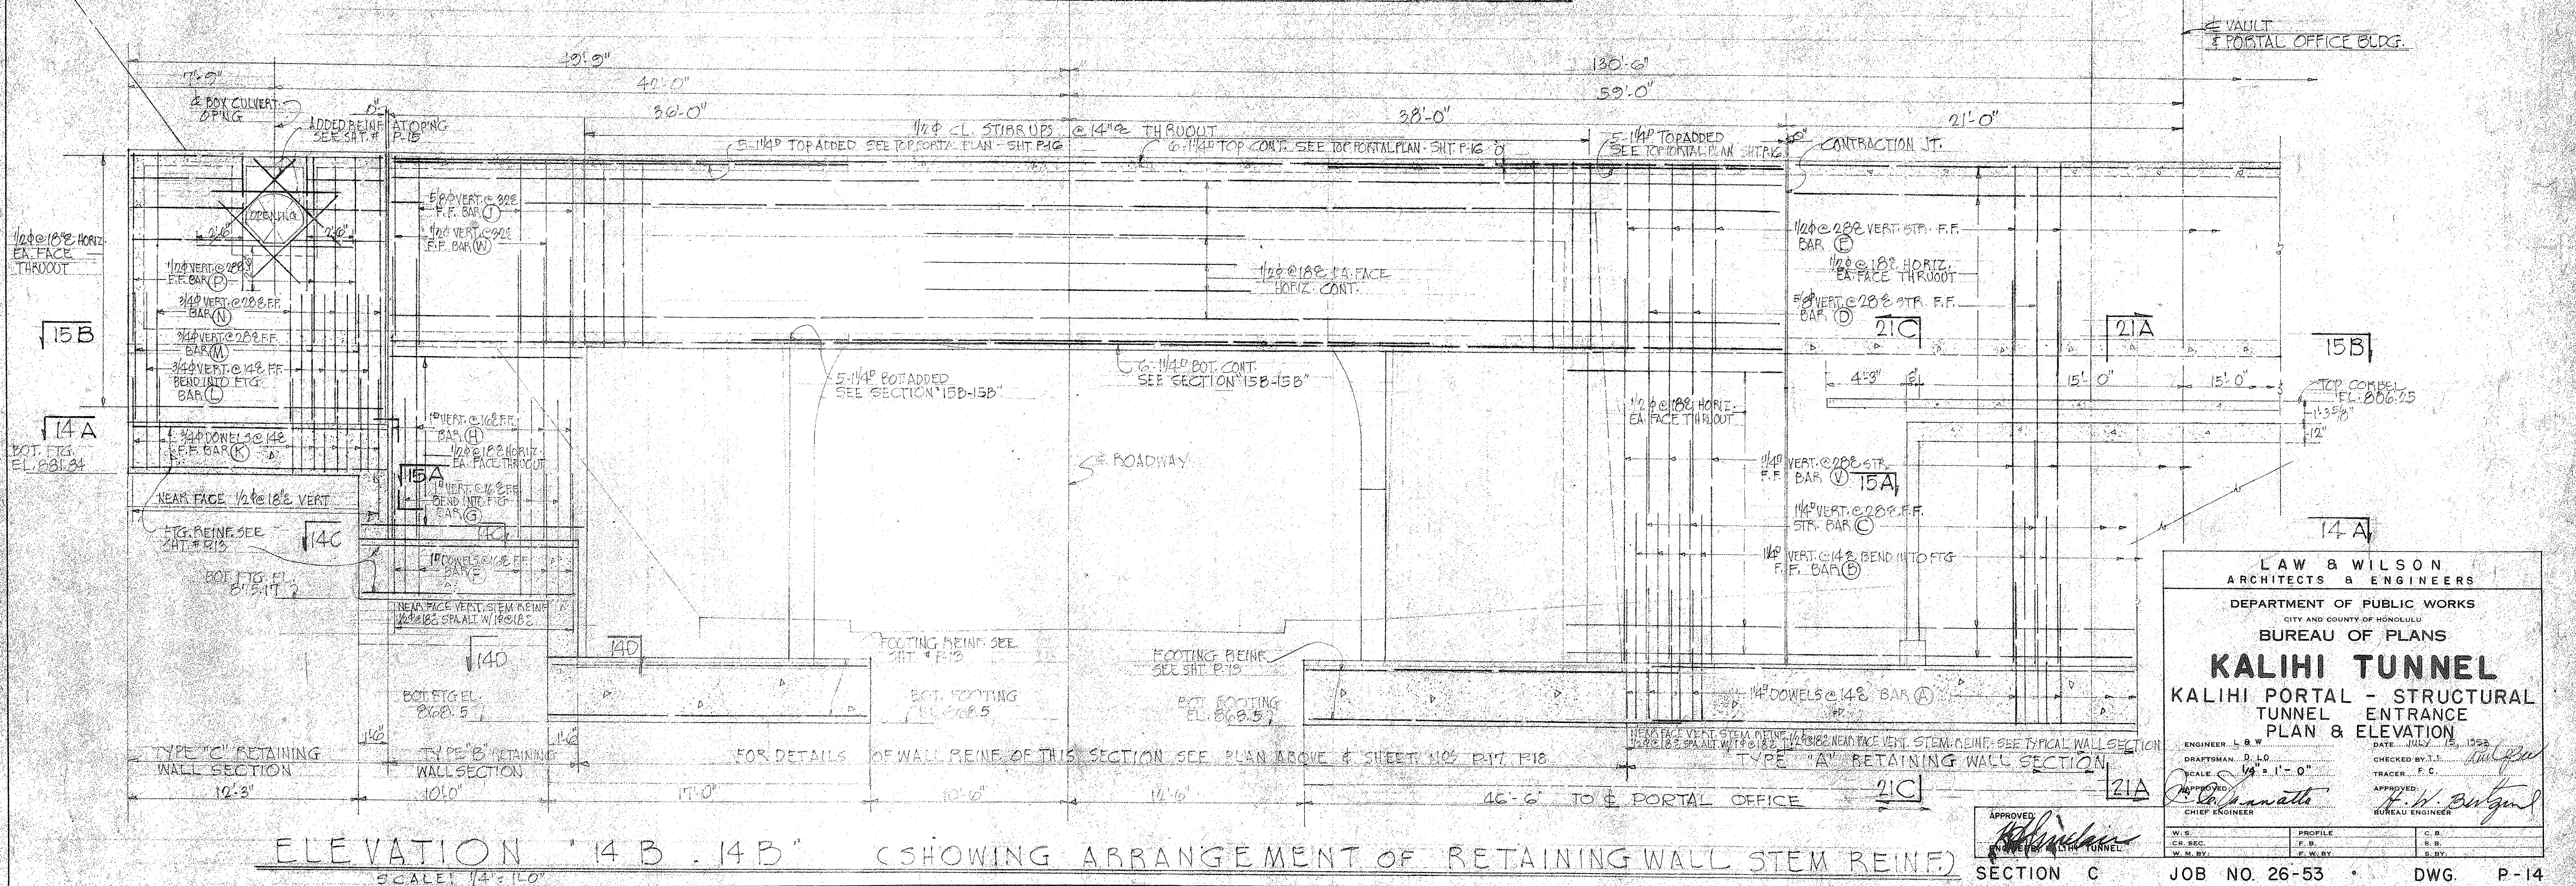


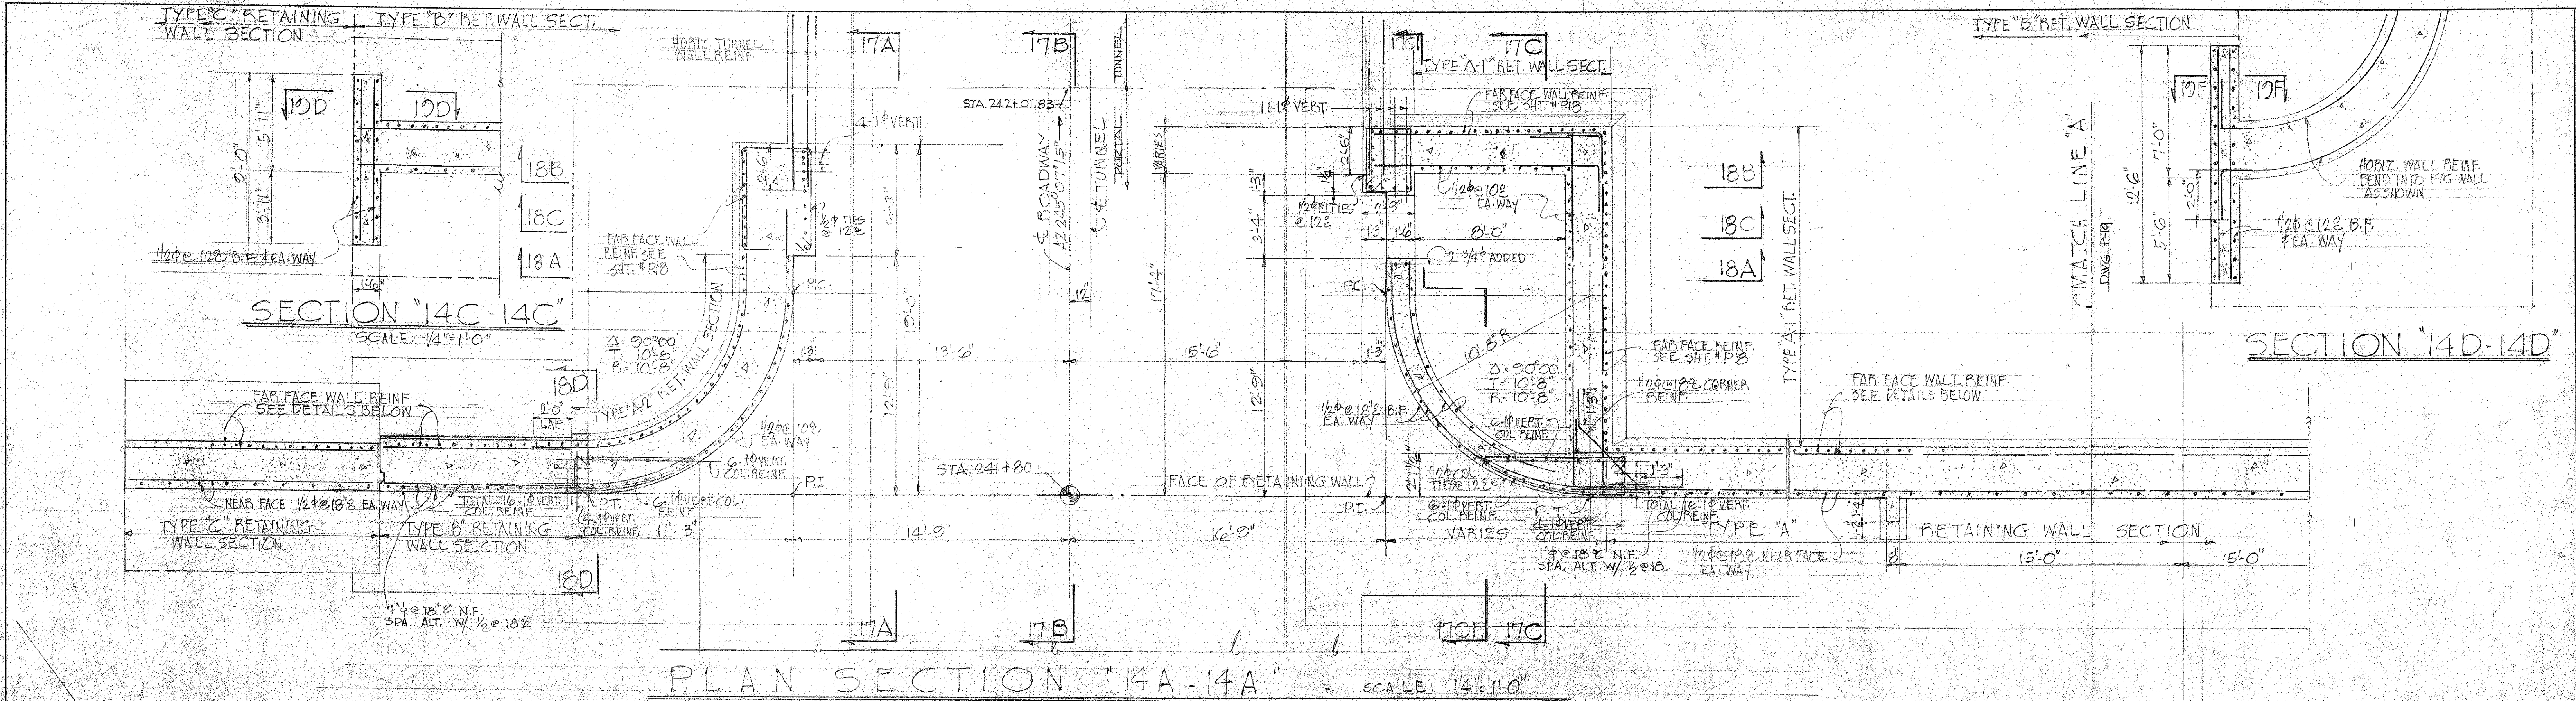

LAW & WILSON
ARCHITECTS & ENGINEERS
CITY AND COUNTY OF HONOLULU
DEPARTMENT OF PUBLIC WORKS
BUREAU OF PLANS
KALIHI TUNNEL
KALIHI PORTAL - STRUCTURAL
TUNNEL ENTRANCE
PLAN & ELEVATION

ENGINEER: J. R. WILSON
DRAFTSMAN: J. L. WILSON
SCALE: 1/4\"/>

APPROVED
[Signature]
KALIHI TUNNEL