
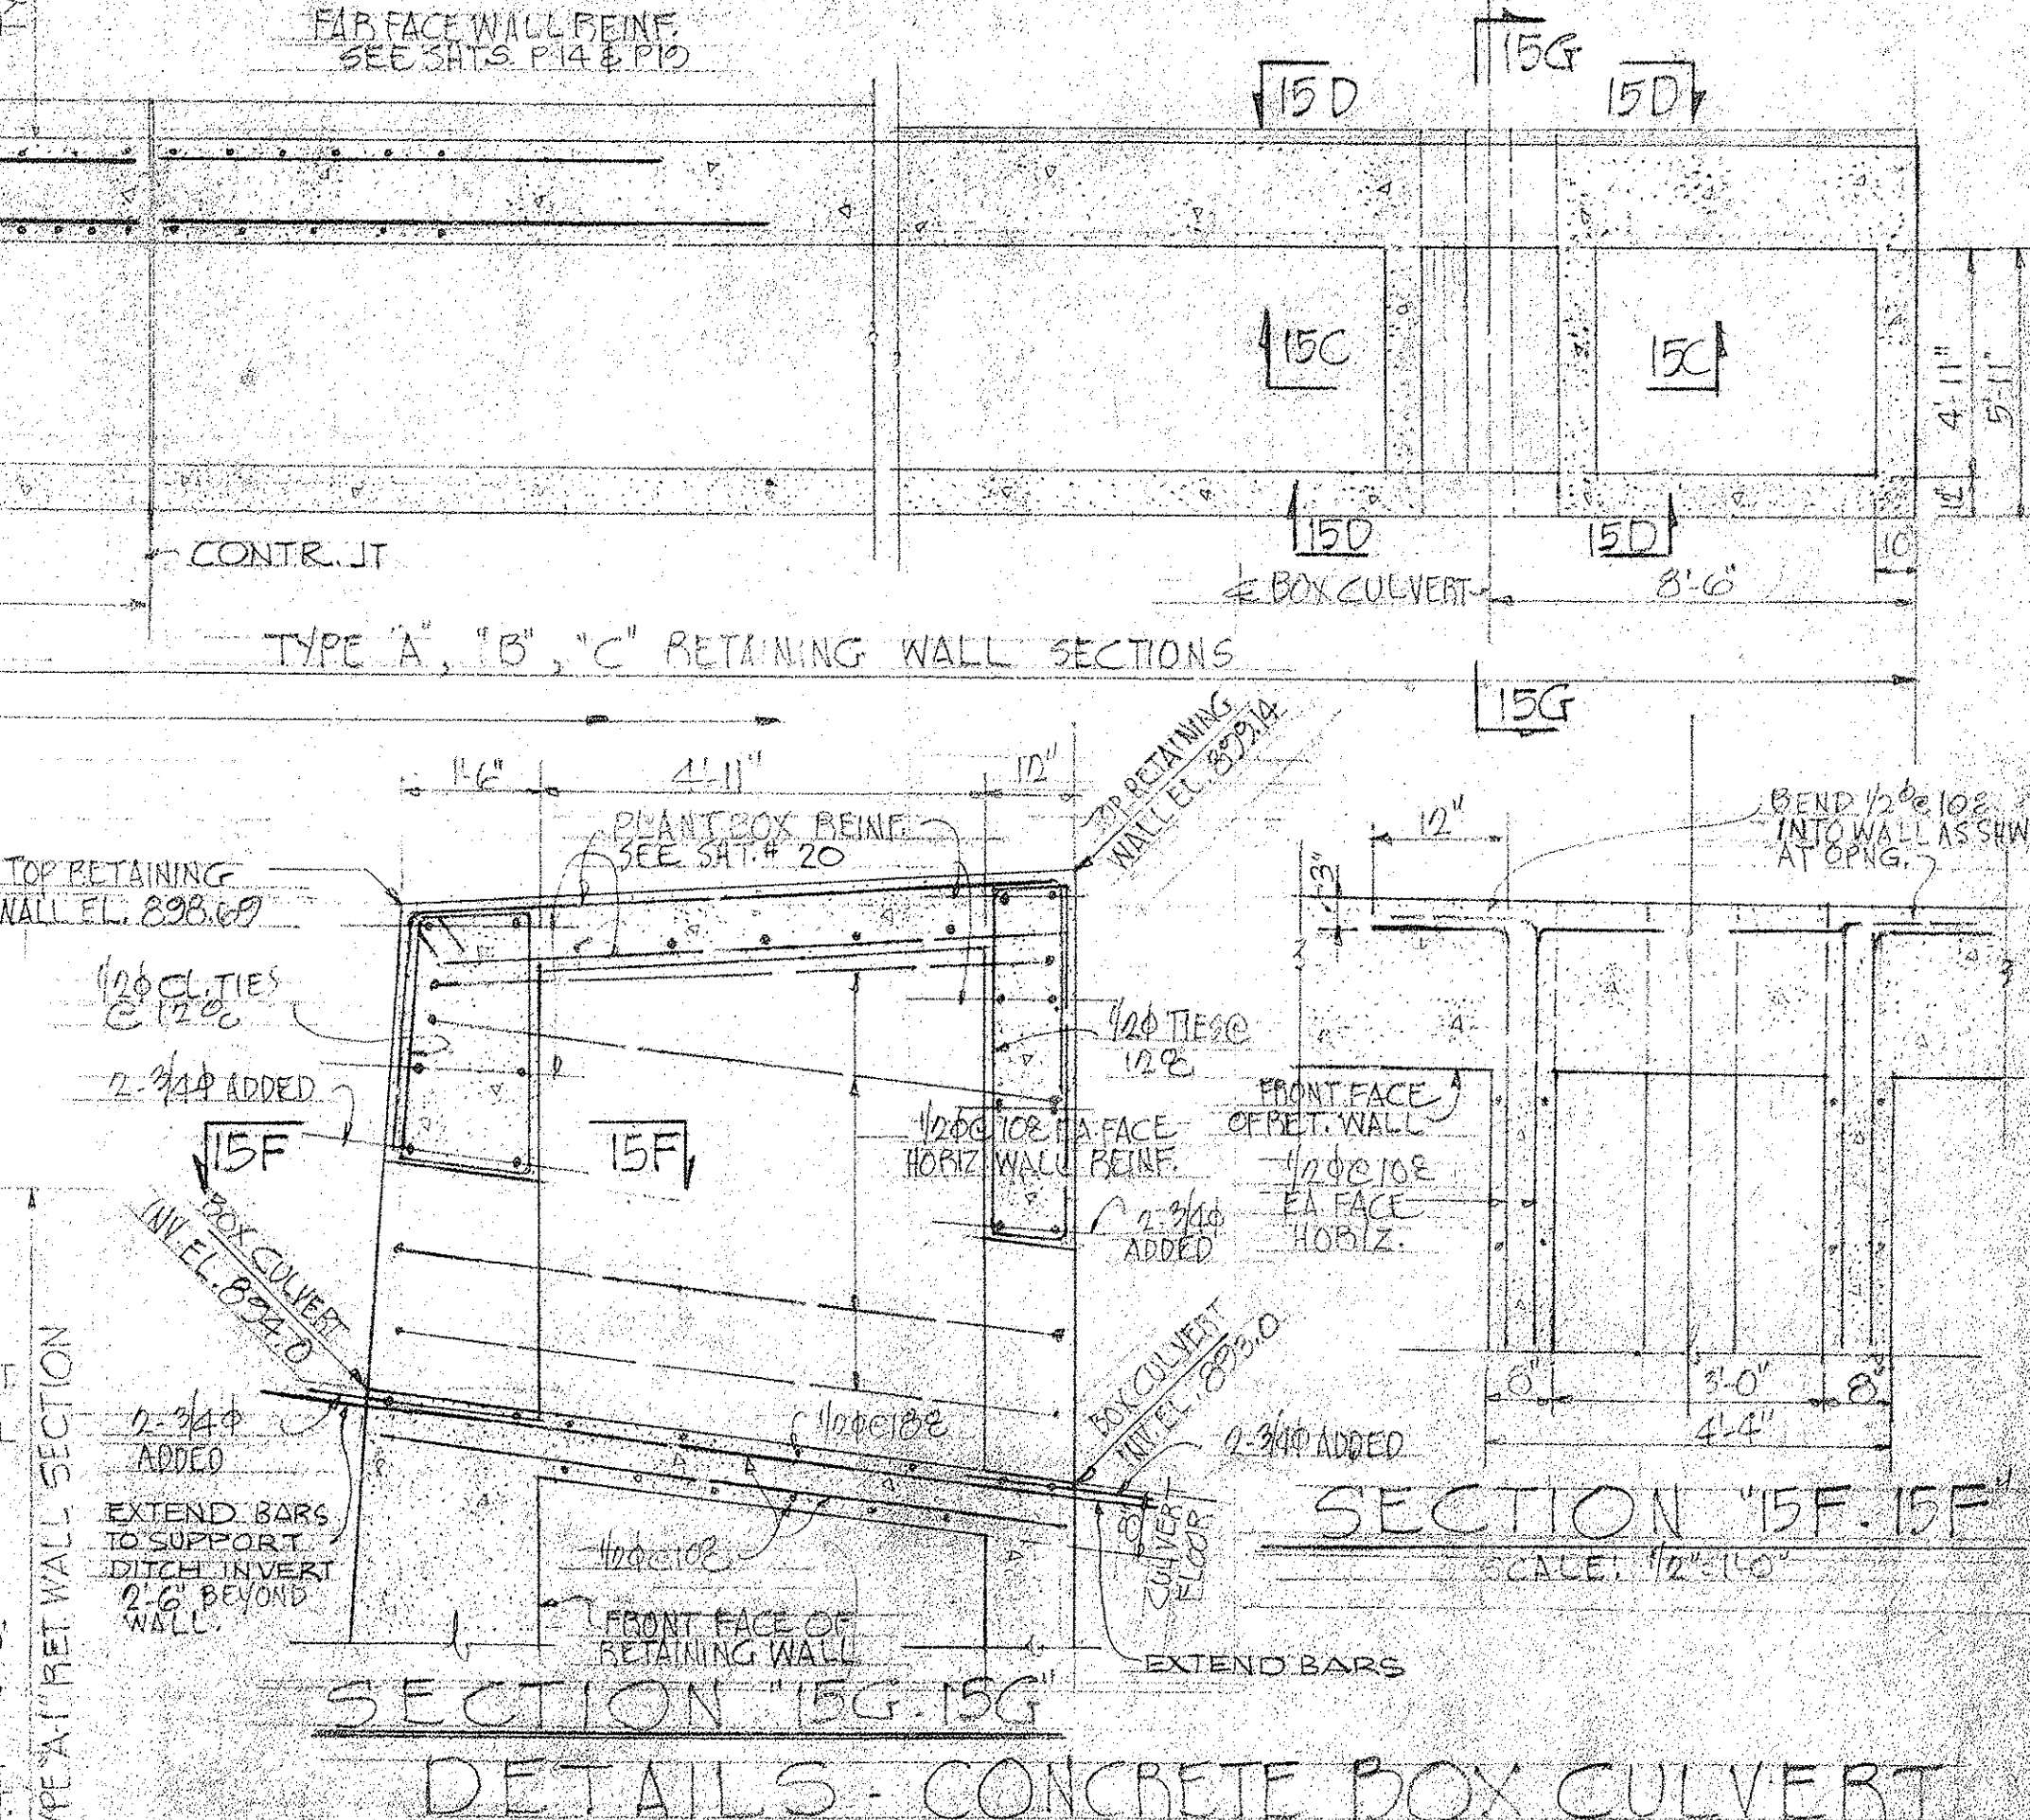
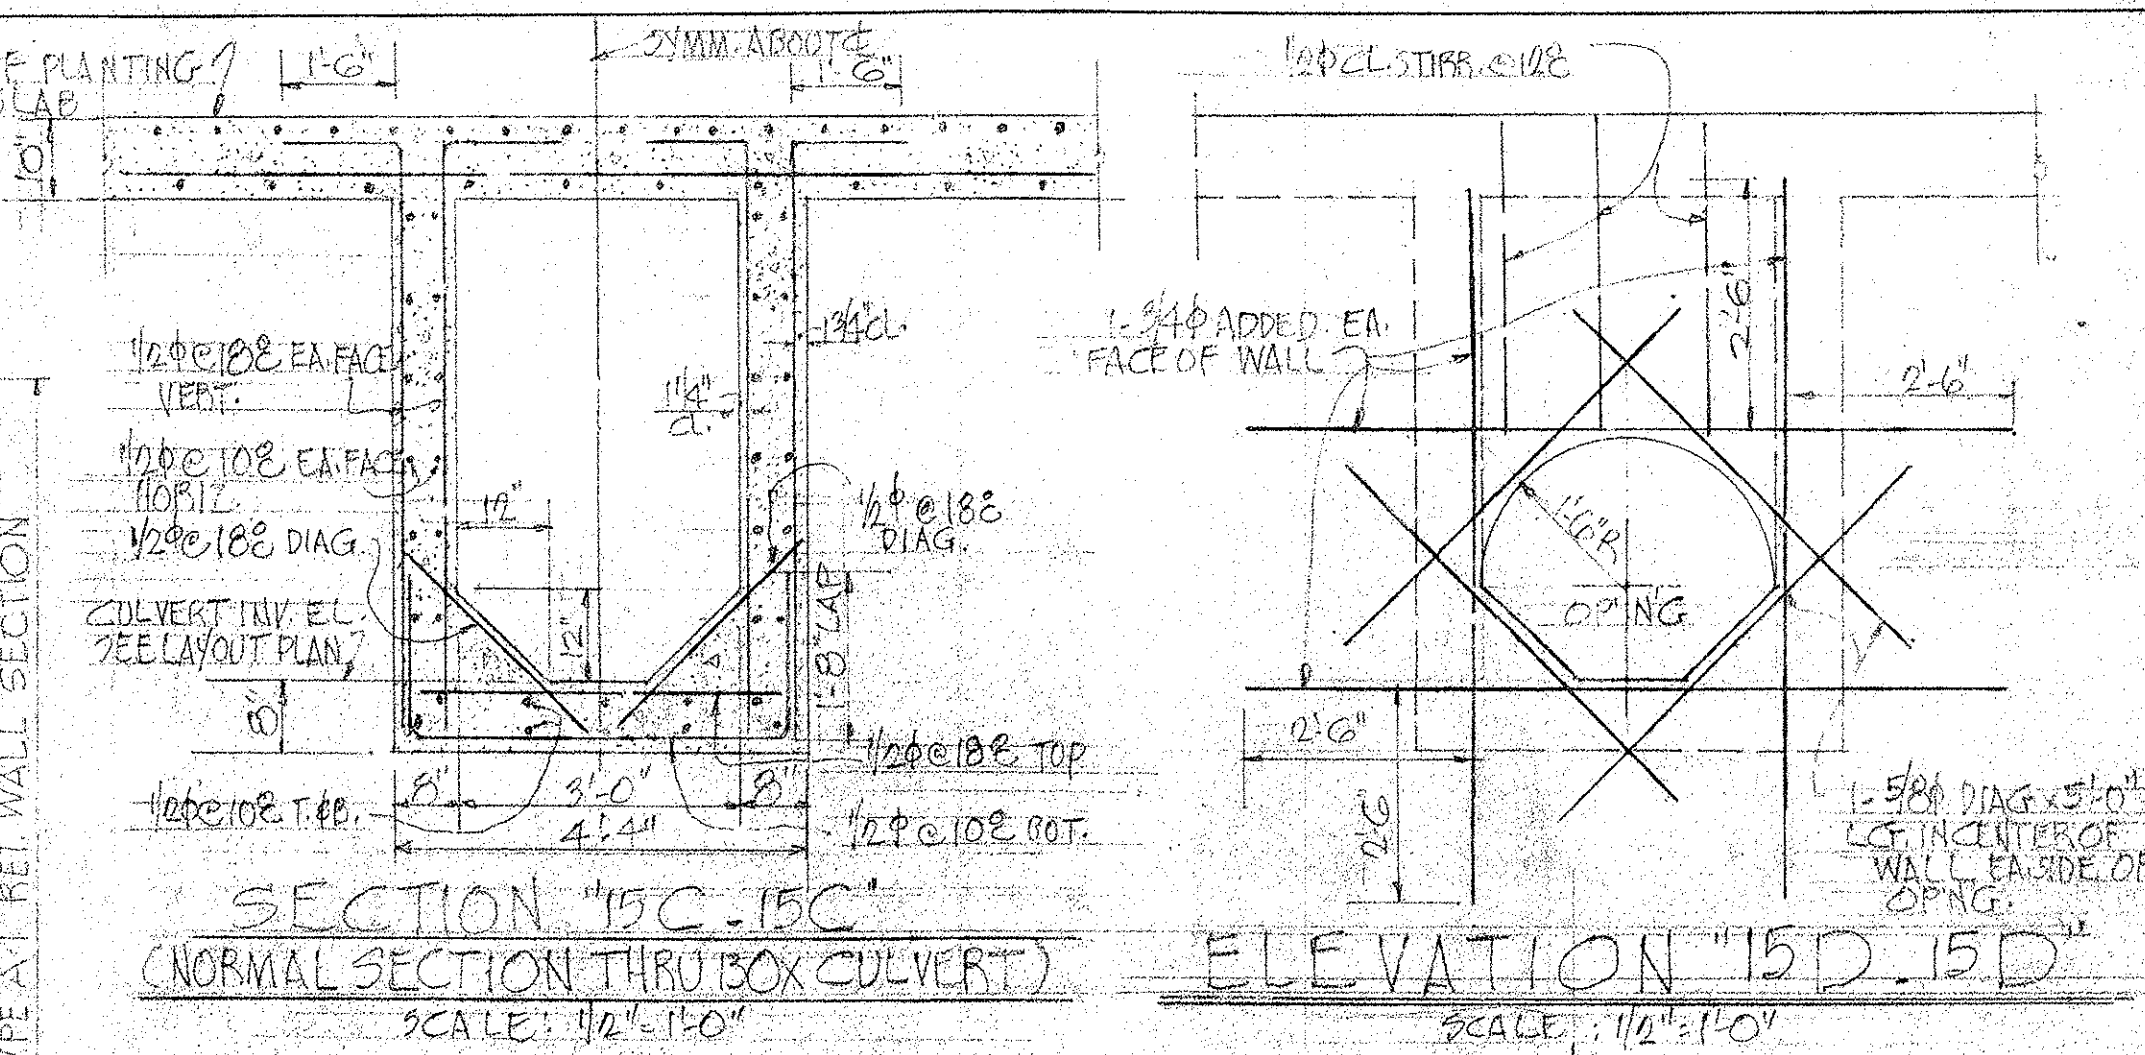
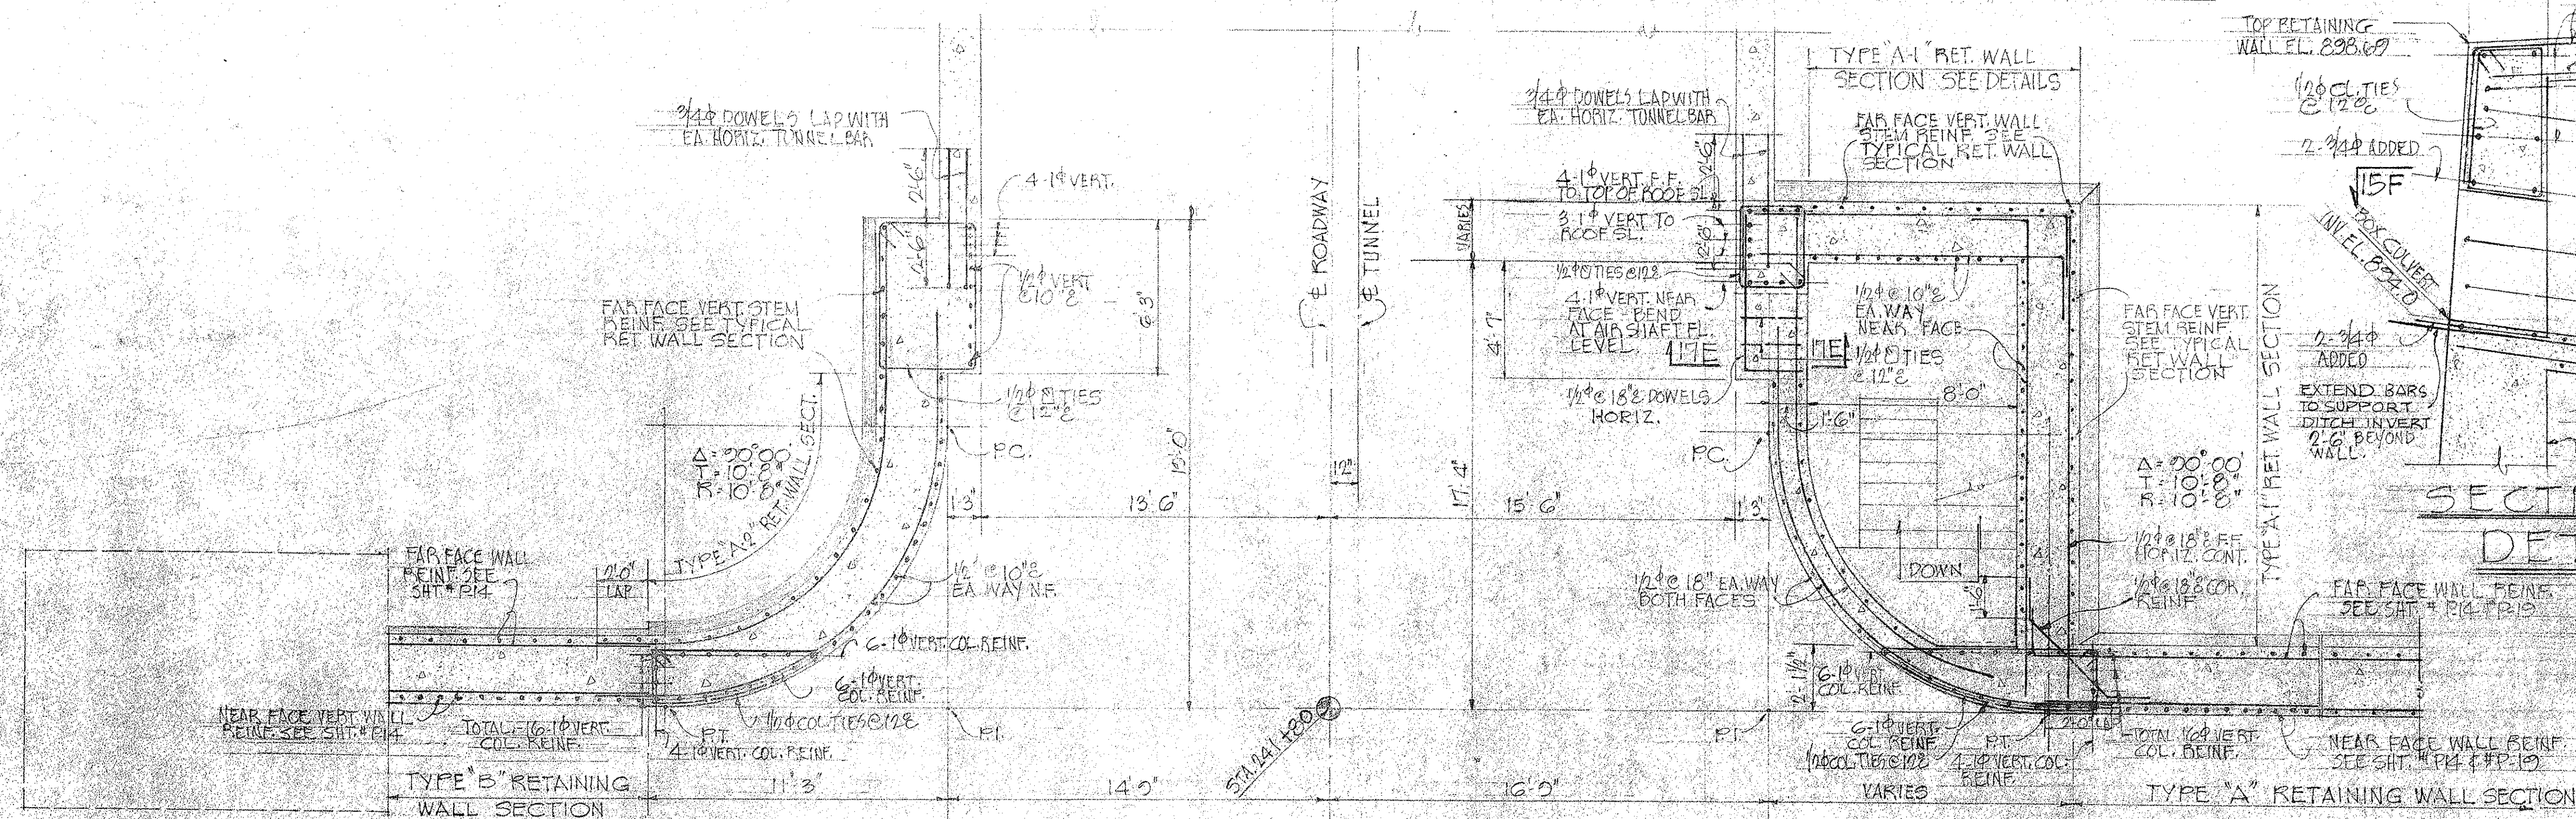


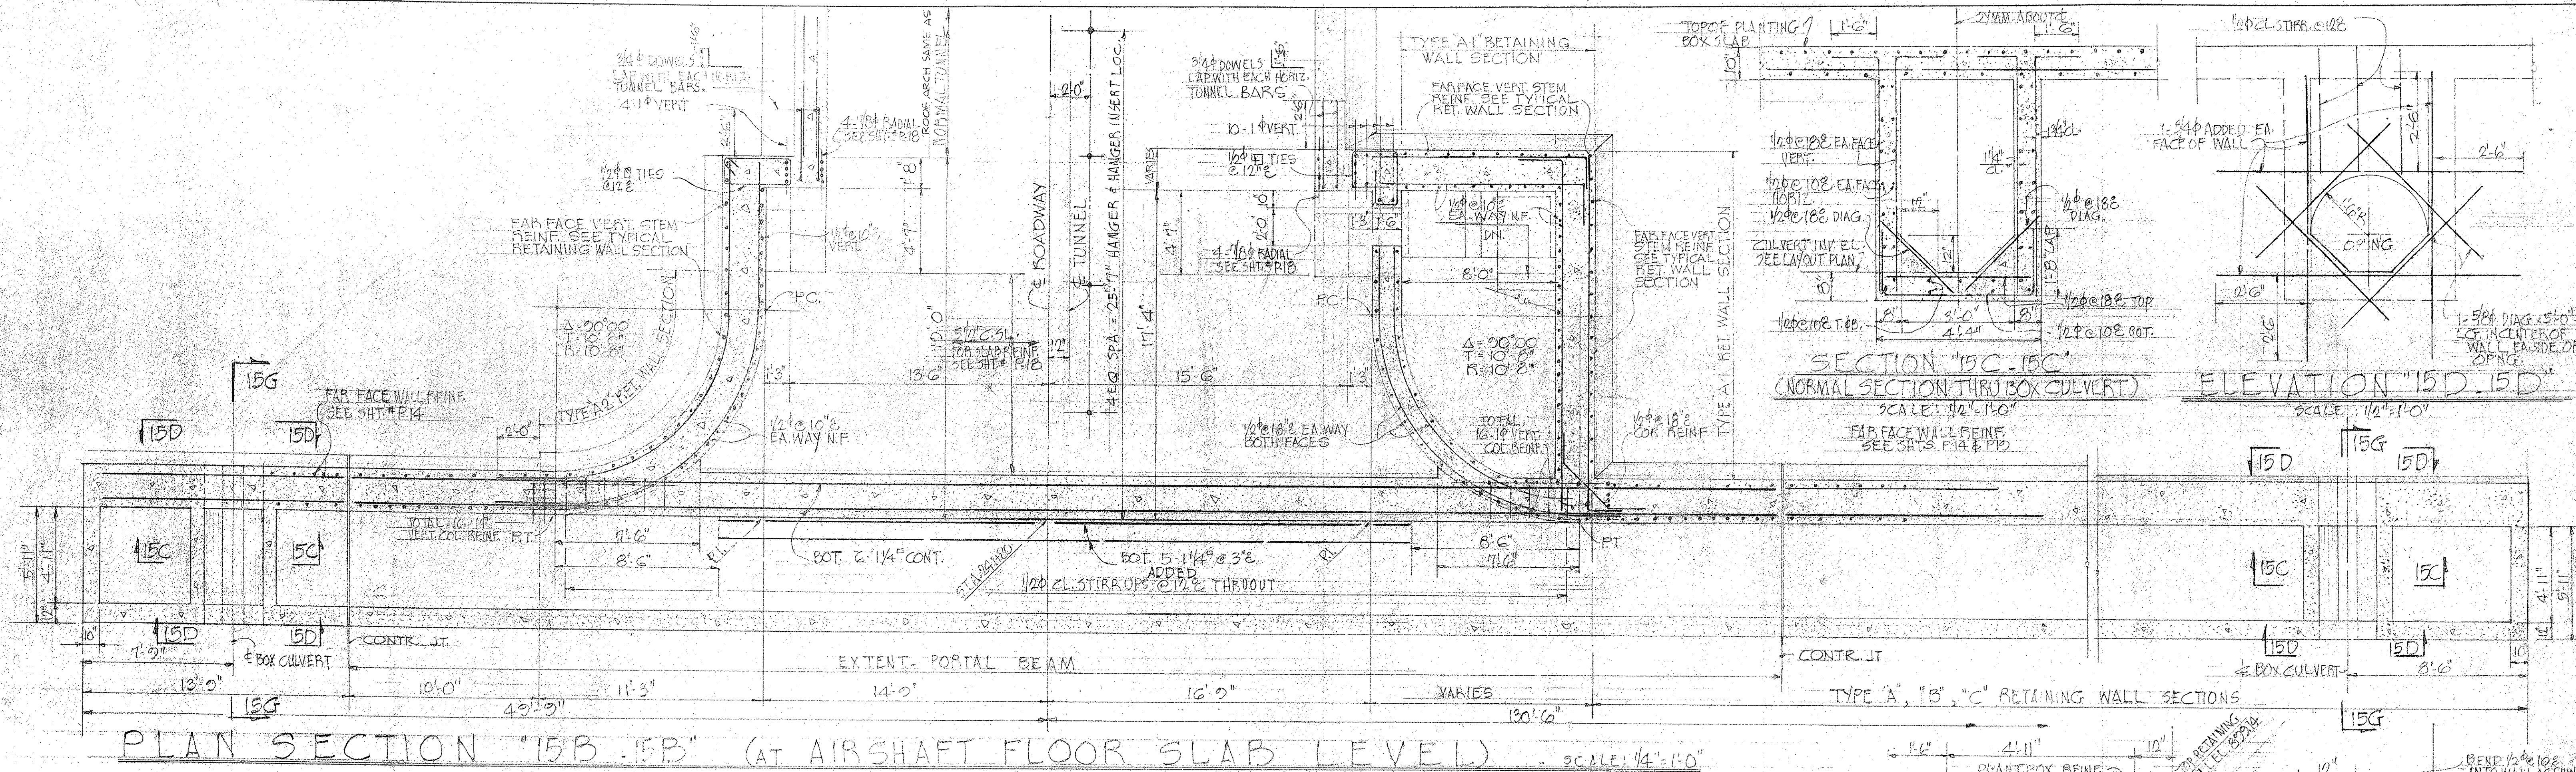

LAW & WILSON
ARCHITECTS & ENGINEERS
DEPARTMENT OF PUBLIC WORKS
CITY AND COUNTY OF HONOLULU
BUREAU OF PLANS
KALIHI TUNNEL
KALIHI PORTAL - STRUCTURAL
TUNNEL ENTRANCE
PLAN SECTIONS & DETAILS
ENGINEER: L. B. W. DATE: JULY 15, 1953
DRAFTSMAN: D. L. O. CHECKED BY: J. E. L.
SCALE: AS NOTED TRACER: J. Y. L.
APPROVED: *[Signature]* APPROVED: *[Signature]*
CHIEF ENGINEER BUREAU ENGINEER