



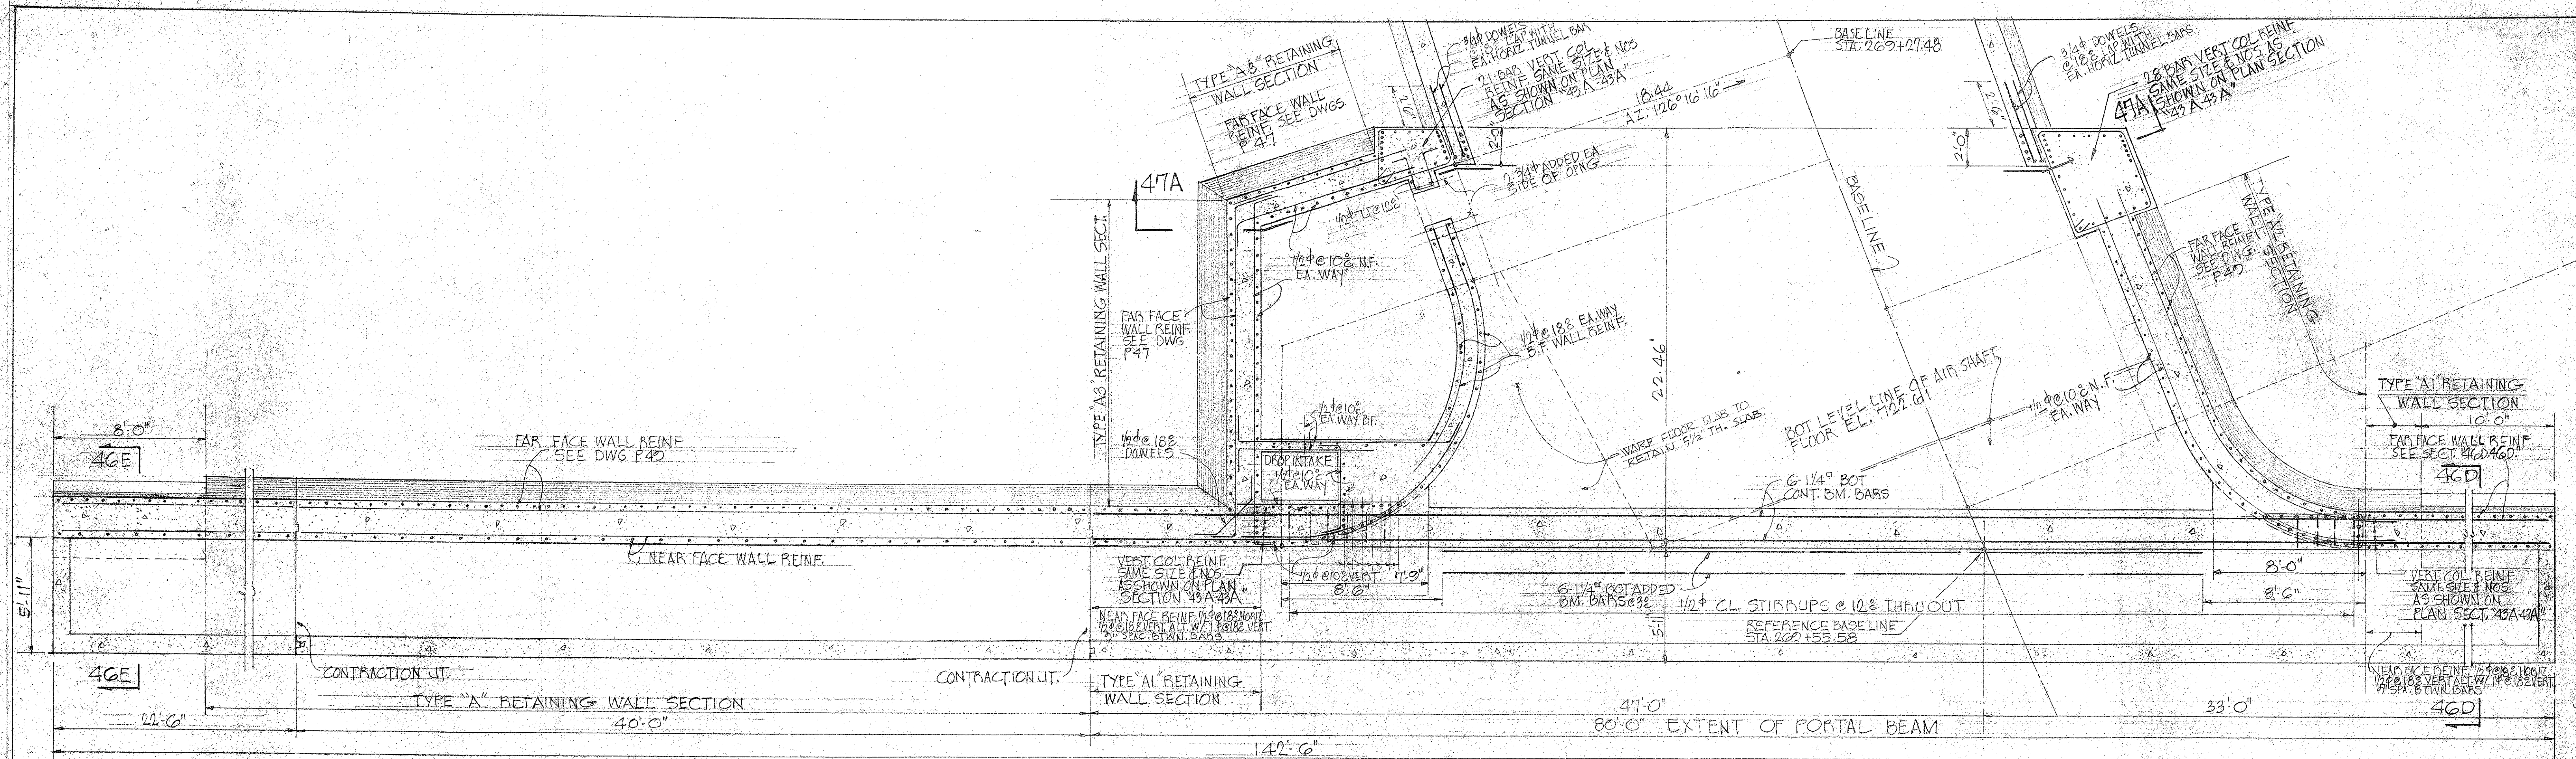

PLAN SECTION "45A-45A" AT AIRSHAFT FLOOR LEVEL SCALE: 1/4"=1'-0"

- NOTES**
- REFERENCE:**
- FOR LOCATION OF CORRESPONDING SECTION "45A-45A" SEE DWG. P.48.
- GENERAL:**
- FOR PORTAL WALL DATA SEE DWG# P.42

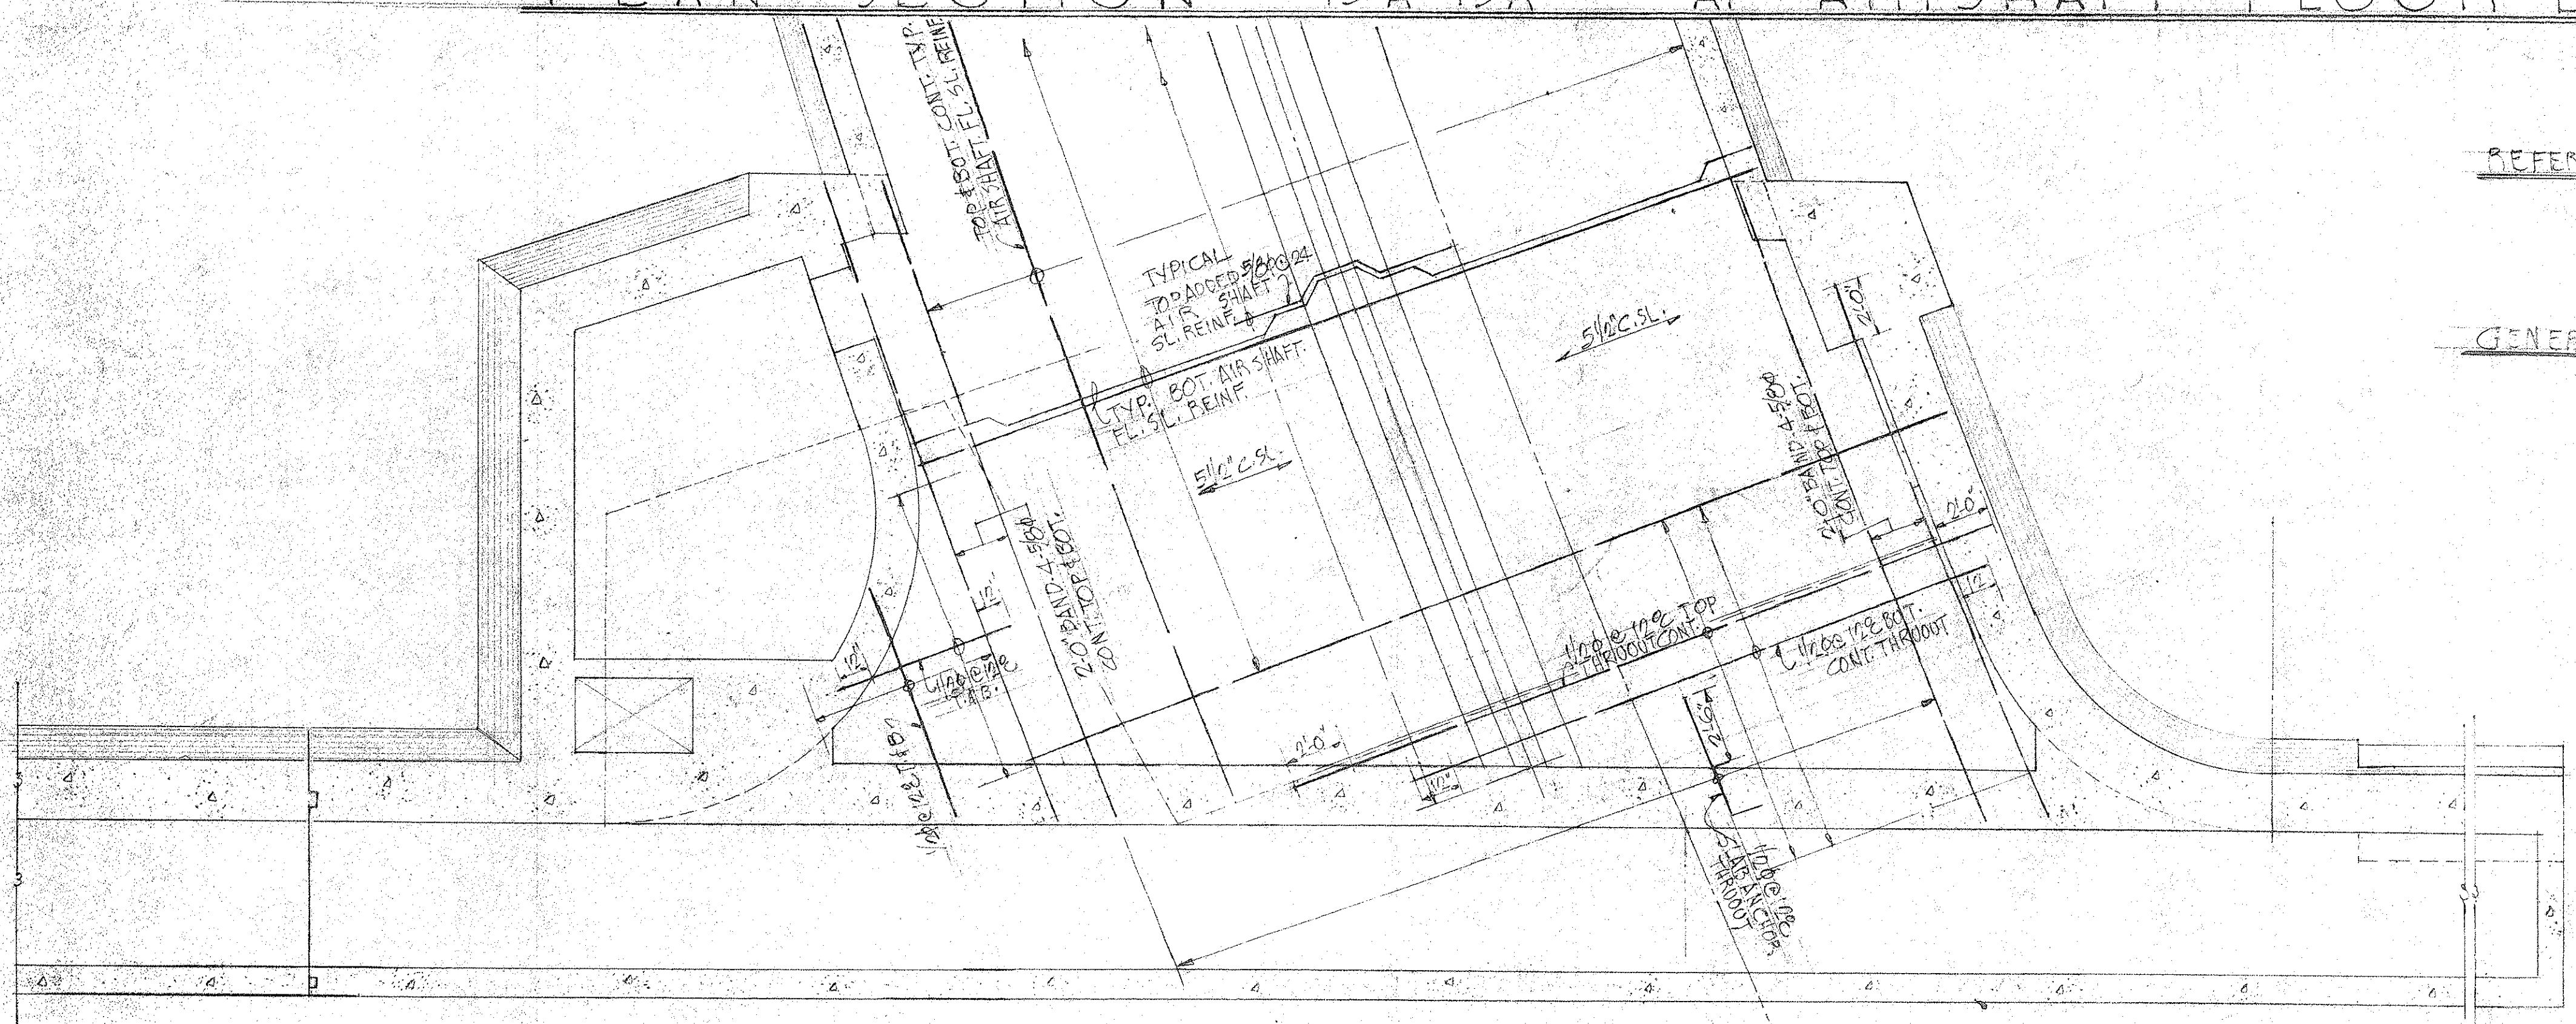

NOTE: EXCEPT AS OTHERWISE INDICATED ABOVE, AIR SHAFT FLOOR SLAB REINFORCEMENT SAME AS SHOWN ON DWG. T-6

PLAN SECTION "45A-45A" (SHOWING ARRANGEMENT OF AIR SHAFT FLOOR SLAB REINFORCEMENT)

LAW & WILSON
ARCHITECTS & ENGINEERS
DEPARTMENT OF PUBLIC WORKS
CITY AND COUNTY OF HONOLULU
BUREAU OF PLANS
KALIHI TUNNEL
KANEHOE PORTAL - STRUCTURAL
TUNNEL ENTRANCE
PLANS ABOVE CEILING

ENGINEER: L.W. D.L. DATE: JULY 15, 1953
DRAFTSMAN: J.Y.L. CHECKED BY: D.L. D.L.
SCALE: 1/4"=1'-0" TRACER:
APPROVED: *[Signature]* APPROVED: *[Signature]*
CHIEF ENGINEER BUREAU ENGINEER

W.S.	PROFILE	C.B.
CR. SEC.	F.B.	S.B.
W.M.B.Y.	F.W.B.Y.	S.B.Y.

SECTION C JOB NO. 26-53 DWG. P-45