
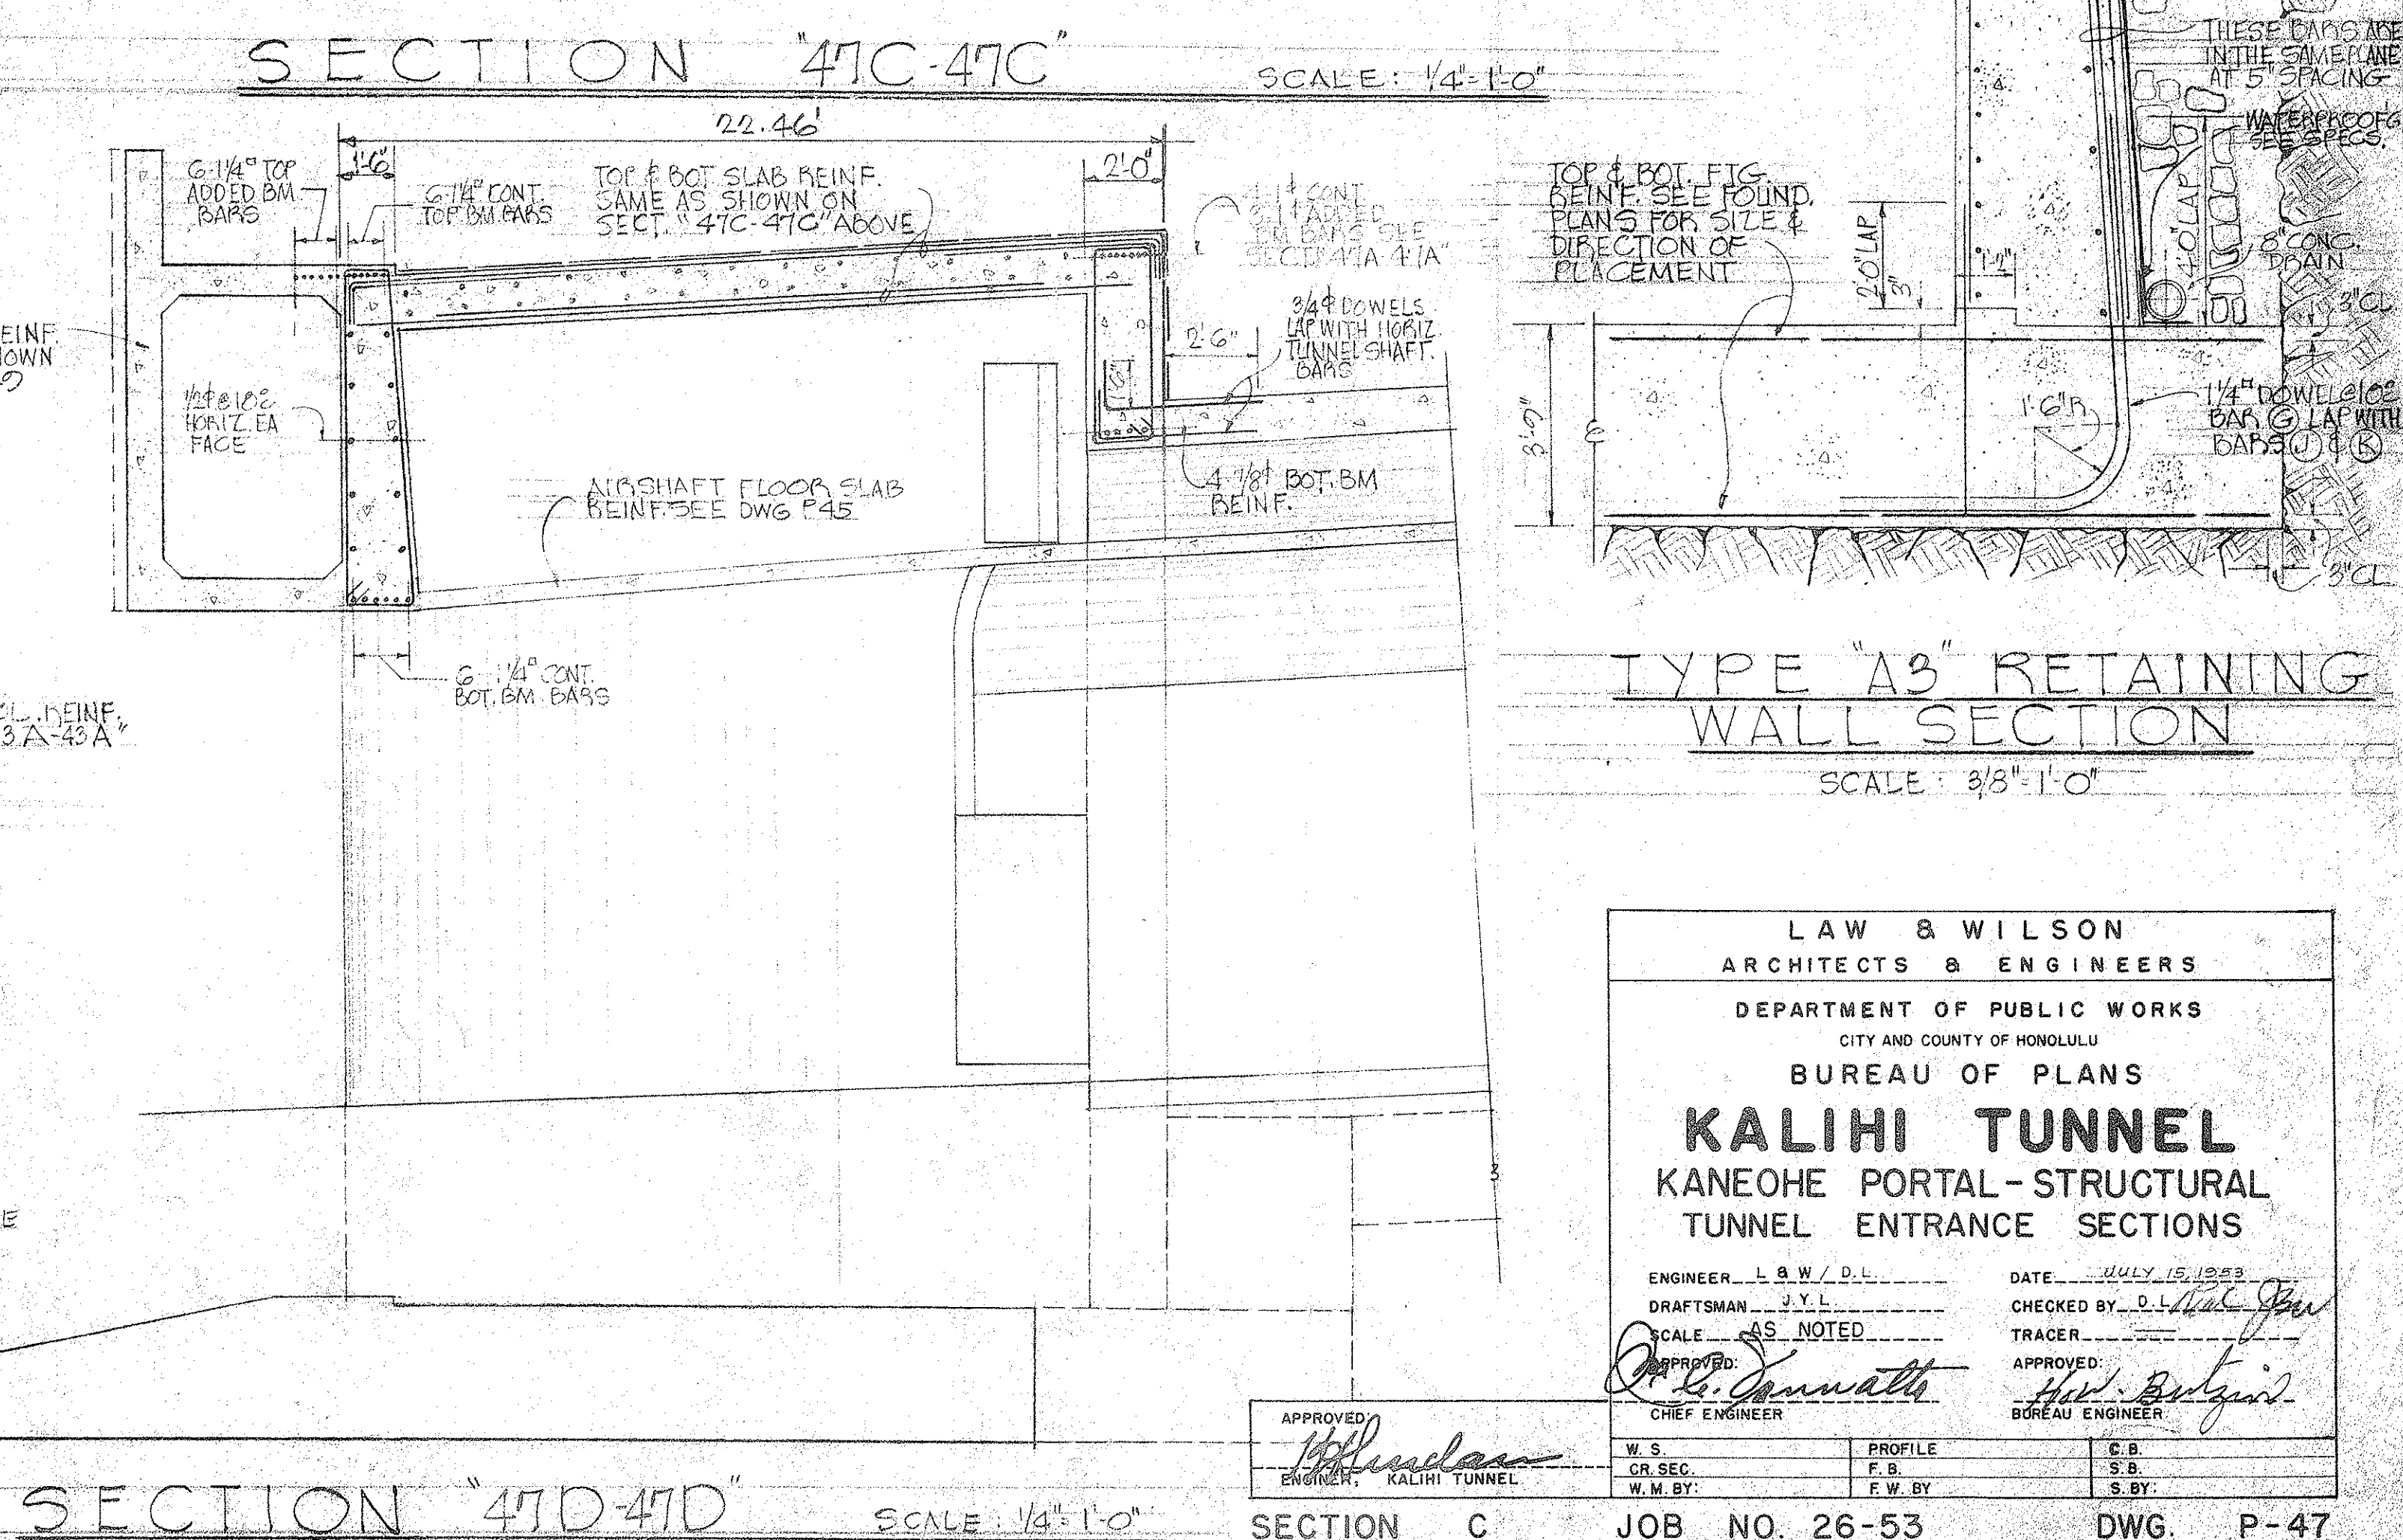
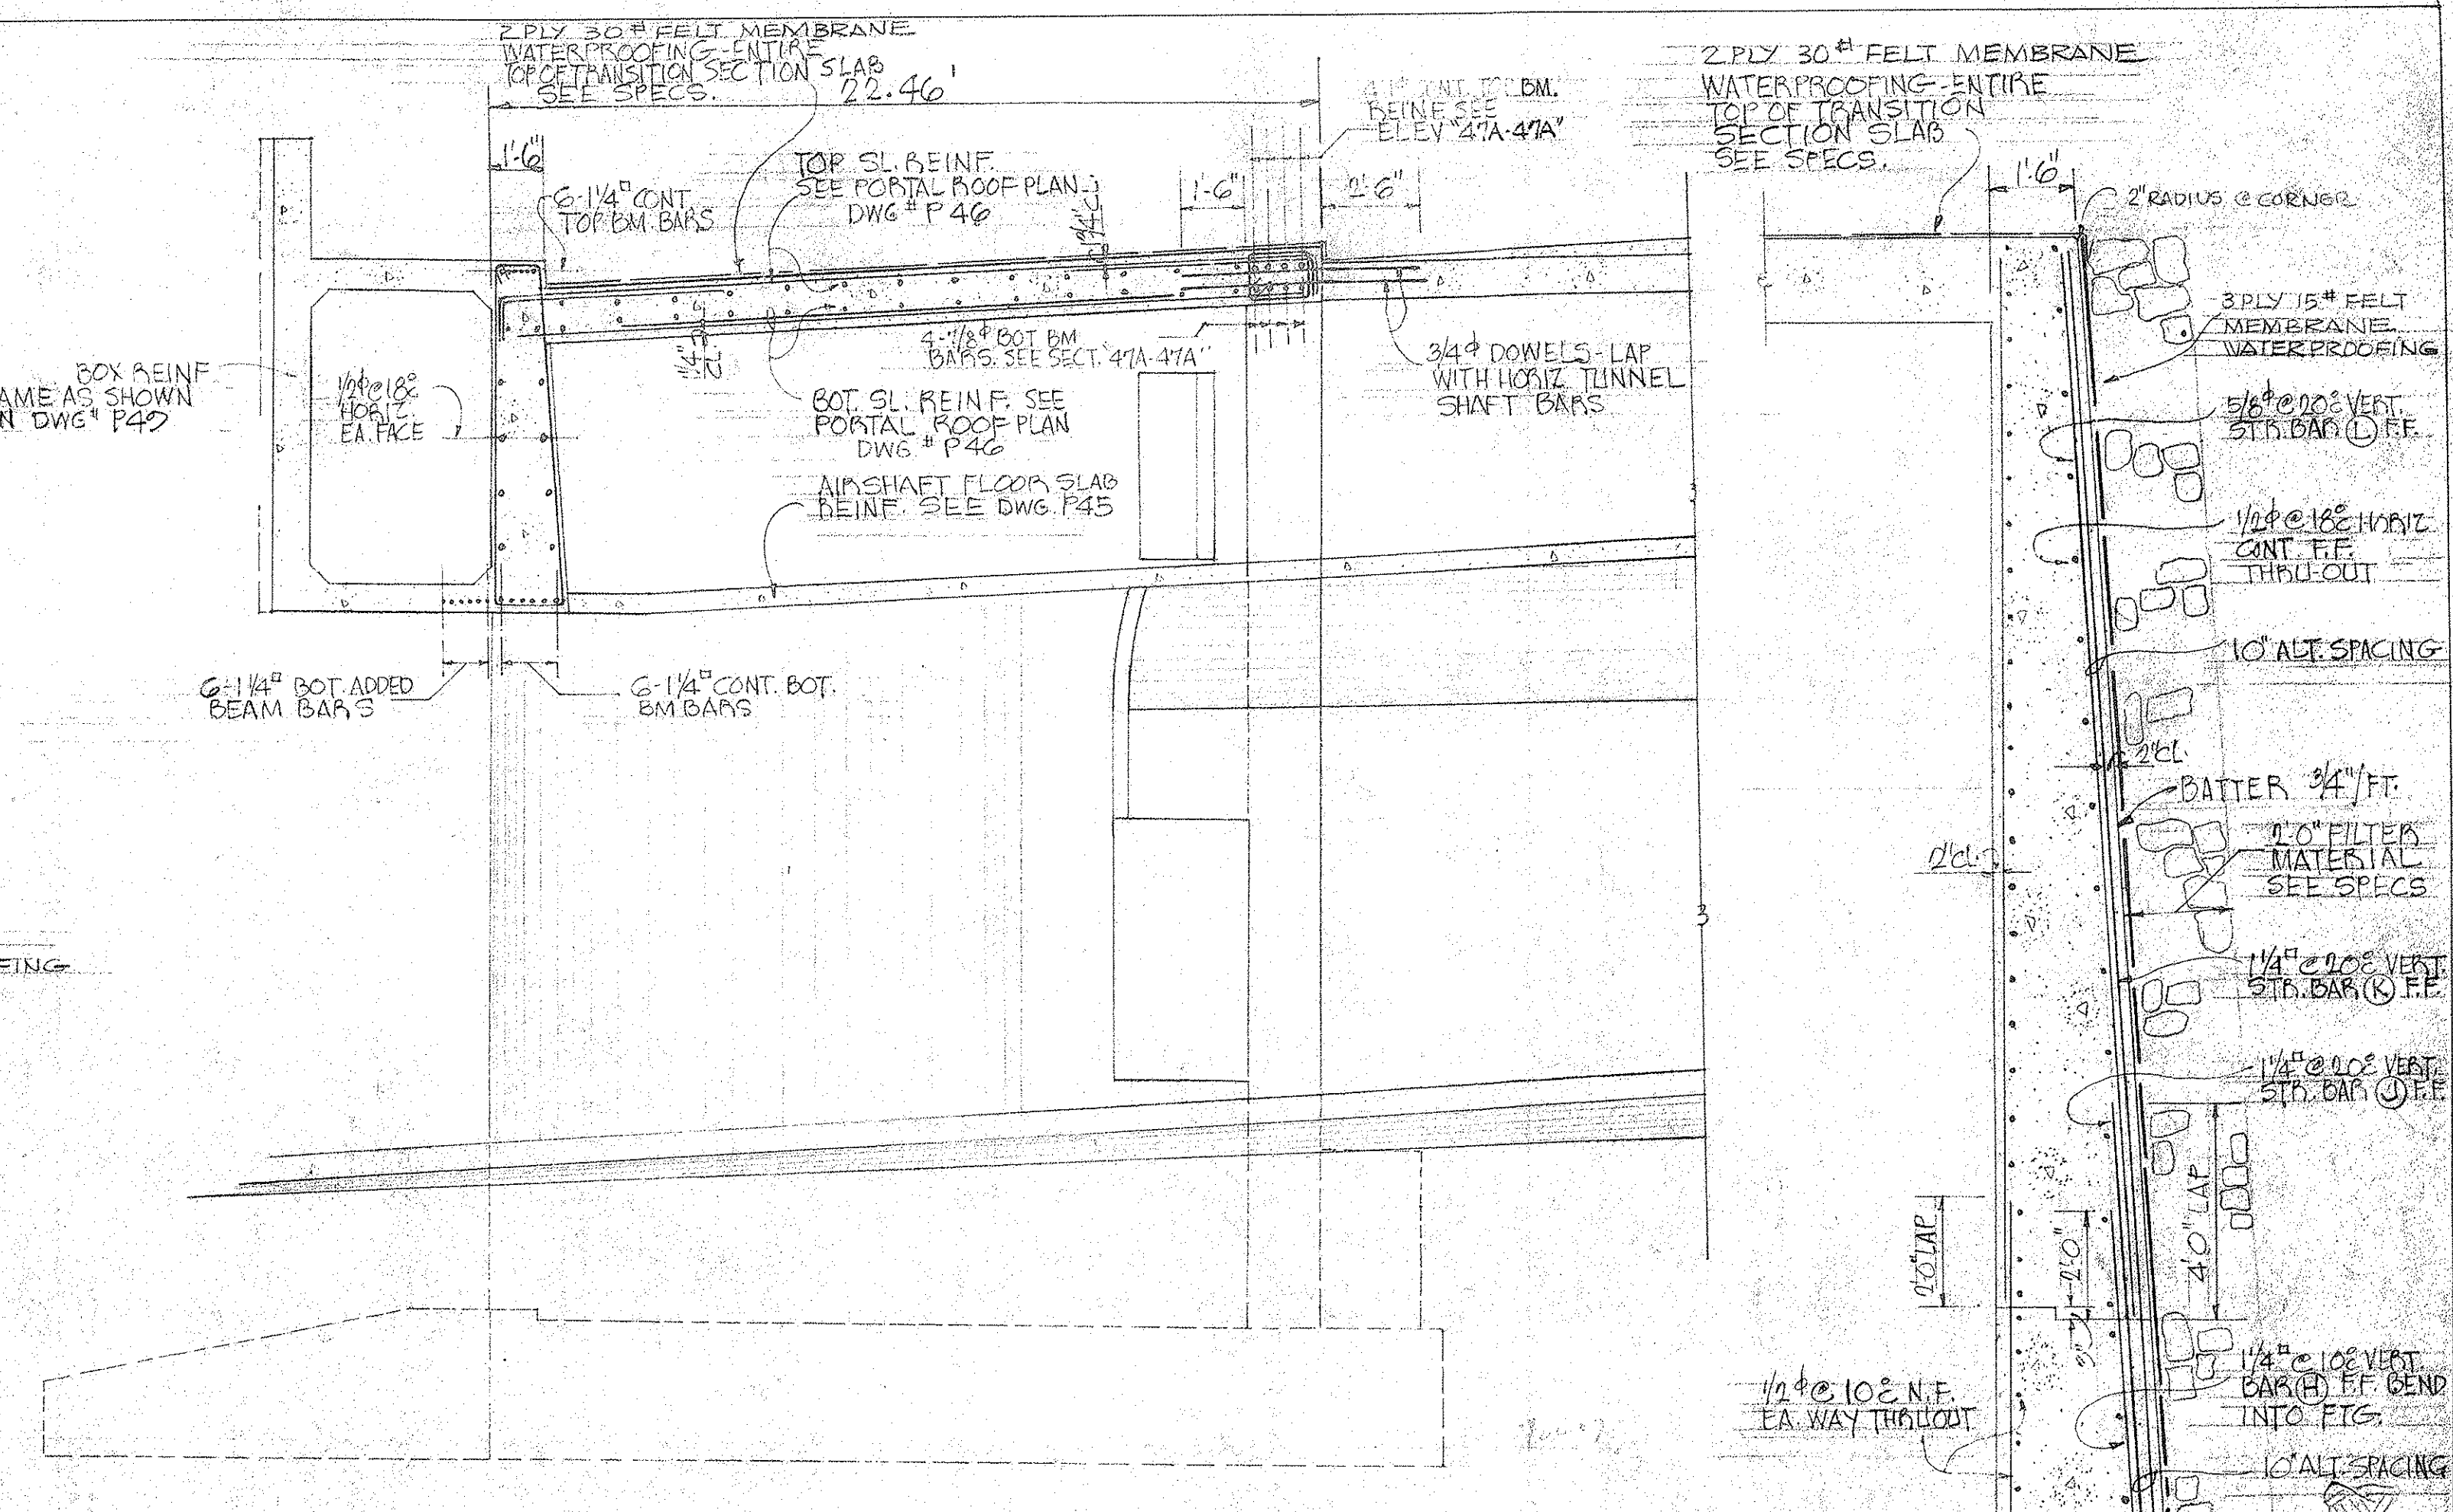
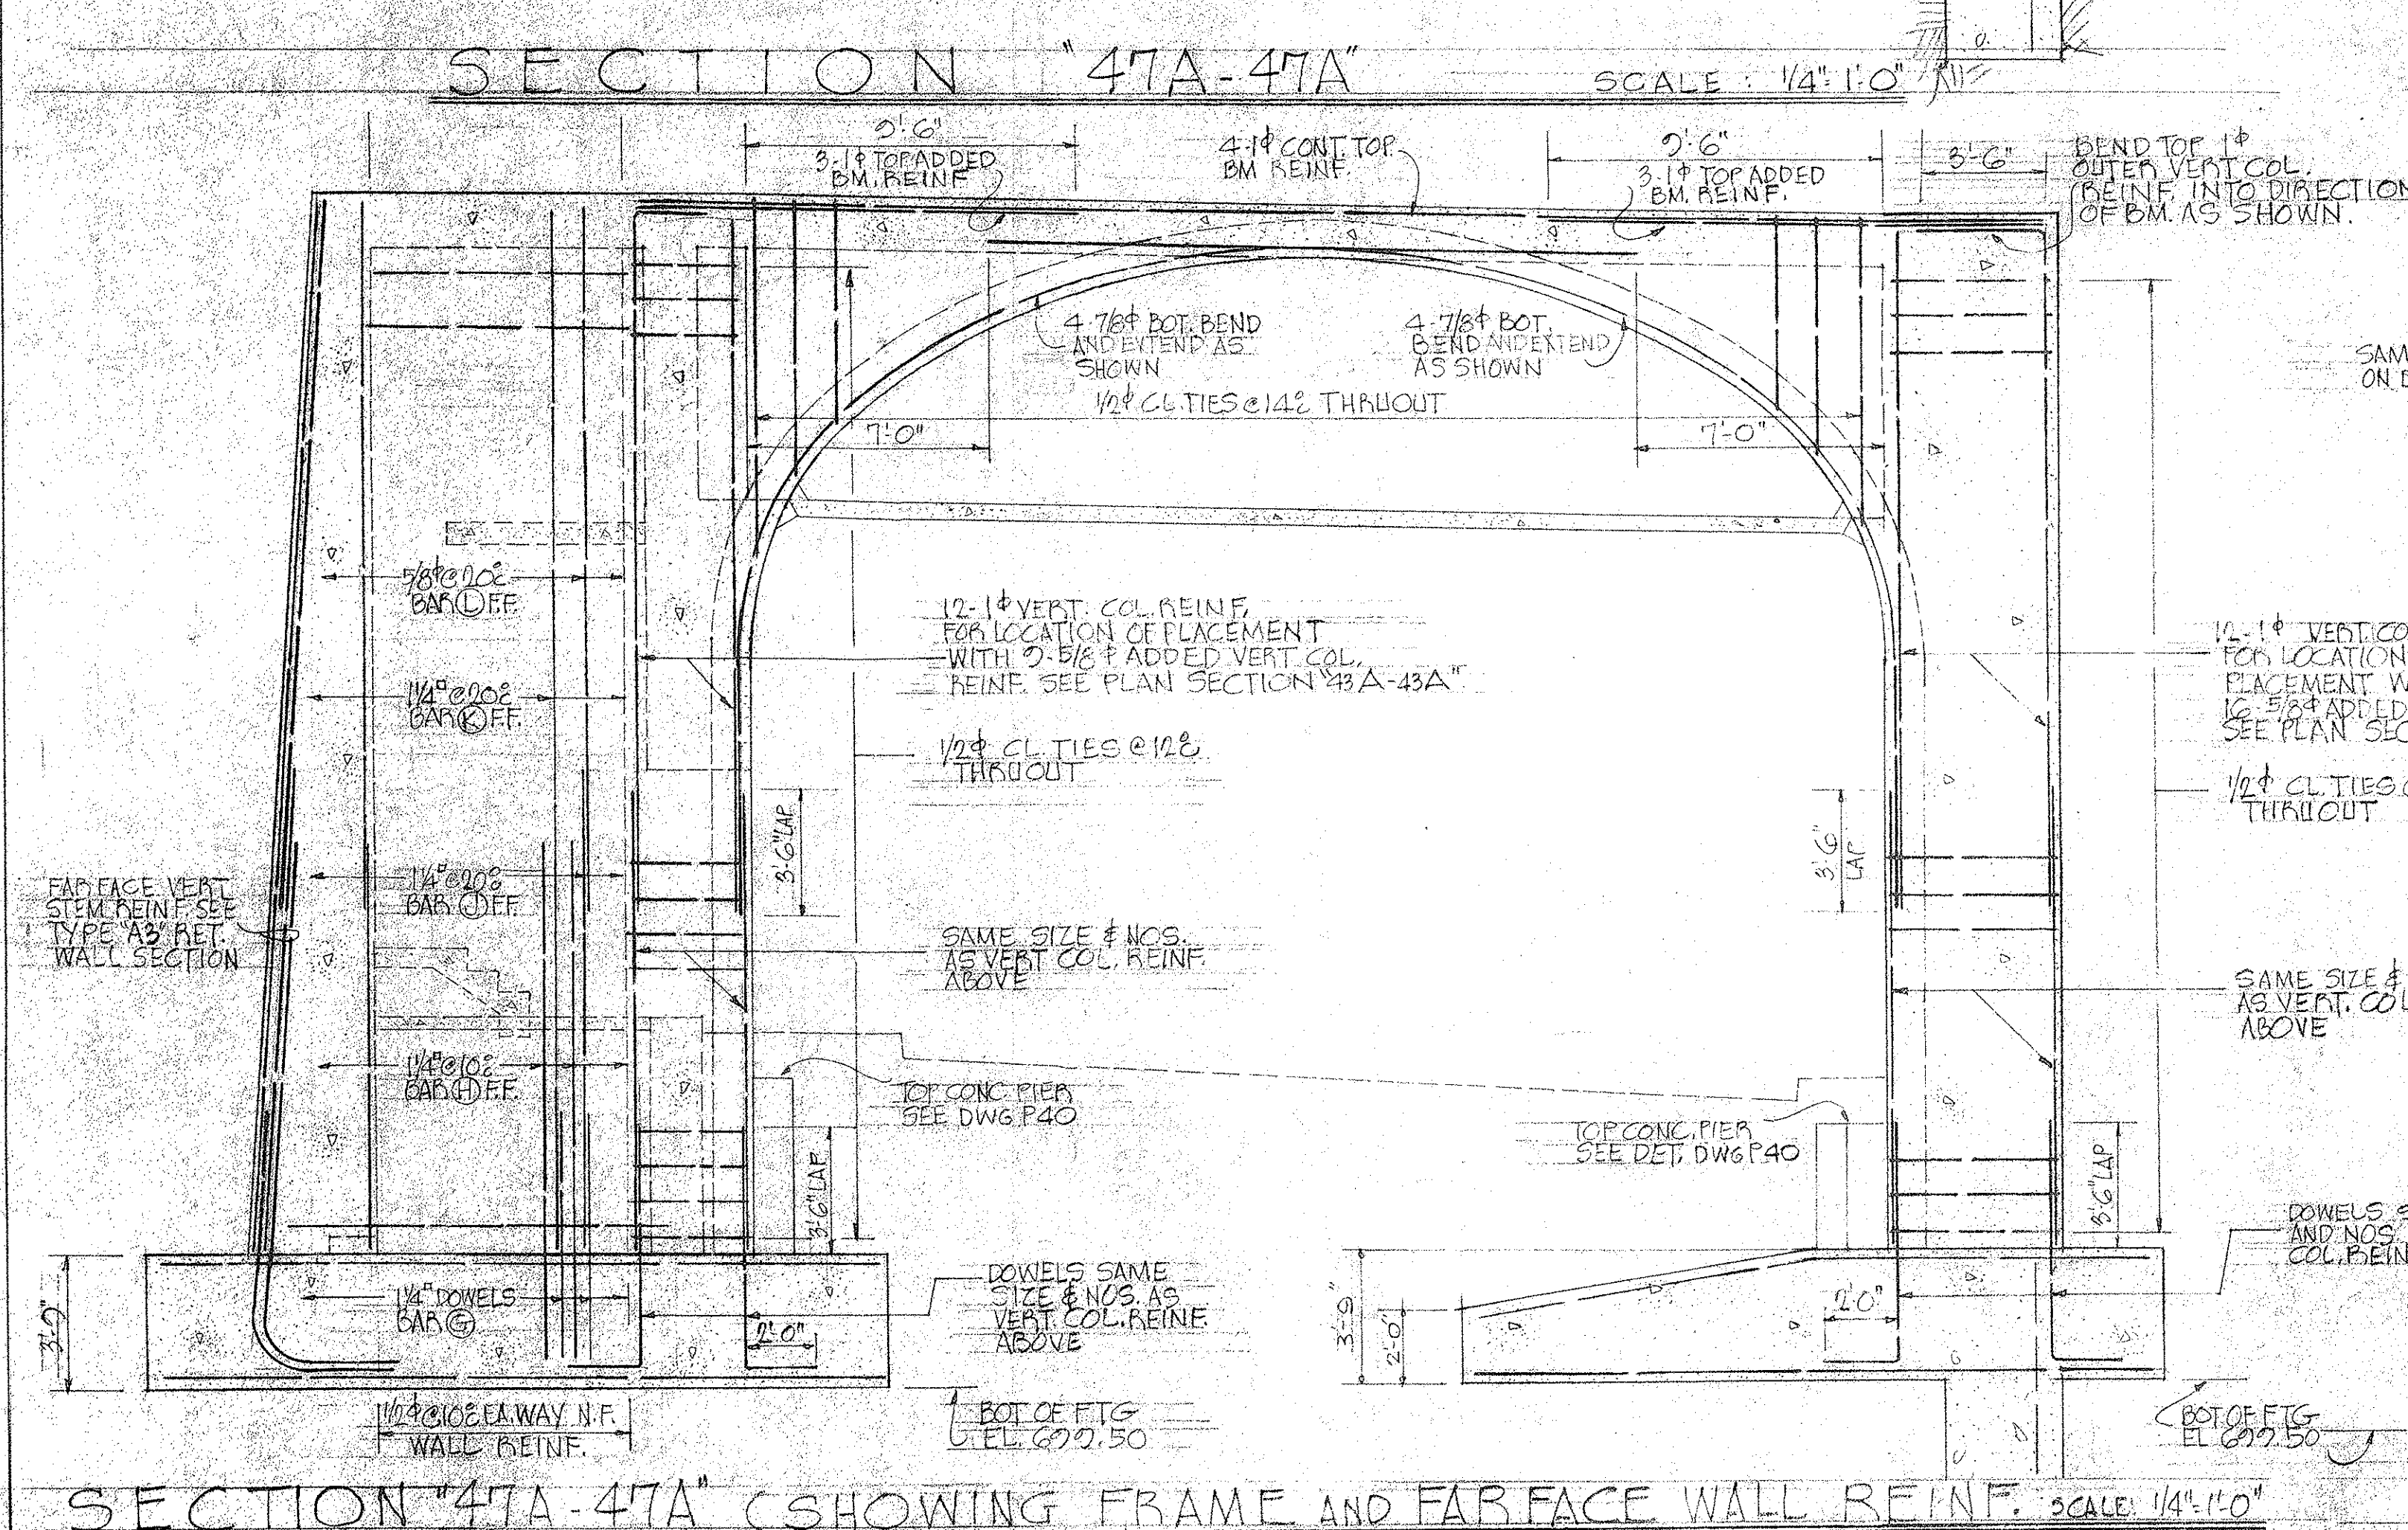


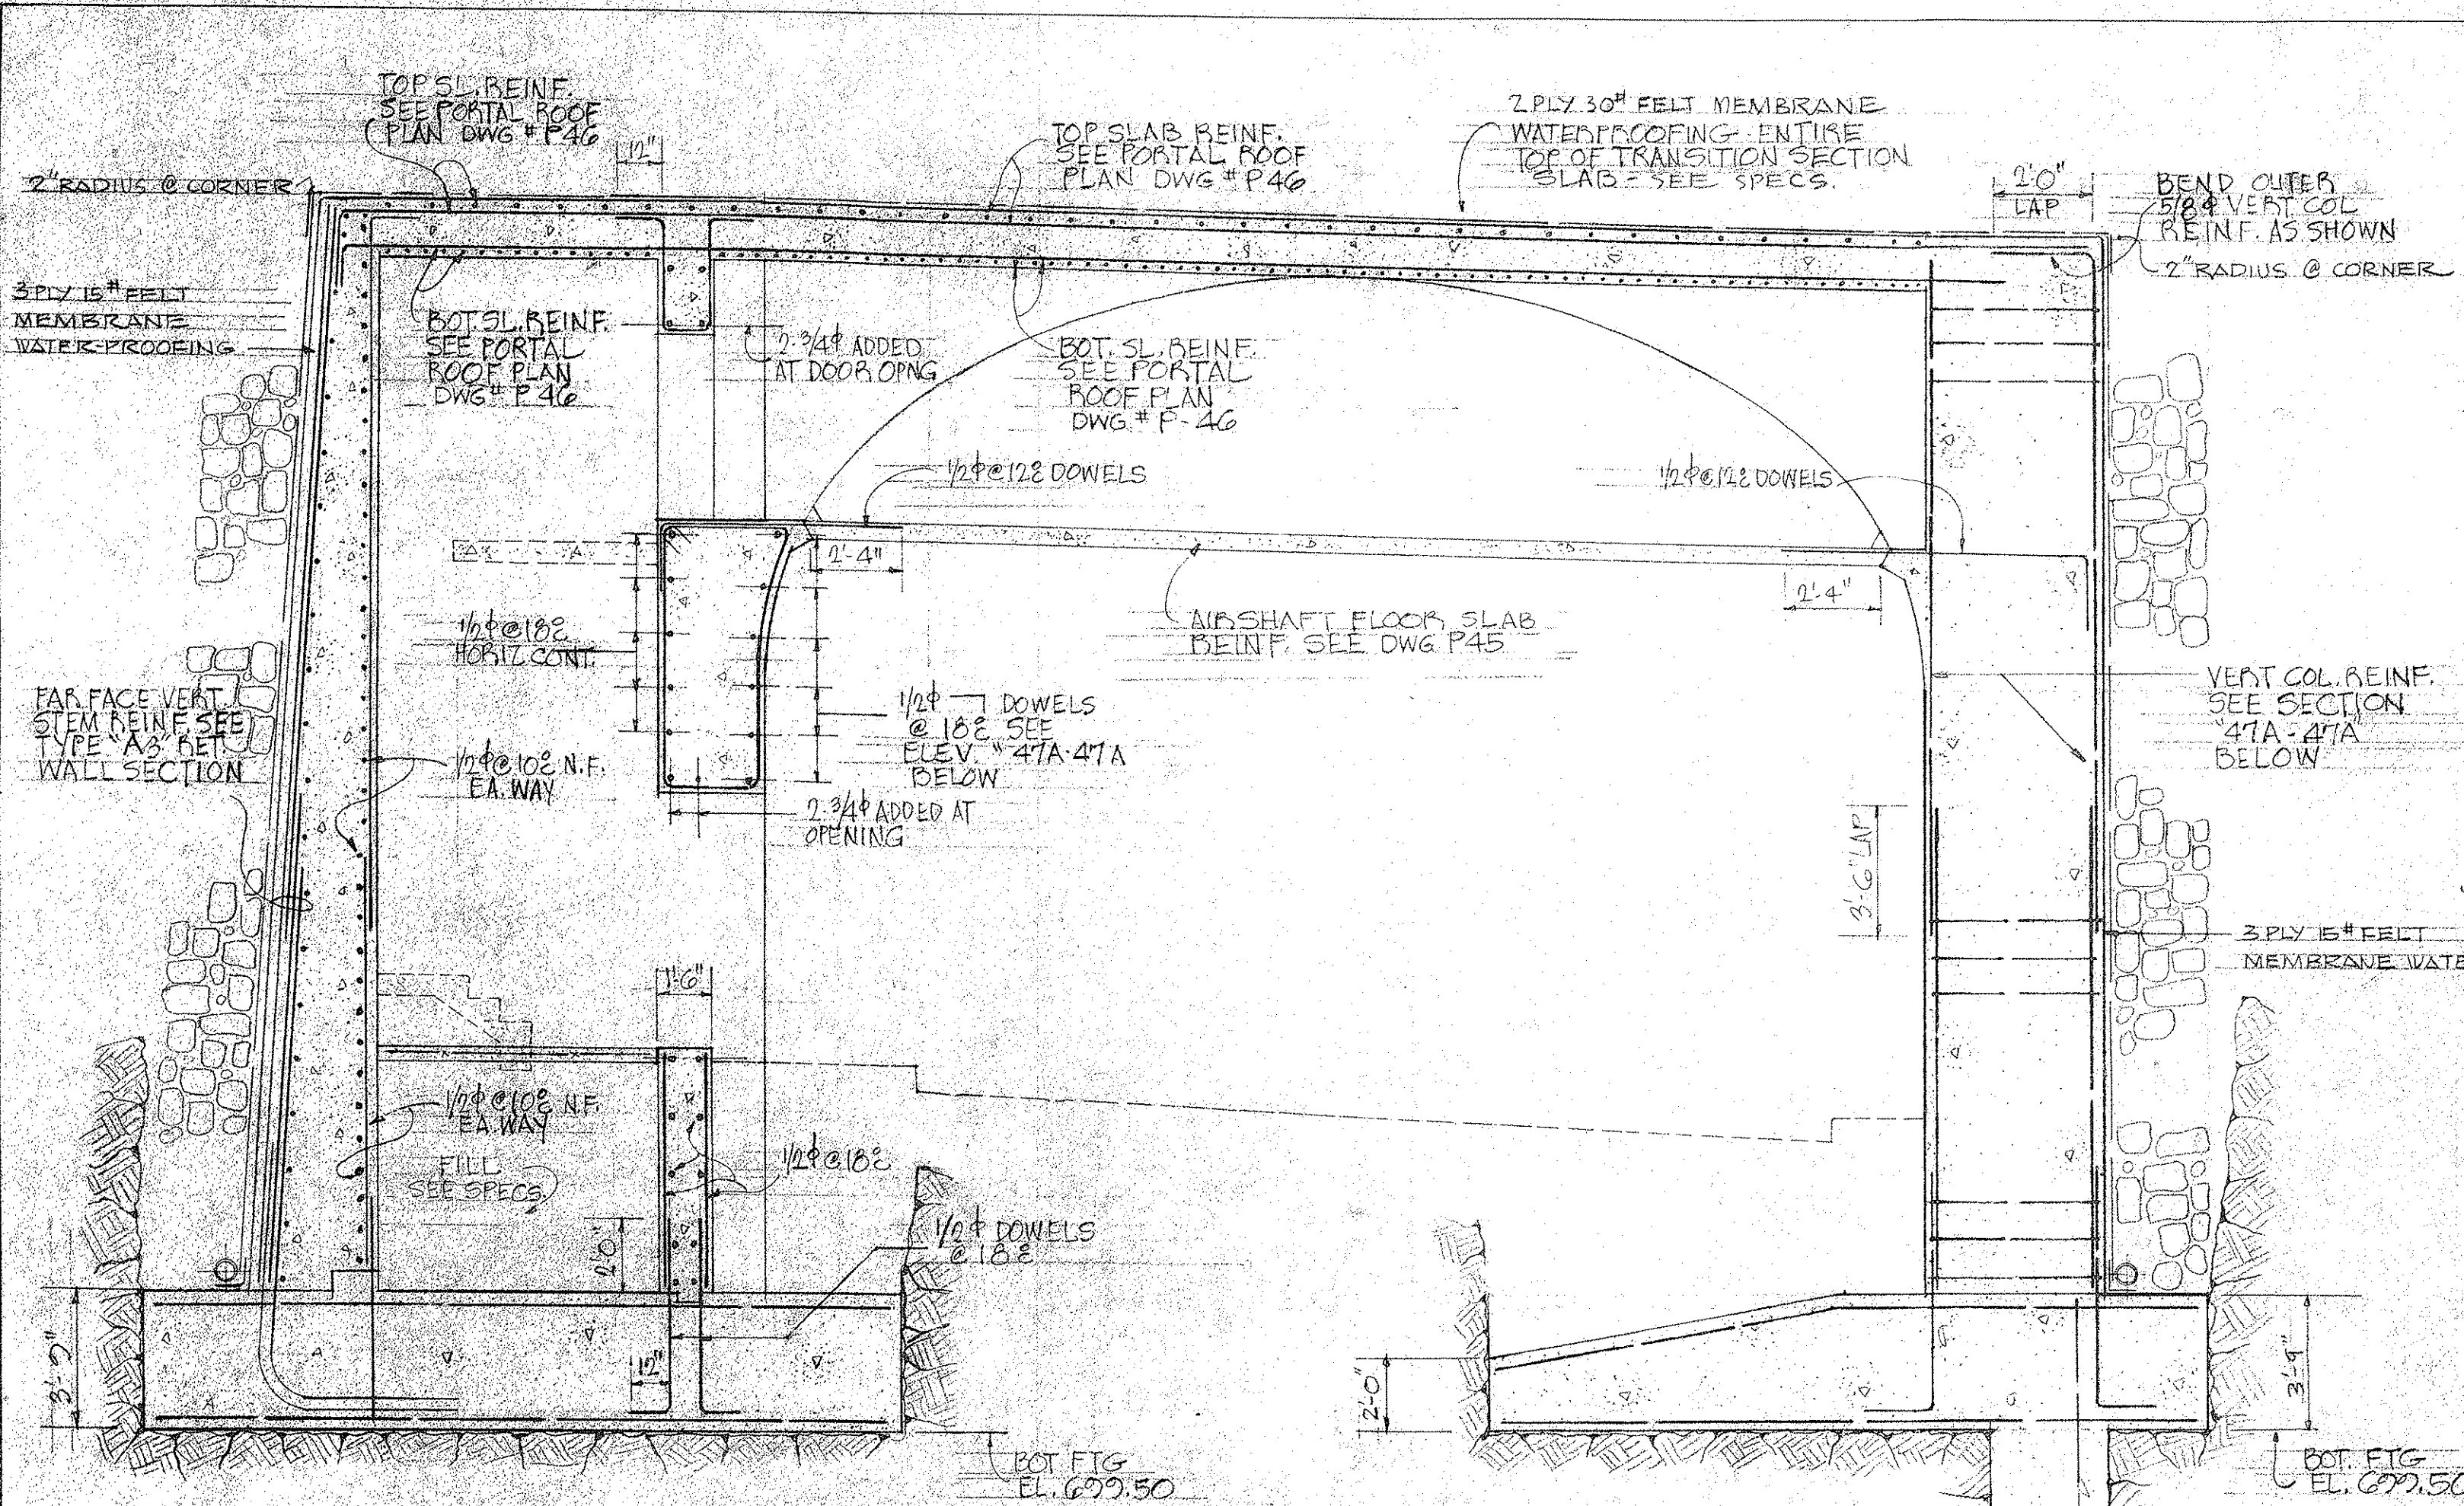

TYPE "A3" RETAINING WALL SECTION SCALE: 3/8" = 1'-0"

LAW & WILSON
ARCHITECTS & ENGINEERS
DEPARTMENT OF PUBLIC WORKS
CITY AND COUNTY OF HONOLULU
BUREAU OF PLANS

KALIHI TUNNEL KANE OHE PORTAL-STRUCTURAL TUNNEL ENTRANCE SECTIONS

ENGINEER: L. B. W. / D.L. DATE: JULY 15, 1983
DRAFTSMAN: J.Y. CHECKED BY: J. [Signature]
SCALE: AS NOTED TRACER: [Signature]
APPROVED: [Signature] CHIEF ENGINEER
APPROVED: [Signature] BUREAU ENGINEER

W. S.	CR. SEC.	W. M. BY:	PROFILE	F. B.	F. W. BY:	C. B.	S. B.	S. BY:

SECTION C JOB NO. 26-53 DWG. P-47