




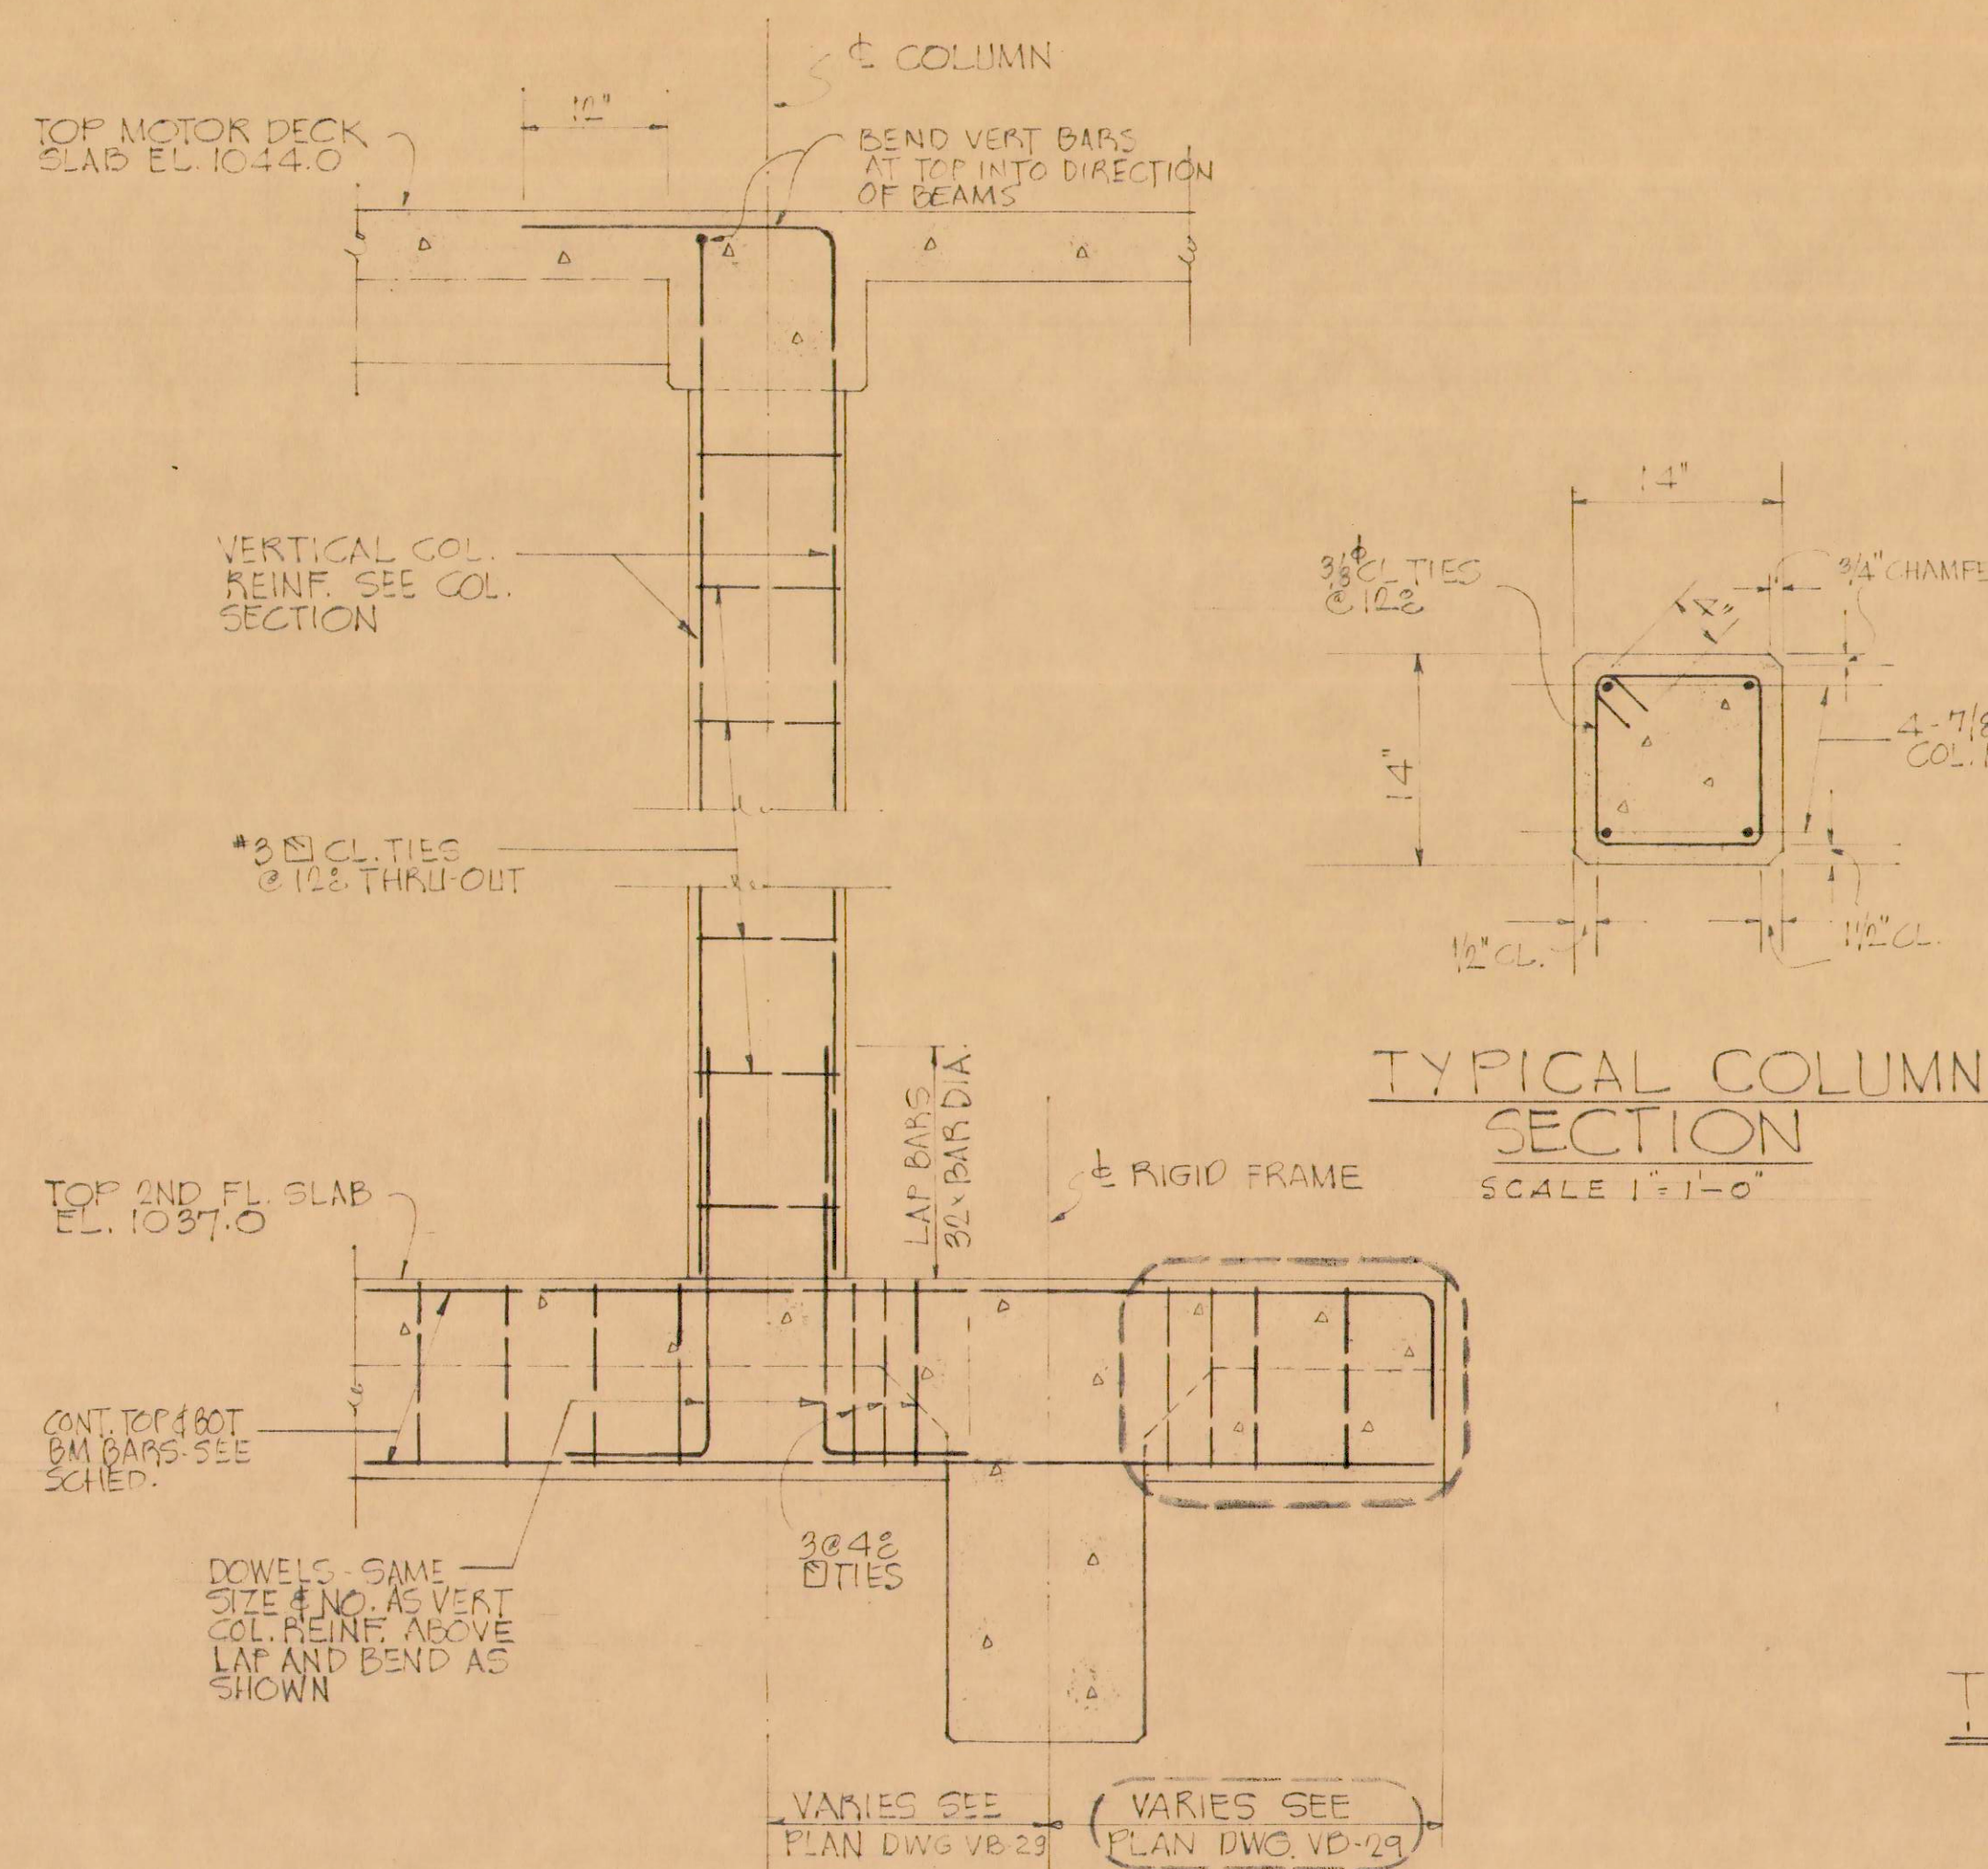



TYPICAL CONC. COLUMN DETAILS
FOR LOCATION OF CONC. COLUMNS SEE DWG. VB-29

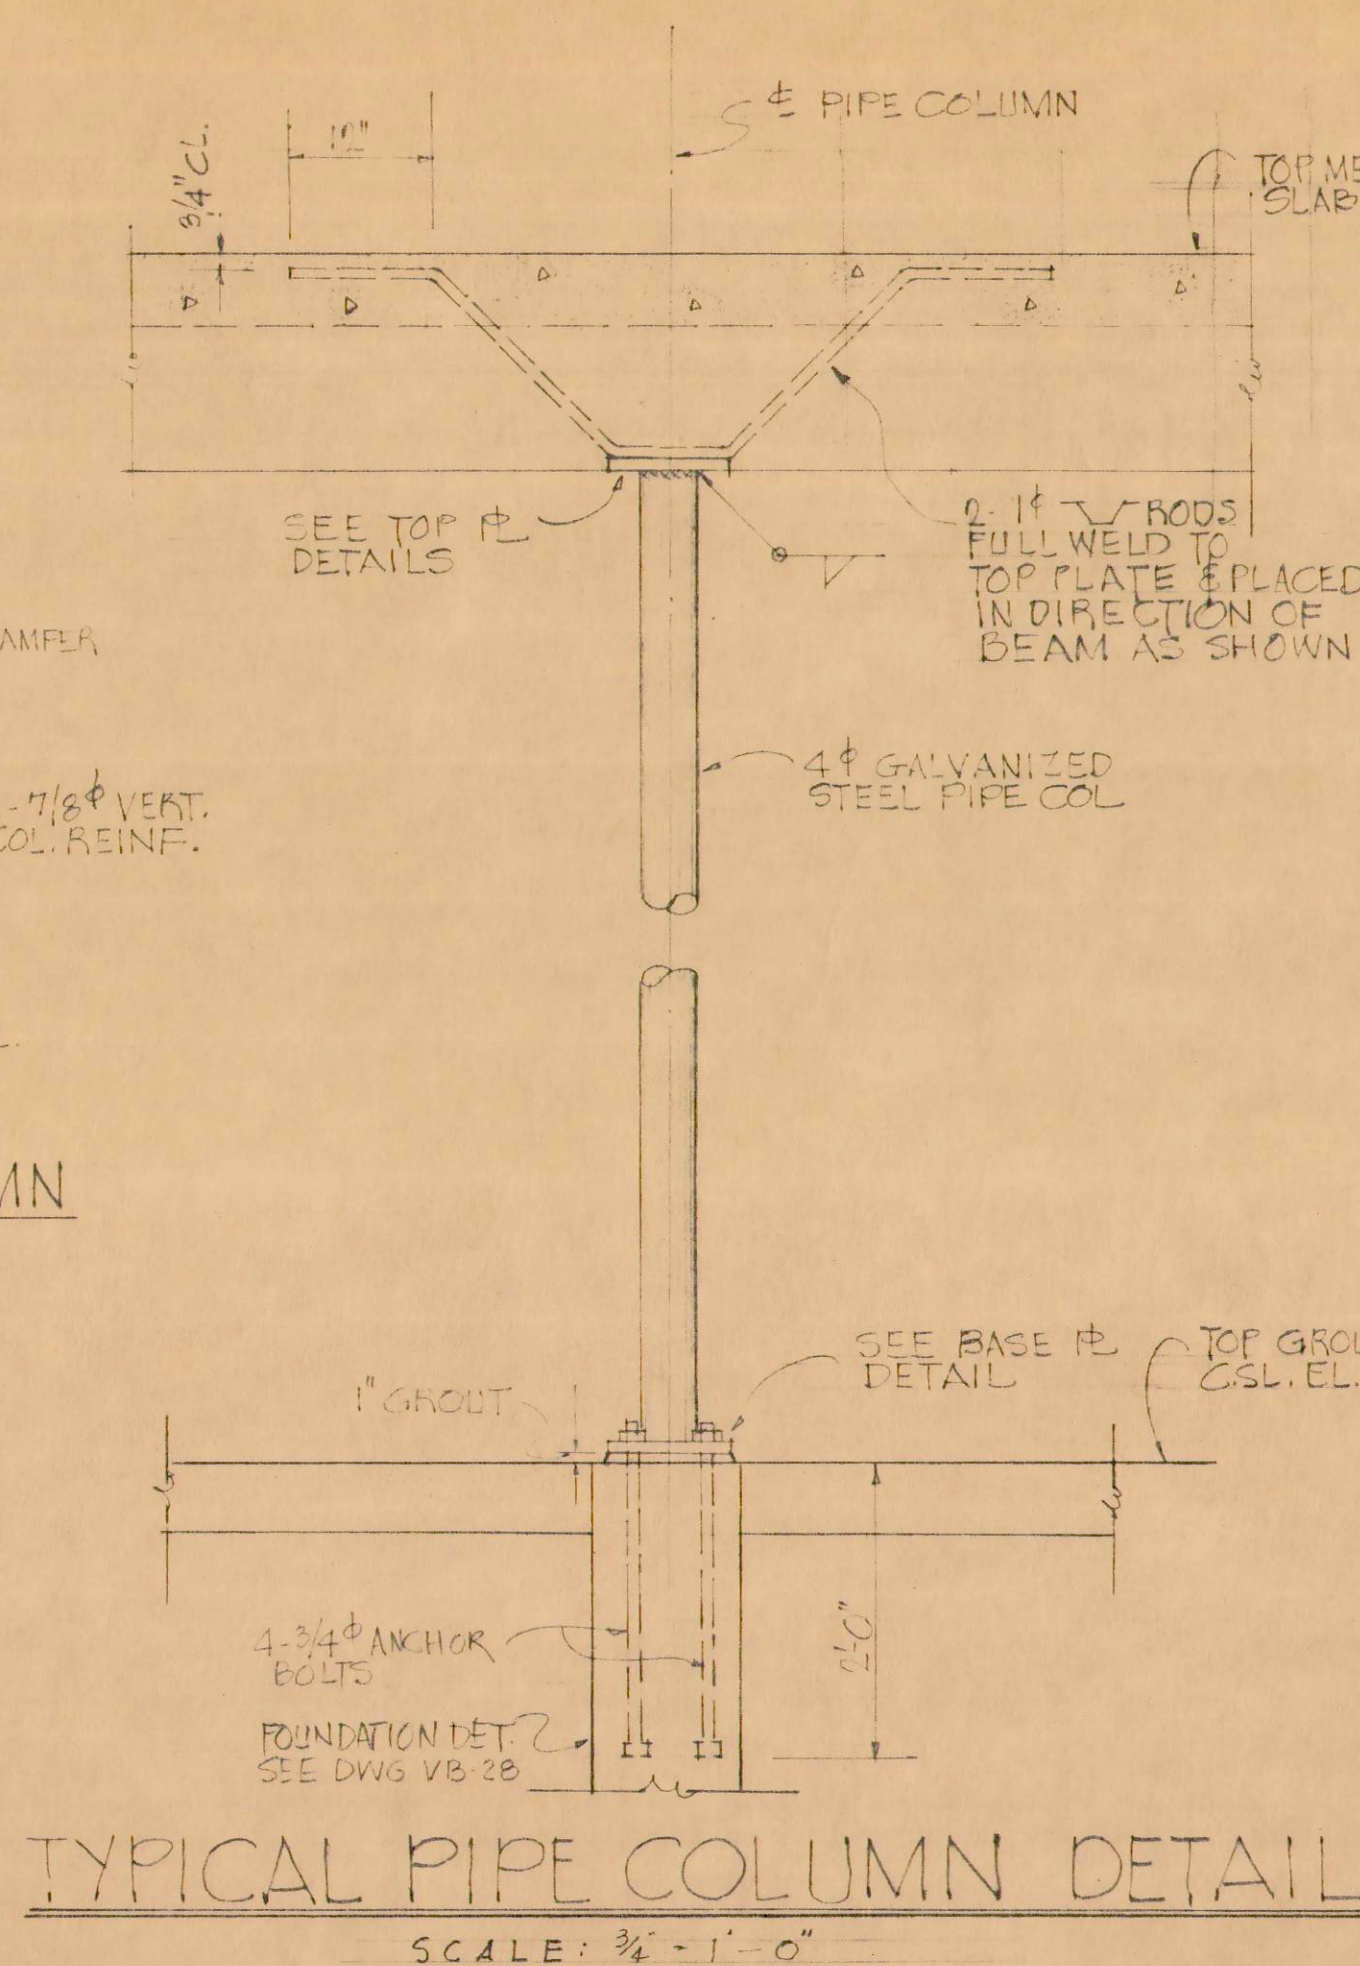

TYPICAL PIPE COLUMN DETAIL
SCALE: 3/4" = 1'-0"

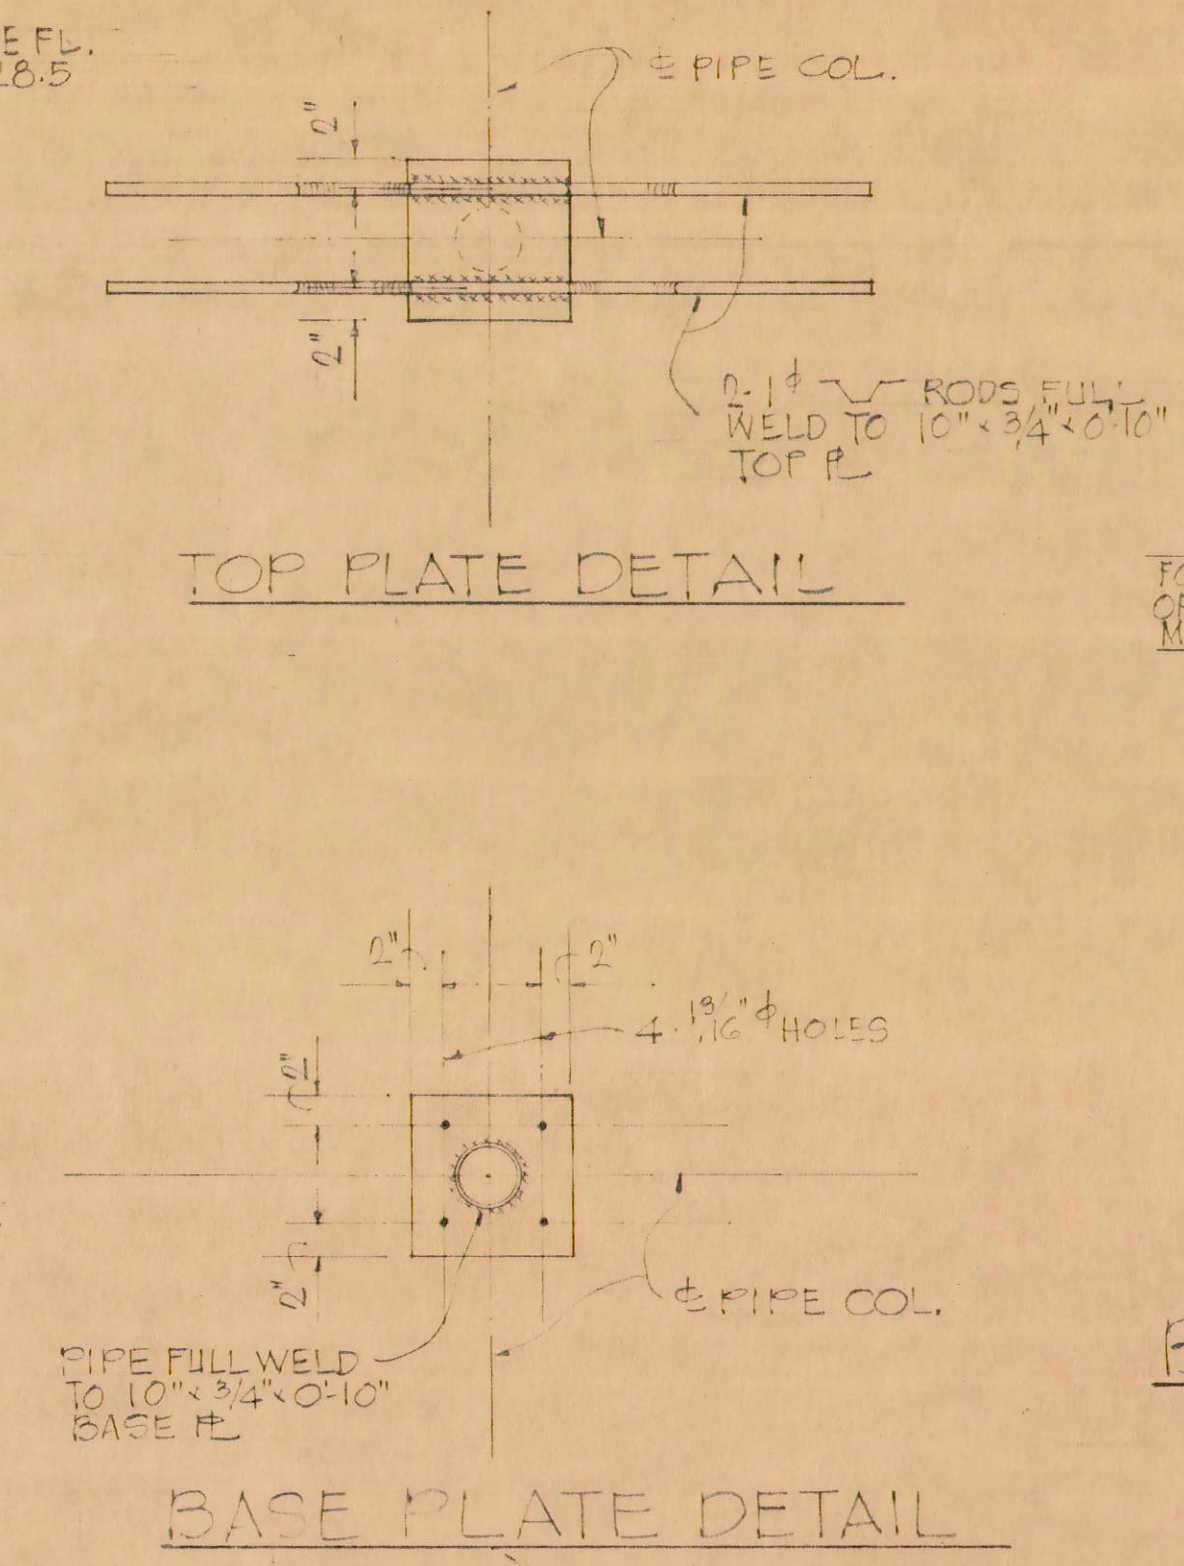

TYPICAL PIPE COLUMN CONNECTION DETAILS
SCALE: 1" = 1'-0"

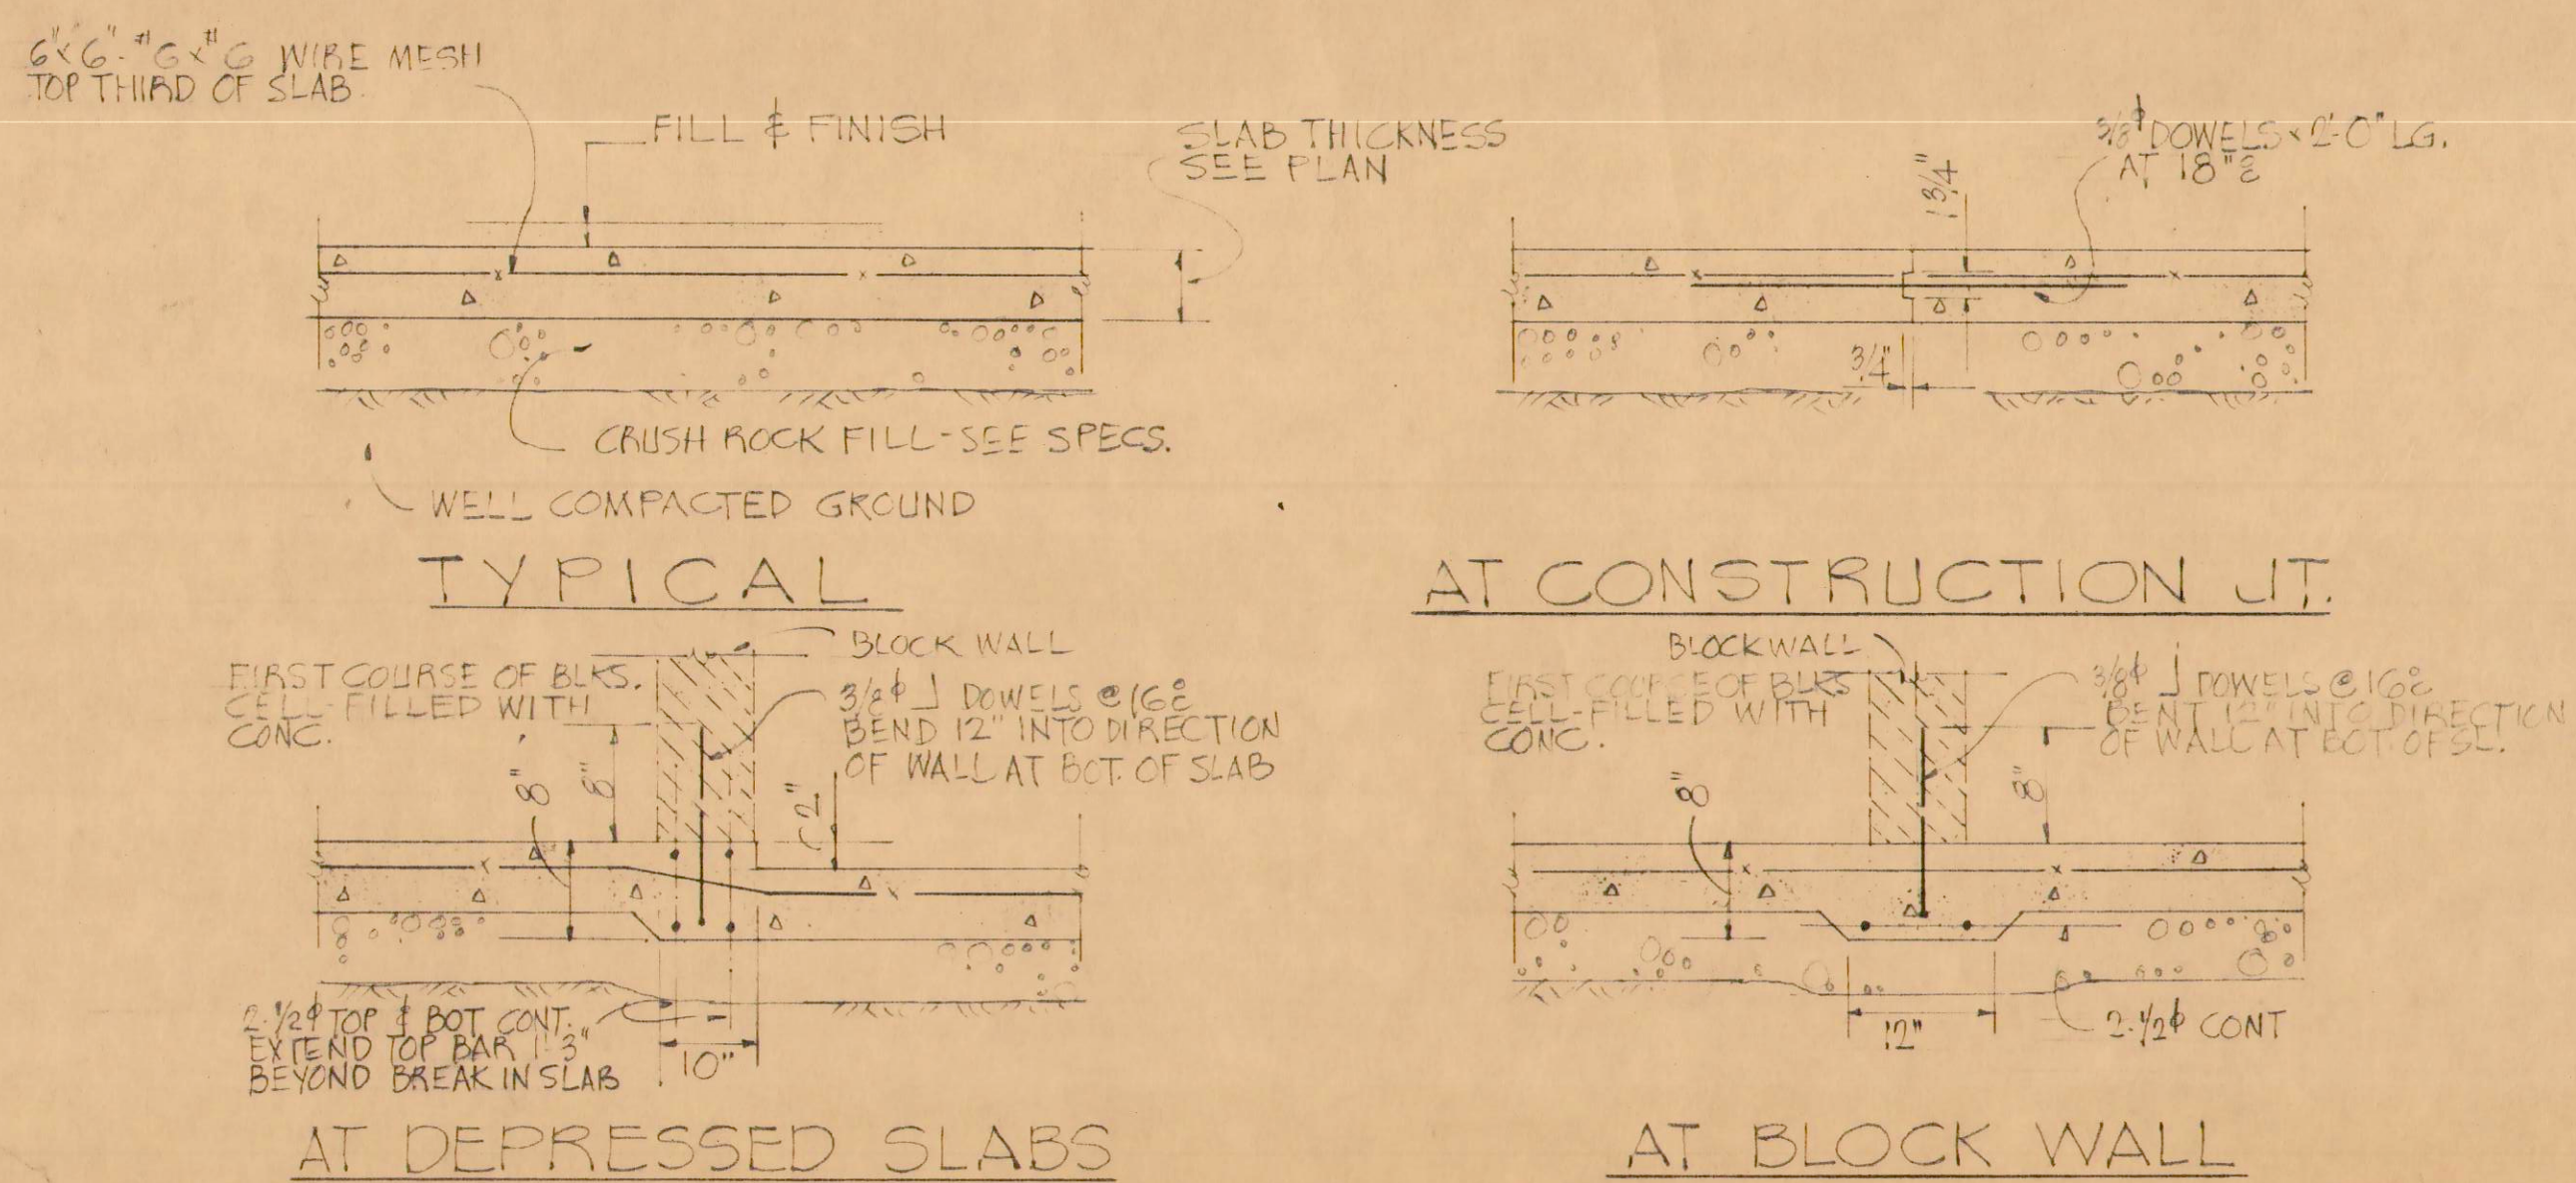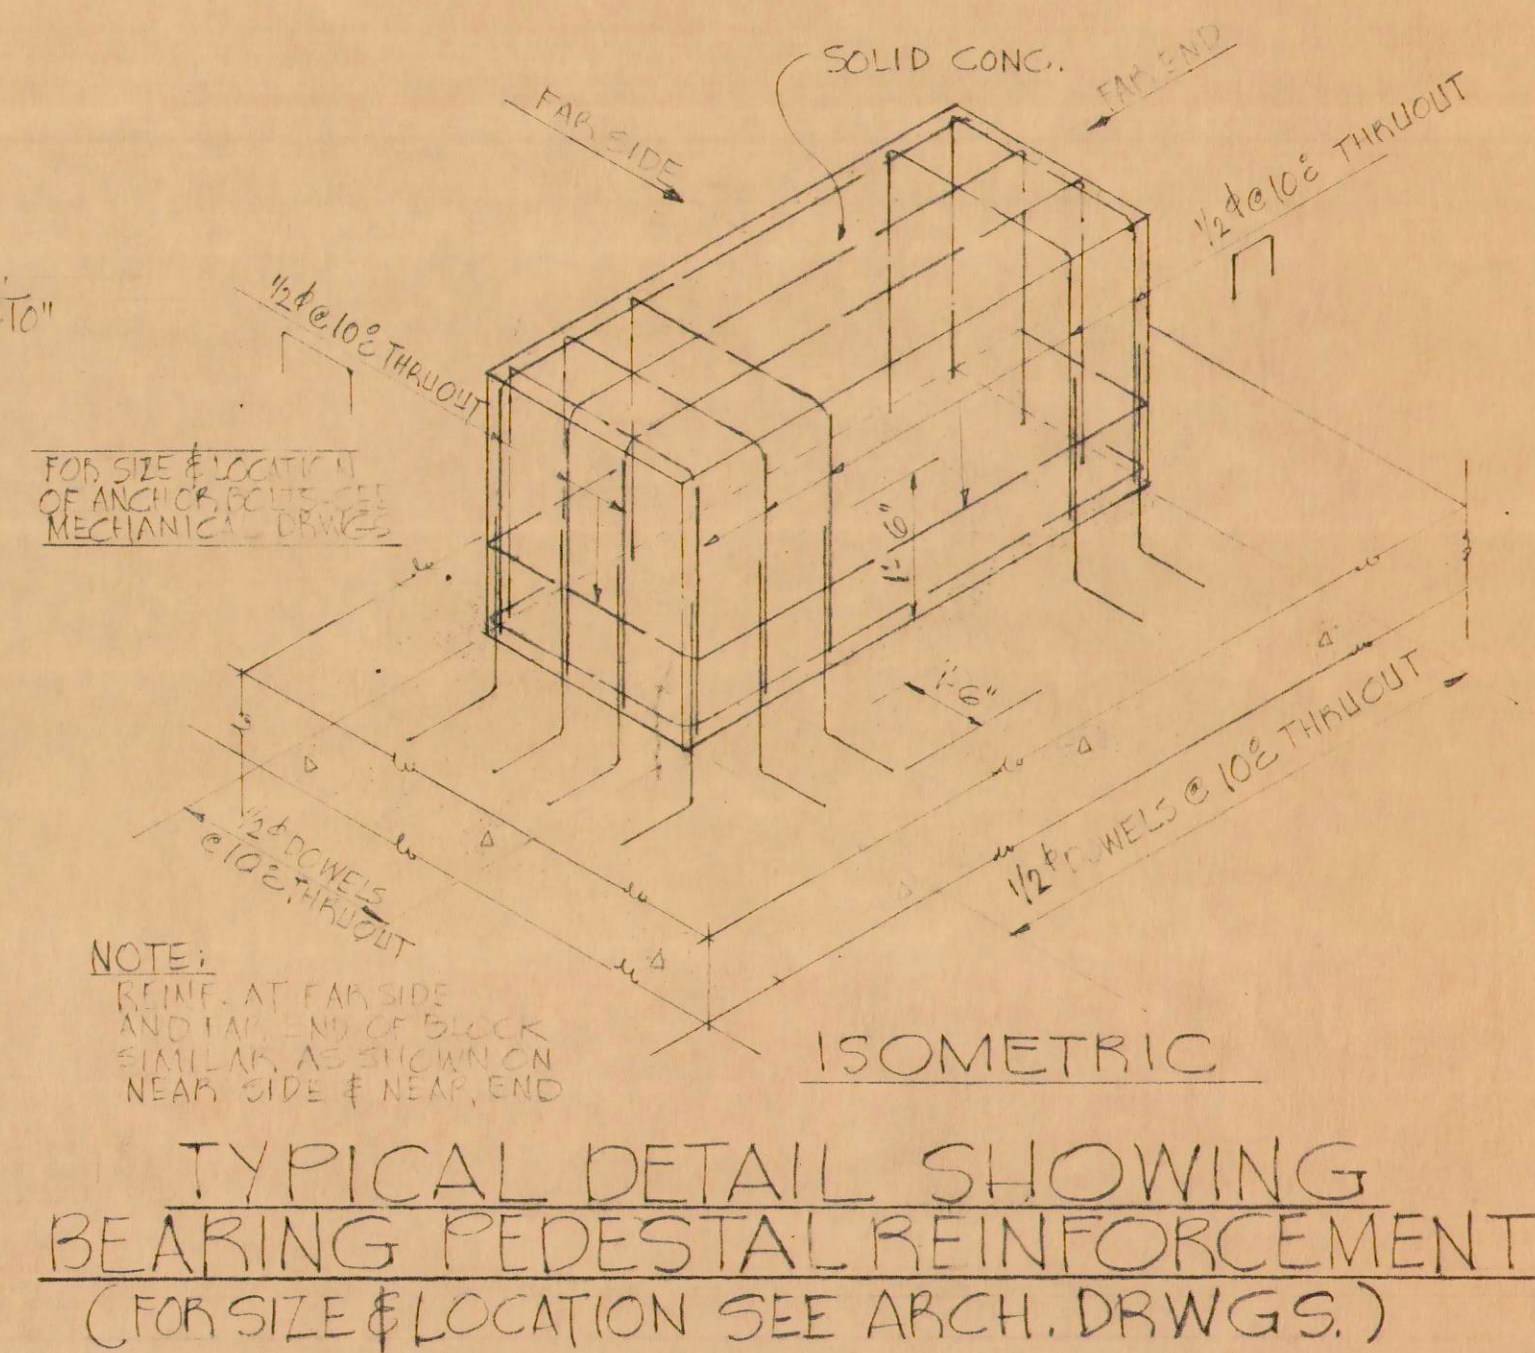

TYPICAL DETAILS OF SLABS ON FILL
SCALE: 3/4" = 1'-0"

1	4-10-50	STRUCTURAL DETAILS	E.W.	80
REVISION	DATE	DESCRIPTION	MADE BY	CHK BY
LAW & WILSON ARCHITECTS & ENGINEERS DEPARTMENT OF PUBLIC WORKS CITY AND COUNTY OF HONOLULU BUREAU OF PLANS KALIHI TUNNEL VENTILATION BLDG.-STRUCTURAL TYPICAL DETAILS ENGINEER: L.W./D.L. DATE: 4-15-53 DRAFTSMAN: F.C. CHECKED BY: D.L. [Signature] SCALE: AS NOTED TRACER: [Signature] APPROVED: [Signature] CHIEF ENGINEER APPROVED: [Signature] BUREAU ENGINEER W.S. PROFILE C.B. CR. SEC. P.B. S.B. W.M. BY. S. BY.				
SECTION C		JOB NO. 26-53		DWG. VB-34