



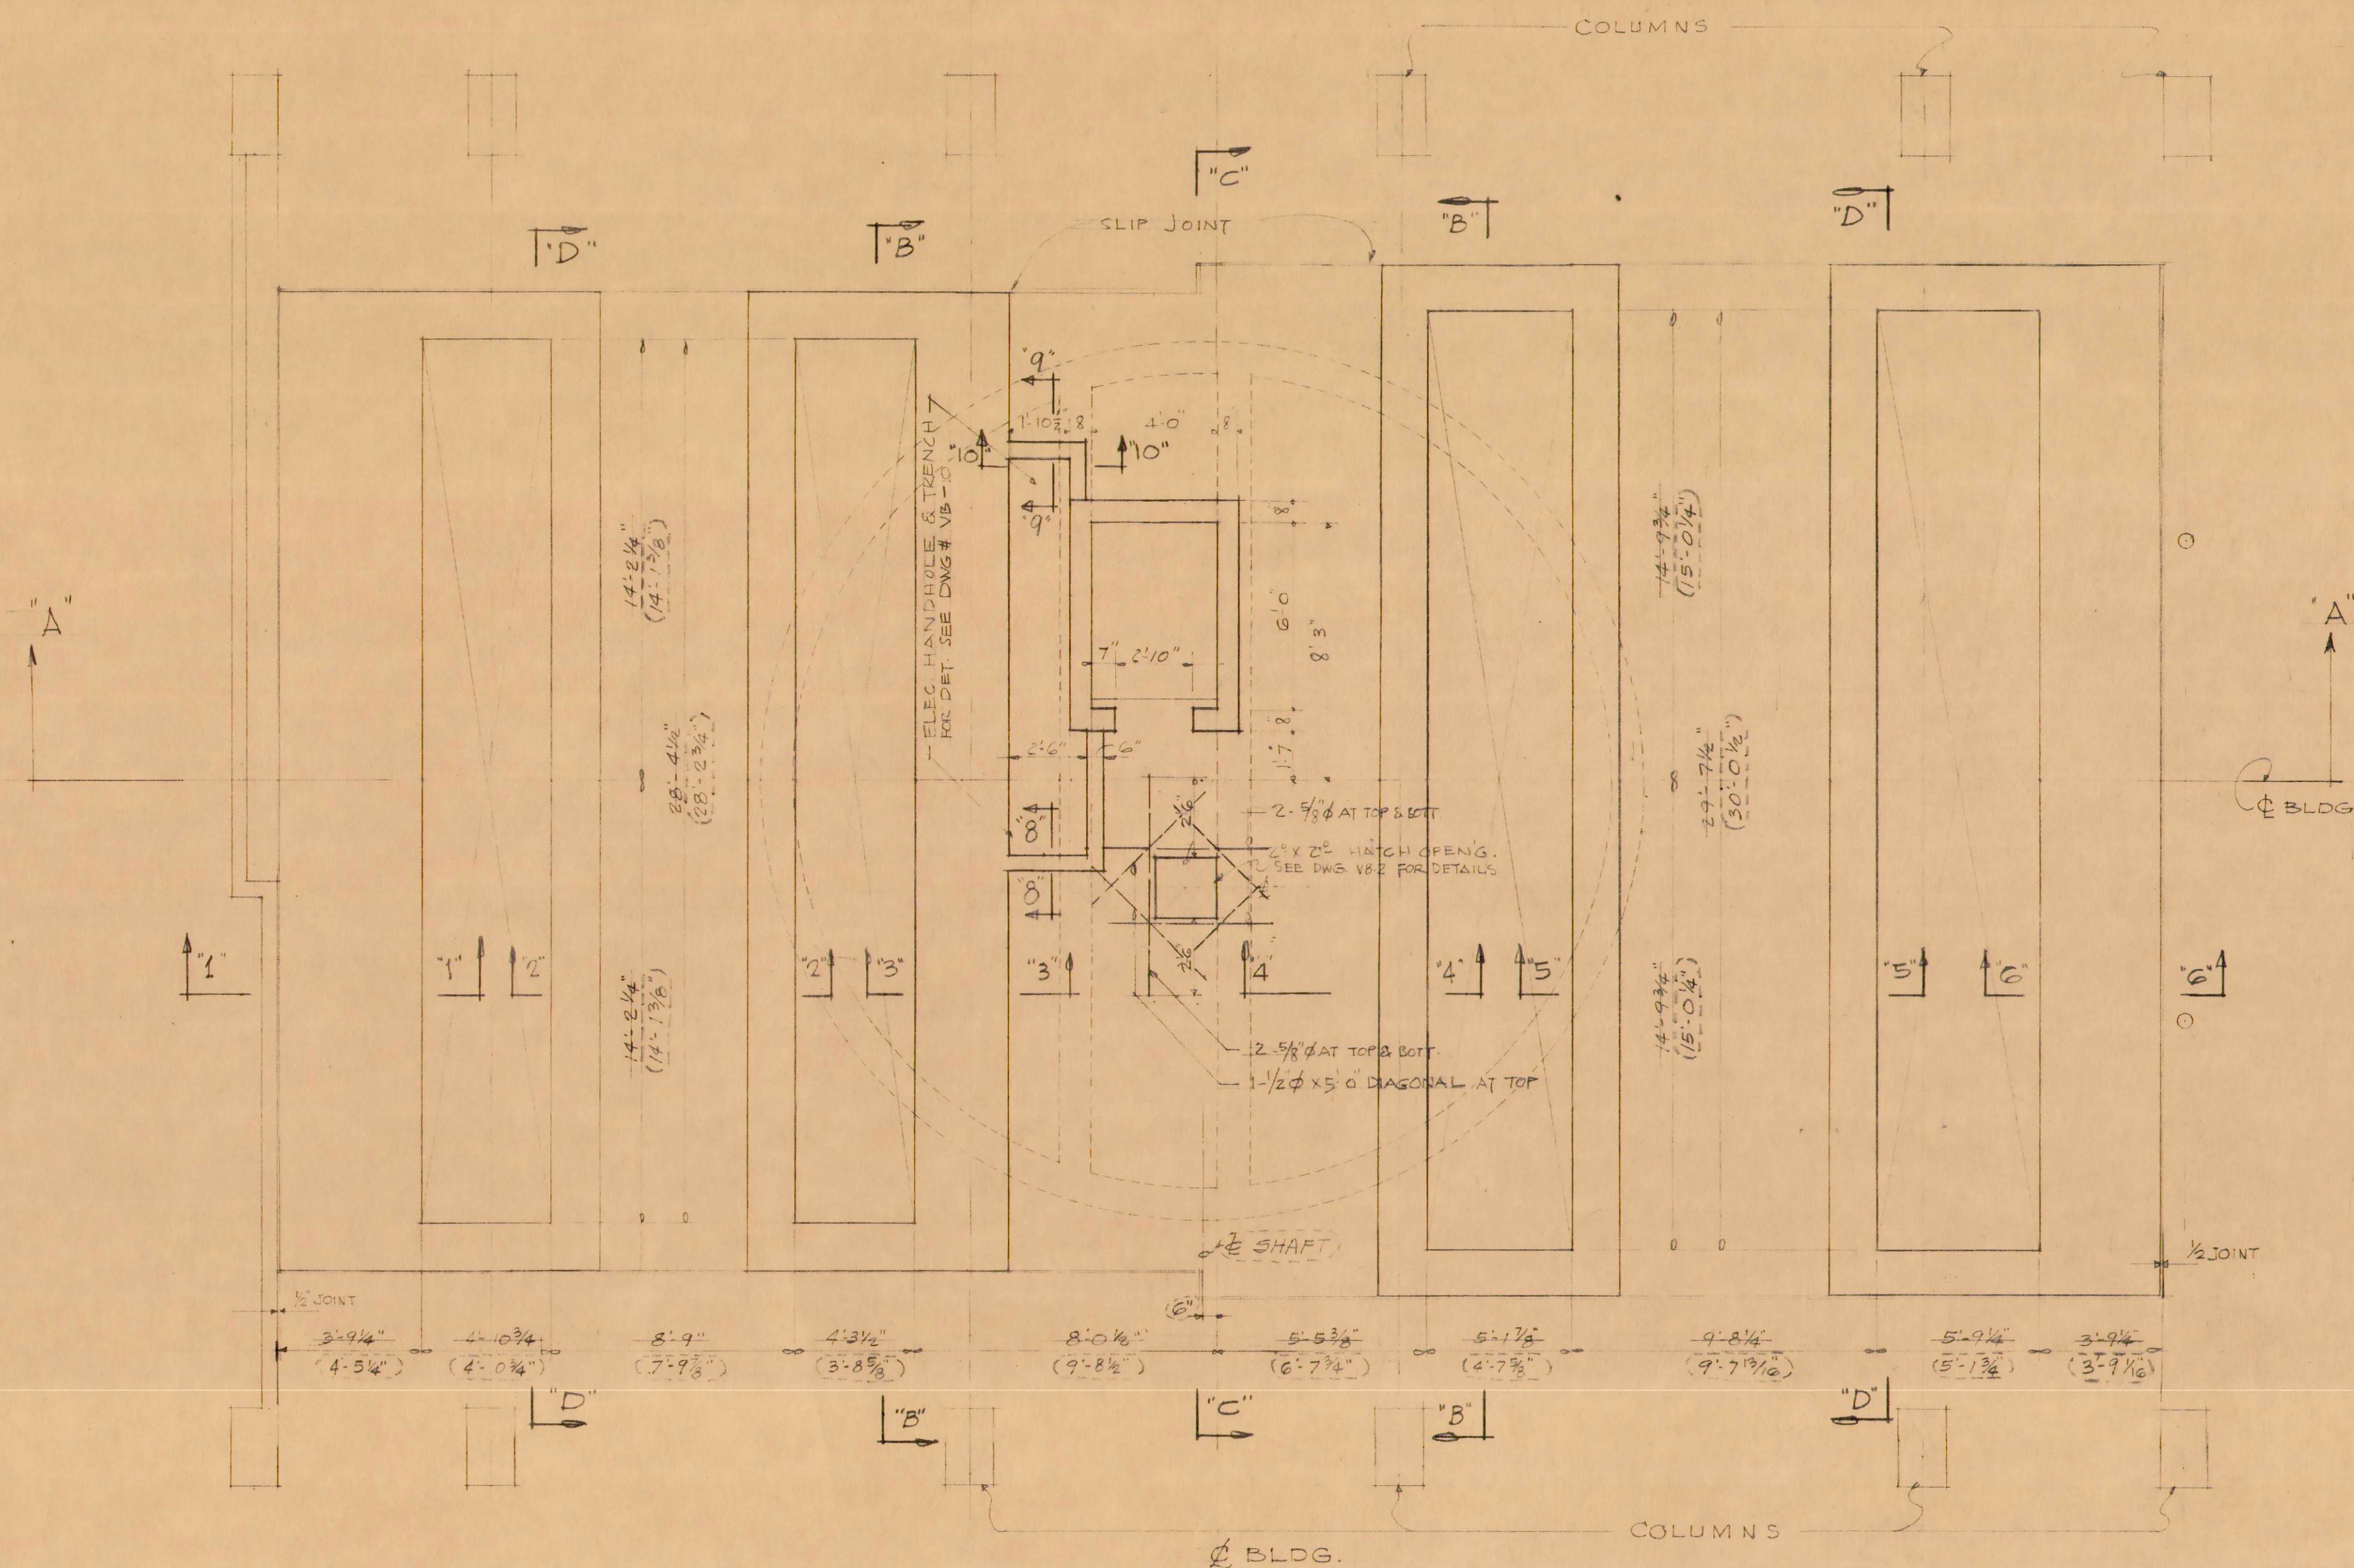

PLAN OF VENT SHAFT AT GR FL. (ELEV. 1020.0)

SCALE: 1/4" = 1'-0"










NOTES: FOR PLAN OF SHAFT AT JUNCTION FLARE SEE DWG. # 7-37 (SECTION F-F)
 FOR ARCHT DET. OF ELEC. HANDHOLE & TRENCH SEE DWG. # VB-10
 FOR FLANGE ANGLES AT RIM OF VENT SHAFT OPENINGS, SEE DWG. VB-21

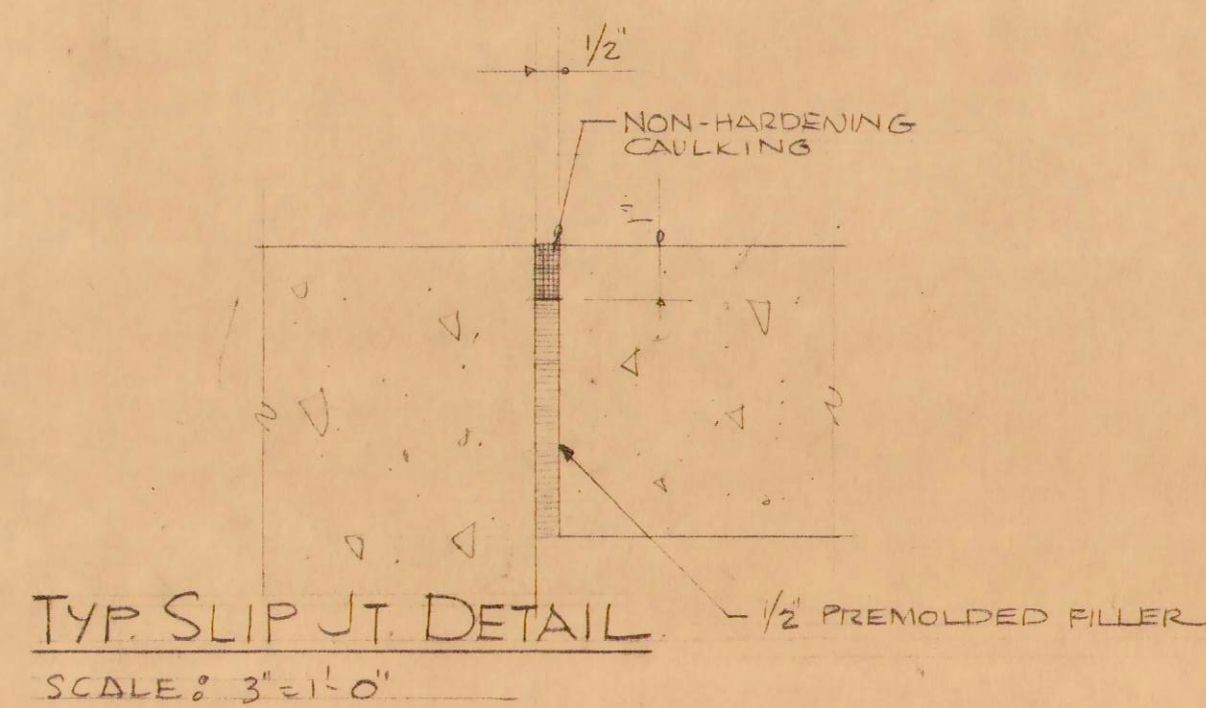

SUPERCEDED
 see DWG VB-23A
 7-20-56

1	4-16-56	RELOCATED OPENINGS & EQUIPMENT	E.W.	10
REVISION	DATE	DESCRIPTION	MADE BY	CHK BY
LAW & WILSON ARCHITECTS & ENGINEERS DEPARTMENT OF PUBLIC WORKS CITY AND COUNTY OF HONOLULU BUREAU OF PLANS KALIHI TUNNEL VENTILATION BLDG. - STRUCTURAL VENT FLARE - PLANS ENGINEER: L.W. / D.L. DRAFTSMAN: T.F. SCALE: AS NOTED DATE: JULY 15, 1956 CHECKED BY: R.B. / J.B. TRACER: J.B. APPROVED: <i>[Signature]</i> CHIEF ENGINEER: H.W. / B.B. BUREAU ENGINEER: S.B. / S.B.				

APPROVED: <i>[Signature]</i> ENGINEER, KALIHI TUNNEL	W.S. CR. SEC. W.M. BY.	PROFILE F.B. F.W. BY.	C.B. S.B. S.B.
SECTION C	JOB NO. 26-53	DWG. VB-23	

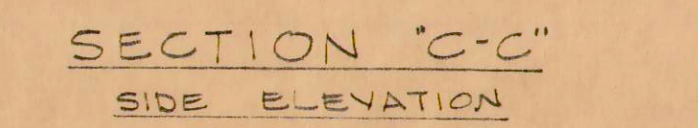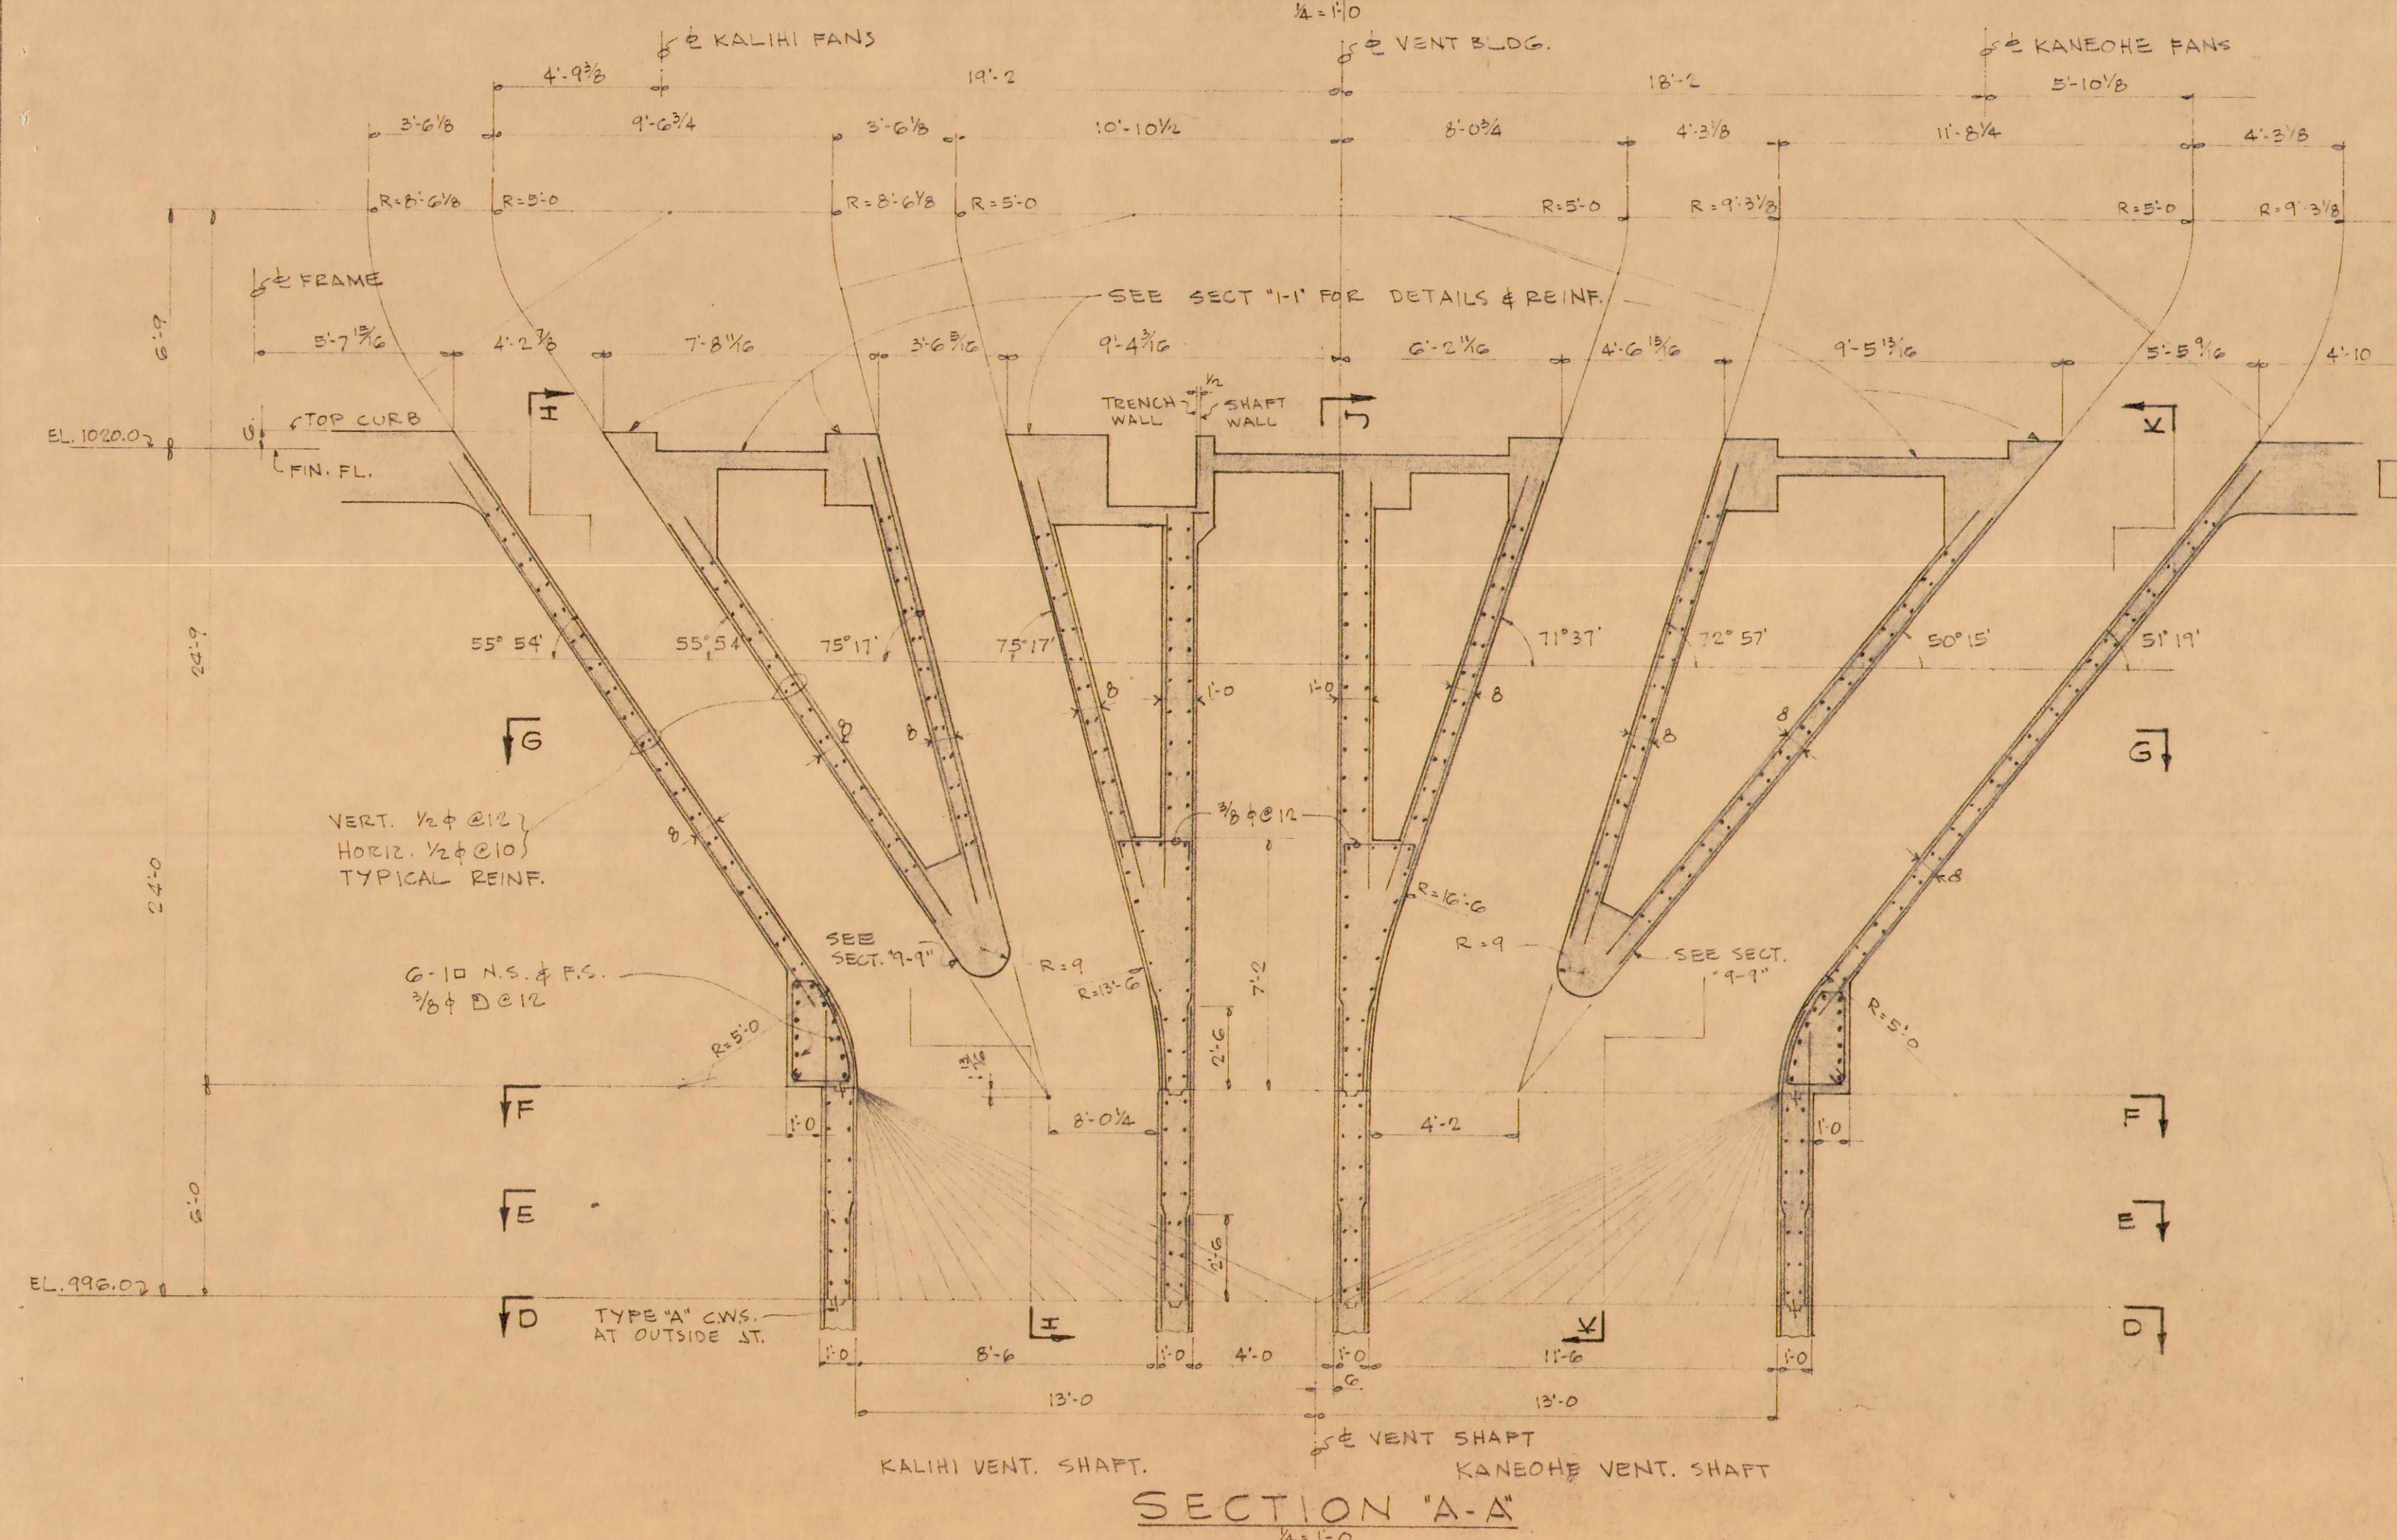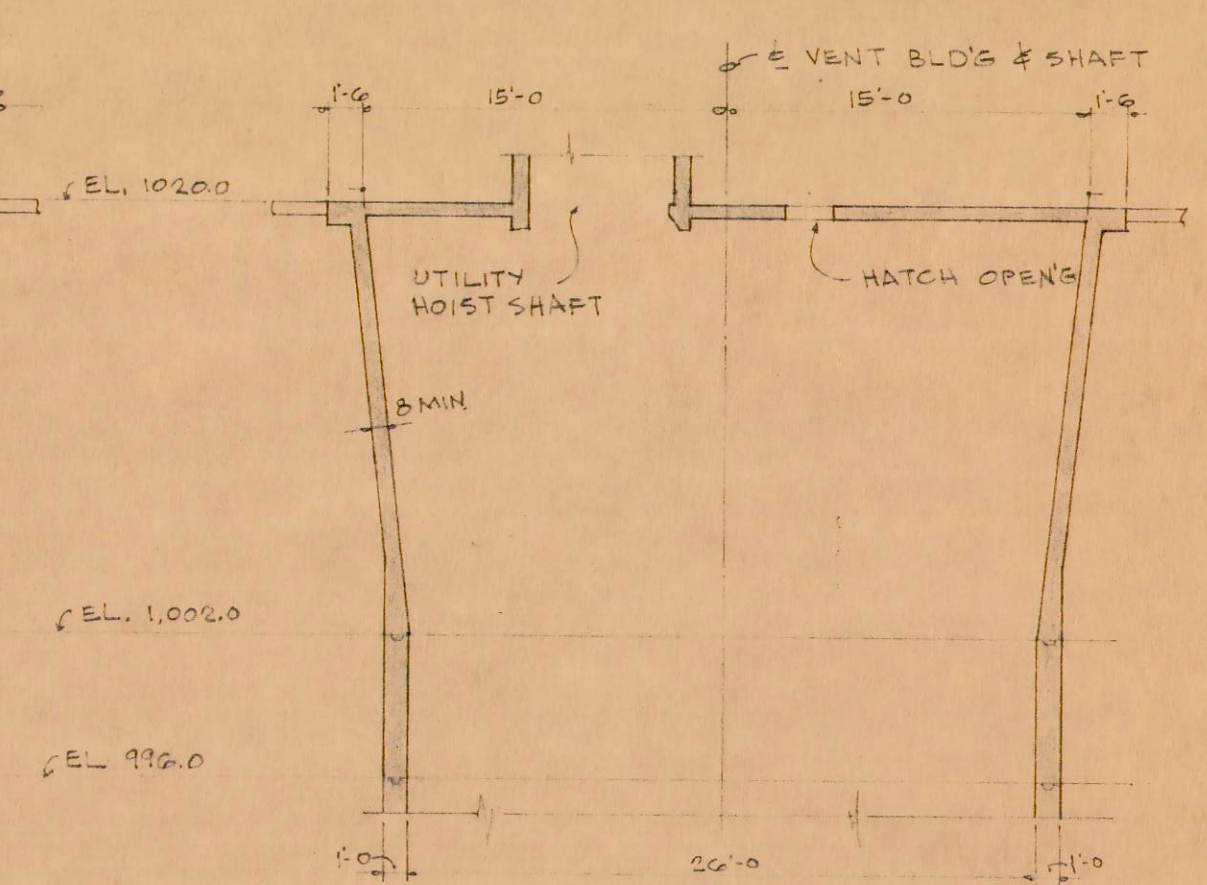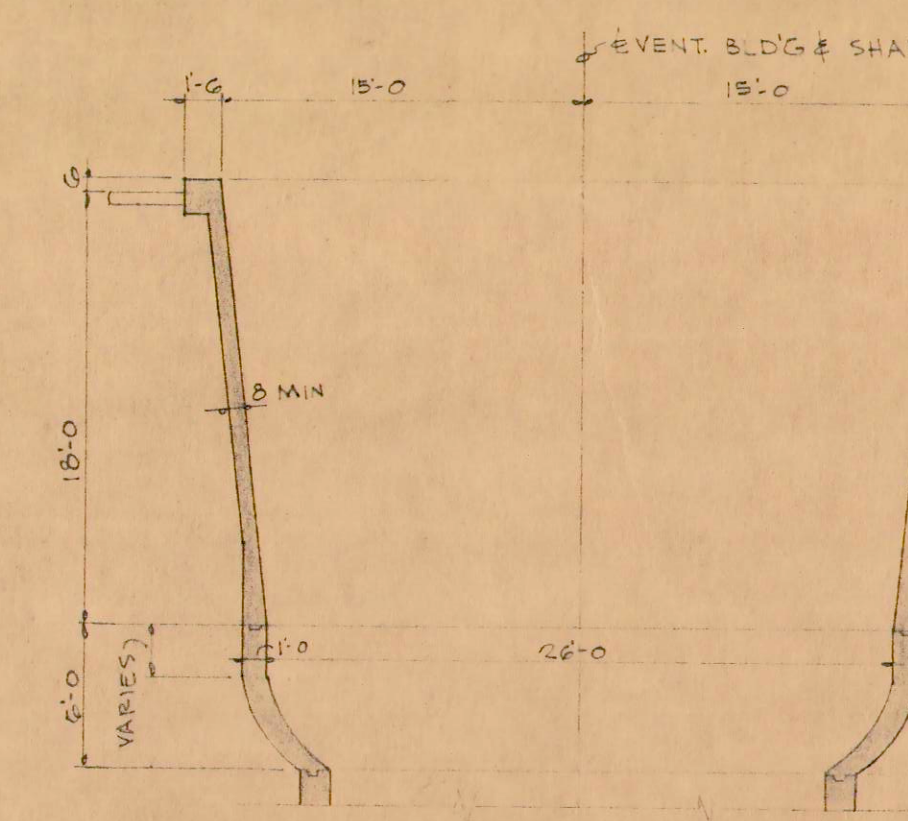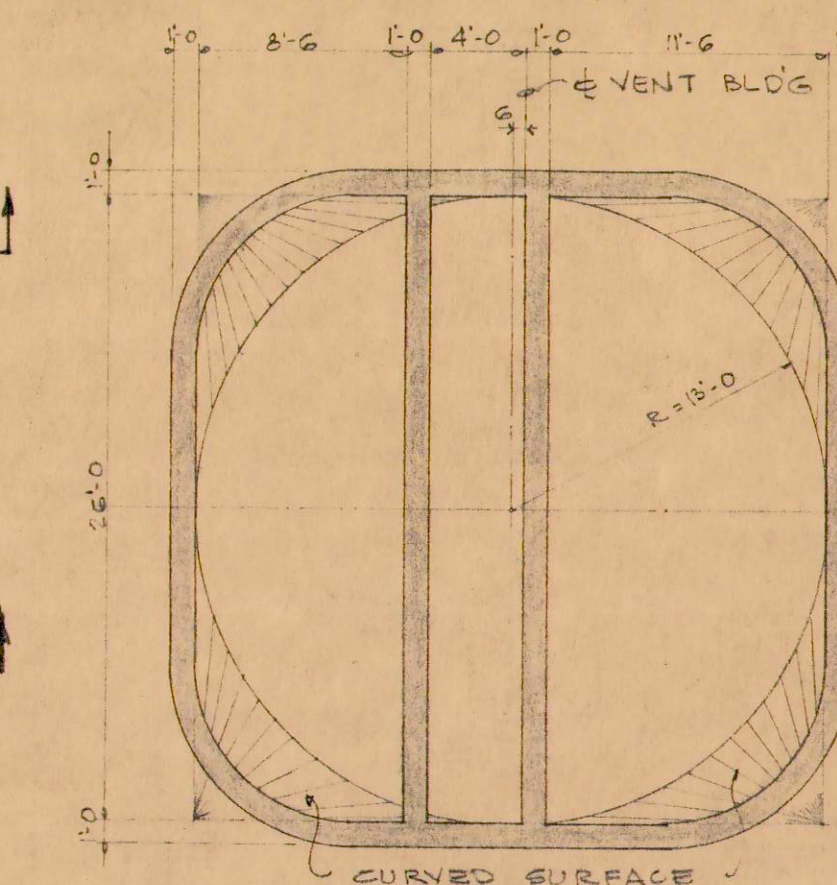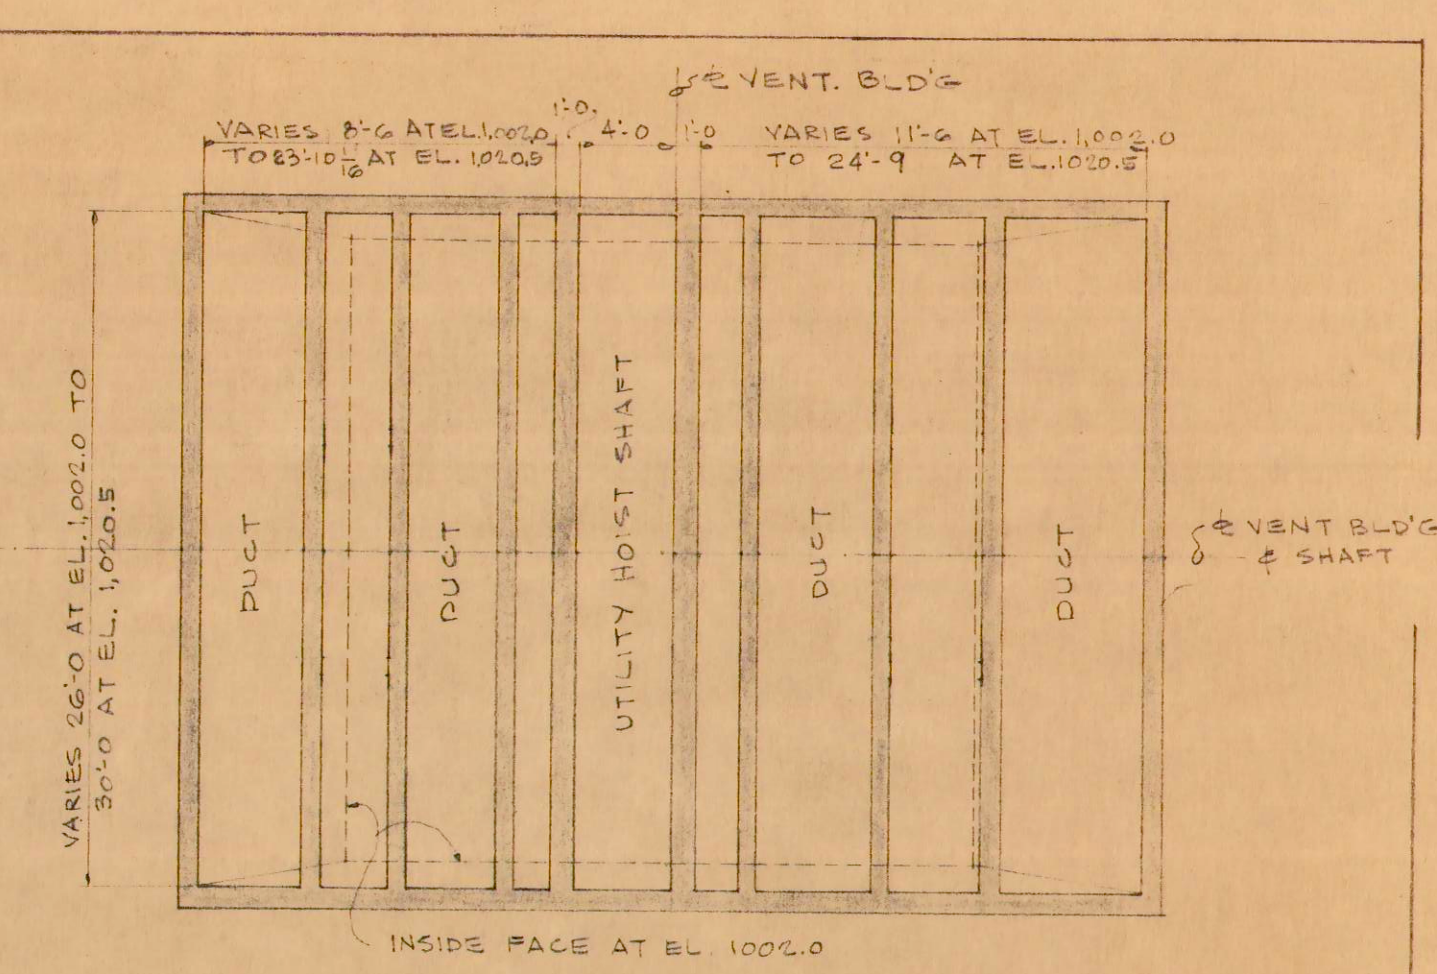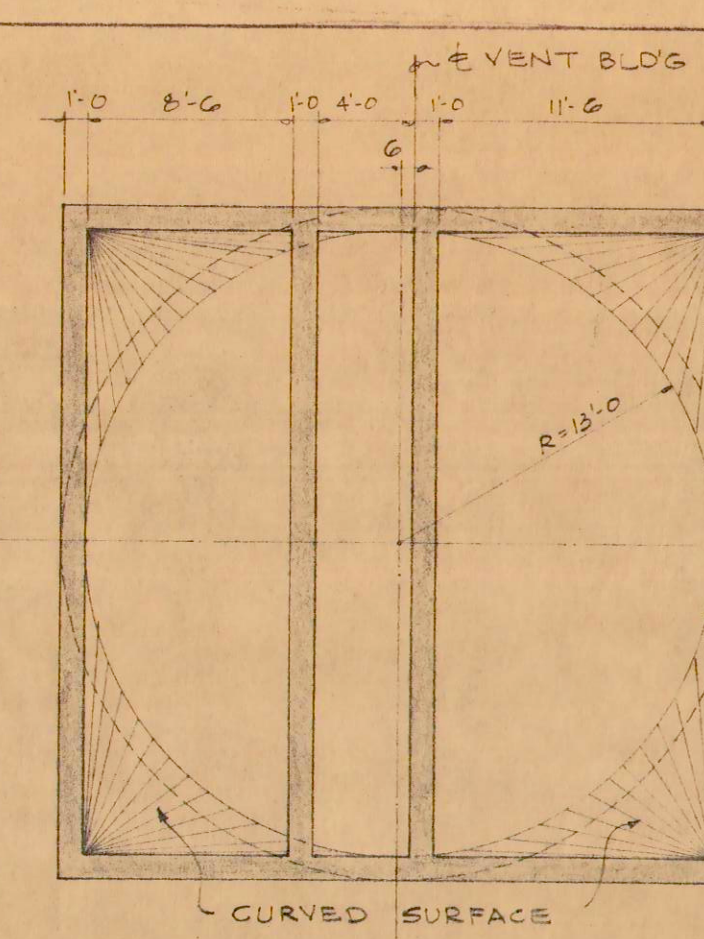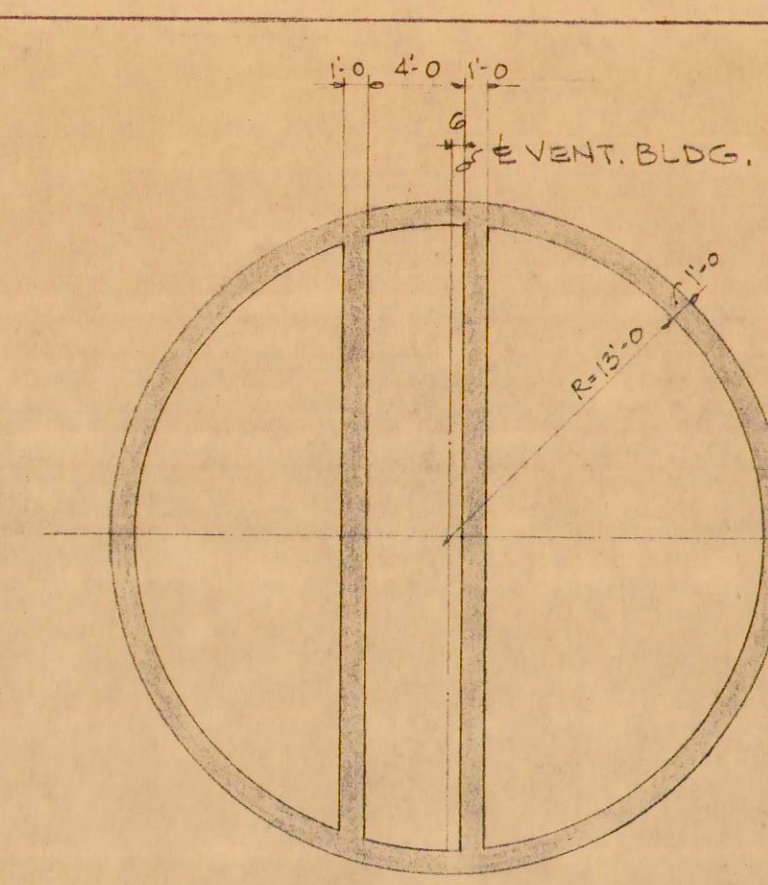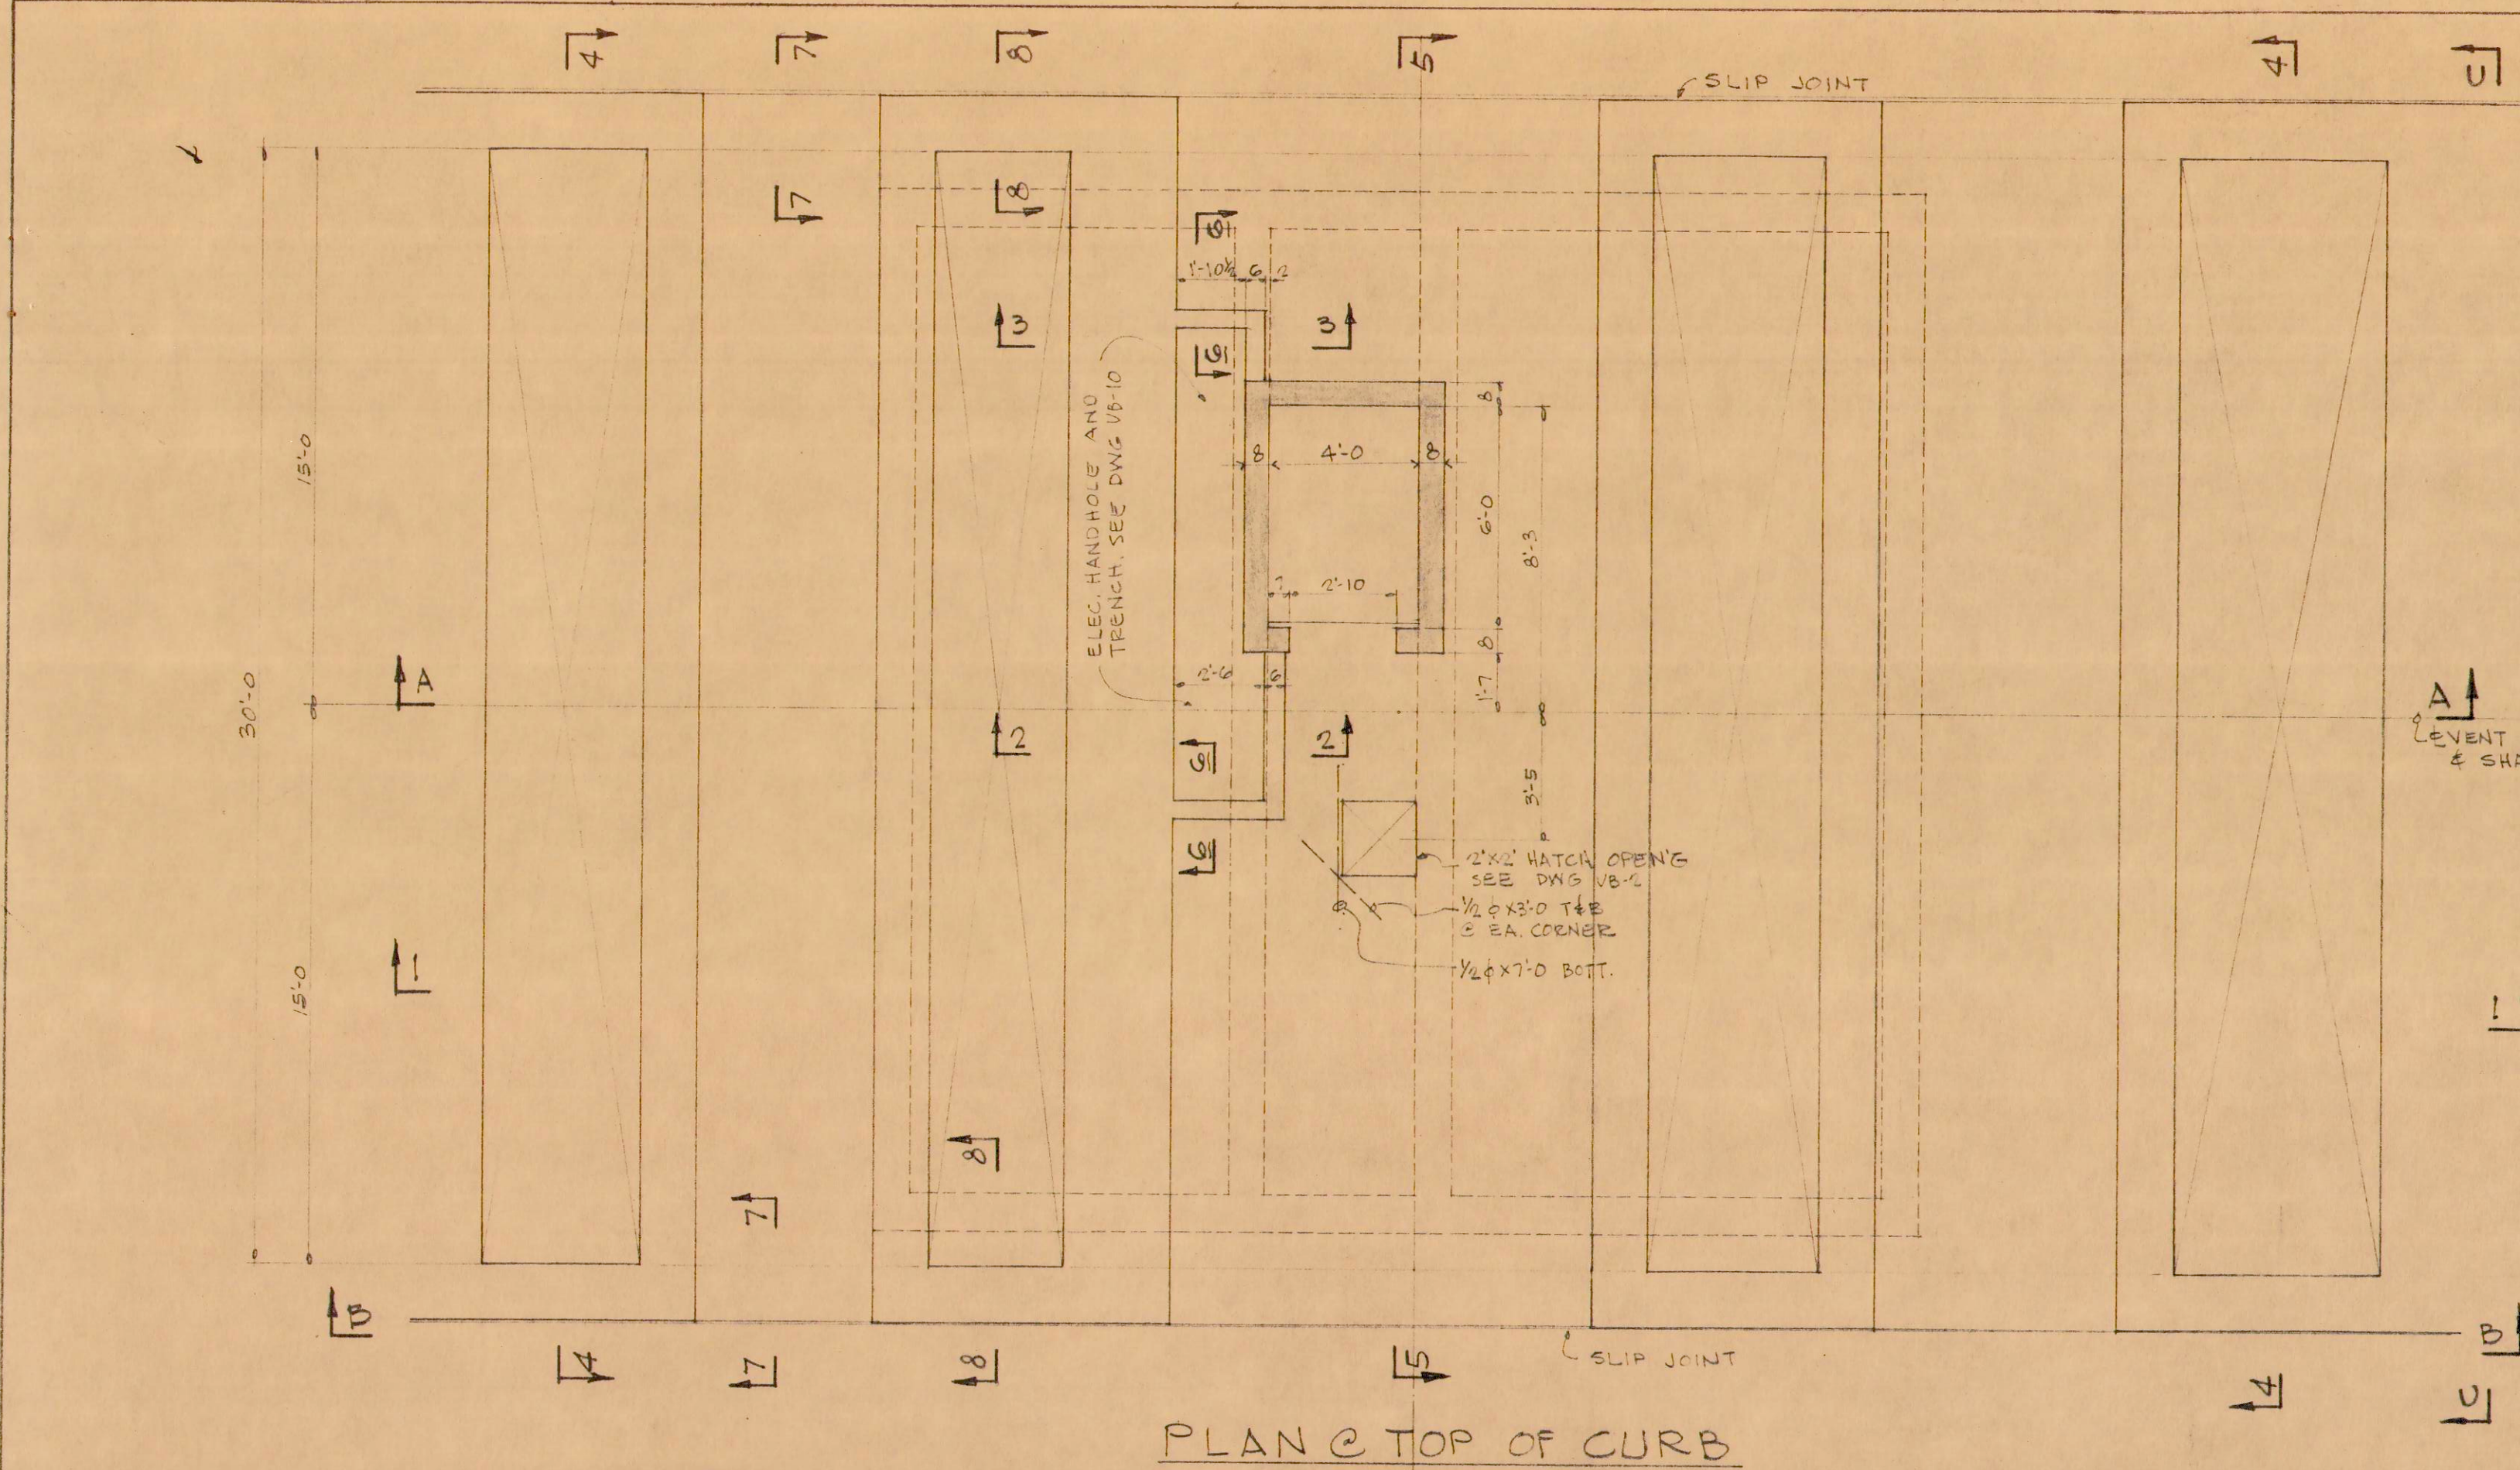

NOTE:
WHERE THIS DWG CONFLICTS WITH
DWGS ALREADY ISSUED, THIS DWG
WILL SUPERCEDE IN SUCH
CONFLICTING ITEMS ONLY.

FOR SECT. "1-1" TO "10-10"
SEE DWG VB-24A.

DEPARTMENT OF PUBLIC WORKS
CITY AND COUNTY OF HONOLULU
BUREAU OF PLANS
KALIHI TUNNEL
VENTILATION BLDG-STRUCTURAL
VENT FLARE-DETAILS
ENGINEER *W. J. [Signature]* DATE *7-19-56*
DRAFTSMAN *[Signature]* CHECKED BY
SCALE _____ TRACER _____
APPROVED *[Signature]* APPROVED *[Signature]*
G. E. [Signature] BUREAU ENGINEER

APPROVED: *K. Y. Miller*
ENGINEER, KALIHI TUNNEL

SECTION C	JOB NO. 26 - 53	DWG. 23-A
-----------	-----------------	-----------