


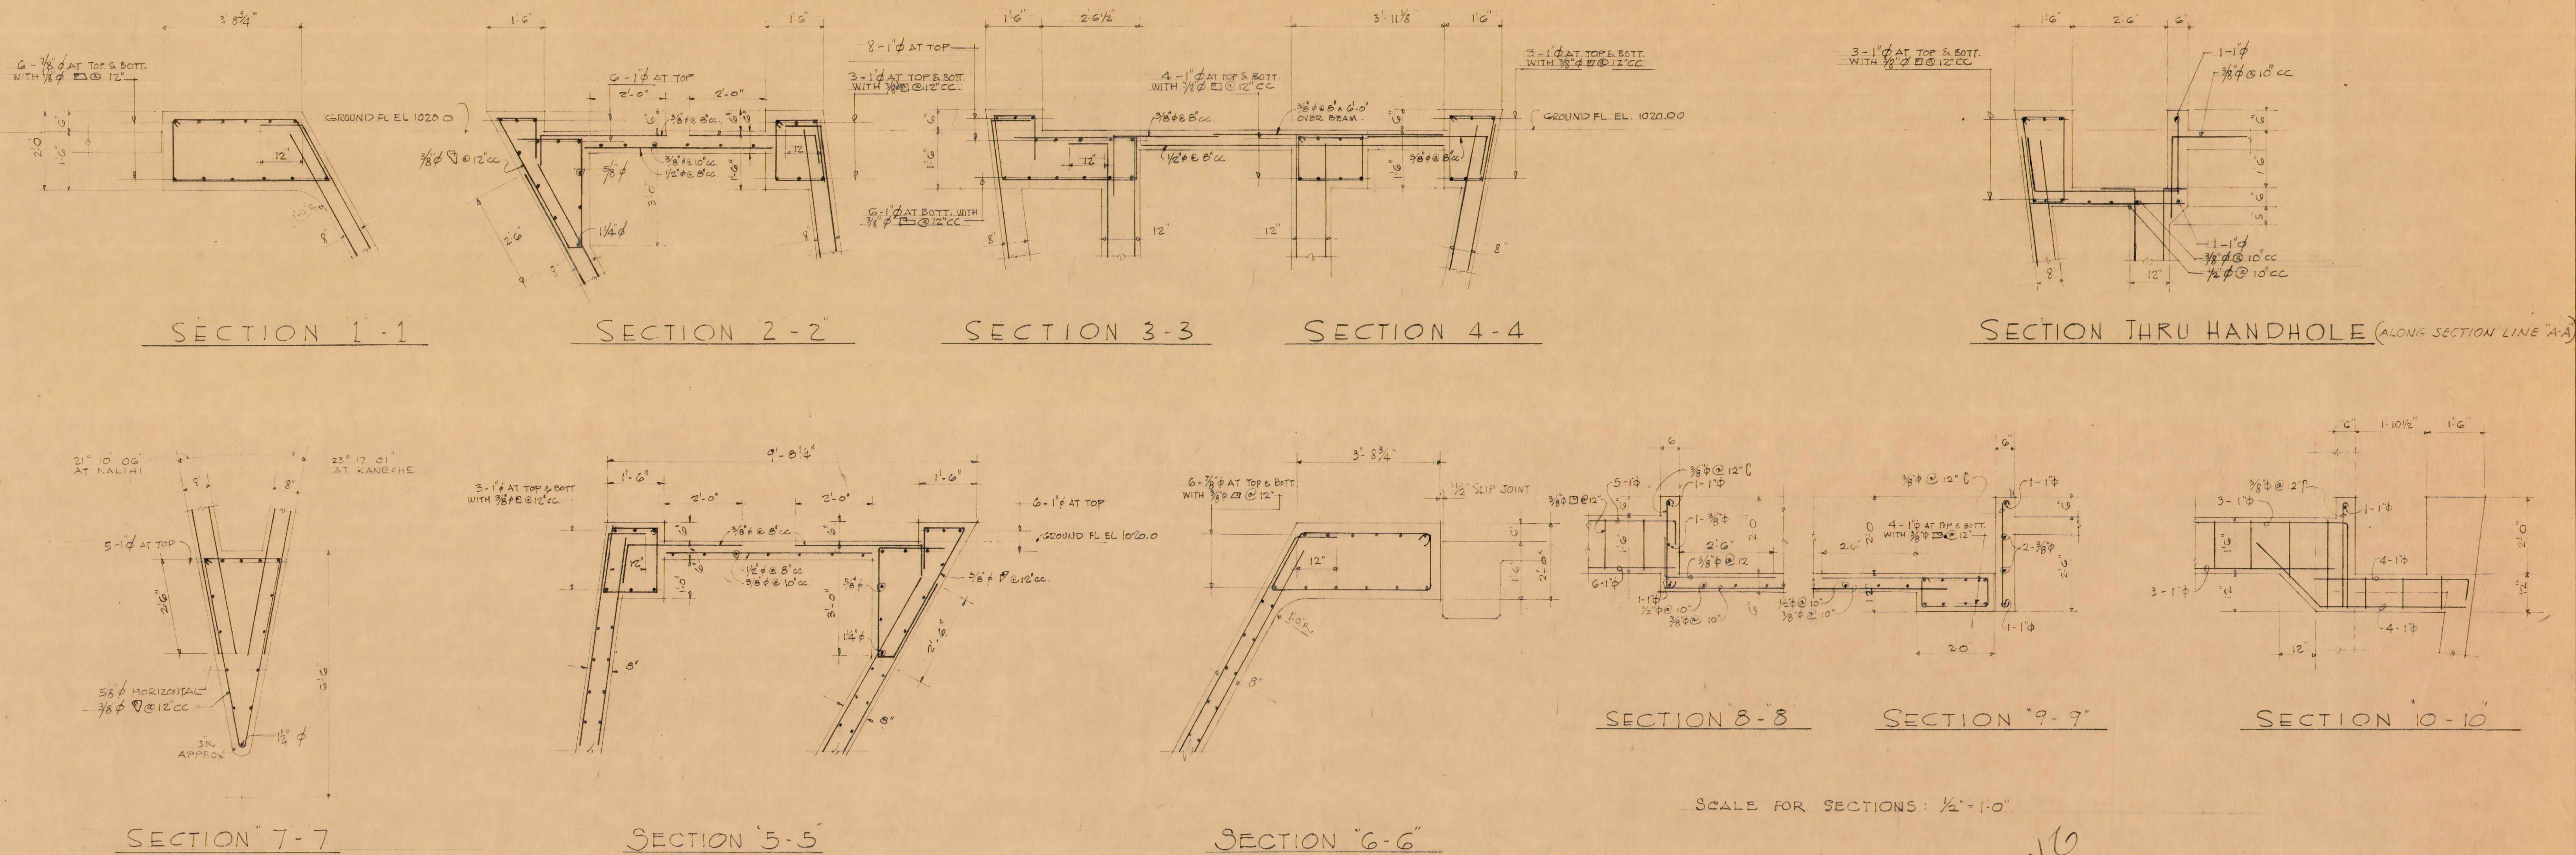

HOLD THIS SHEET
DETAILS LATER

NOTE: THIS DWG
SUPERCEDED - See New
DWG # VB25

REVISION	DATE	DESCRIPTION	MADE BY	CHK BY
RELOCATED OPENINGS & SIZE				



LAW & WILSON
ARCHITECTS & ENGINEERS
DEPARTMENT OF PUBLIC WORKS
CITY AND COUNTY OF HONOLULU
BUREAU OF PLANS

KALIHI TUNNEL
VENTILATION BLDG.-STRUCTURAL
VENT FLARE-DETAILS

ENGINEER LAW & WILSON DATE APRIL 15, 1953
DRAFTSMAN T.F. CHECKED BY R.B. [Signature]
SCALE AS NOTED TRACER [Signature]
APPROVED: [Signature] CHIEF ENGINEER [Signature] BUREAU ENGINEER

W.S.	PROFILE	C.B.
CR. SEC.	F.B.	S.B.
W.M.B.Y.	F.W.B.Y.	S.B.Y.

SECTION C JOB NO. 26-53 DWG. VB-25

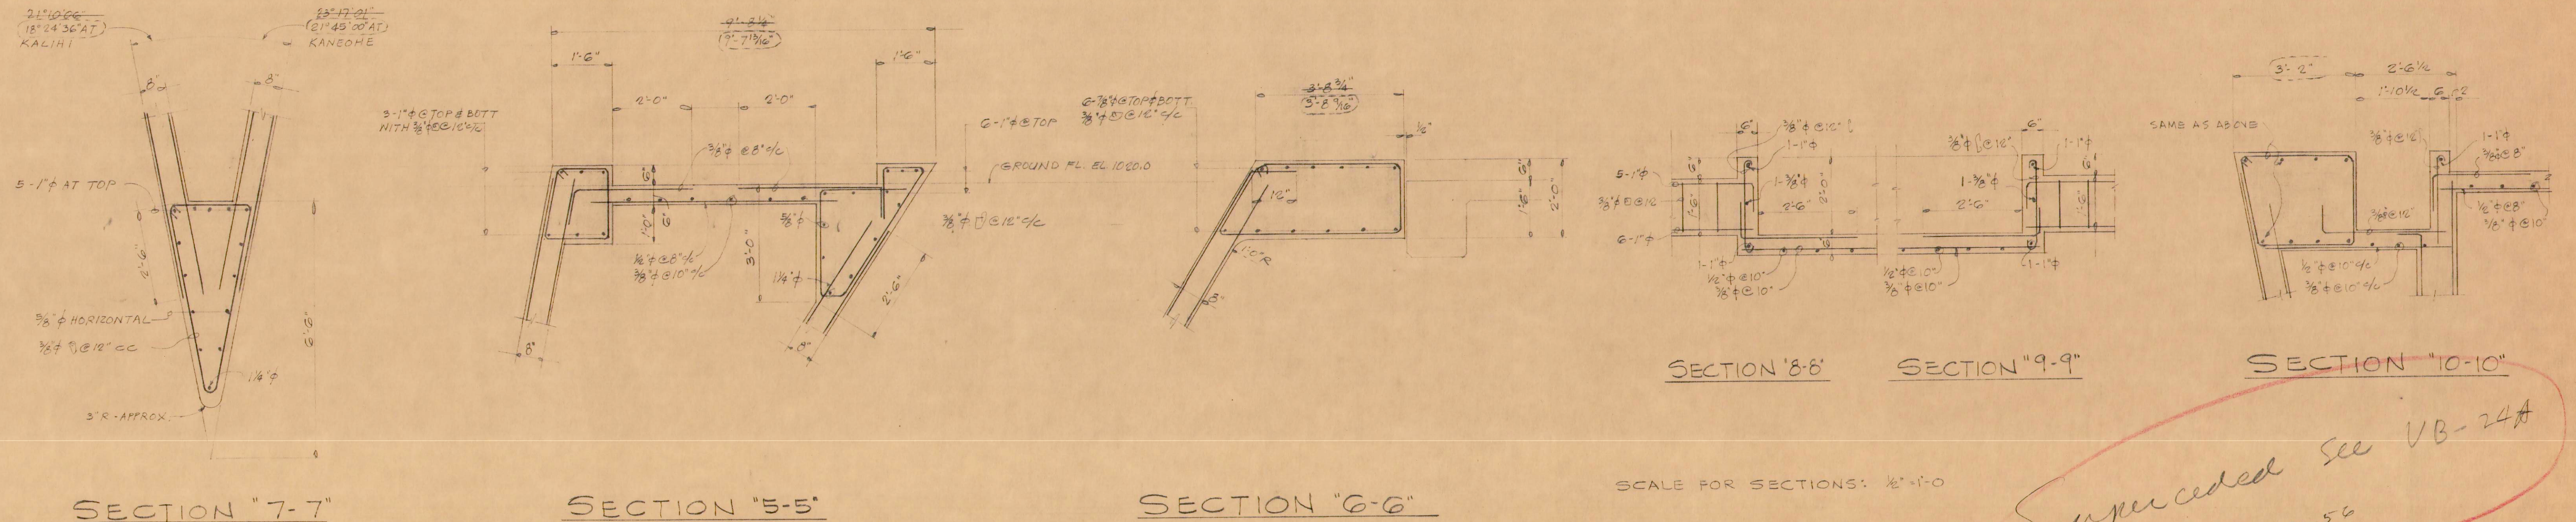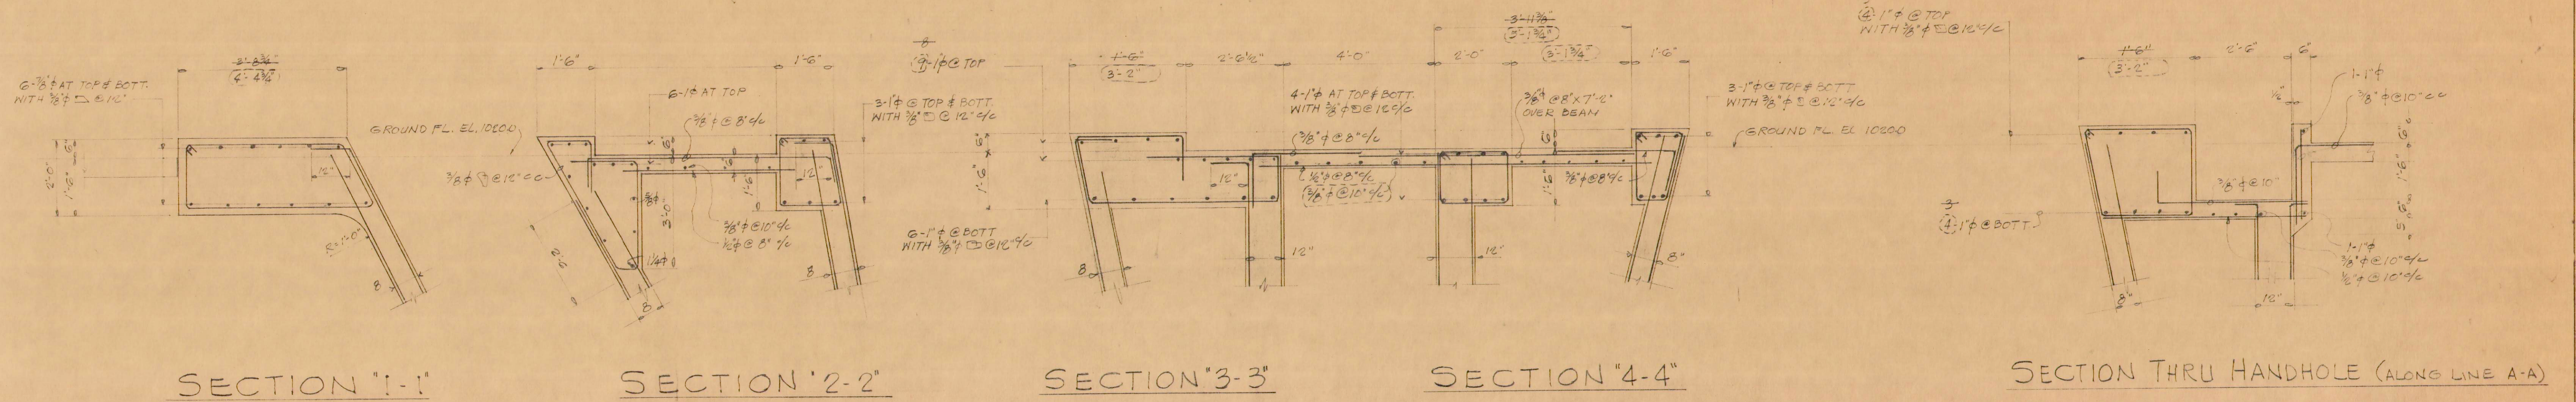

SCALE FOR SECTIONS: 1/2" = 1'-0"

*Superseded See VB-24A
7-20-56*

1	4-16-56	RELOCATED OPENINGS & SIZE	E.W.	90
REVISION	DATE	DESCRIPTION	MADE BY	CHK BY
LAW & WILSON ARCHITECTS & ENGINEERS DEPARTMENT OF PUBLIC WORKS CITY AND COUNTY OF HONOLULU BUREAU OF PLANS KALIHI TUNNEL VENTILATION BLDG.-STRUCTURAL VENT FLARE-DETAILS ENGINEER L.W./D.L. DATE JULY 15, 1953 DRAFTSMAN T.F. CHECKED BY R.B. [Signature] SCALE AS NOTED TRACER APPROVED [Signature] APPROVED [Signature] CHIEF ENGINEER BUREAU ENGINEER				
W.S.	PROFILE	C.B.		
CR. SEC.	F.B.	S.B.		
W.M. BY.	F.W. BY.	S. BY.		

SECTION C JOB NO. 26-53 DWG. VB-25