

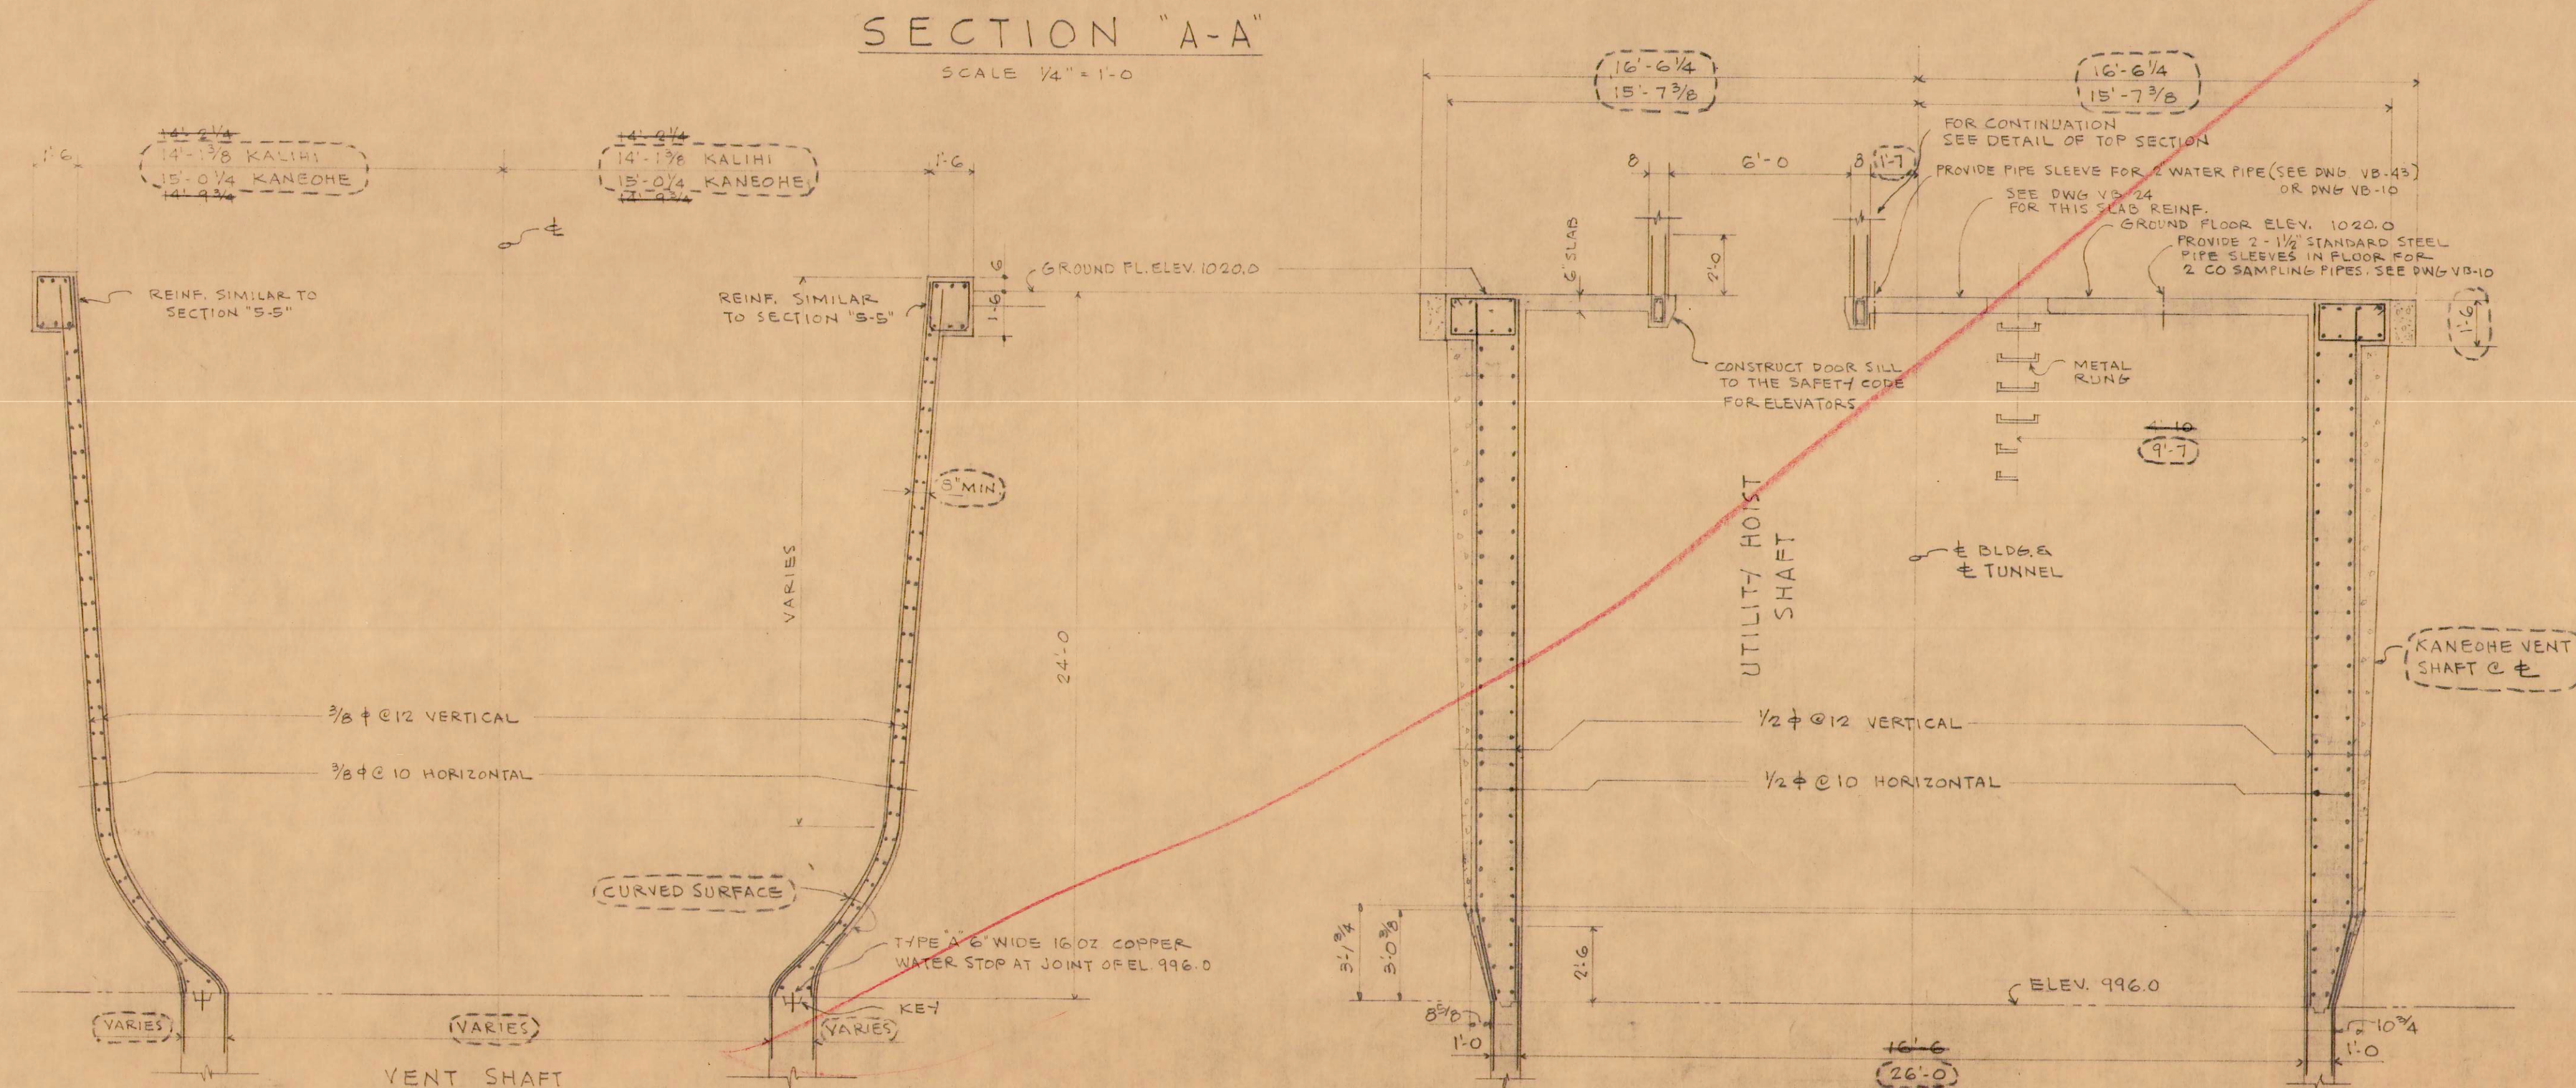


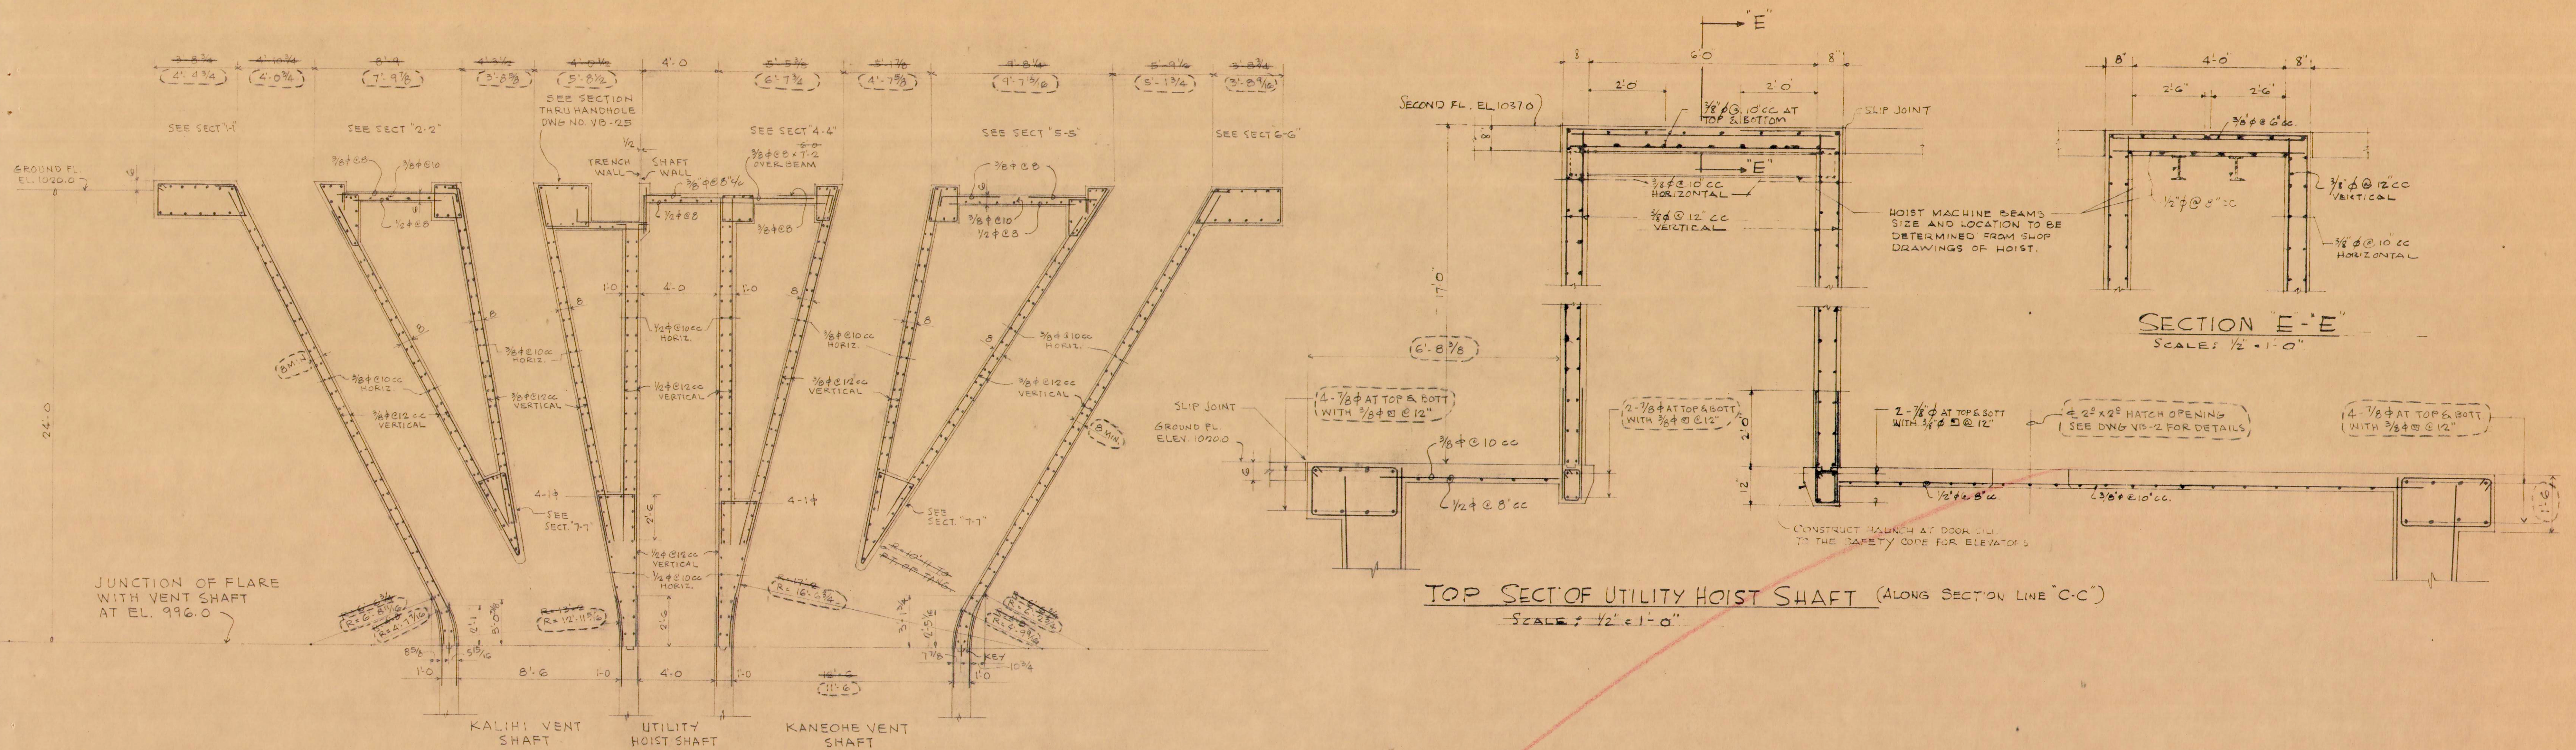


*Superseded
See VB-24A
7-10-56*

REVISION	DATE	DESCRIPTION	MADE BY	CHECK BY
1	4-16-56	RELOCATED OPENINGS & SIZE	E.V.	1/0
LAW & WILSON ARCHITECTS & ENGINEERS DEPARTMENT OF PUBLIC WORKS CITY AND COUNTY OF HONOLULU BUREAU OF PLANS				
KALIHI TUNNEL VENTILATION BLDG.-STRUCTURAL VENT FLARE-SECTIONS				
ENGINEER	LAW/W/L	DATE	JULY 13, 1955	
DRAFTSMAN	P.K.	CHECKED BY	R.B. [Signature]	
SCALE	AS NOTED	TRACER		
APPROVED	[Signature]	APPROVED	[Signature]	
CHIEF ENGINEER		BUREAU ENGINEER		
W.S.	PROJ. ENGR.	C.B.		
CR. SEC.	F.B.	S.B.		
W.M.B.Y.	F.W.B.Y.	S.B.Y.		

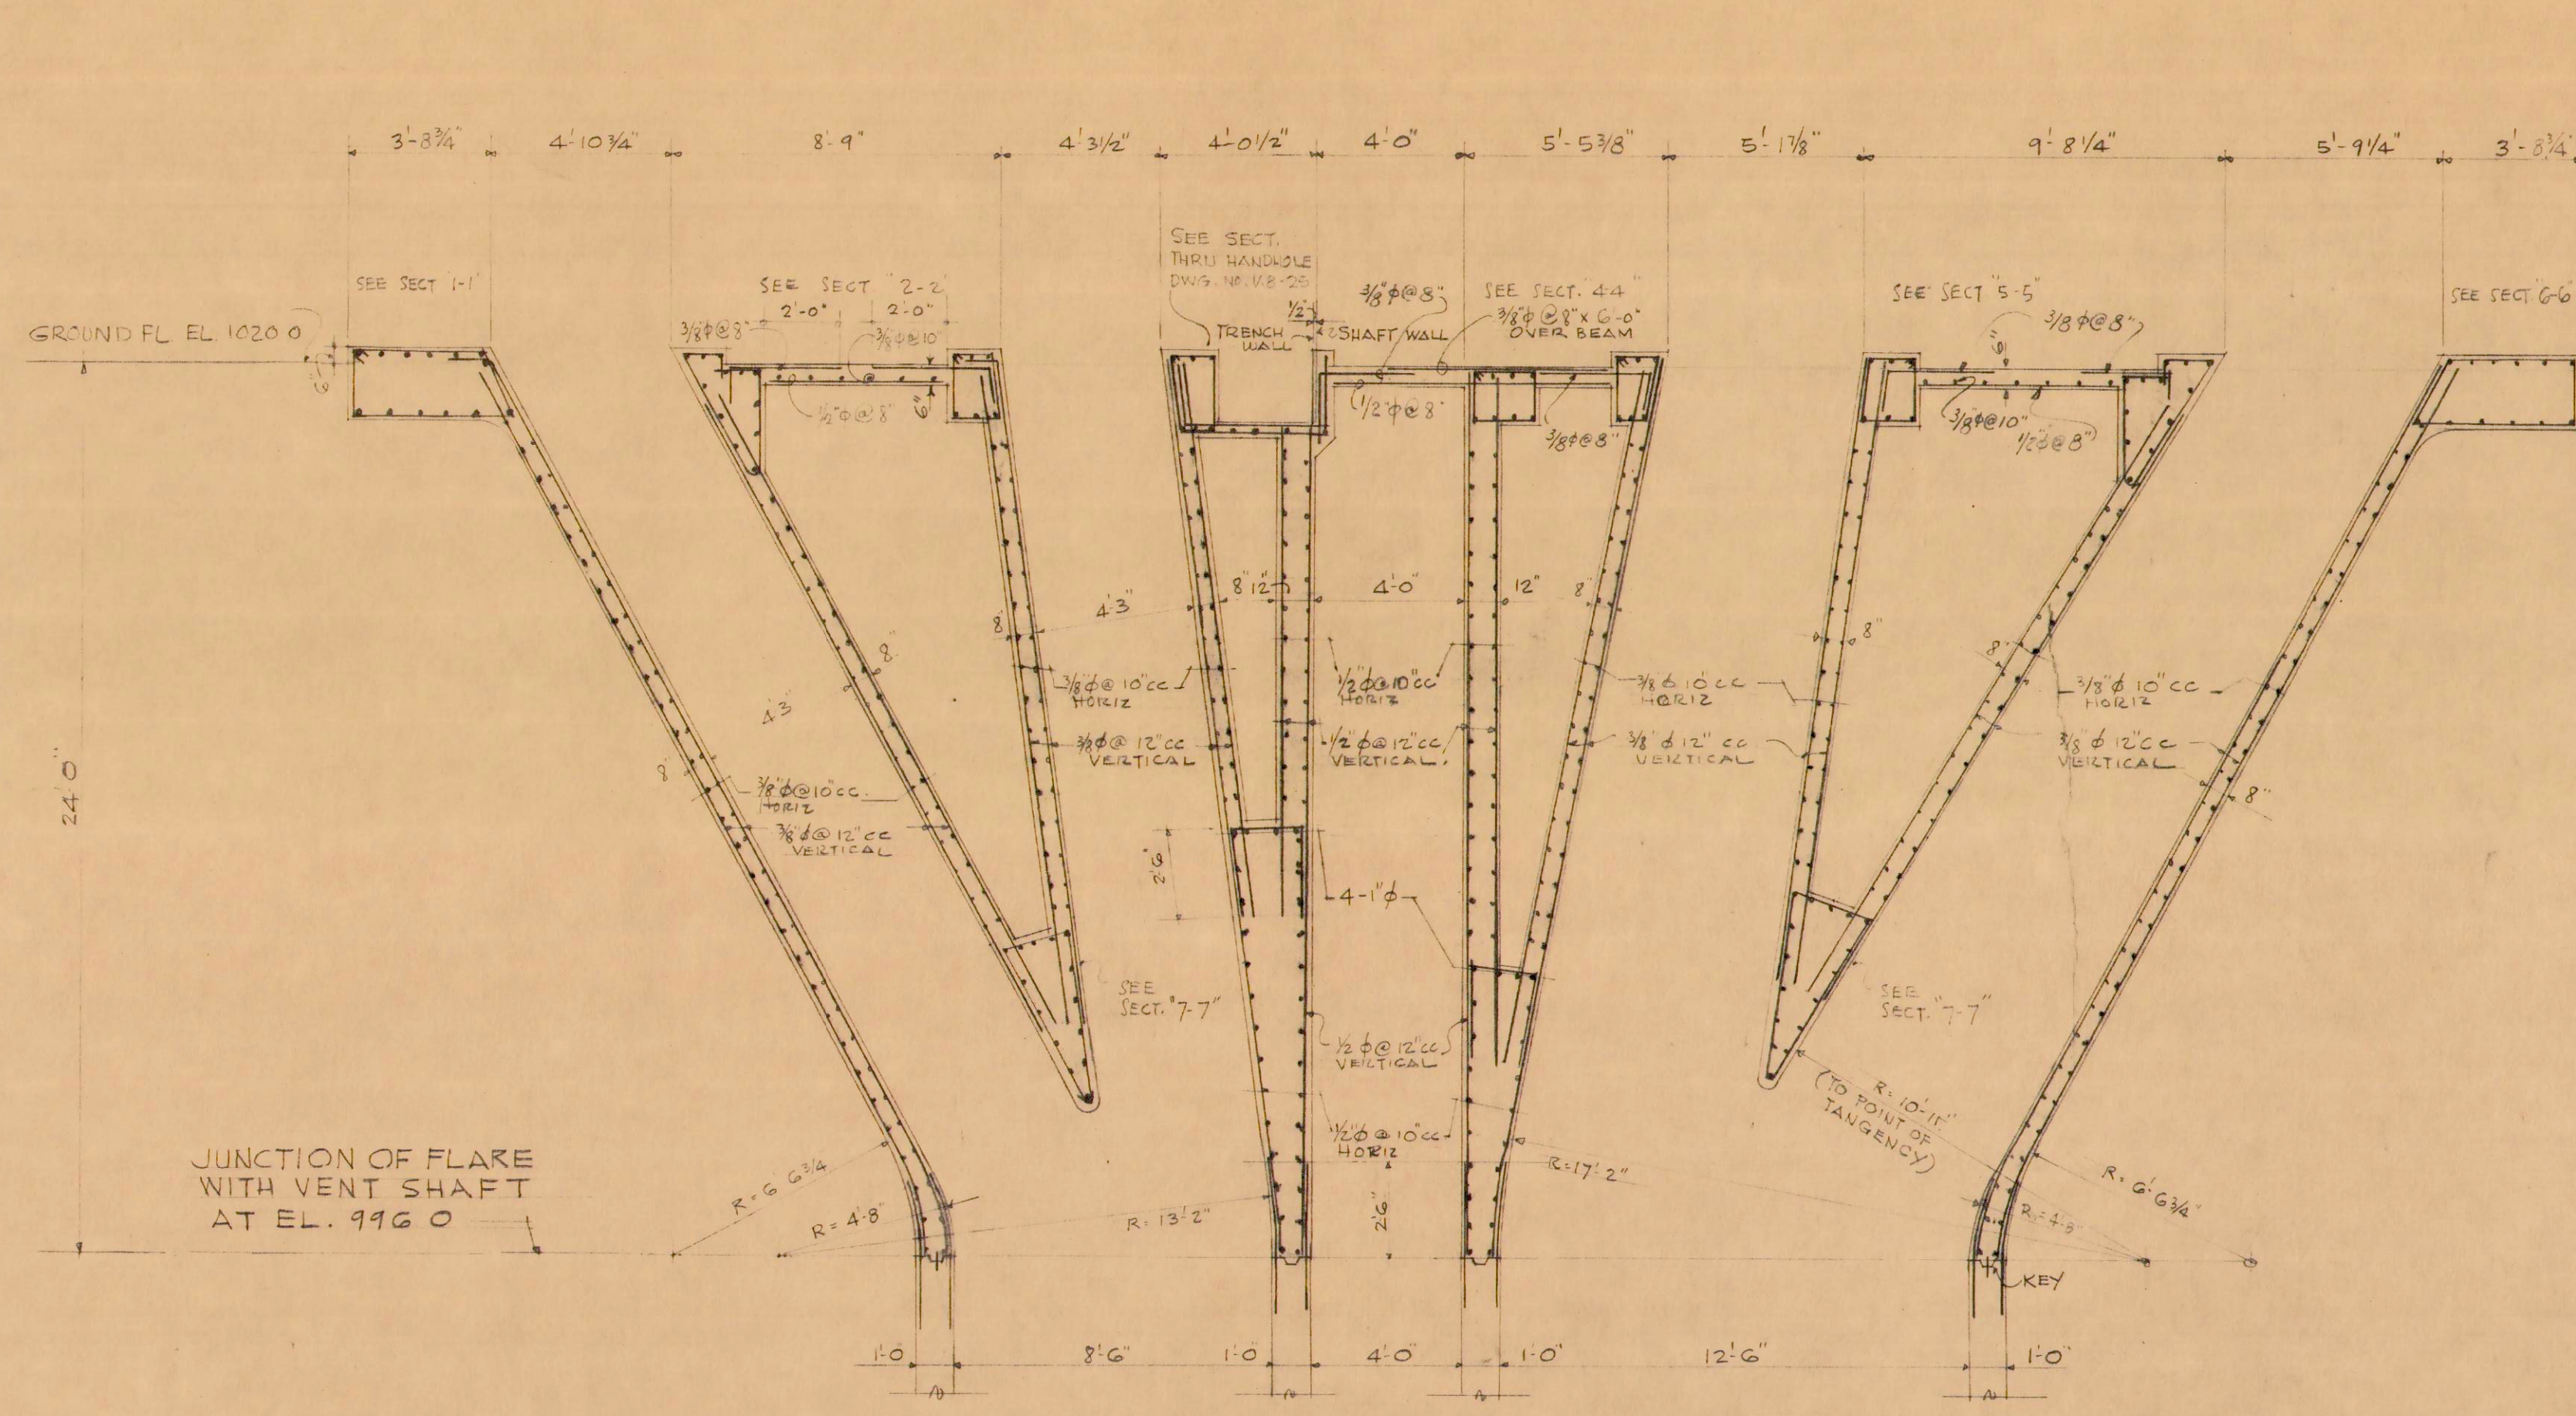


KALIHI VENT SHAFT
UTILITY HOIST SHAFT
Kaneohe VENT SHAFT
SECTION "A-A-A"
SCALE: 1/4" = 1'-0"

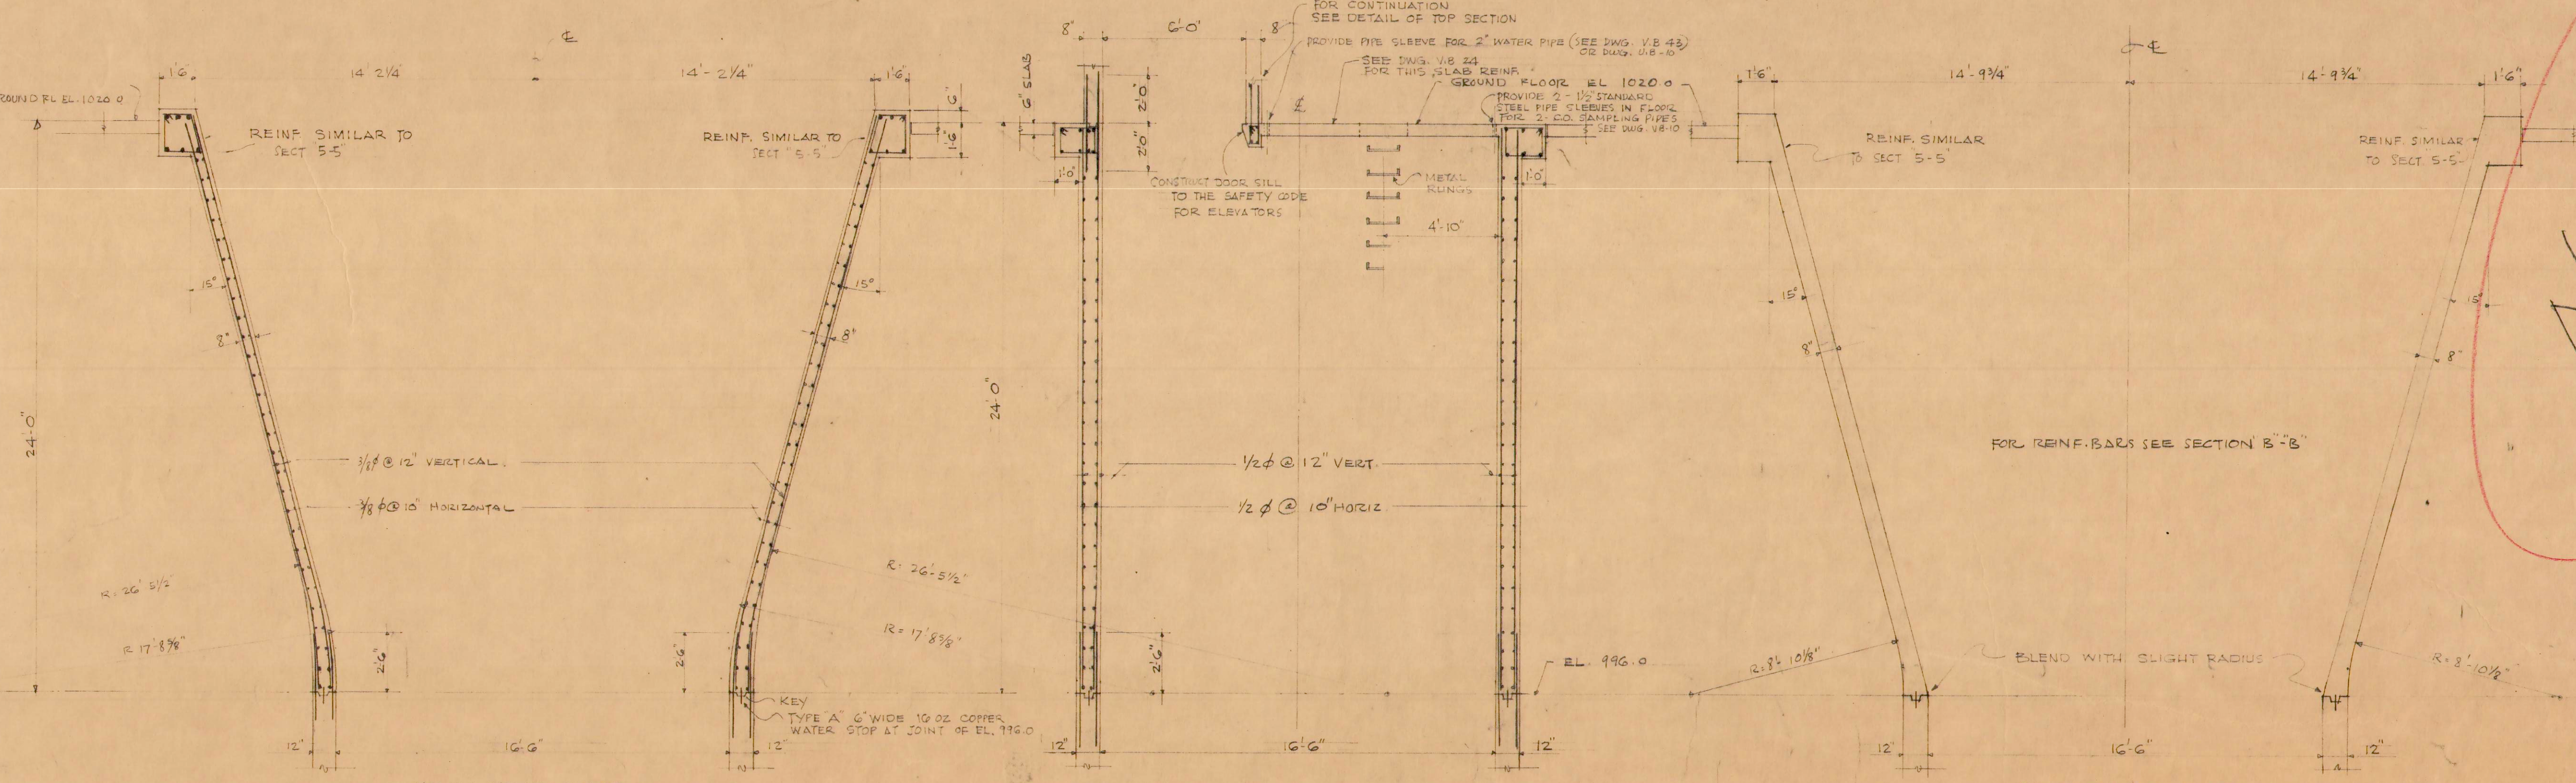

KALIHI VENT SHAFT
SECTION "B-B-B"
SCALE: 1/4" = 1'-0"

UTILITY HOIST SHAFT
SECTION "C-C-C"
SCALE: 1/4" = 1'-0"

Kaneohe VENT SHAFT
SECTION "D-D-D"
SCALE: 1/4" = 1'-0"

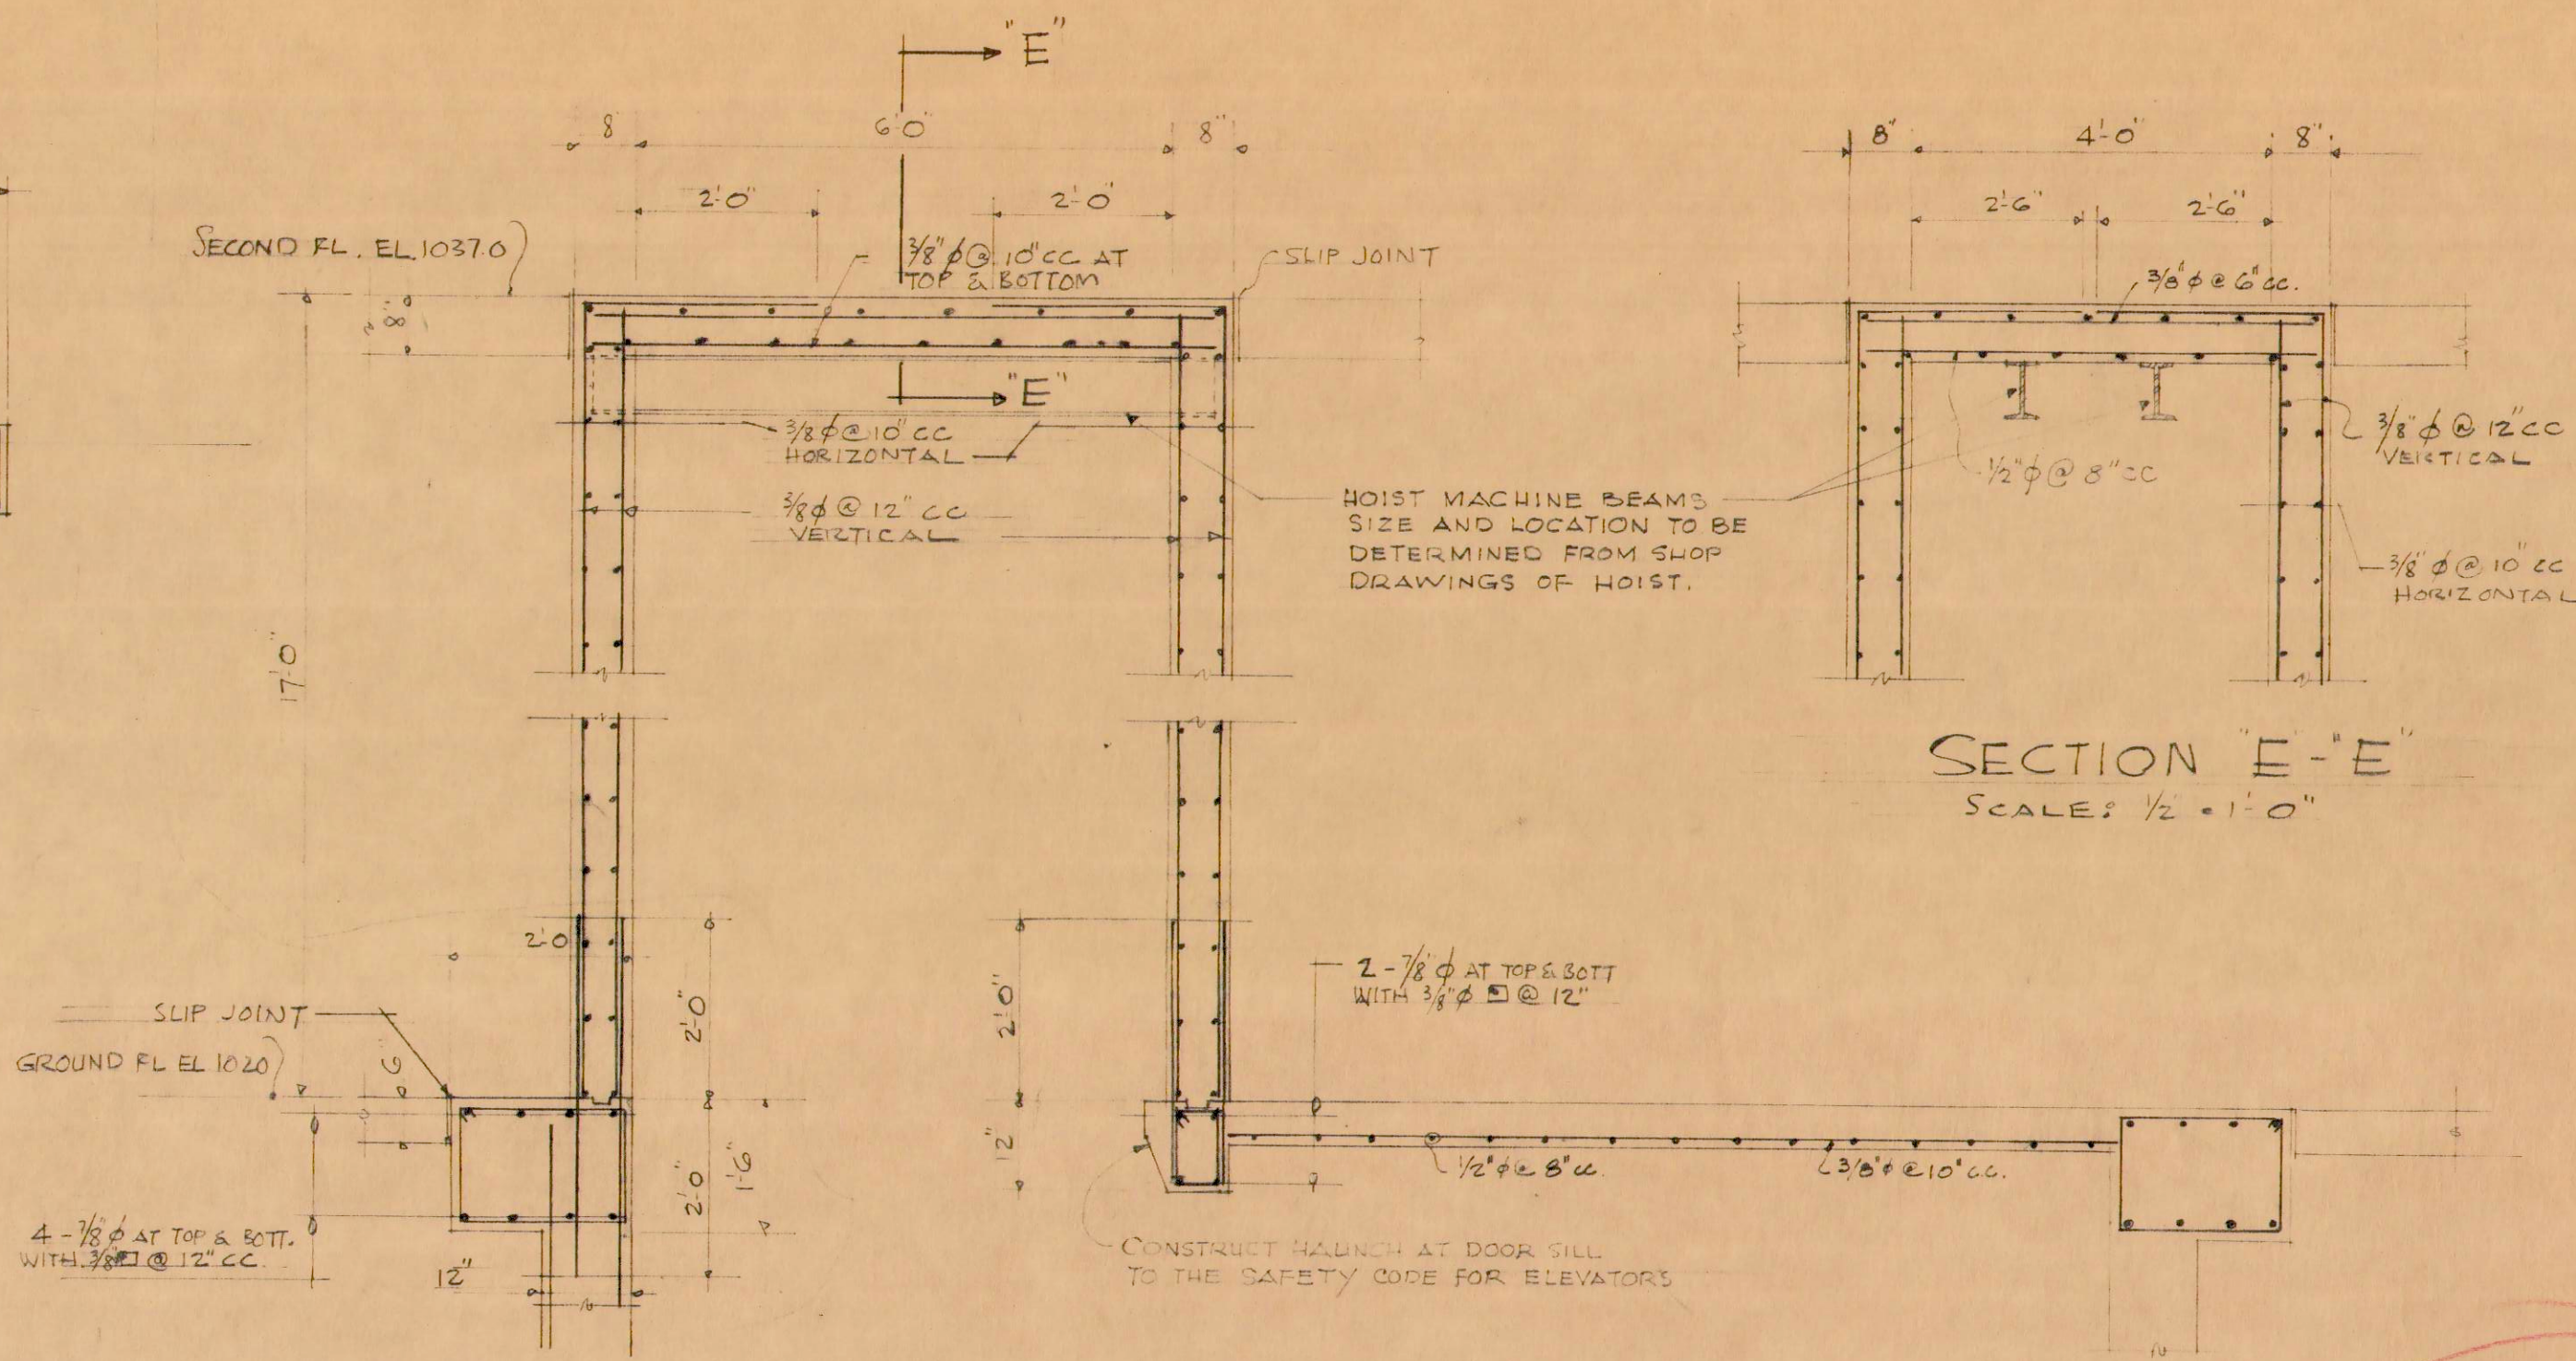


UTILITY HOIST SHAFT (ALONG SECTION LINE "C-C")
SCALE: 1/2" = 1'-0"

HOLD THIS SHEET
DETAILS LATER


NOTE: THIS DWG
SUPERCEDED - see New
DWG # VB2-4

REVISION	DATE	DESCRIPTION	MADE BY	CHEK BY
1		RELOCATED OPENINGS & SIZE		
LAW & WILSON ARCHITECTS & ENGINEERS DEPARTMENT OF PUBLIC WORKS CITY AND COUNTY OF HONOLULU BUREAU OF PLANS KALIHI TUNNEL VENTILATION BLDG.-STRUCTURAL VENT FLARE - SECTIONS				
ENGINEER	LAW & WILSON	DATE	JULY 19, 1953	
DRAFTSMAN	P. K.	CHECKED BY	R. B. [Signature]	
SCALE	AS NOTED	TRACER		
APPROVED:	[Signature]	APPROVED:	[Signature]	
CHIEF ENGINEER		BUREAU ENGINEER		
W. S.	PROF.	C.B.		
CR. SEC.	F. B.	S. B.		
W. M. BY.	F. W. BY.	S. BY.		

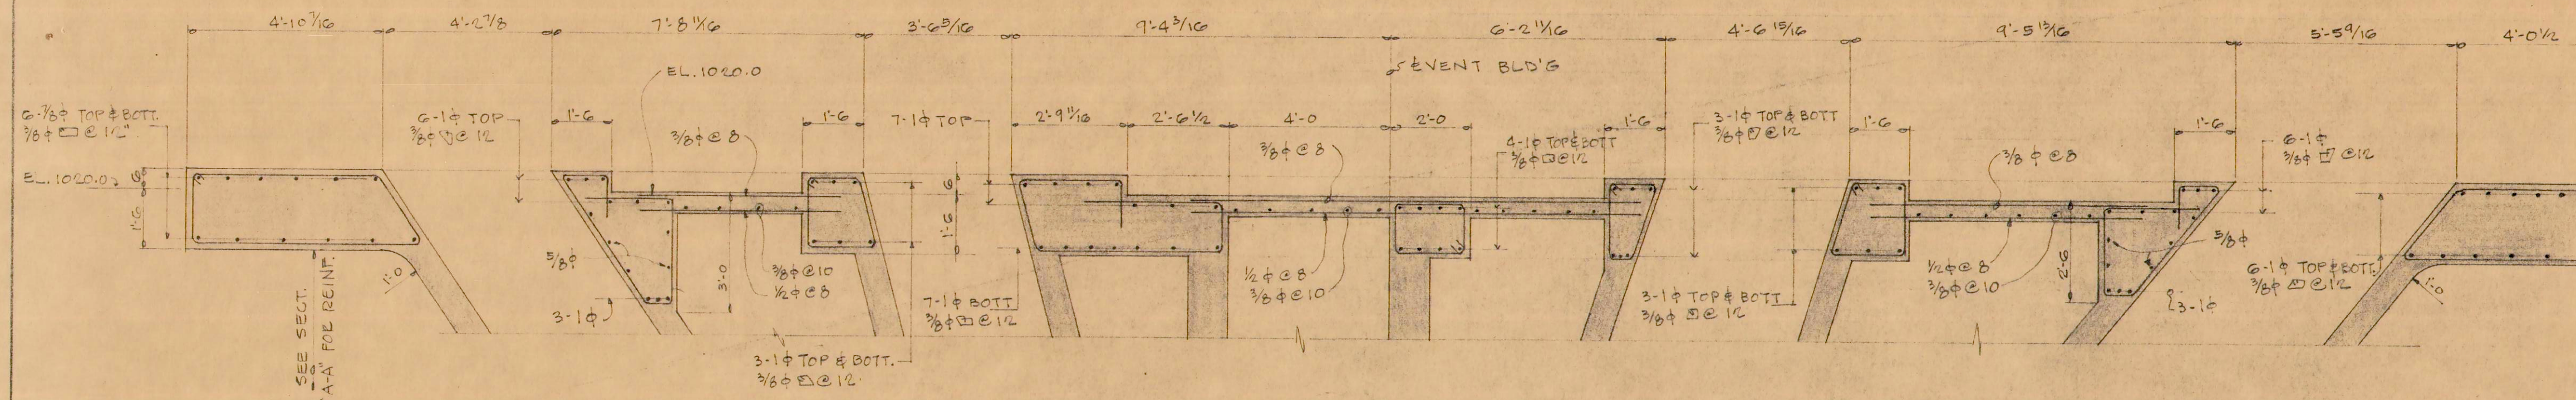



SECT. "1-1"

3/8" = 1'-0"

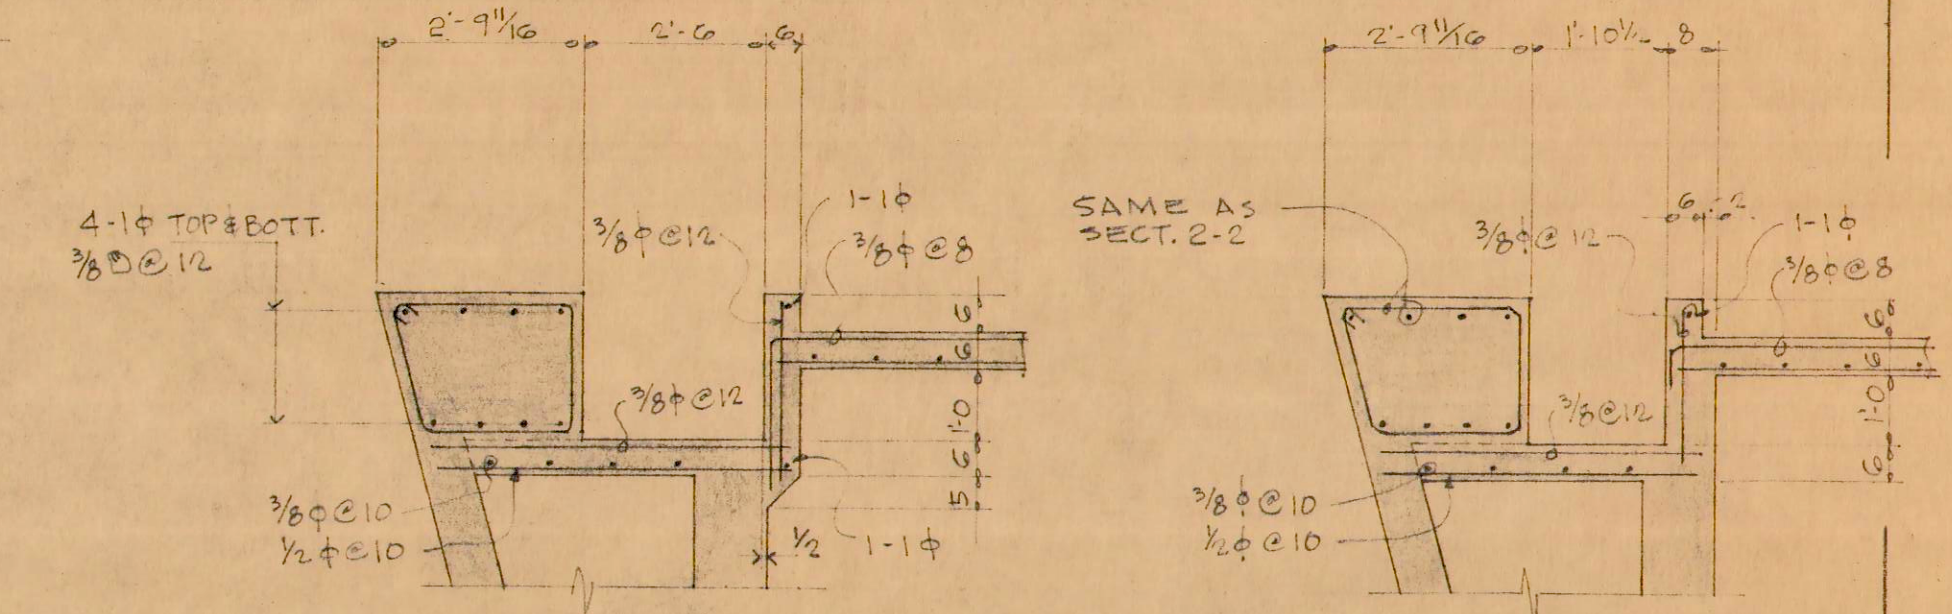


SECT. "2-2"

SECT. "3-3"

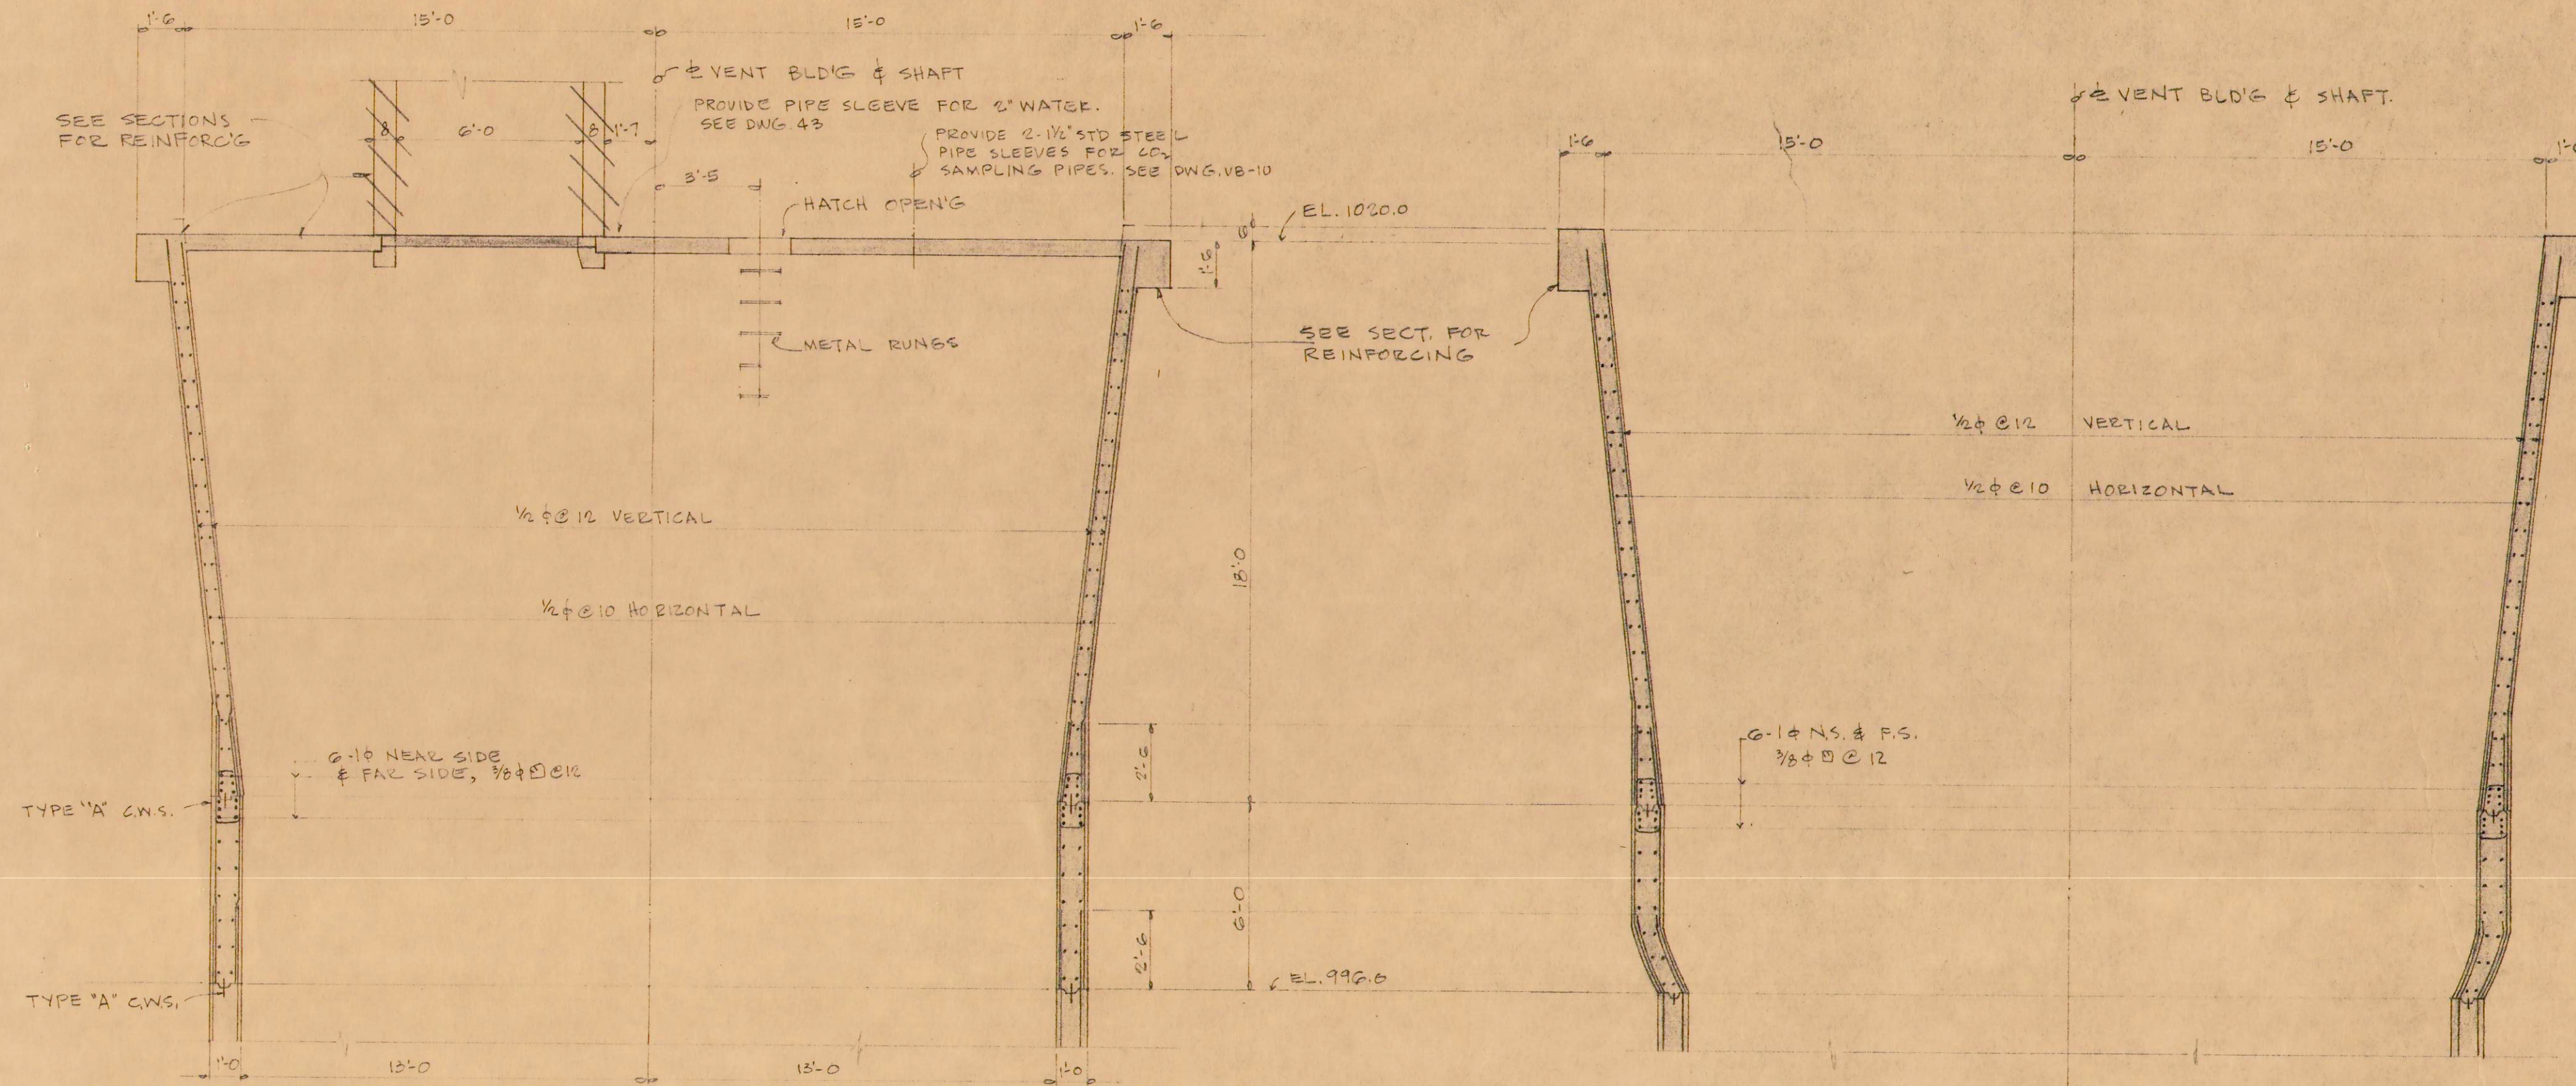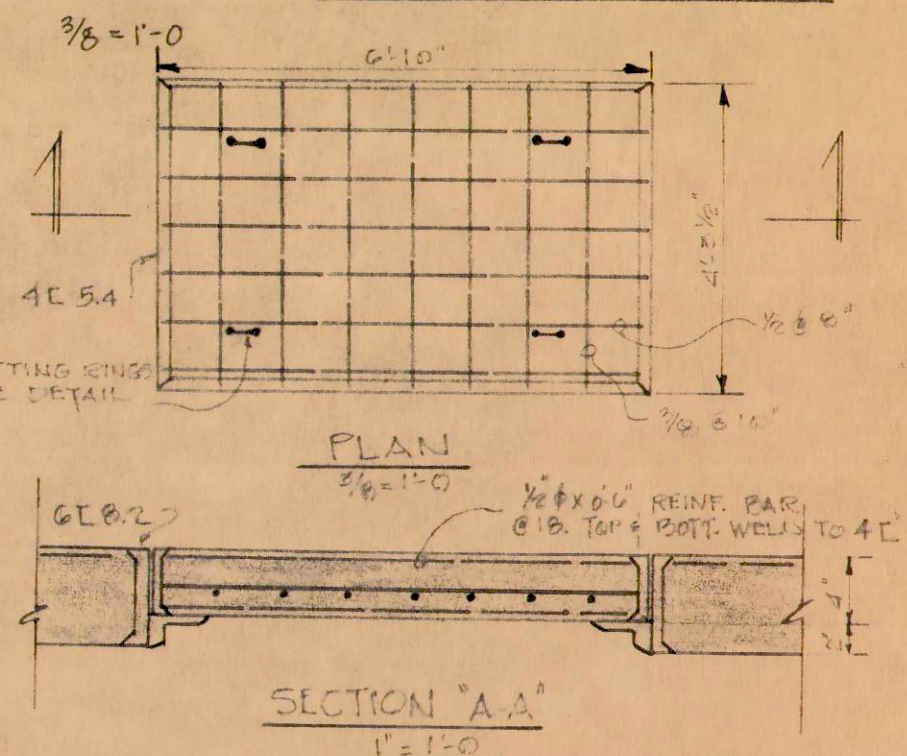

SECT. "4-4"

1/2" = 1'-0"

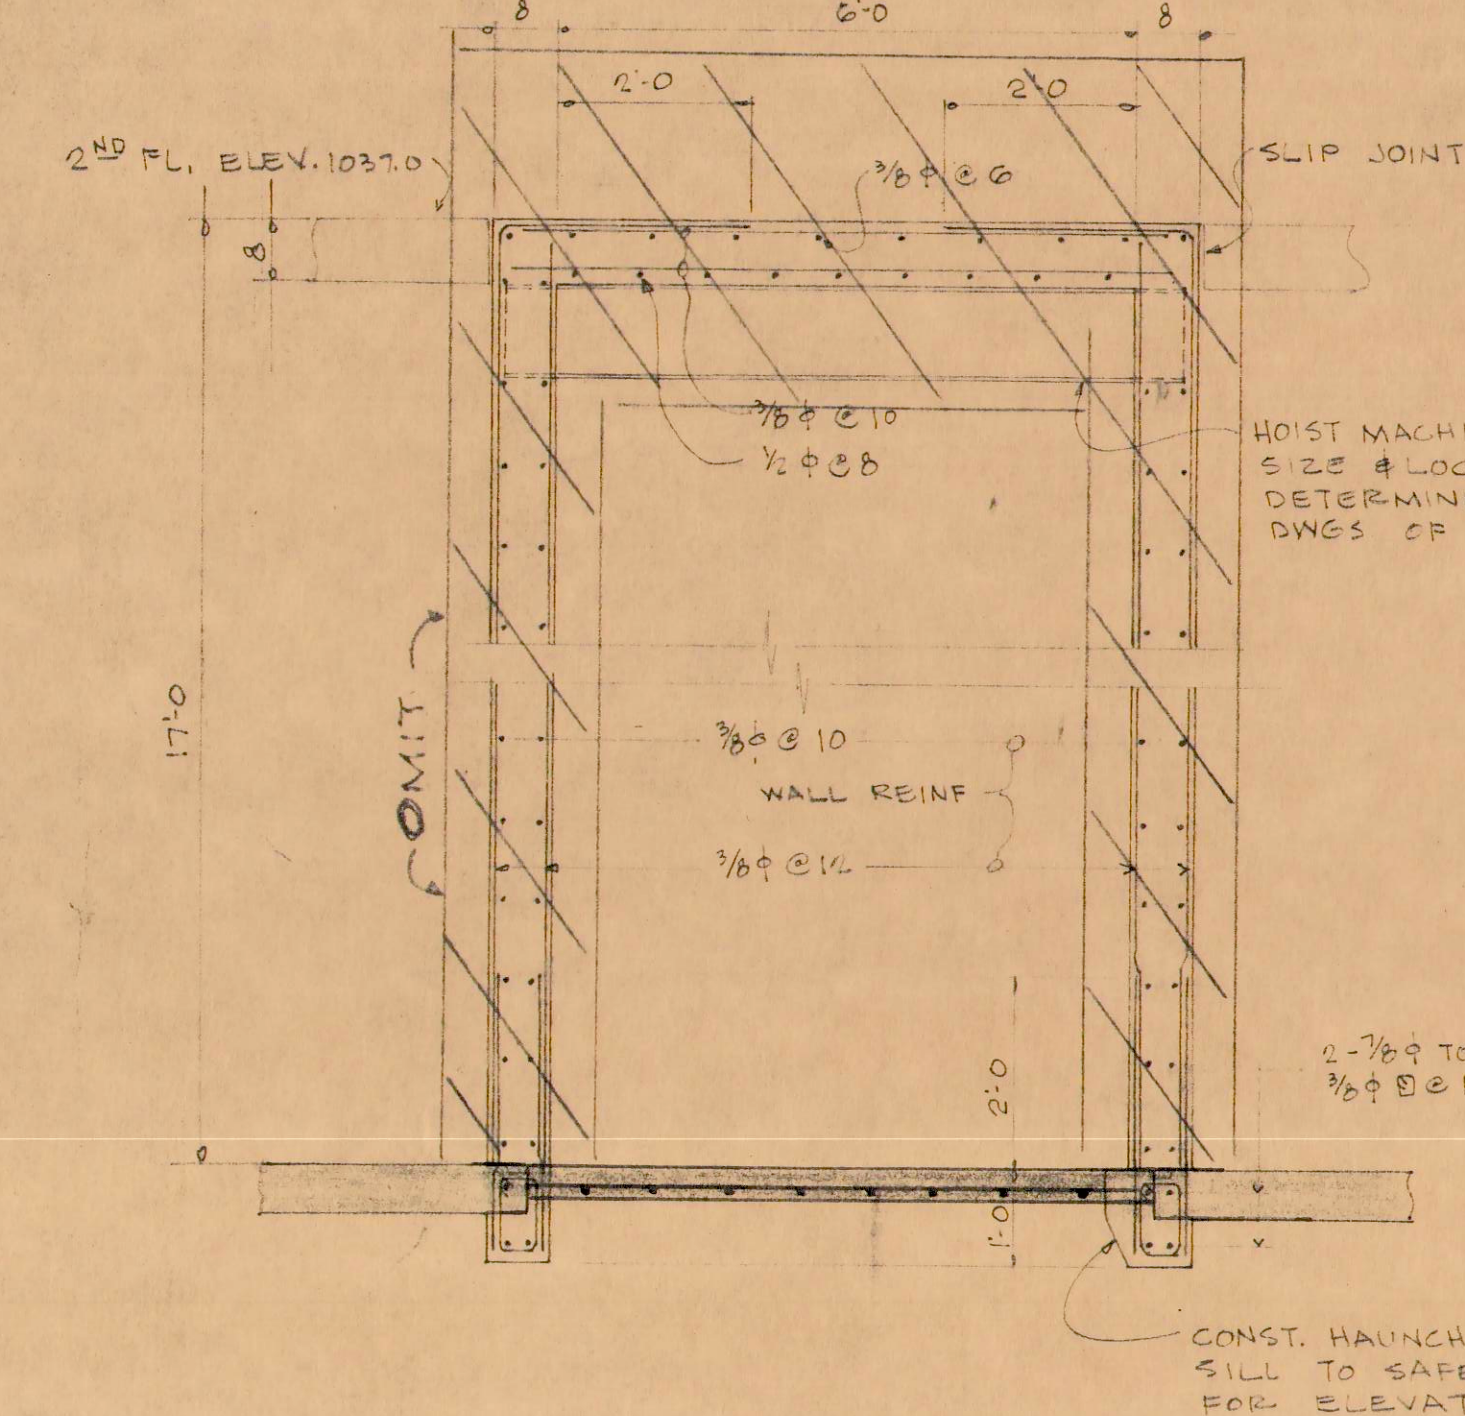


TOP SECT. OF UTILITY HOIST SHAFT

1/2" = 1'-0"

NOTE:
WHERE THIS DWG CONFLICTS
WITH DWGS ALREADY ISSUED,
THIS DWG. WILL SUPERCEDE IN
SUCH CONFLICTING ITEMS ONLY.
FOR LOCATION OF SECTIONS
SEE DWG VB-43-A
LIFTING RING DETAIL
1" = 1'-0"

SECT. "5-5"

1/4" = 1'-0"

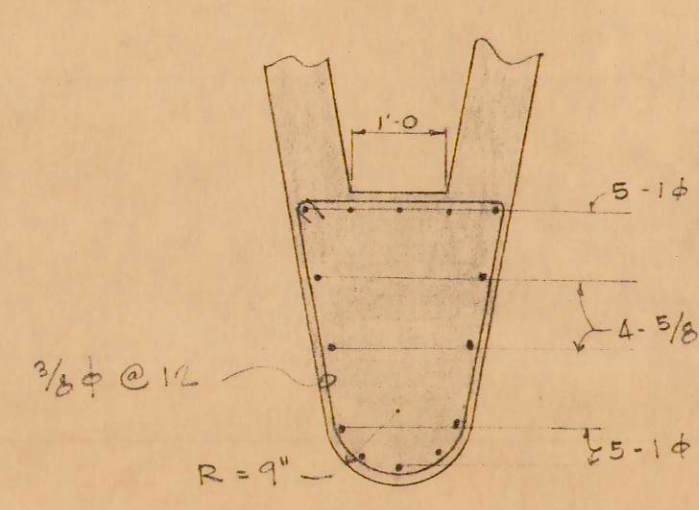

SECT. "9-9"

1/2" = 1'-0"


SECT. "7-7"

3/8" = 1'-0"

SECT. "8-8"

SECT. "6-6"

3/8" = 1'-0"

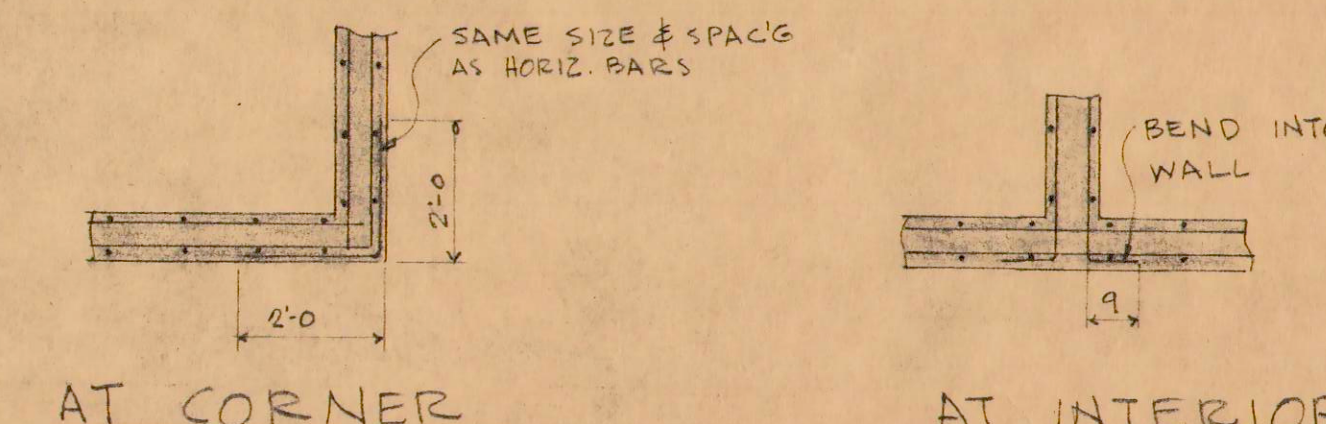

TYPICAL REINFORCING DETAILS

3/8" = 1'-0"

25-59 DETAIL CHART COVER DEPARTMENT OF PUBLIC WORKS CITY AND COUNTY OF HONOLULU BUREAU OF PLANS KALIHI TUNNEL VENTILATION BLDG.-STRUCTURAL VENT FLARE- DETAILS ENGINEER <i>[Signature]</i> DATE <i>[Date]</i> DRAFTSMAN <i>[Signature]</i> CHECKED BY <i>[Signature]</i> SCALE <i>[Scale]</i> TRACER <i>[Signature]</i> APPROVED <i>[Signature]</i> APPROVED <i>[Signature]</i> CHIEF ENGINEER BUREAU ENGINEER			
--	--	--	--