




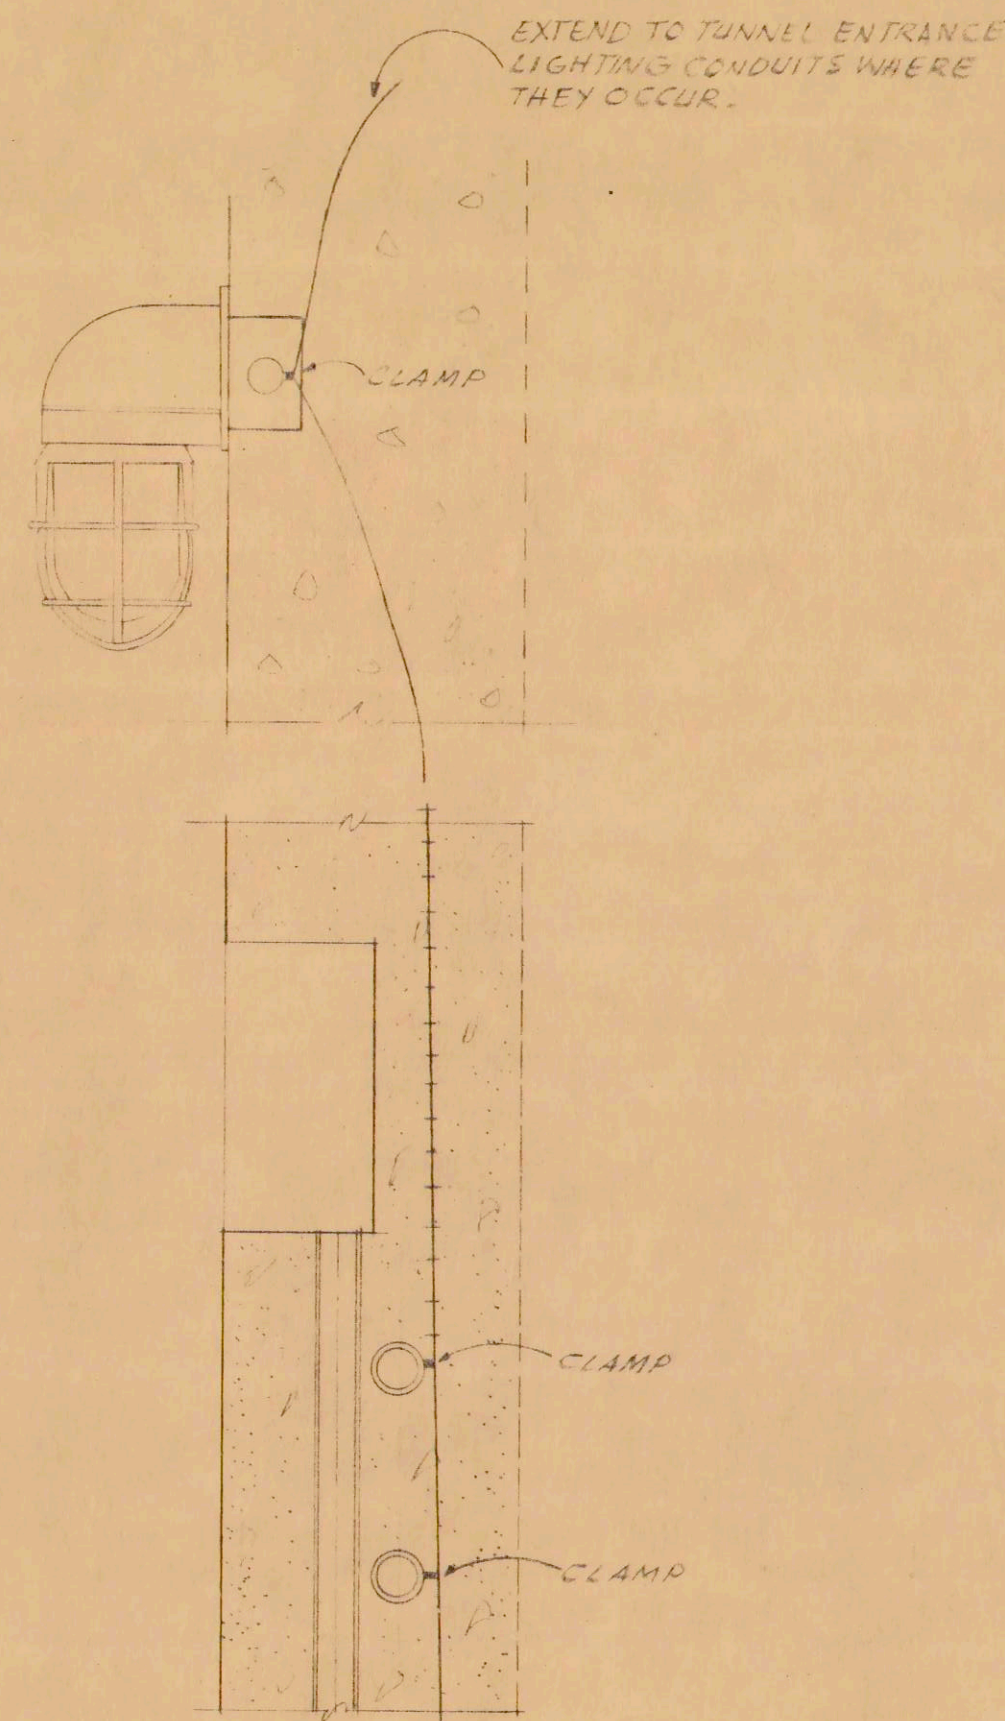


NOTE:
IF ROCK CONDITIONS MAKE INSTALLATION OF 2" GROUND ROD IMPRACTICAL, GROUND PLATES MAY BE INSTALLED IN FILL NEAR 24" CONCRETE DRAIN PIPE AND CONNECTED THROUGH #10 BARE COPPER WIRE INTO HANDHOLD.

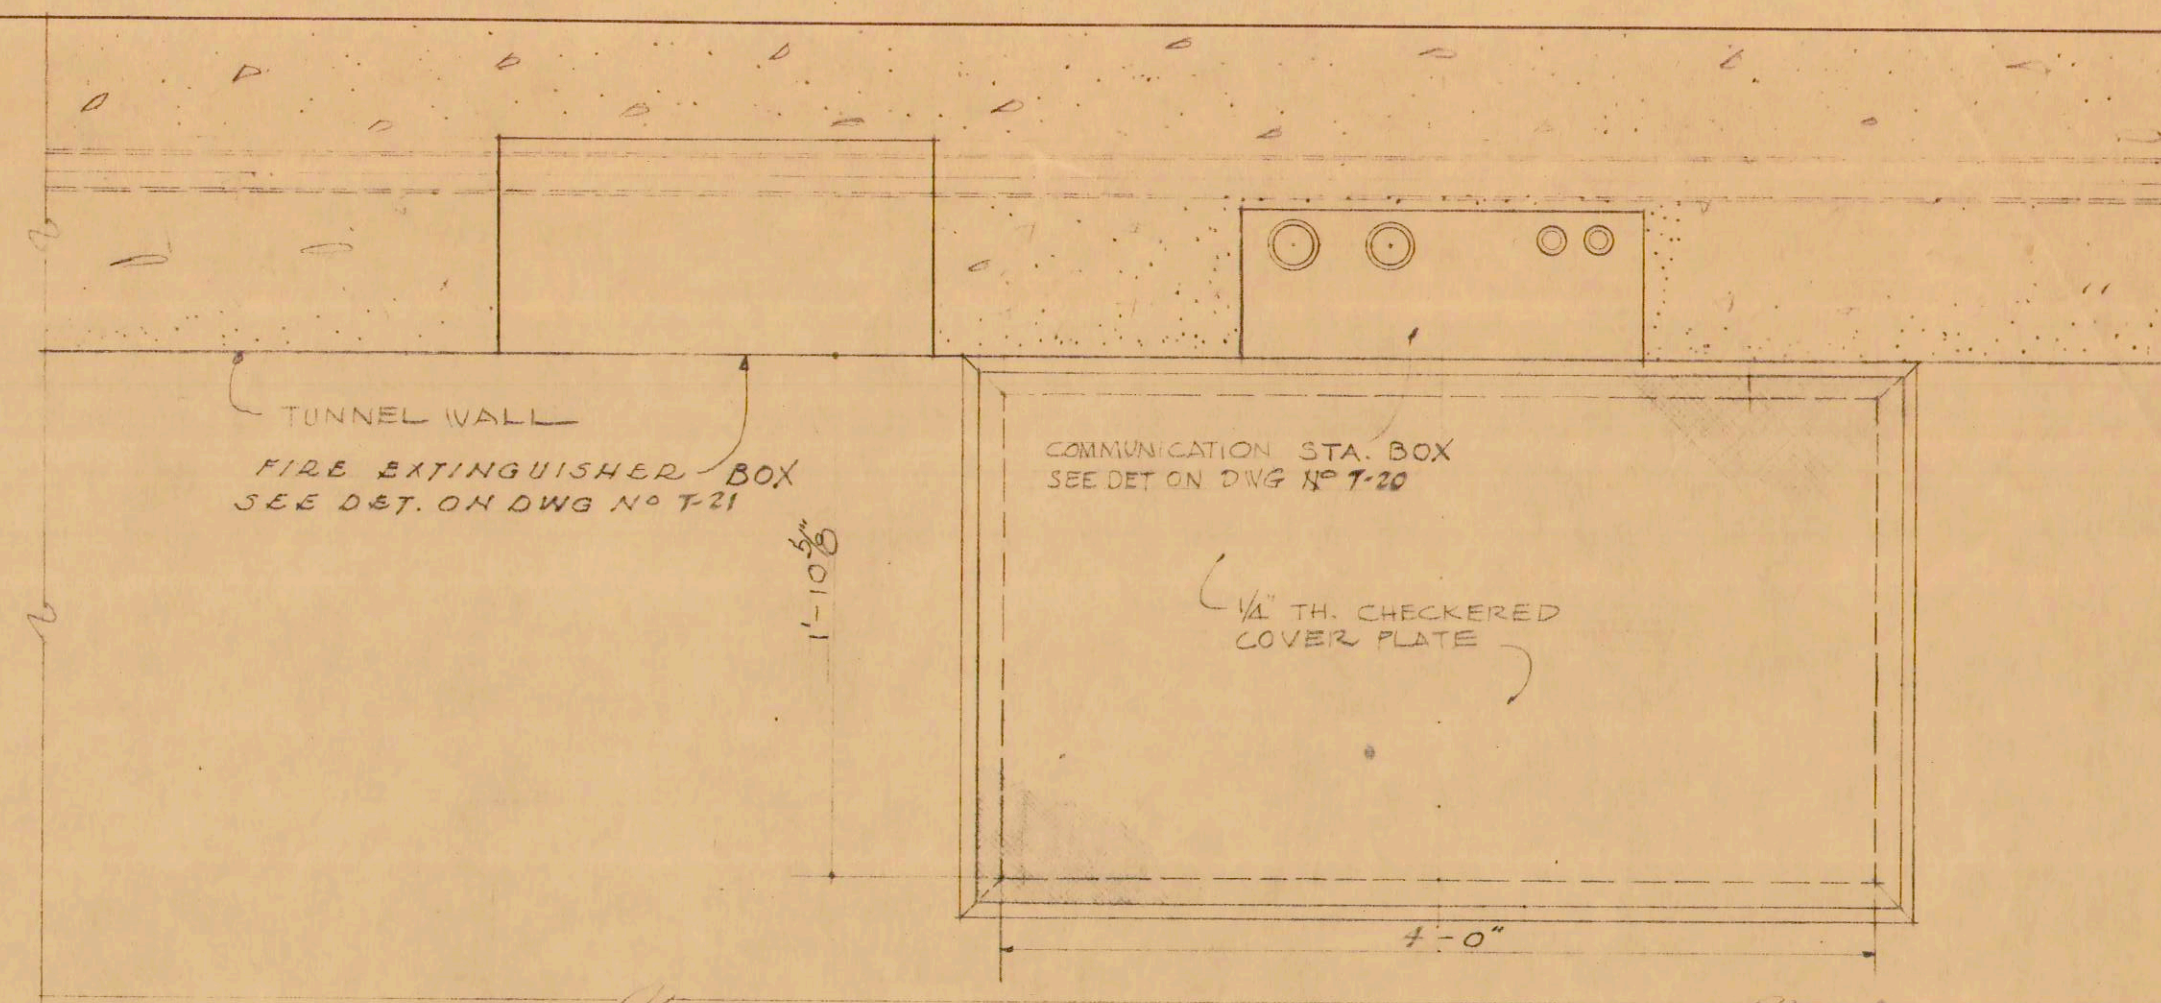


PLAN
SCALE: 1 1/2" = 1'-0"

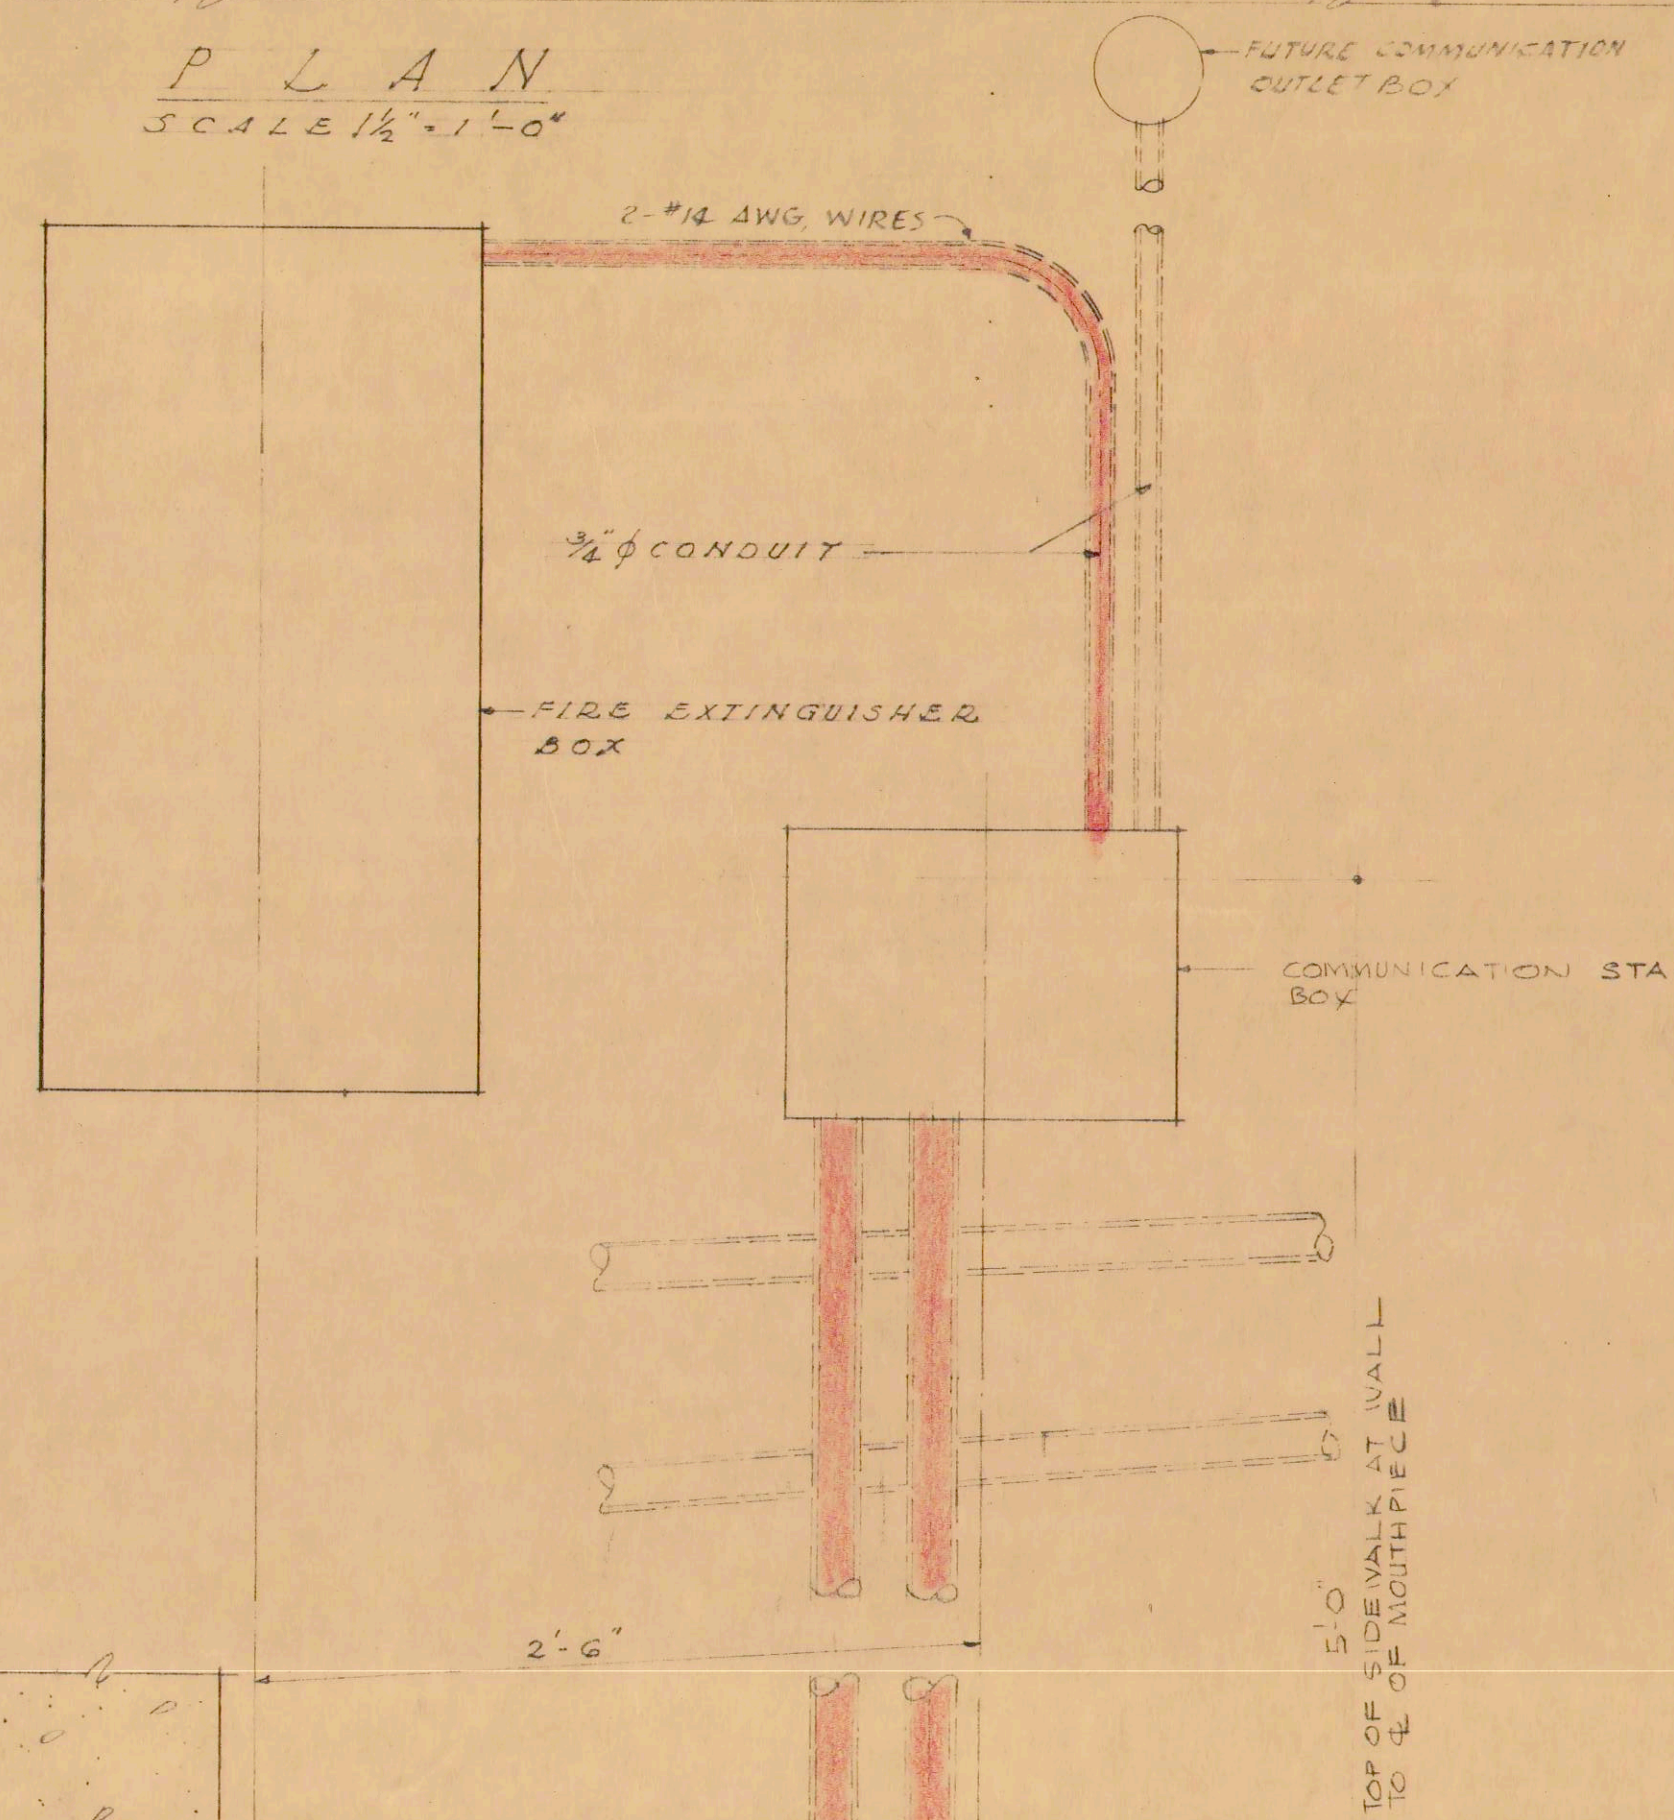


ALL CONDUCTORS OF MULTI CONDUCTOR CABLE FROM WHICH ANY CONDUCTOR IS USED AT THIS STATION SHALL BE TERMINATED ON TERMINAL STRIPS IN THE COMMUNICATION BOX.

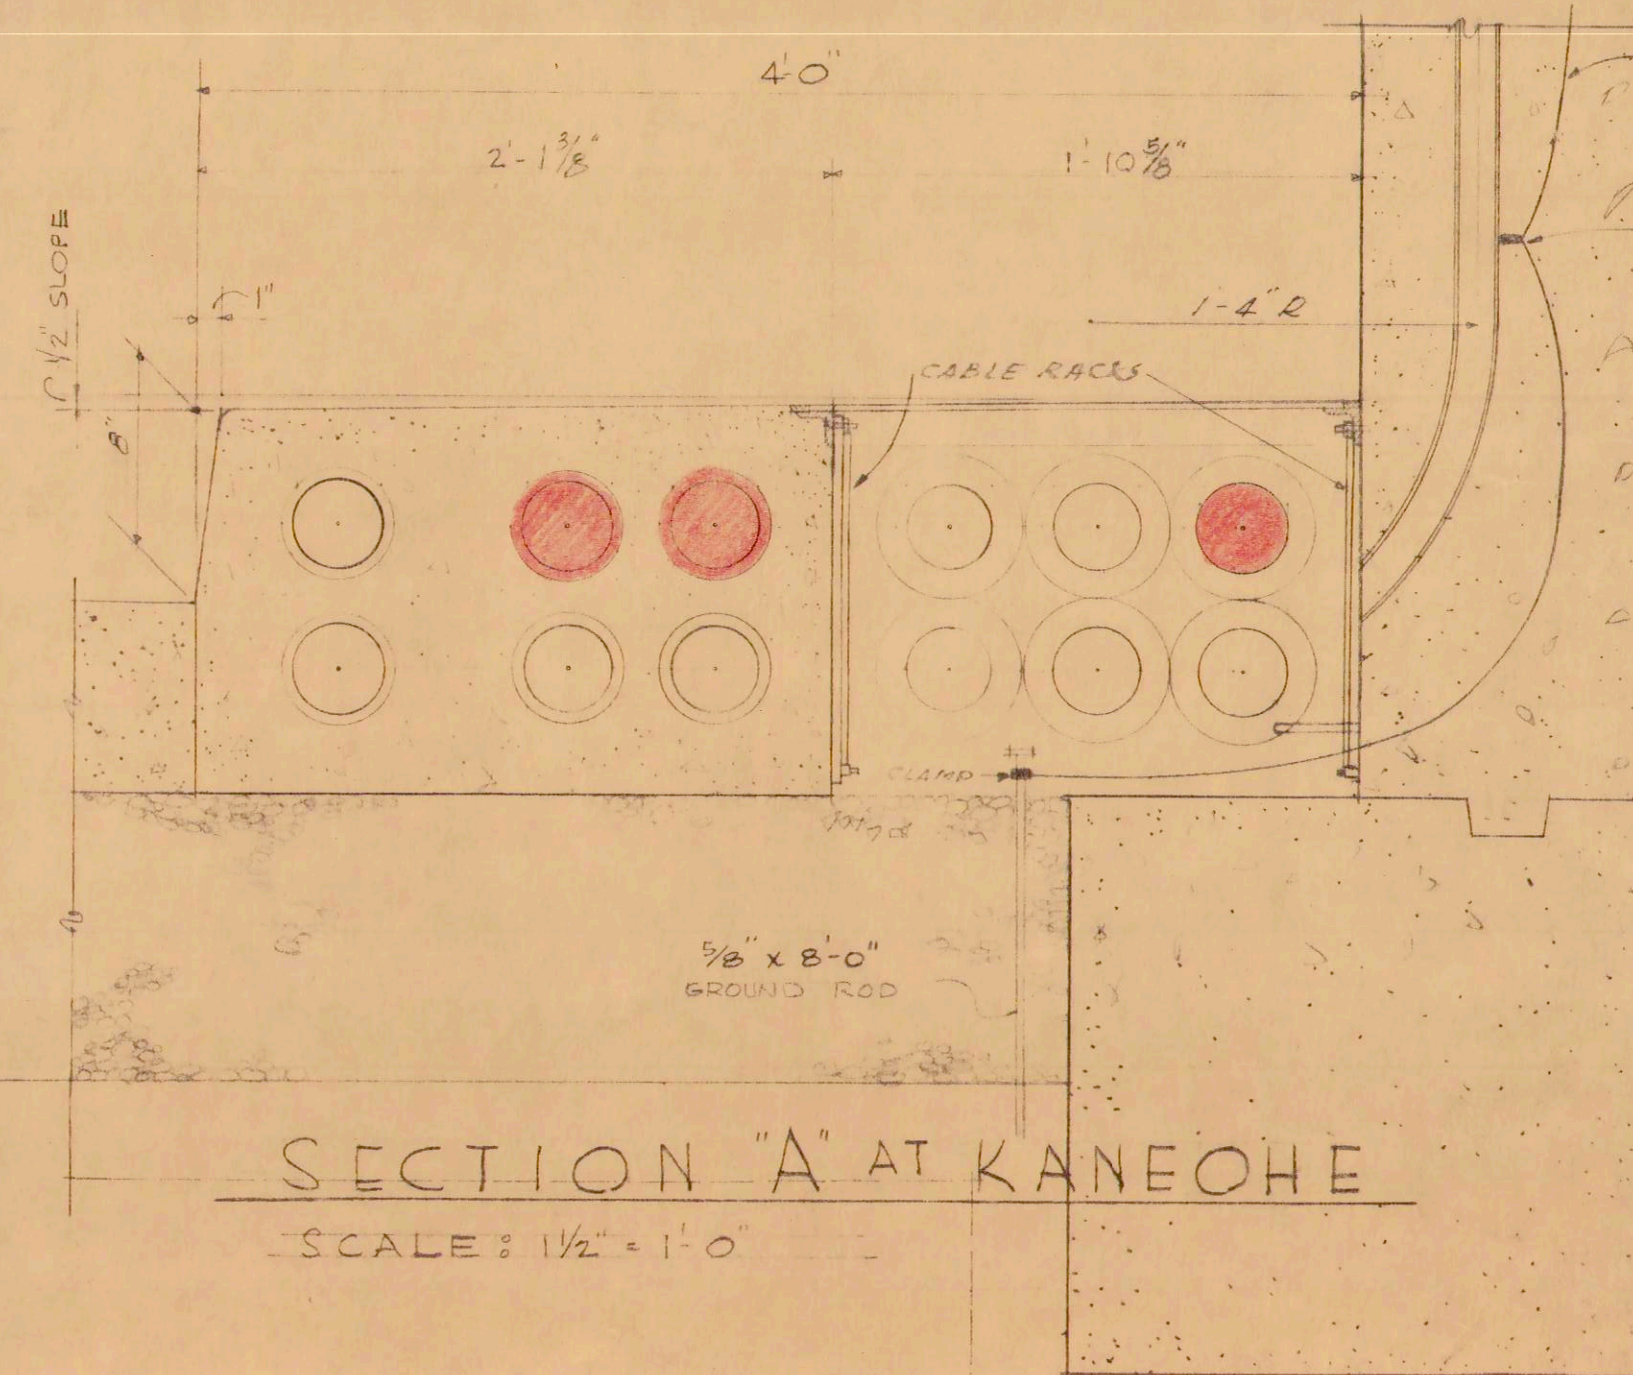

SECTION "A" AT KANEOHE
SCALE: 1 1/2" = 1'-0"

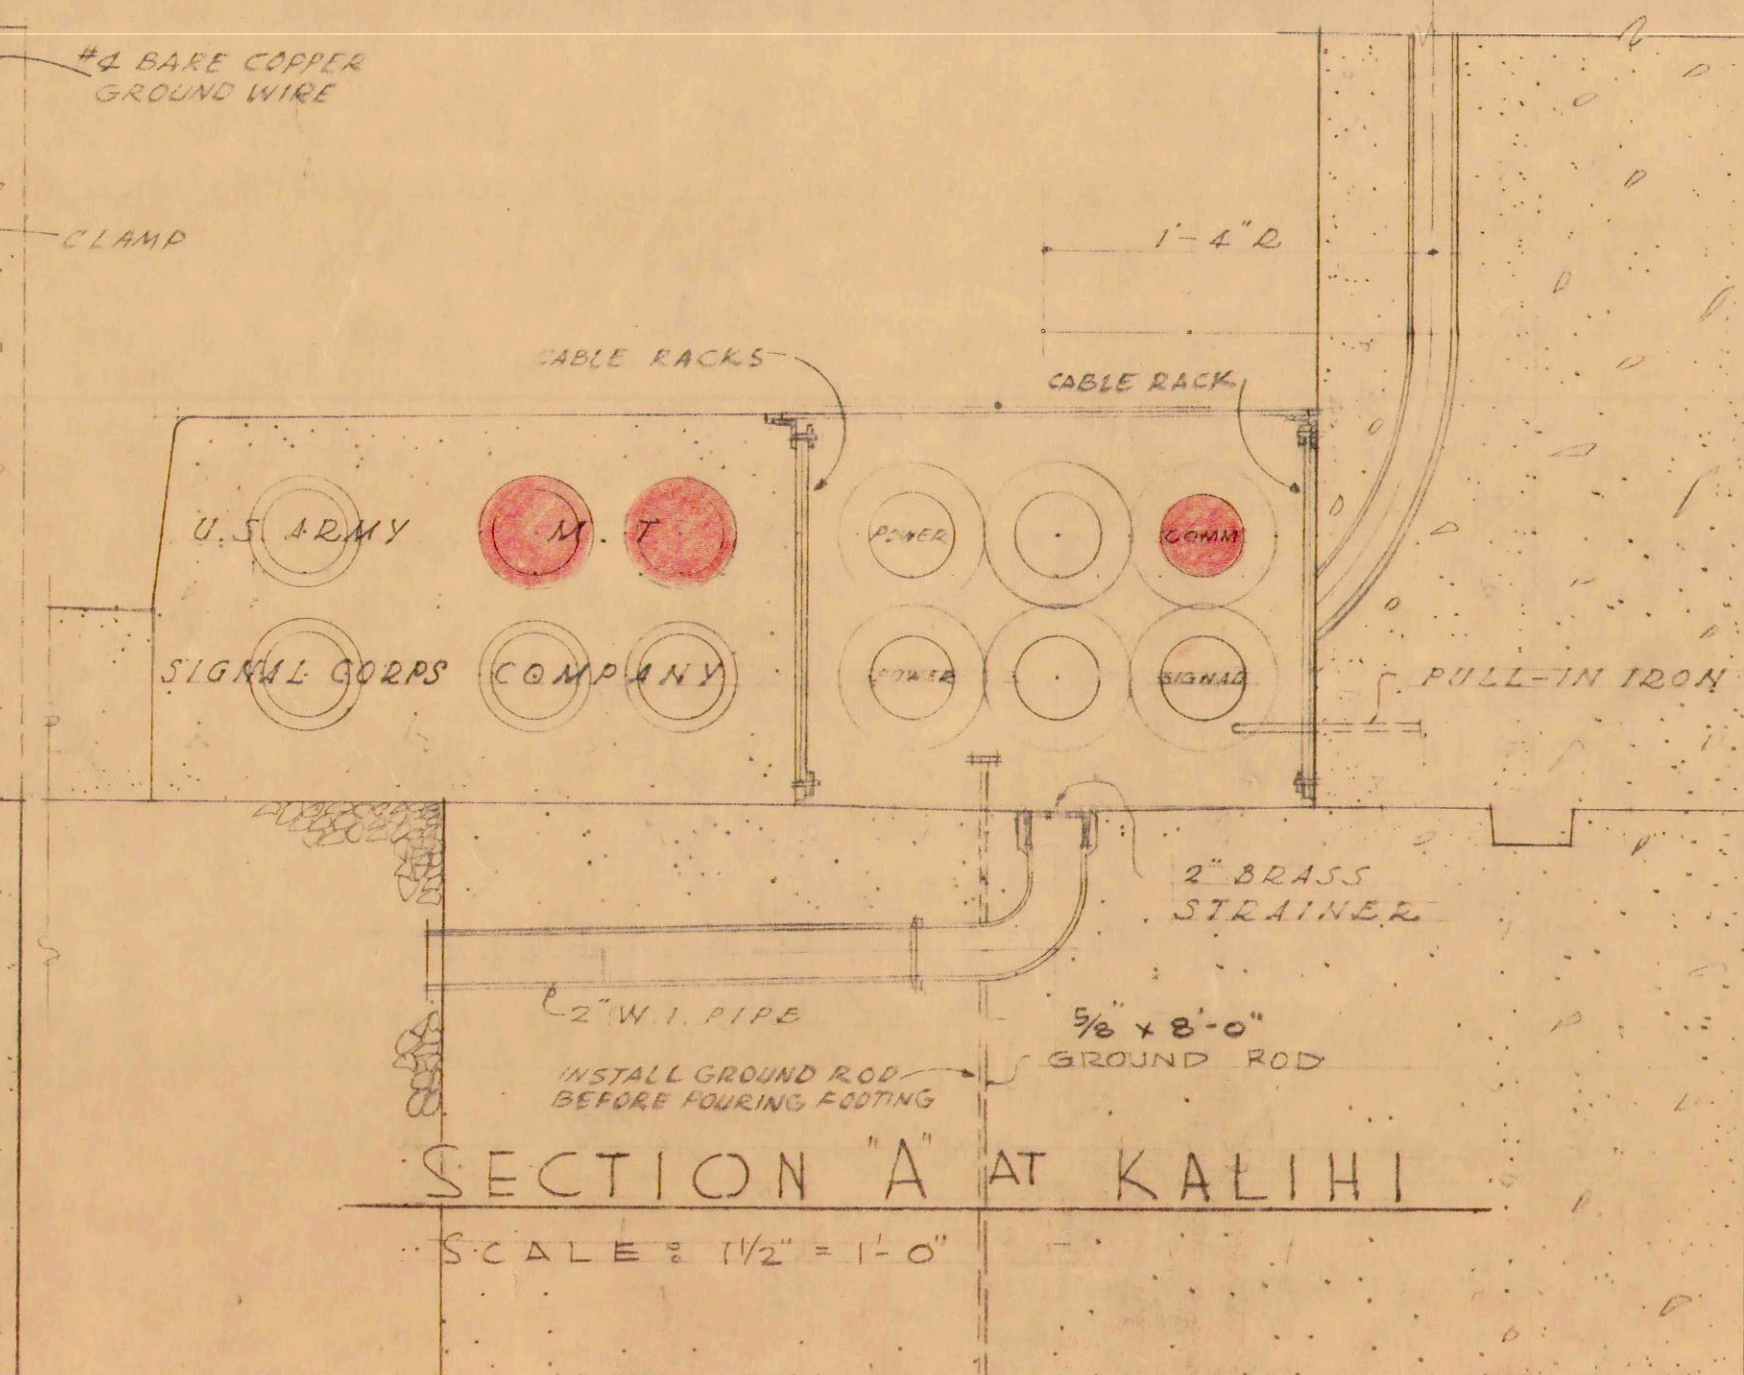

SECTION "A" AT KALIHI
SCALE: 1 1/2" = 1'-0"

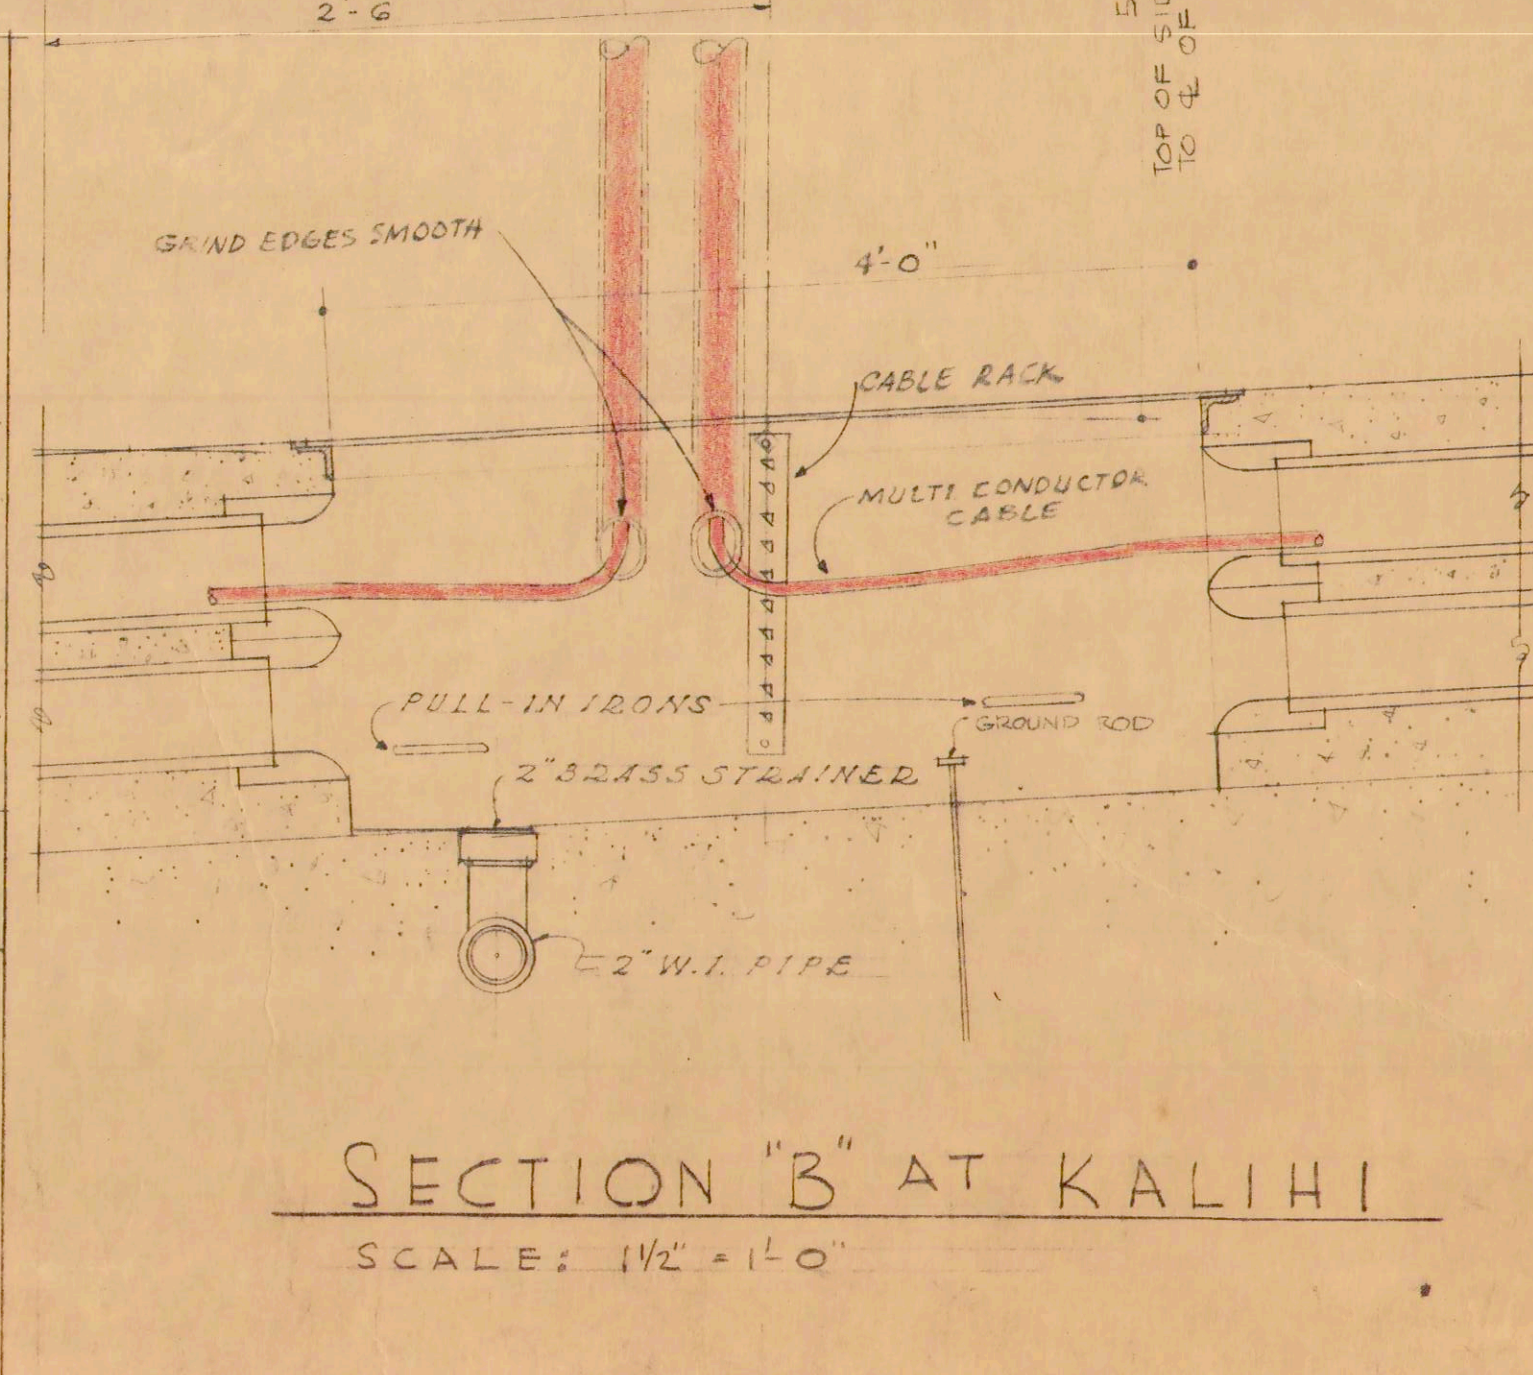

SECTION "B" AT KALIHI
SCALE: 1 1/2" = 1'-0"

LAW & WILSON ARCHITECTS & ENGINEERS			
DEPARTMENT OF PUBLIC WORKS CITY AND COUNTY OF HONOLULU			
BUREAU OF PLANS			
KALIHI TUNNEL			
ELECTRICAL - TUNNEL			
COMMUNICATION STATION DETAILS			
ENGINEER: L. B. W.	DATE: MAY 15, 1953		
DRAFTSMAN: S. H. P.	CHECKED BY: J. D. L.		
SCALE: 1/2" = 1'-0"	TRACER:		
APPROVED: <i>[Signature]</i> CHIEF ENGINEER	APPROVED: <i>[Signature]</i> BUREAU ENGINEER		
W.S. _____	PROFILE _____	C.B. _____	
CR. SEC. _____	F.B. _____	S.B. _____	
W.M. BY: _____	F.W. BY: _____	S.B.Y. _____	