



TUNNEL ENTRANCE LIGHTING
WIRING DIAGRAM - KALIHI END, (KANEHOE END SIMILAR)

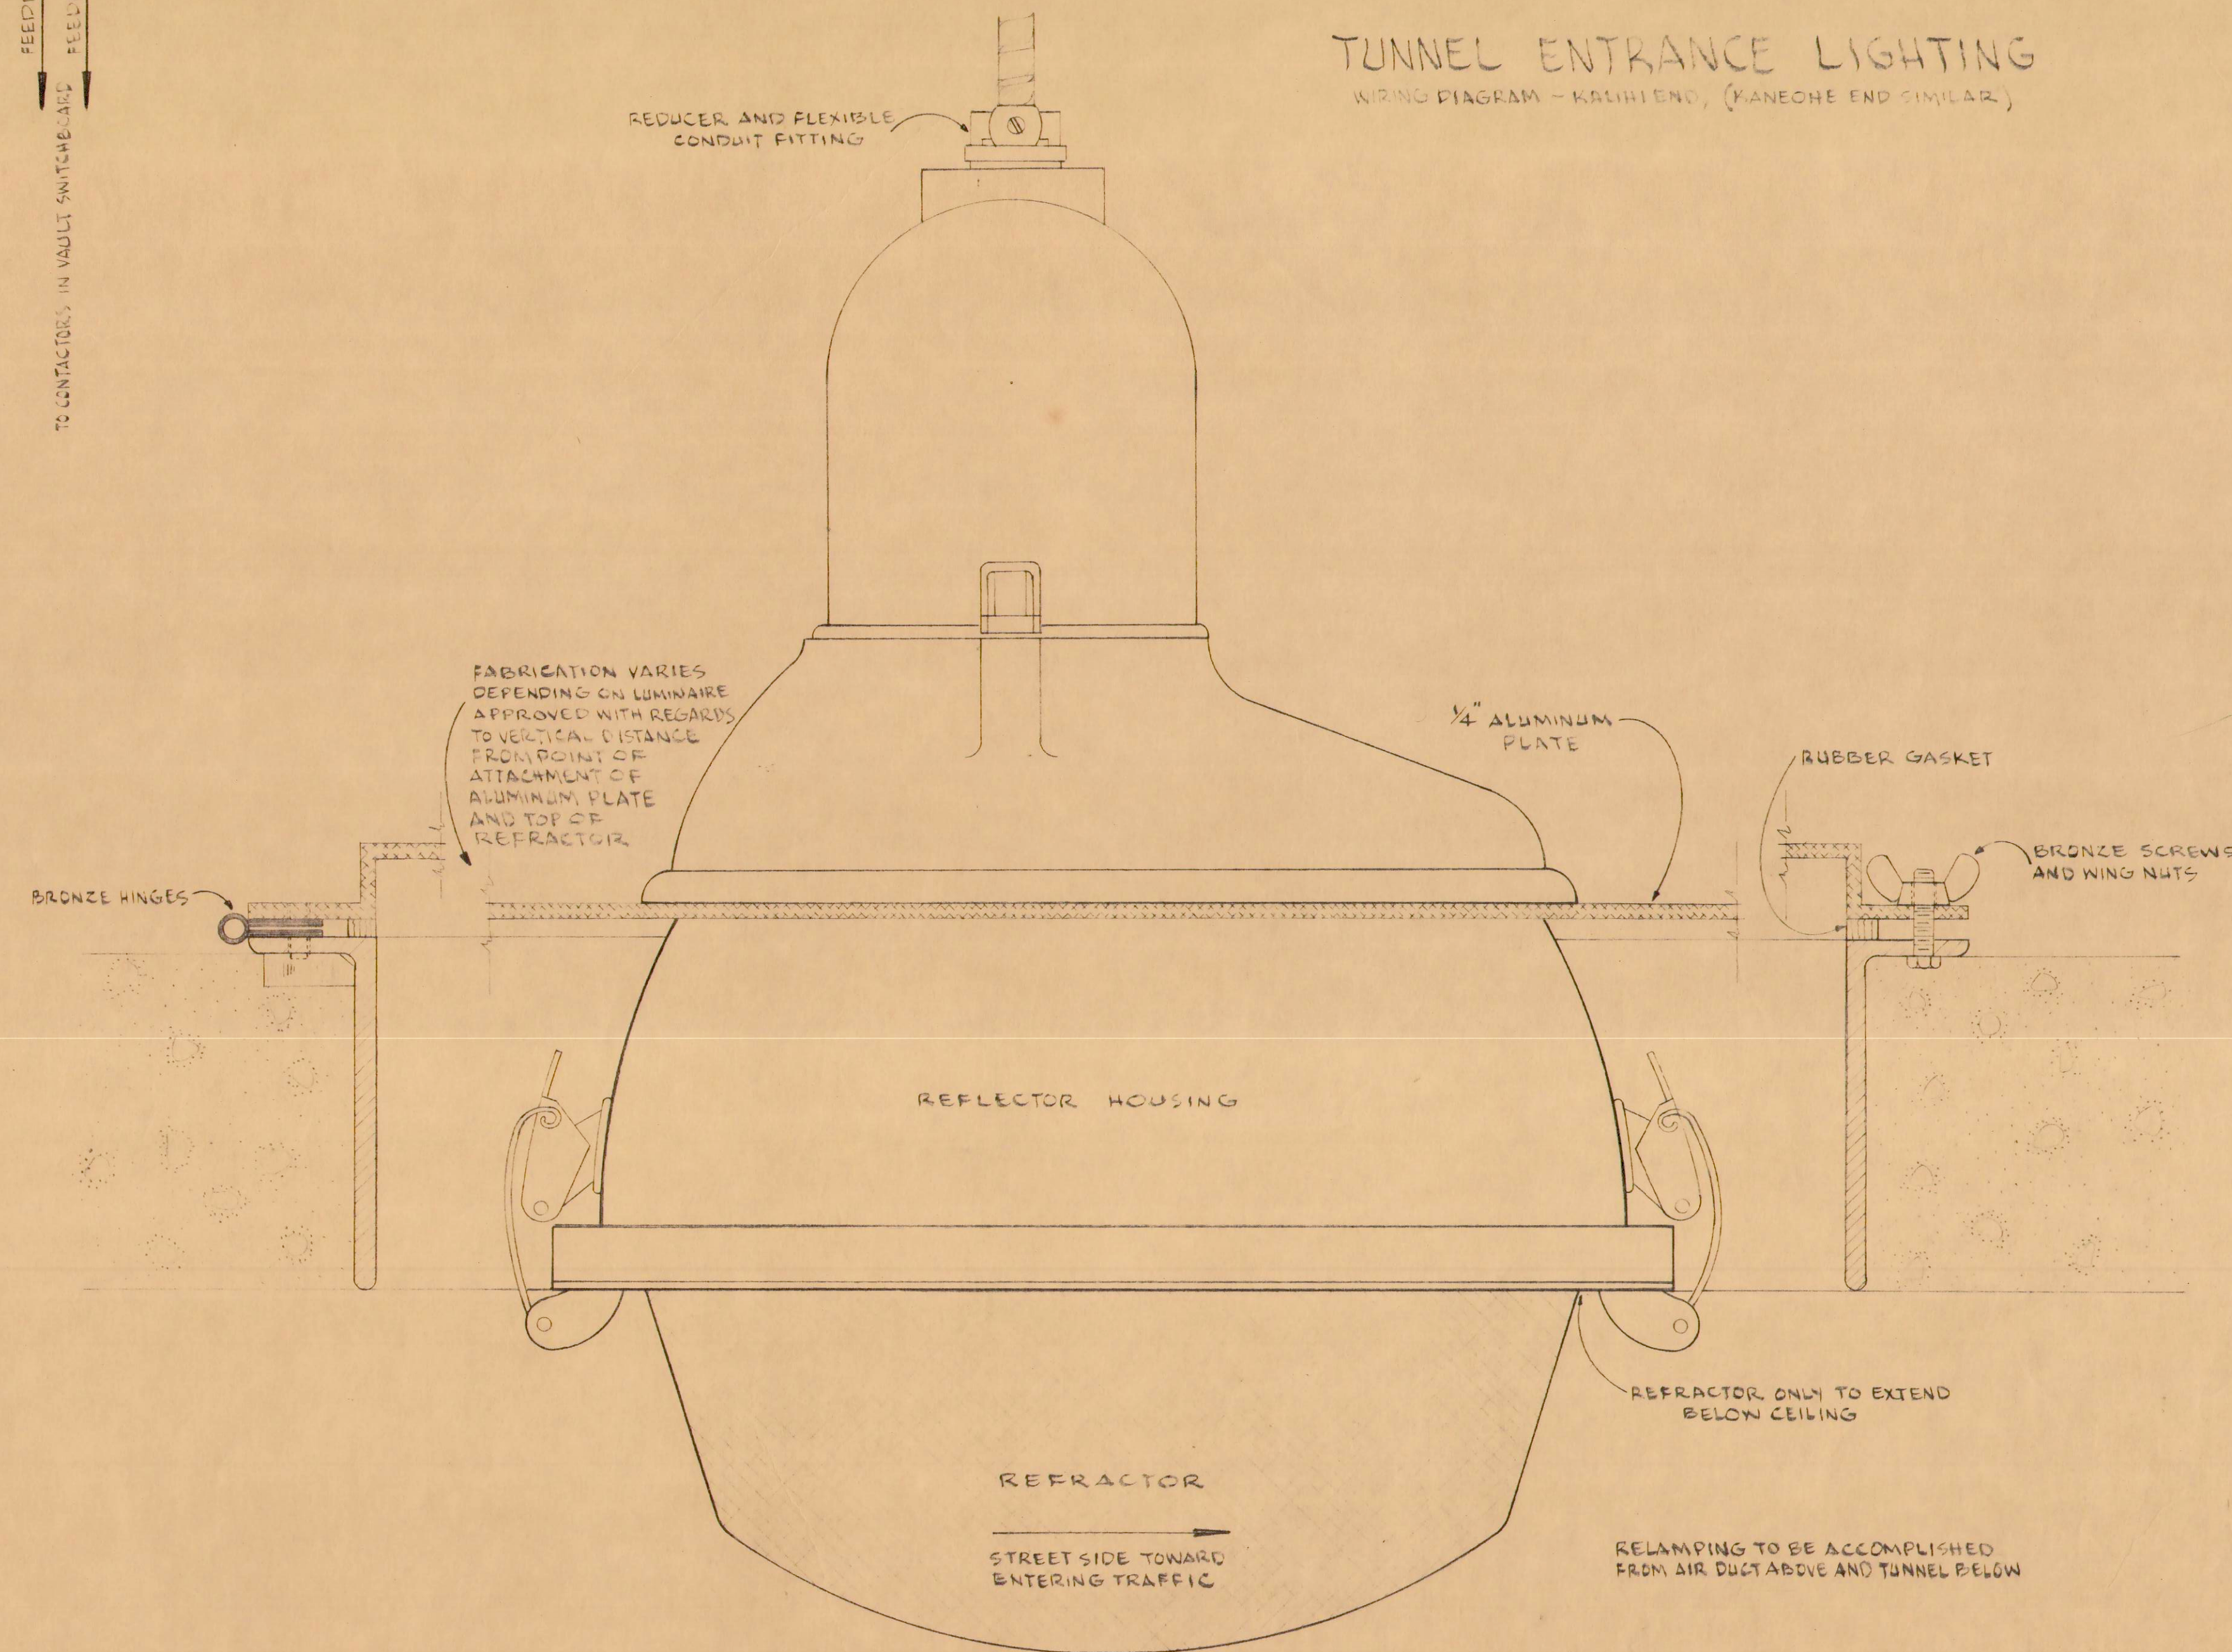

TYPICAL TUNNEL ENTRANCE LIGHTING LUMINAIRE ASSEMBLY
ON TUNNEL ENTRANCE LIGHTING BOX

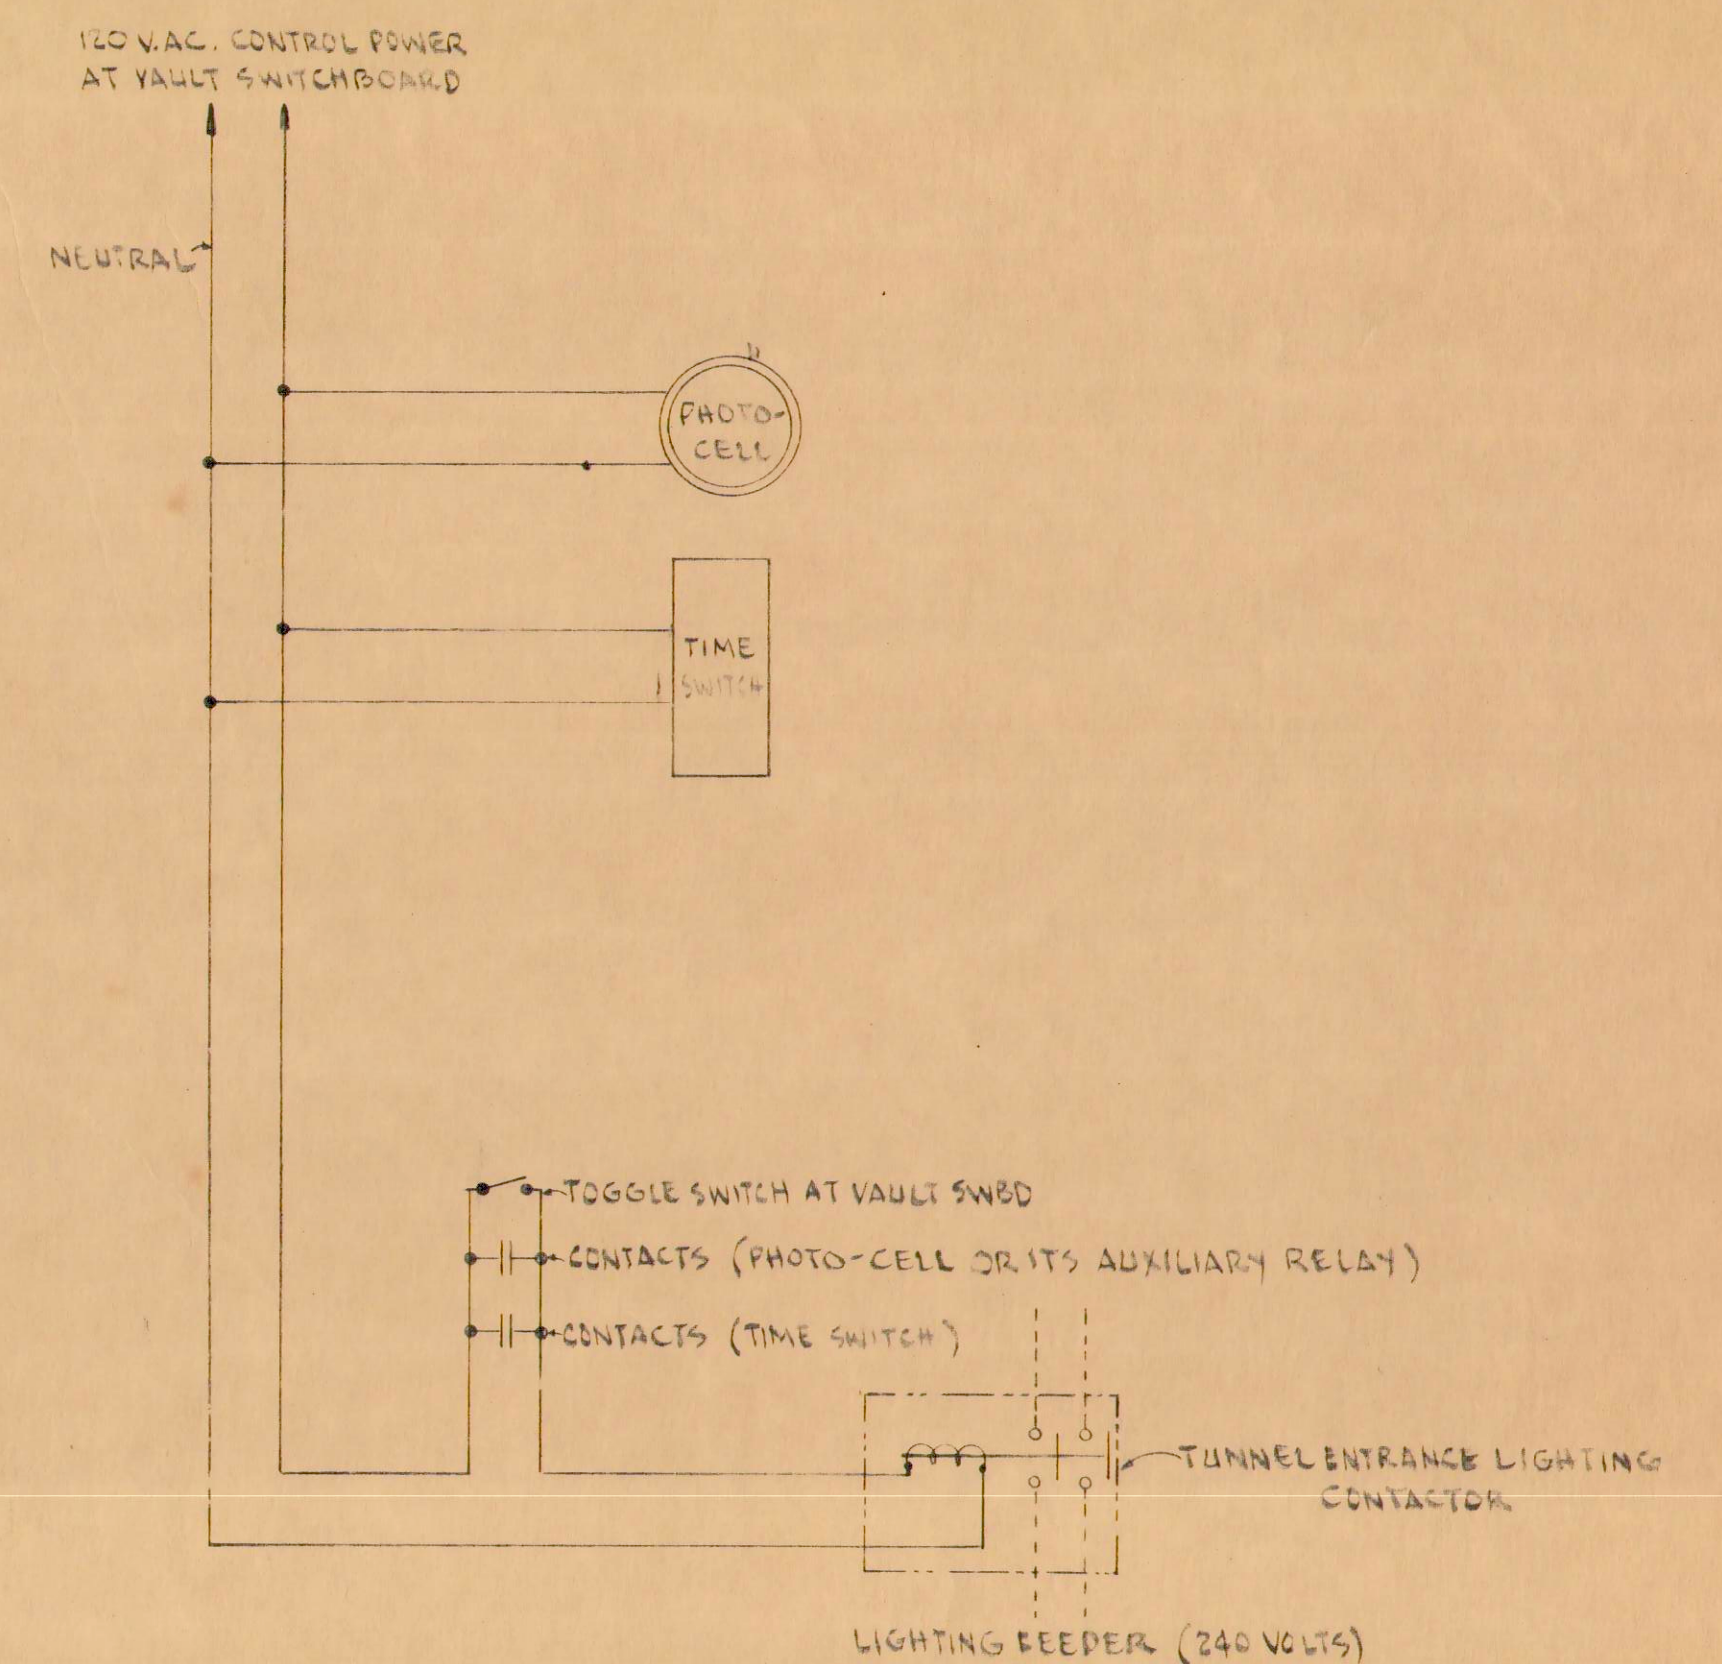

SCHEMATIC DIAGRAM
TUNNEL ENTRANCE LIGHTING CONTROL
(APPROACH ROAD LIGHTING SIMILAR)

LAW & WILSON ARCHITECTS & ENGINEERS			
DEPARTMENT OF PUBLIC WORKS CITY AND COUNTY OF HONOLULU			
BUREAU OF PLANS			
KALIHI TUNNEL			
ELECTRICAL - TUNNEL ENTRANCE LIGHTING WIRING DIAGRAM & LUMINAIRE DETAILS			
ENGINEER... J. B. W.	DATE... JULY 15, 1963		
DRAFTSMAN... S.H.P.	CHECKED BY... J.D. [Signature]		
SCALE... AS NOTED	TRACER...		
APPROVED... [Signature] CHIEF ENGINEER	APPROVED... [Signature] BUREAU ENGINEER		
W.S. CR. SEC. W.M. BY:	PROFILE F.B. F.W. BY:	C.B. S.B. S.B.:	

SECTION C JOB NO. 26-53 DWG. E-5