


TUNNEL INTERIOR LIGHTING - ONE LINE DIAGRAM

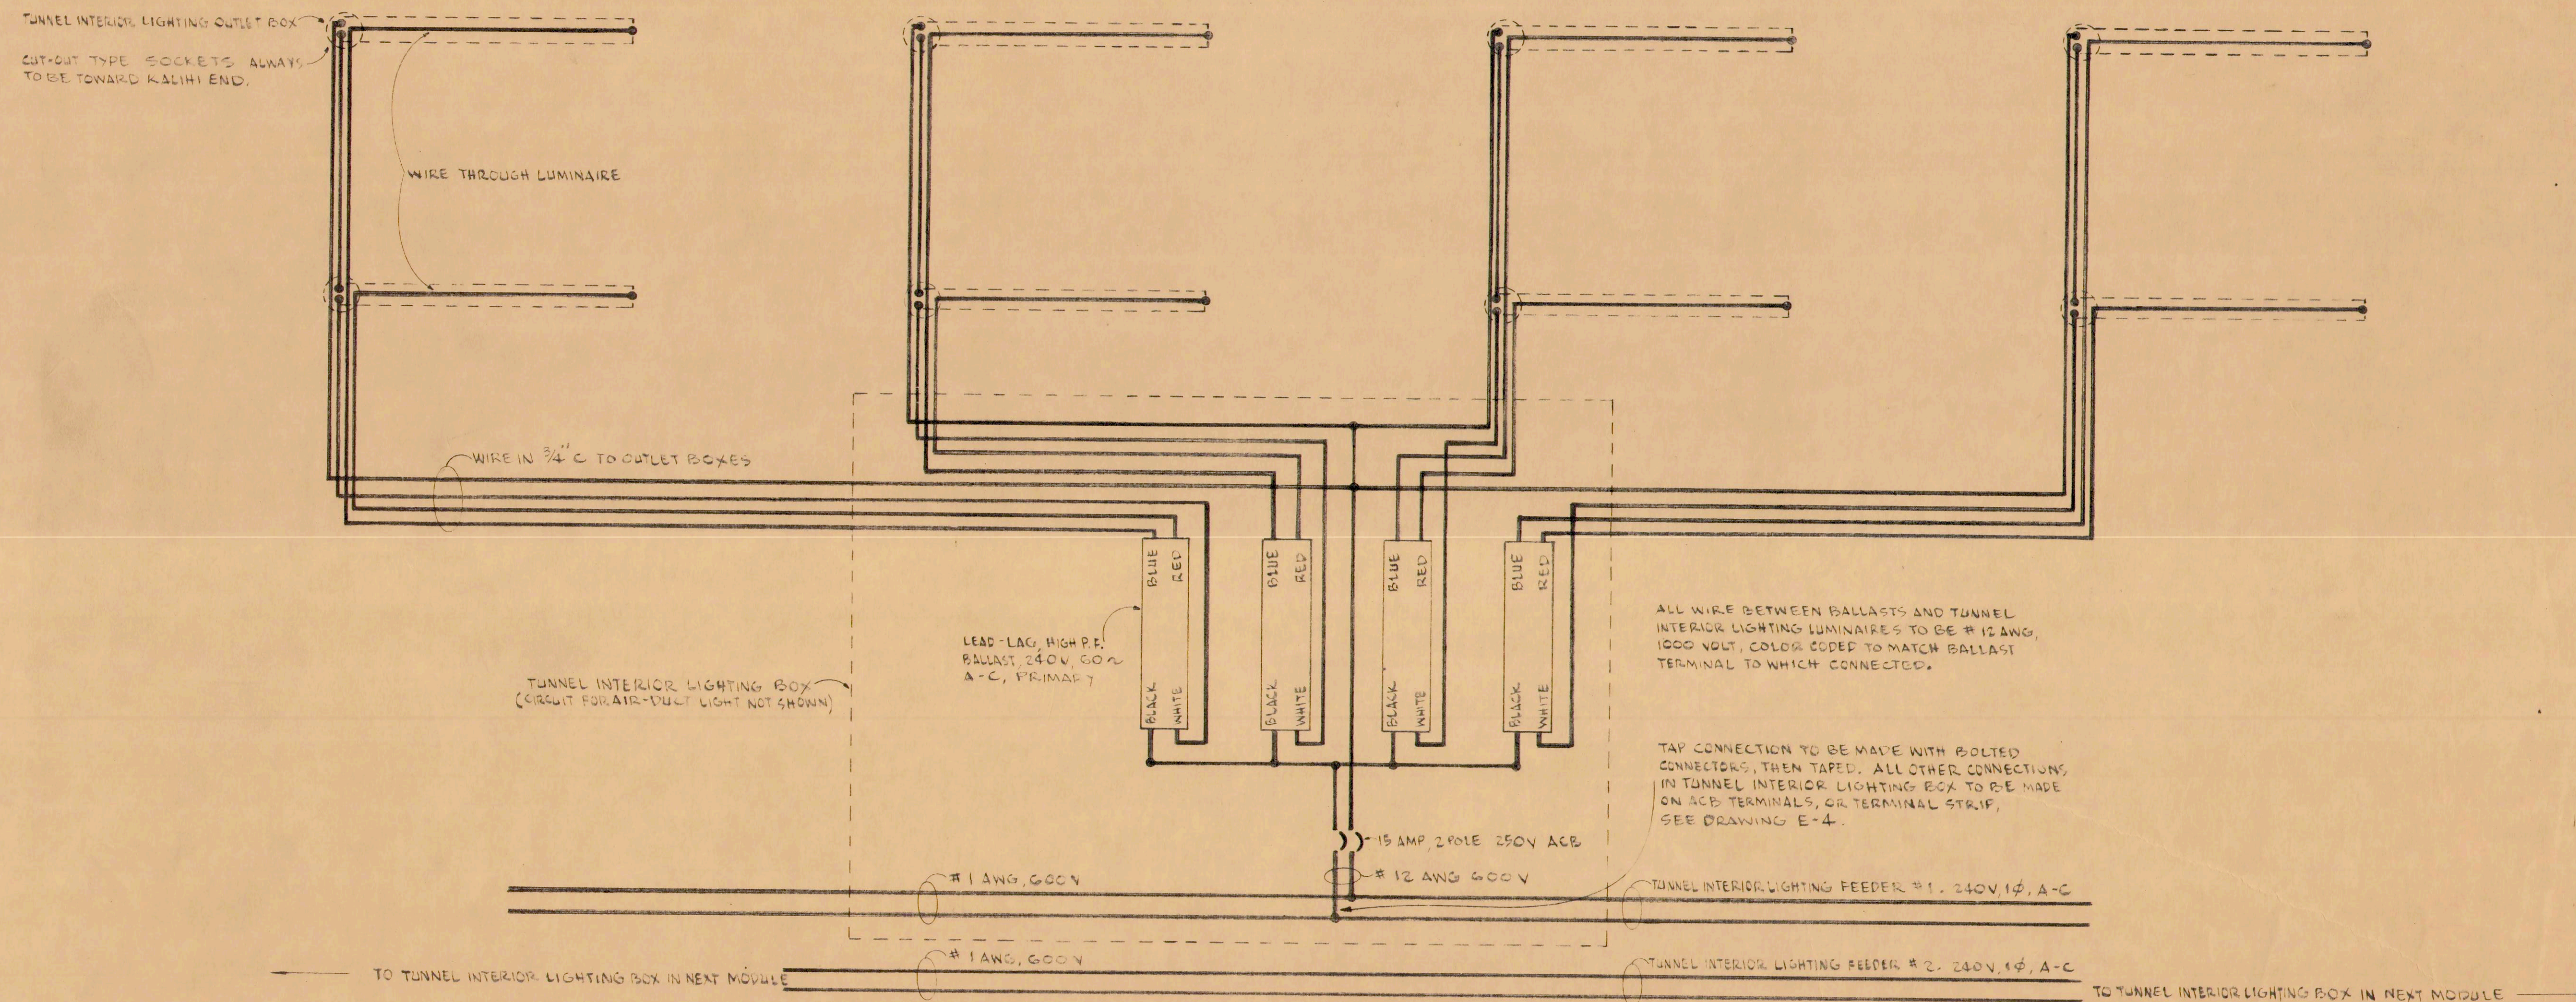

TUNNEL INTERIOR LIGHTING WIRING DIAGRAM WITHIN ONE MODULE

LAW & WILSON
ARCHITECTS & ENGINEERS

DEPARTMENT OF PUBLIC WORKS
CITY AND COUNTY OF HONOLULU
BUREAU OF PLANS

KALIHI TUNNEL
ELECTRICAL-TUNNEL
INTERIOR LIGHTING WIRING DIAGRAM

ENGINEER: J. B. W. DATE: JULY 15, 1968
DRAFTSMAN: S. H. P. CHECKED BY: S. H. P.
SCALE: NO. SCALE TRACER: S. H. P.
APPROVED: [Signature] CHIEF ENGINEER APPROVED: [Signature] BUREAU ENGINEER

APPROVED: [Signature] ENGINEER, KALIHI TUNNEL

W.S. CR. SEC. W.M.B.Y. PROFILE F.B. F.W.B.Y. C.B. S.B. S.B.Y.

SECTION C JOB NO. 26-53 DWG. E-2