


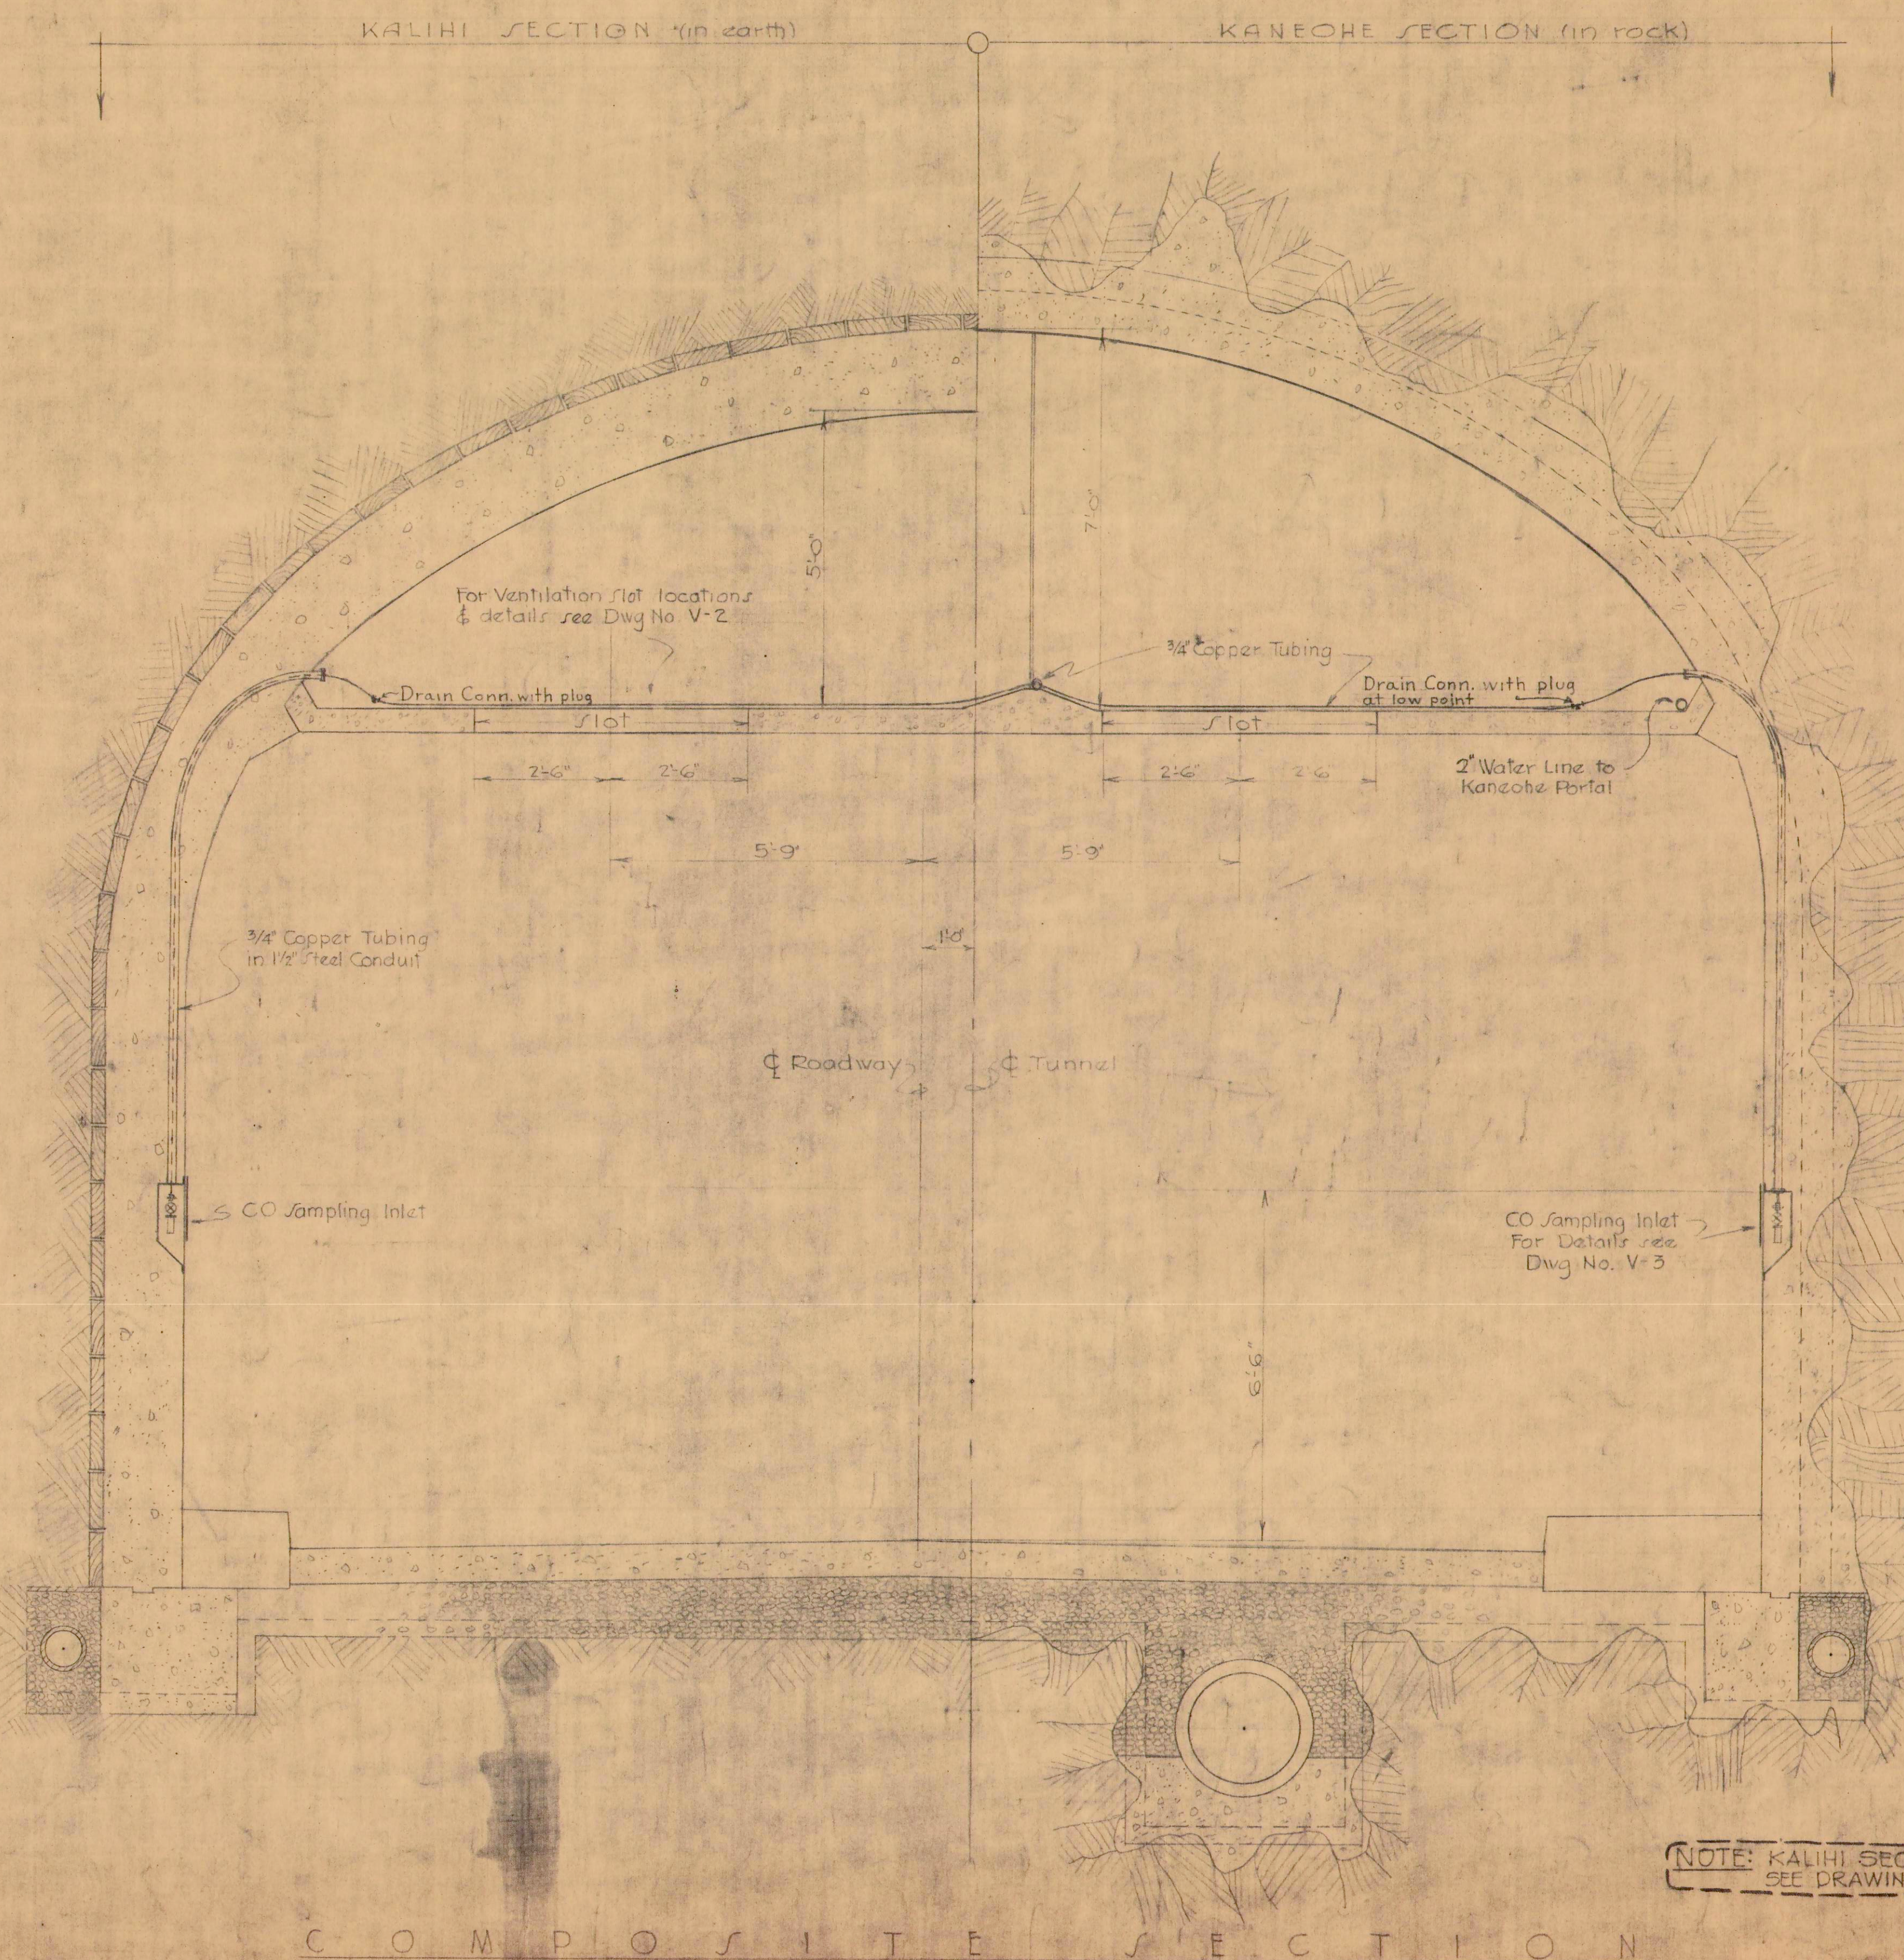

NOTE: KALIHI SECTION REVISED.
SEE DRAWINGS T-5 & T-5A.

C O M P O S I T E S E C T I O N

APPROVED: *[Signature]*
ENGINEER, KALIHI TUNNEL

SECTION C

1	4-16-56	SEE NOTE	E.W.	JD
REVISION	DATE	DESCRIPTION	MADE BY	CHEK BY

LAW & WILSON
ARCHITECTS & ENGINEERS
DEPARTMENT OF PUBLIC WORKS
CITY AND COUNTY OF HONOLULU
BUREAU OF PLANS
KALIHI TUNNEL
VENTILATION
TUNNEL SECTION

ENGINEER: L. B. W. DATE: JULY 15, 1953
DRAFTSMAN: C. H. CHECKED BY: E. M. [Signature]
SCALE: 1/2" = 1'-0" TRACER:
APPROVED: *[Signature]* APPROVED: *[Signature]*
CHIEF ENGINEER BUREAU ENGINEER

W. S.	PROFILE	C. D.
CR. SEC.	F. B.	S. B.
W. M. BY:	F. W. BY:	S. BY:

JOB NO. 26-53 DWG. V-2