
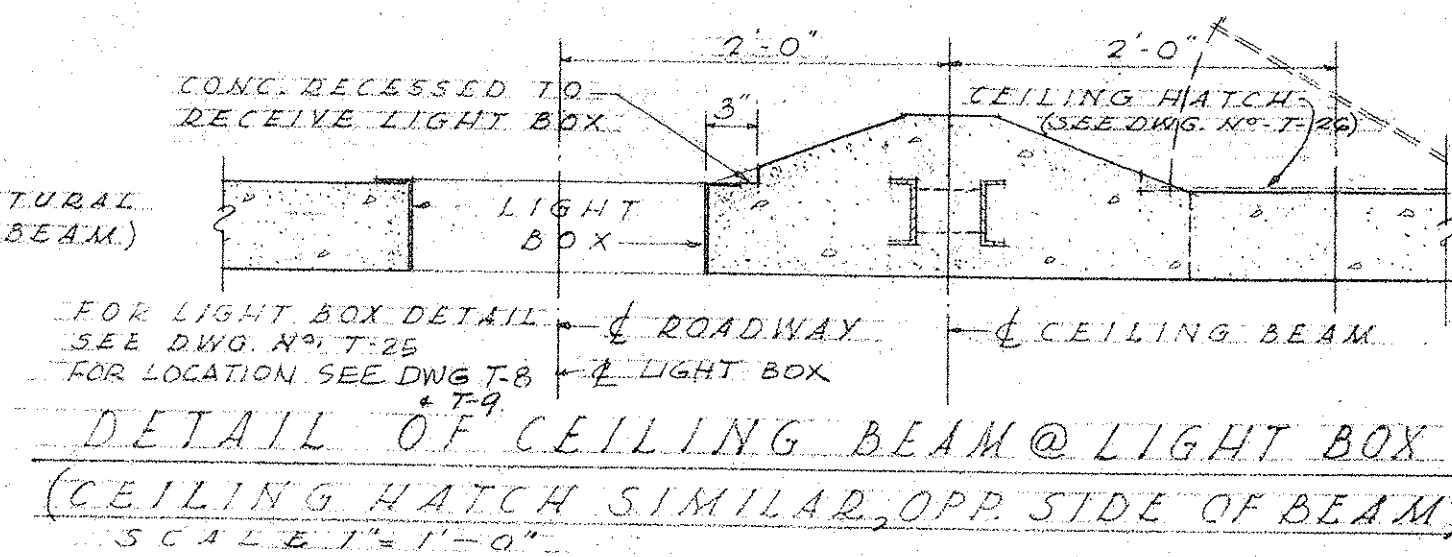
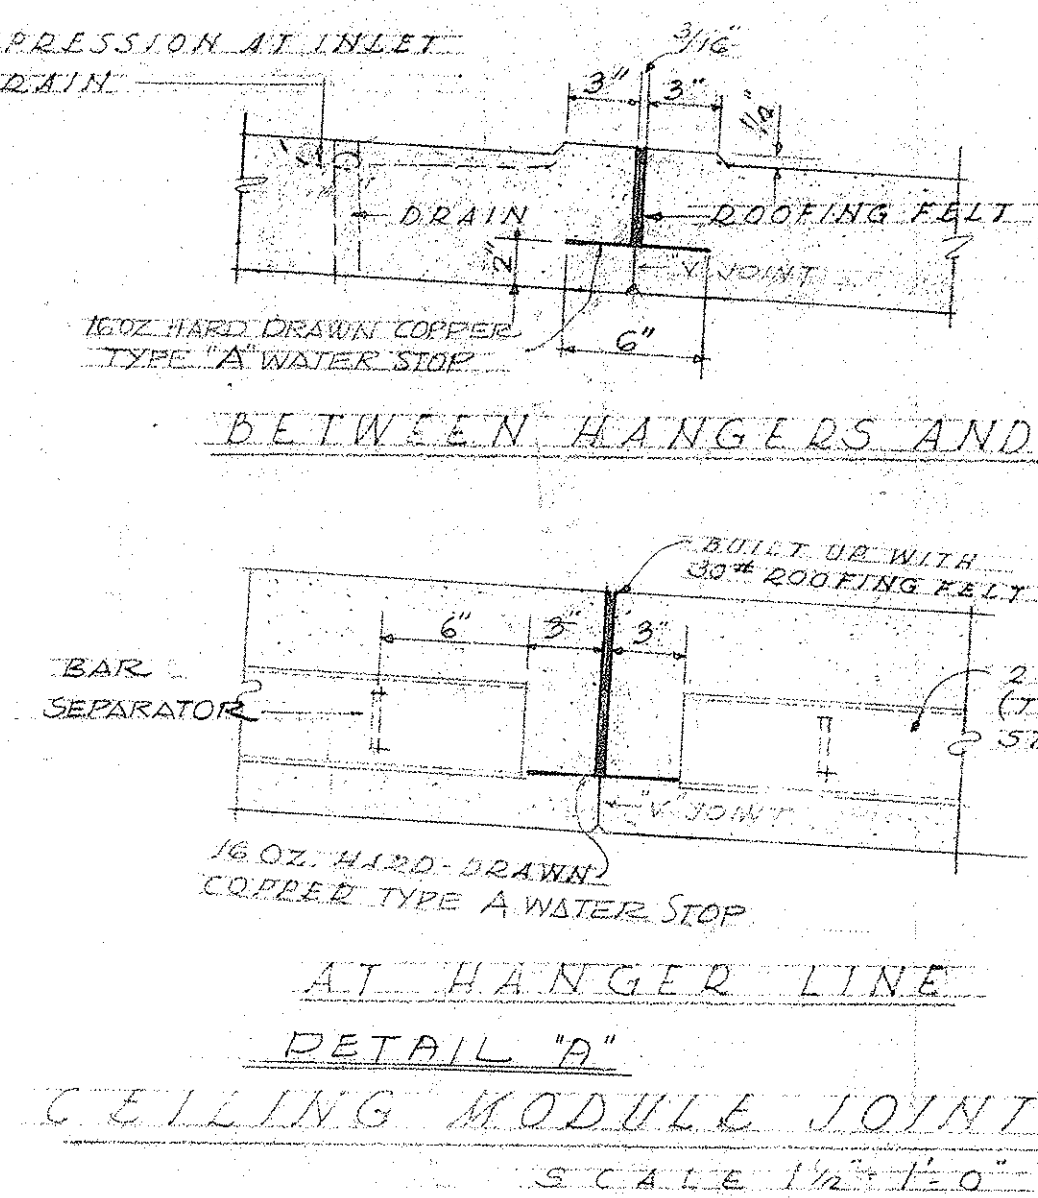
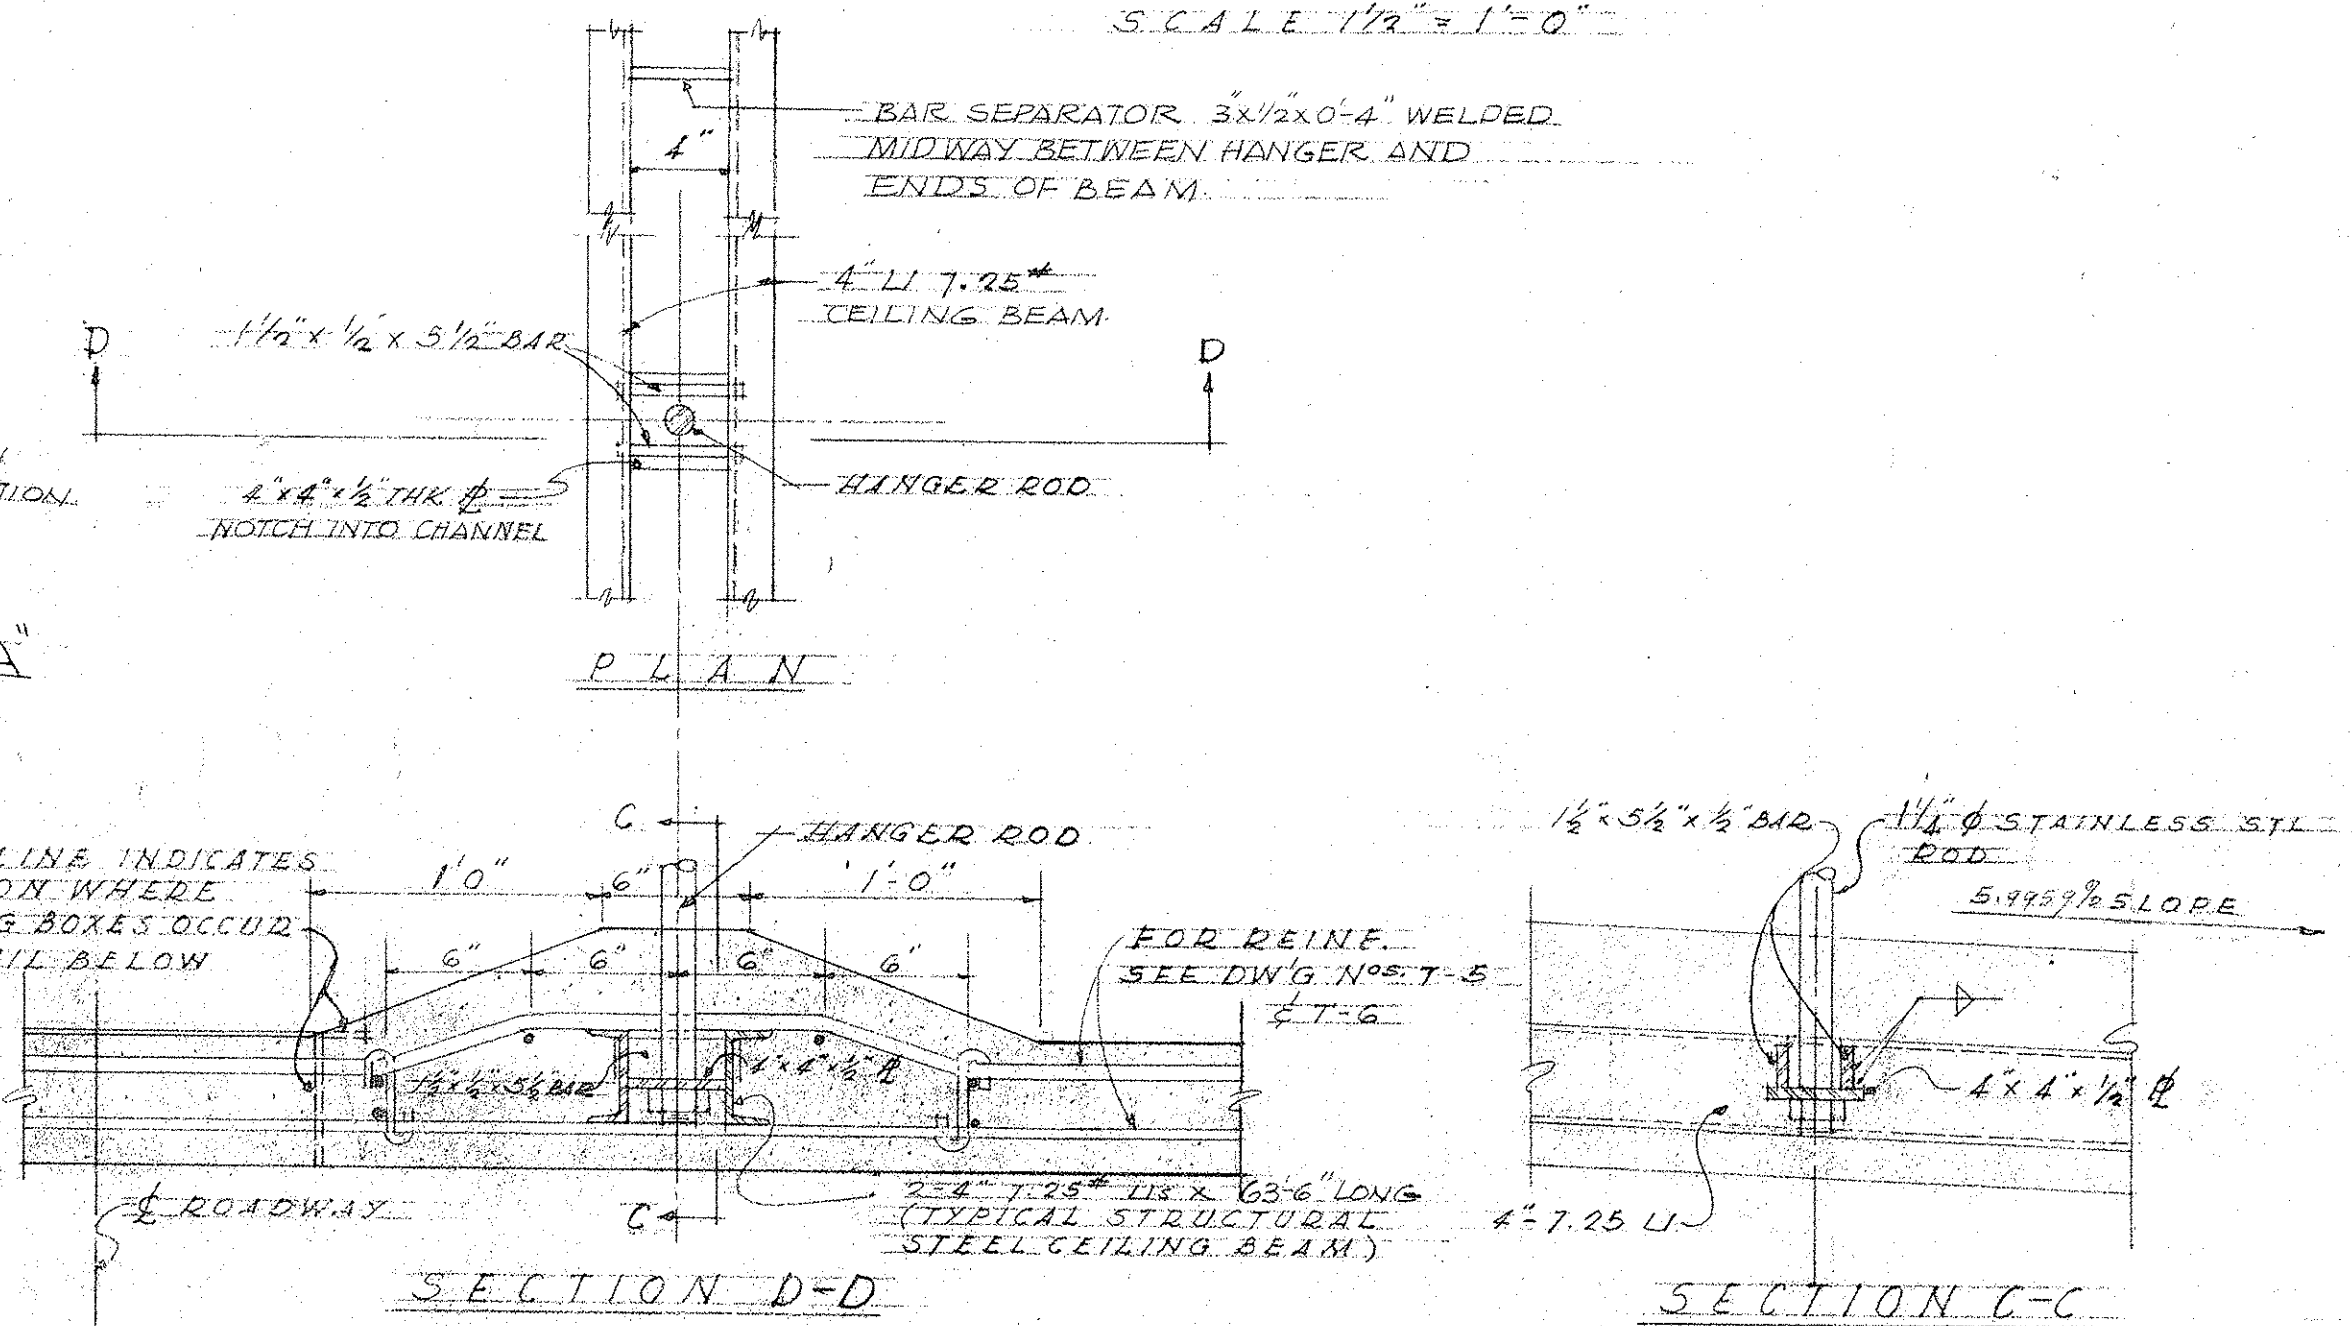
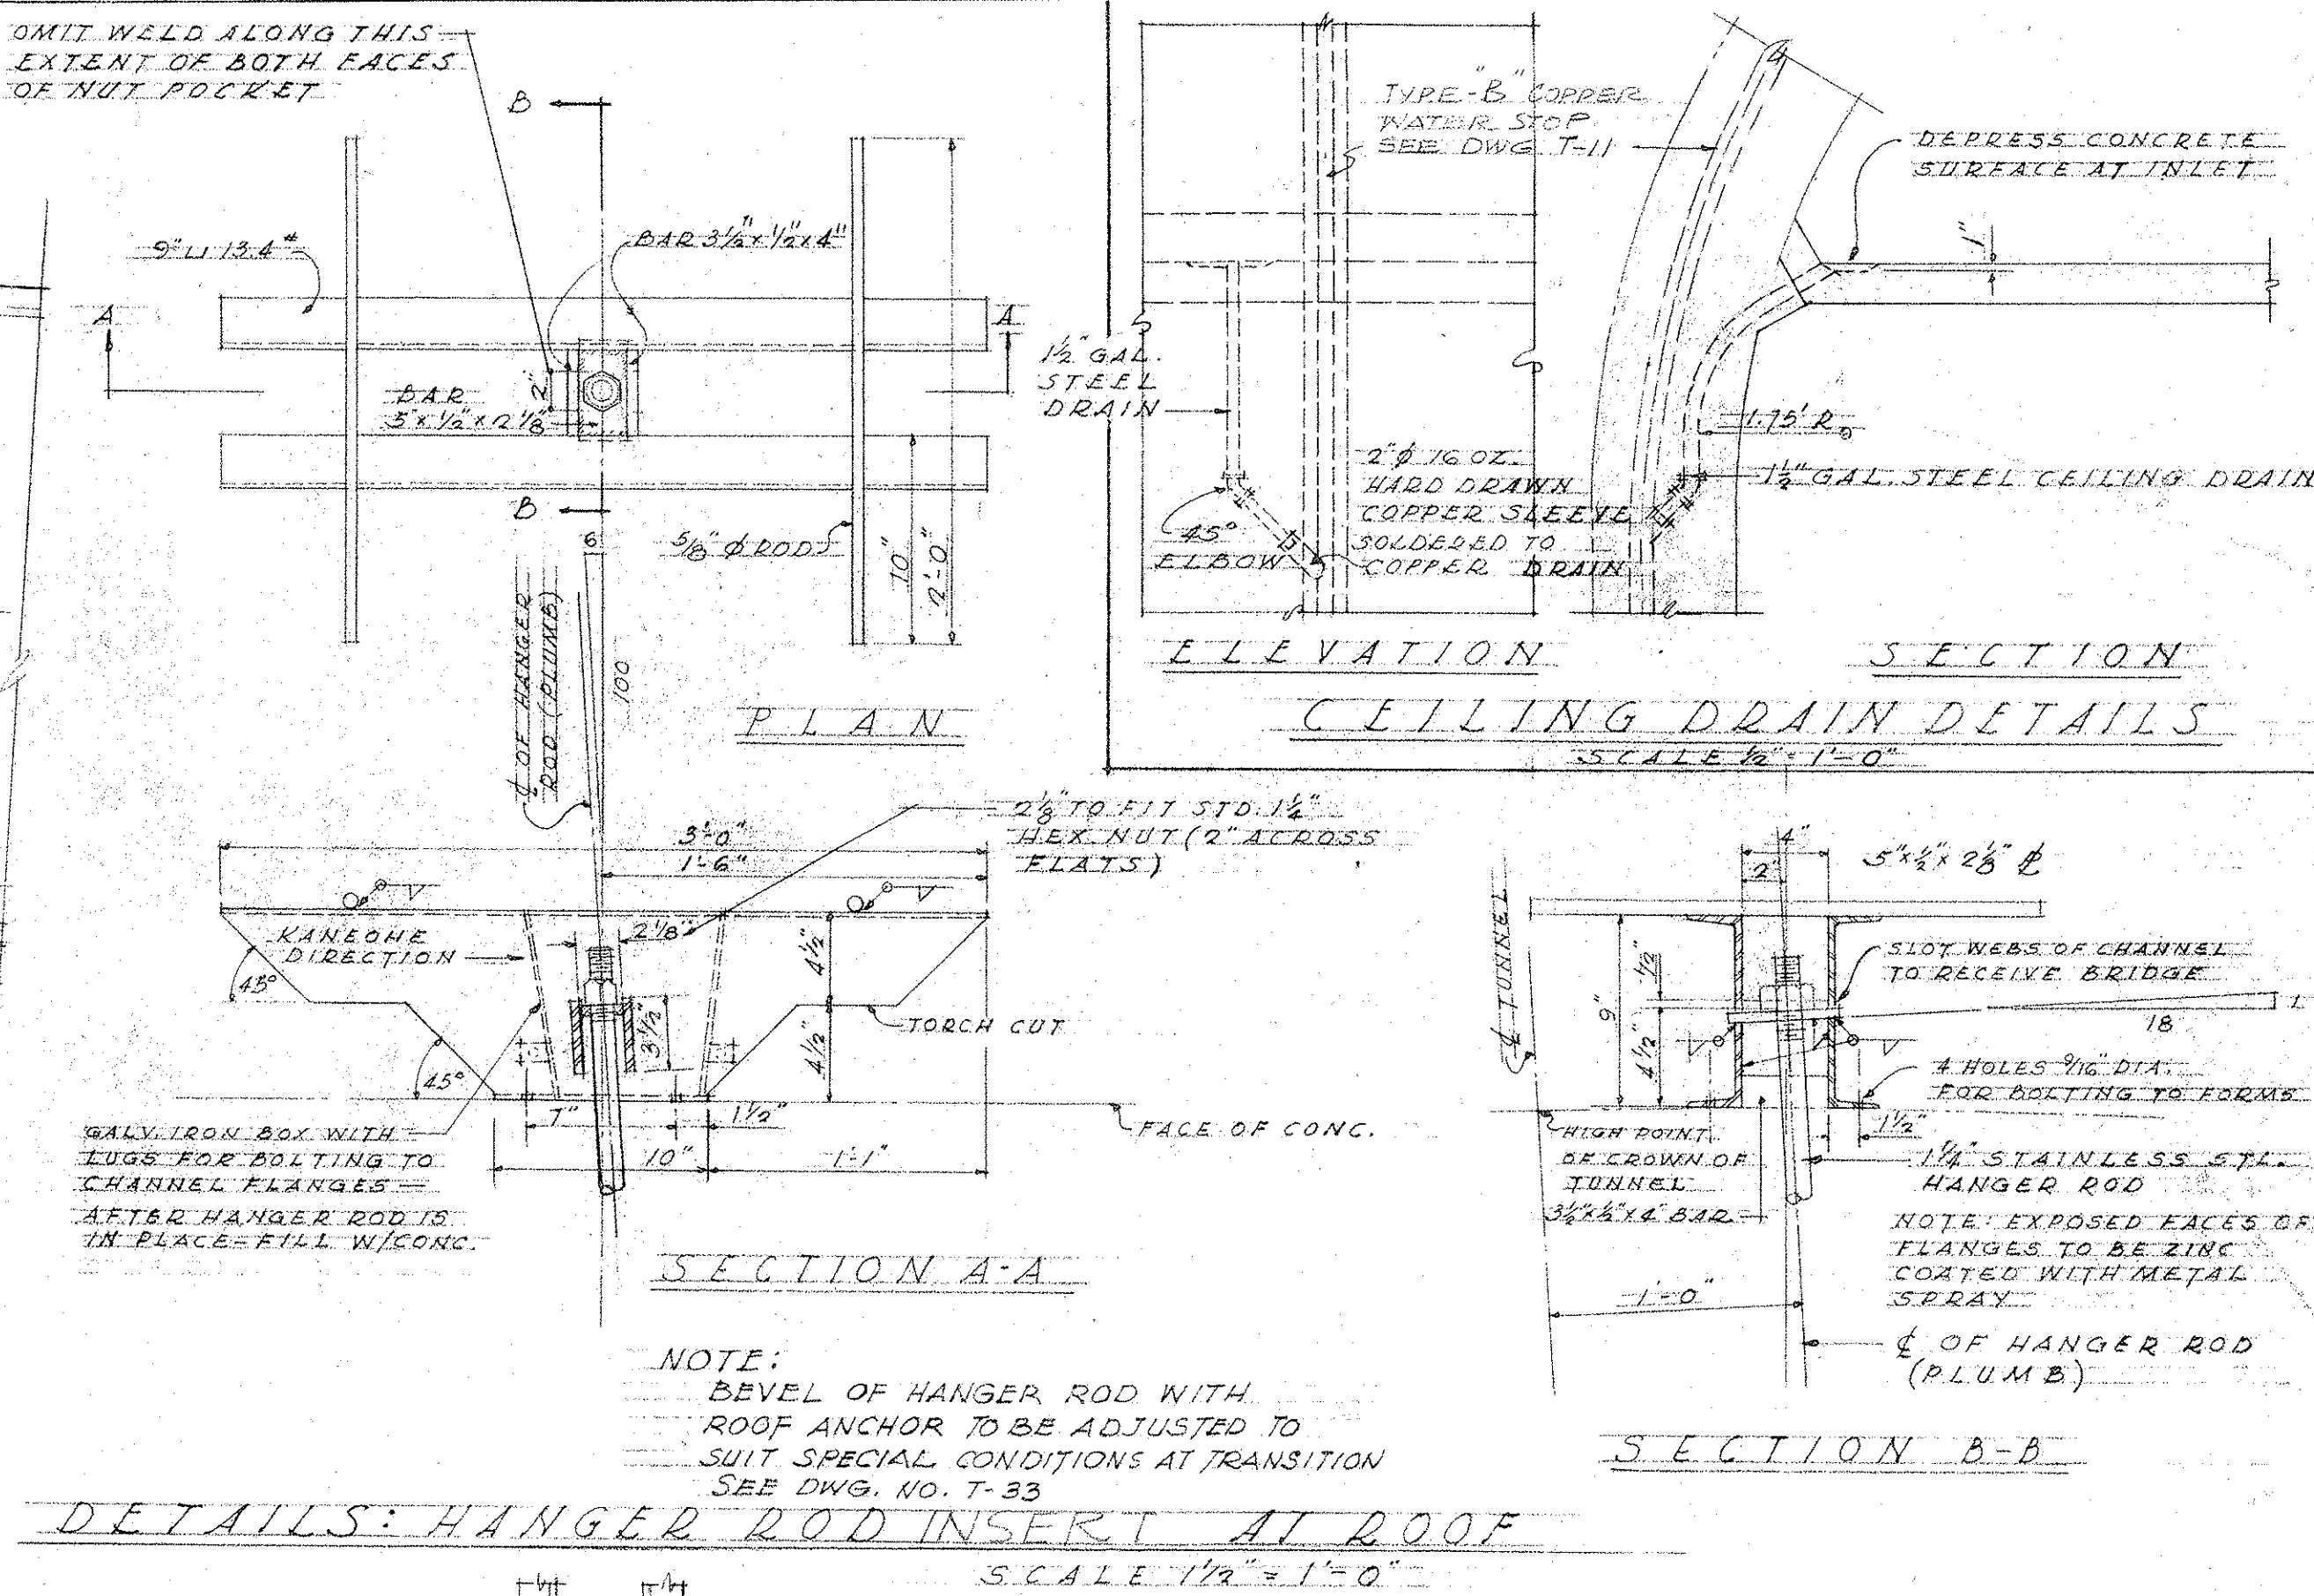
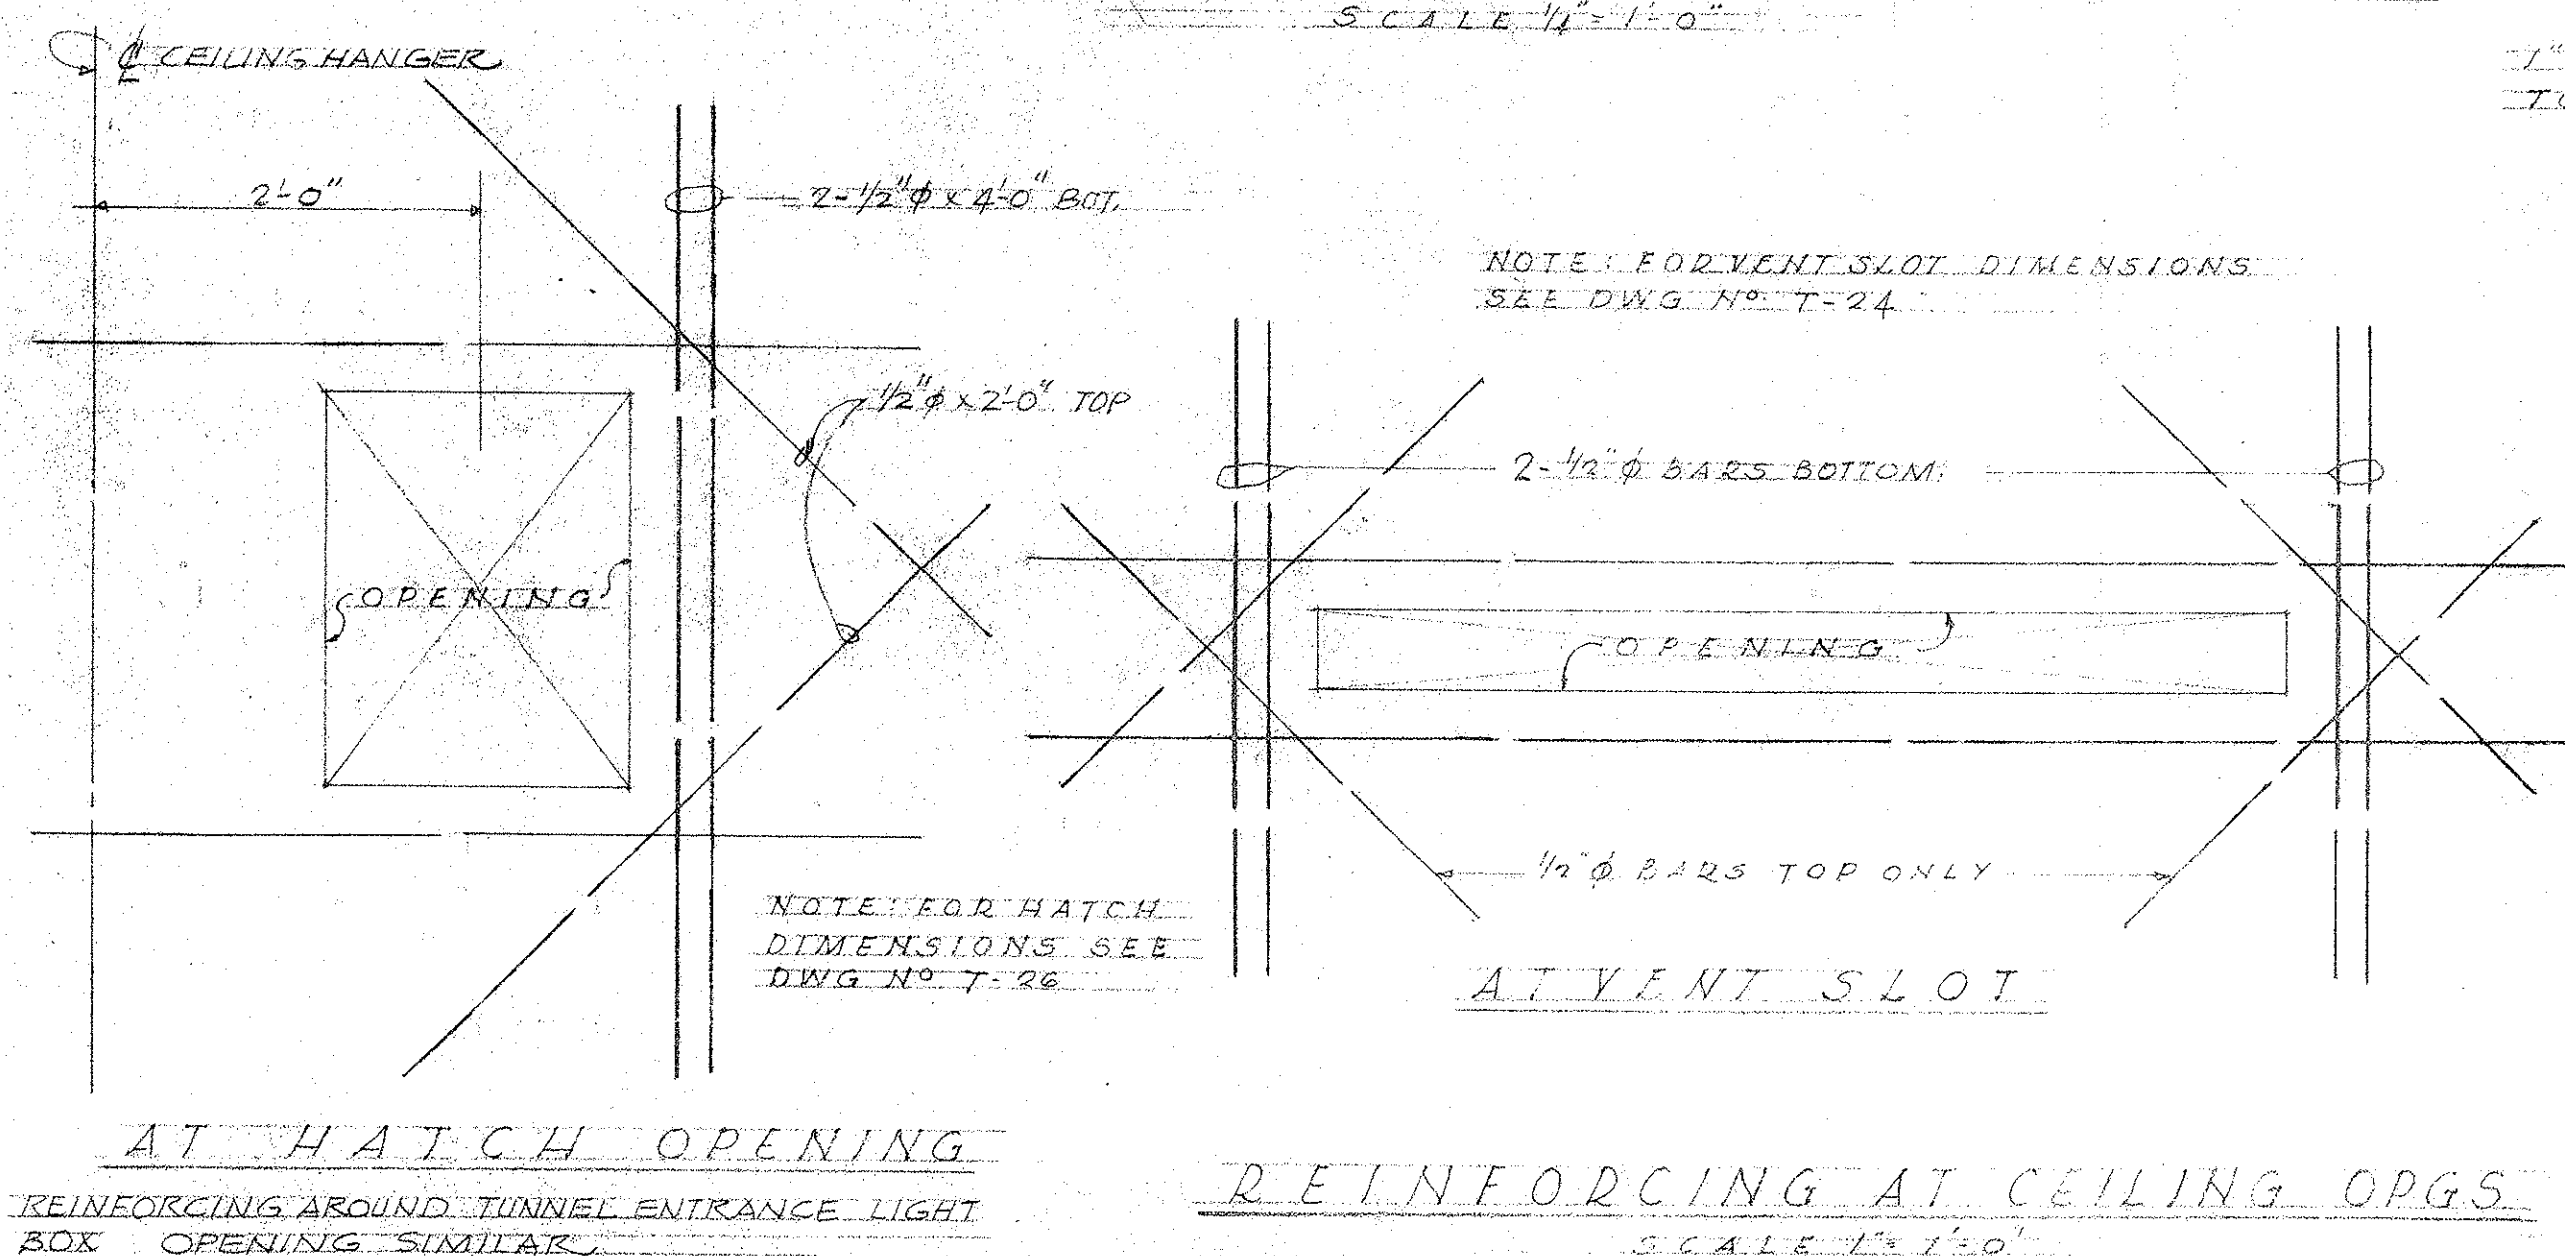
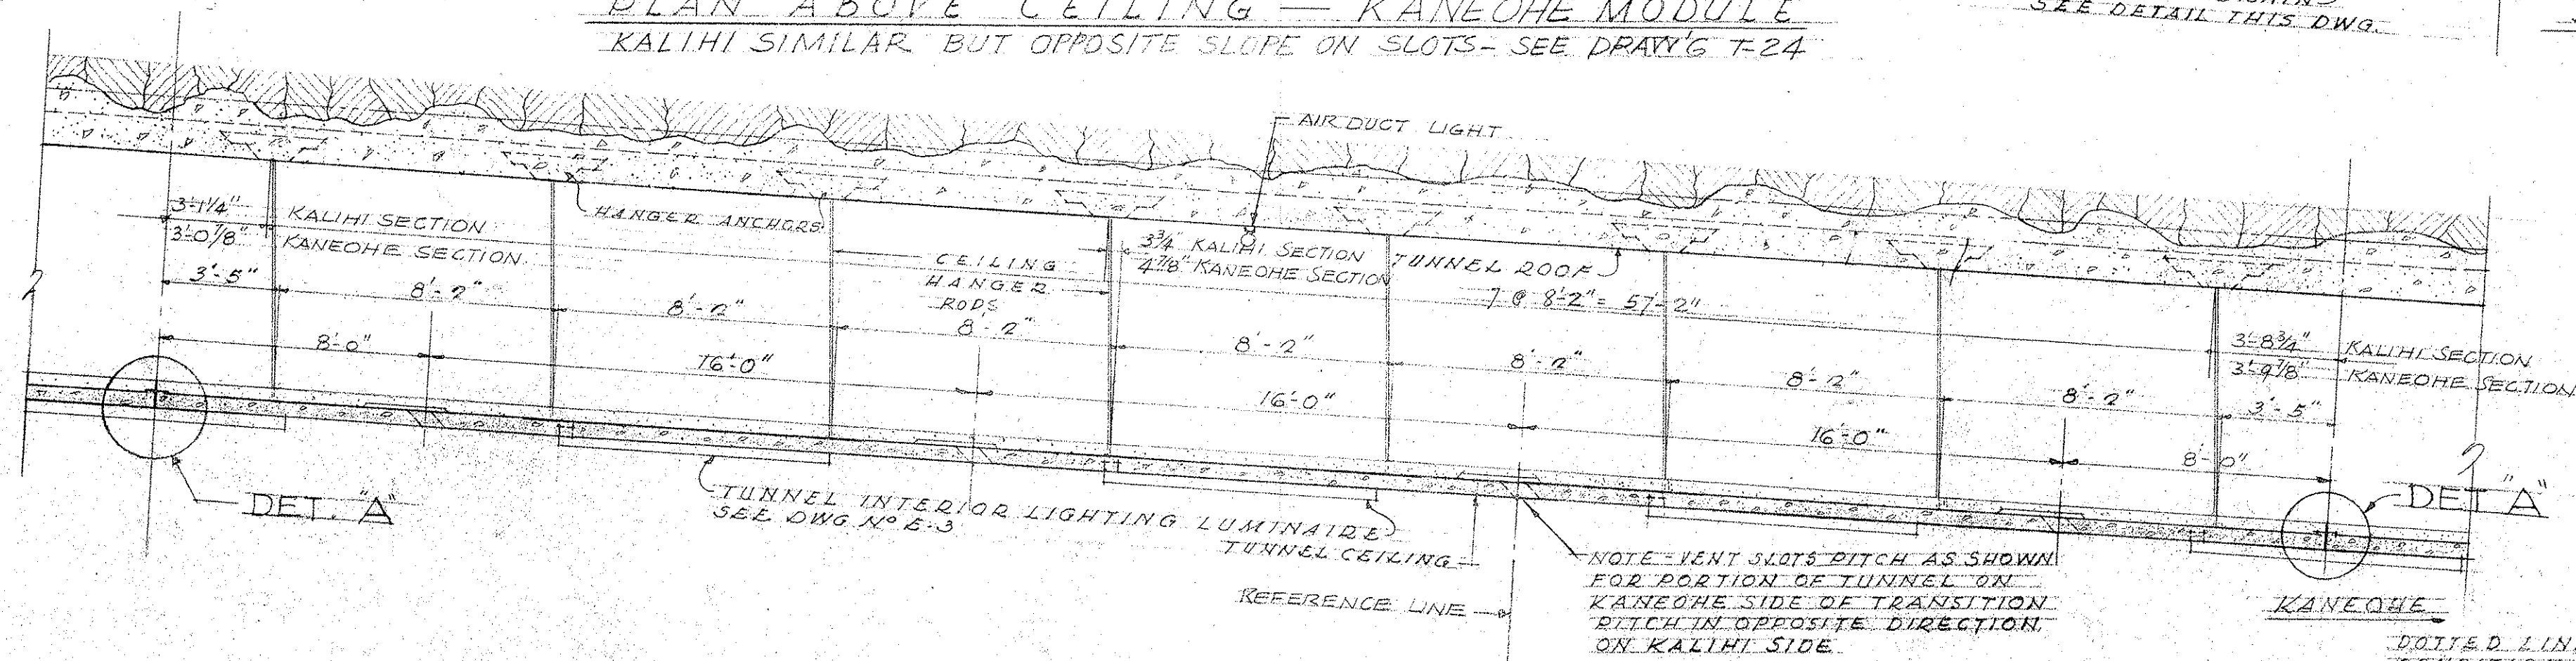


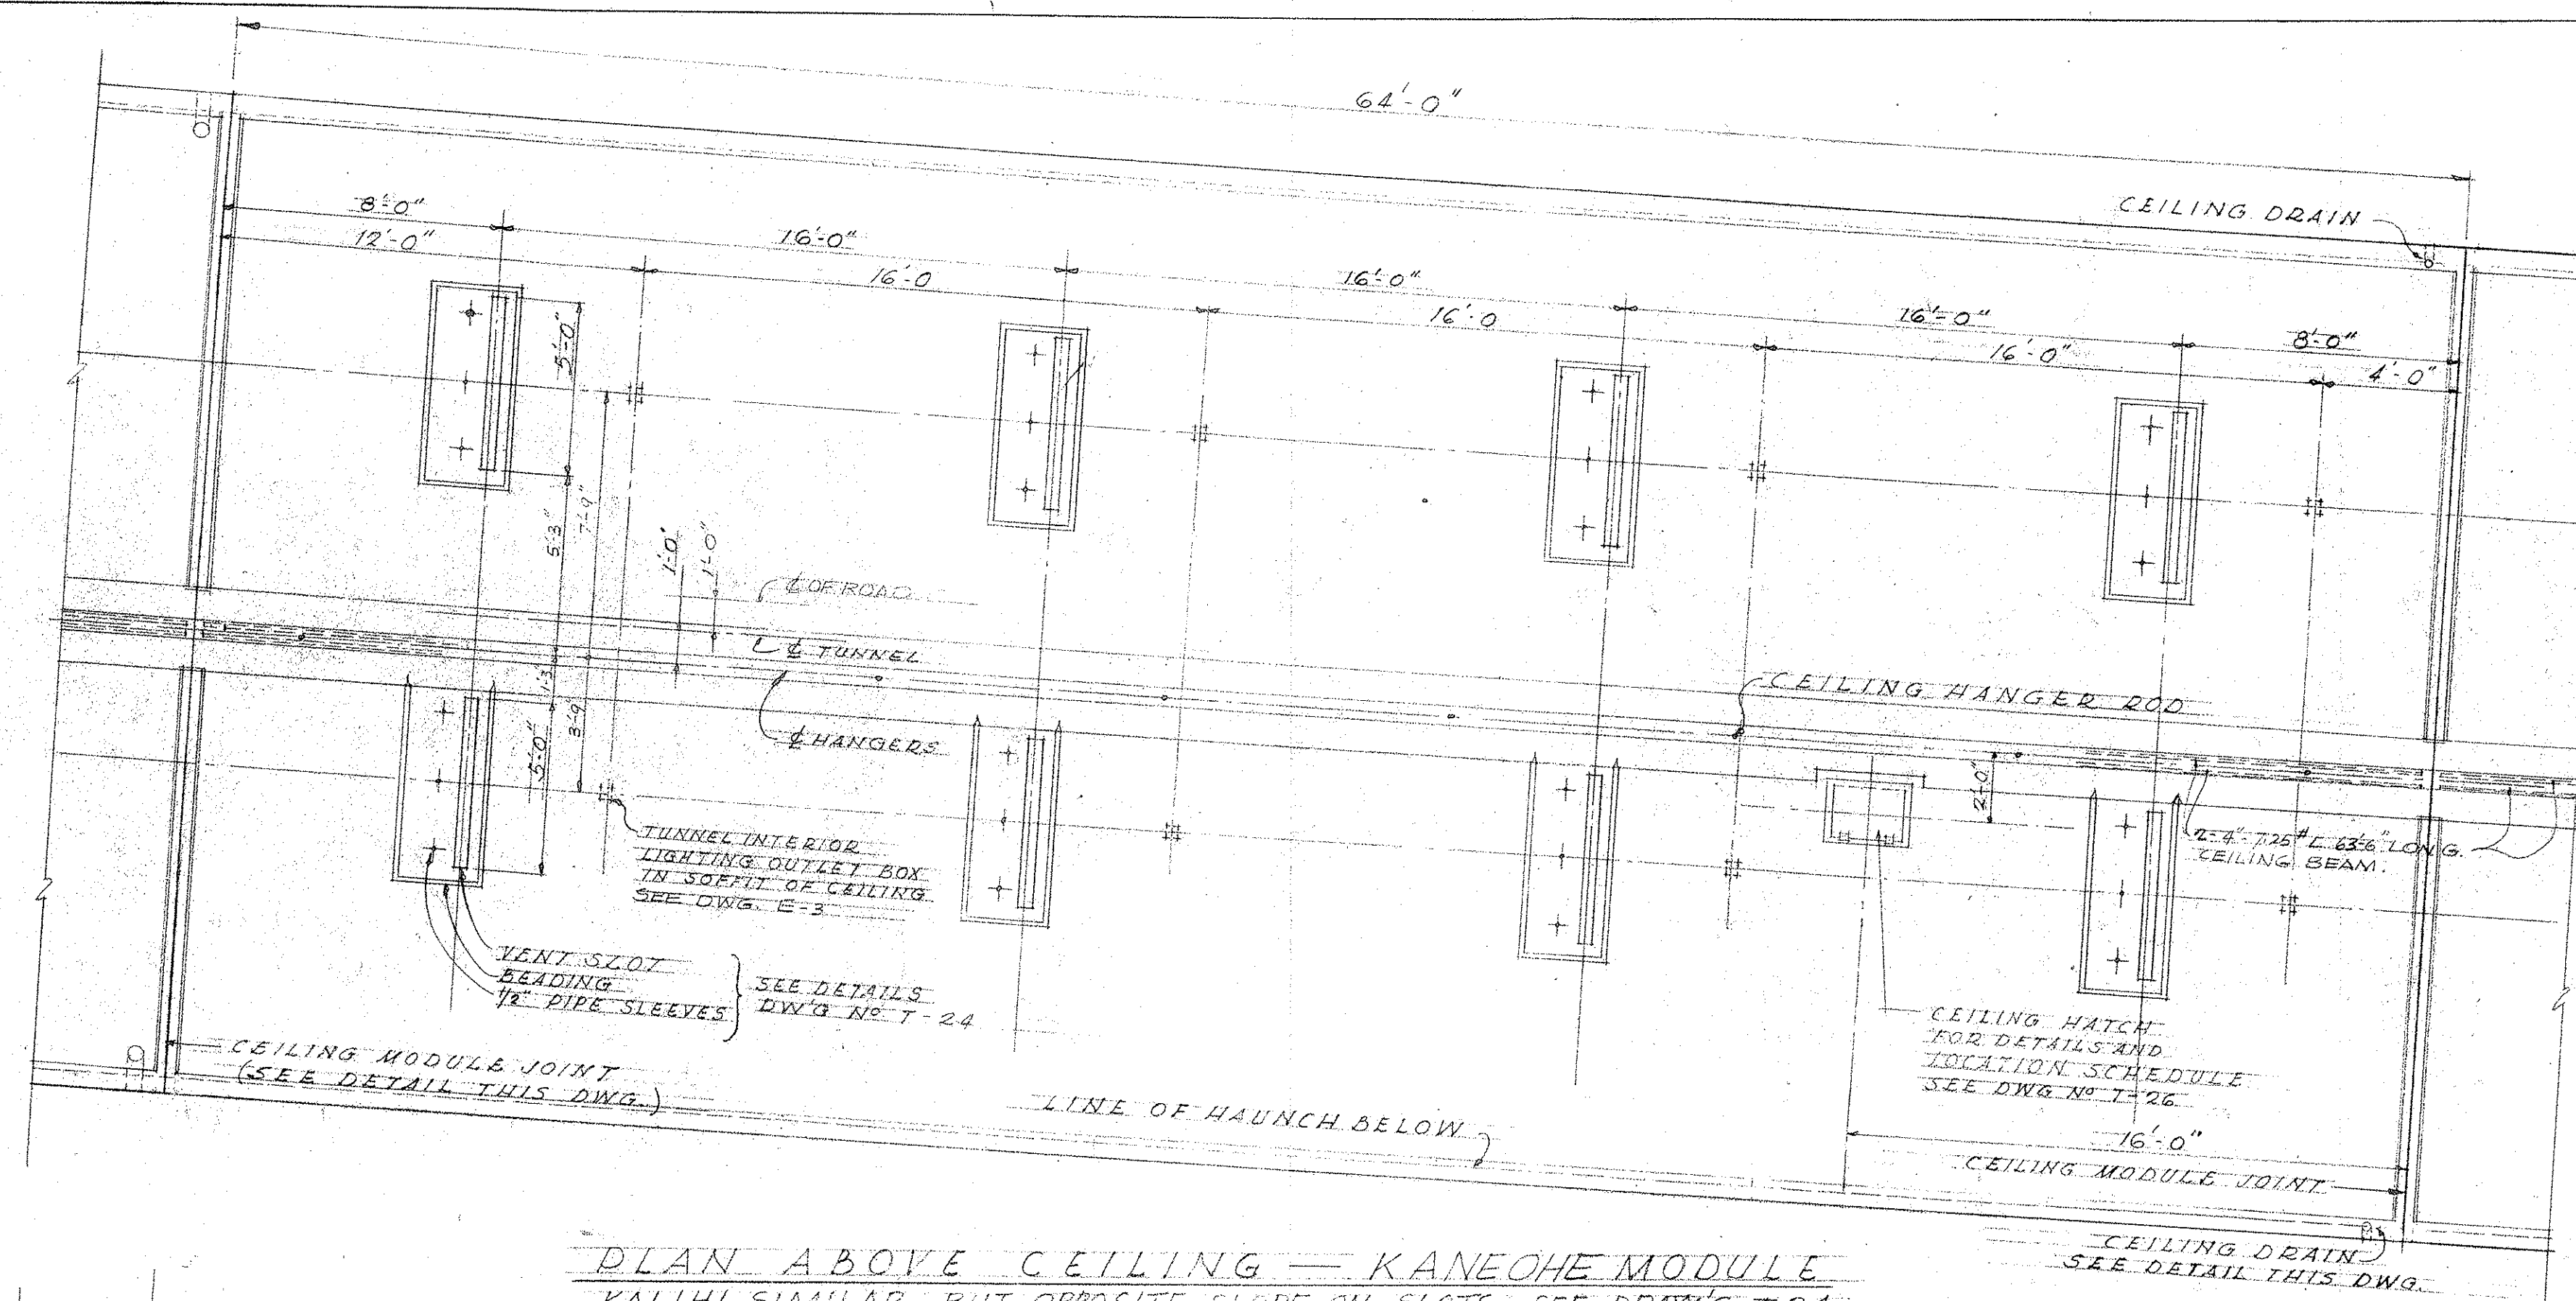

LAW & WILSON
ARCHITECTS & ENGINEERS

DEPARTMENT OF PUBLIC WORKS
CITY AND COUNTY OF HONOLULU

BUREAU OF PLANS

KALIHI TUNNEL
TUNNEL & SHAFT
TYPICAL MODULE - CEILING

ENGINEER: *W. Lum* DATE: *JAN 15 1953*
 DRAFTSMAN: *E.M. 7.2.2* CHECKED BY: *W. Lum, 100*
 SCALE: *AS NOTED* TRACER: _____
 APPROVED: *W. B. Sennett* APPROVED: *H. W. Sennett*
 CHIEF ENGINEER BUREAU ENGINEER

W. S.	PROFILE	C. B.
CR. SEC.	F. B.	S. H.
W. M. BY.	F. W. BY.	S. BY.

JOB NO. 26-53 DWG. T-7