
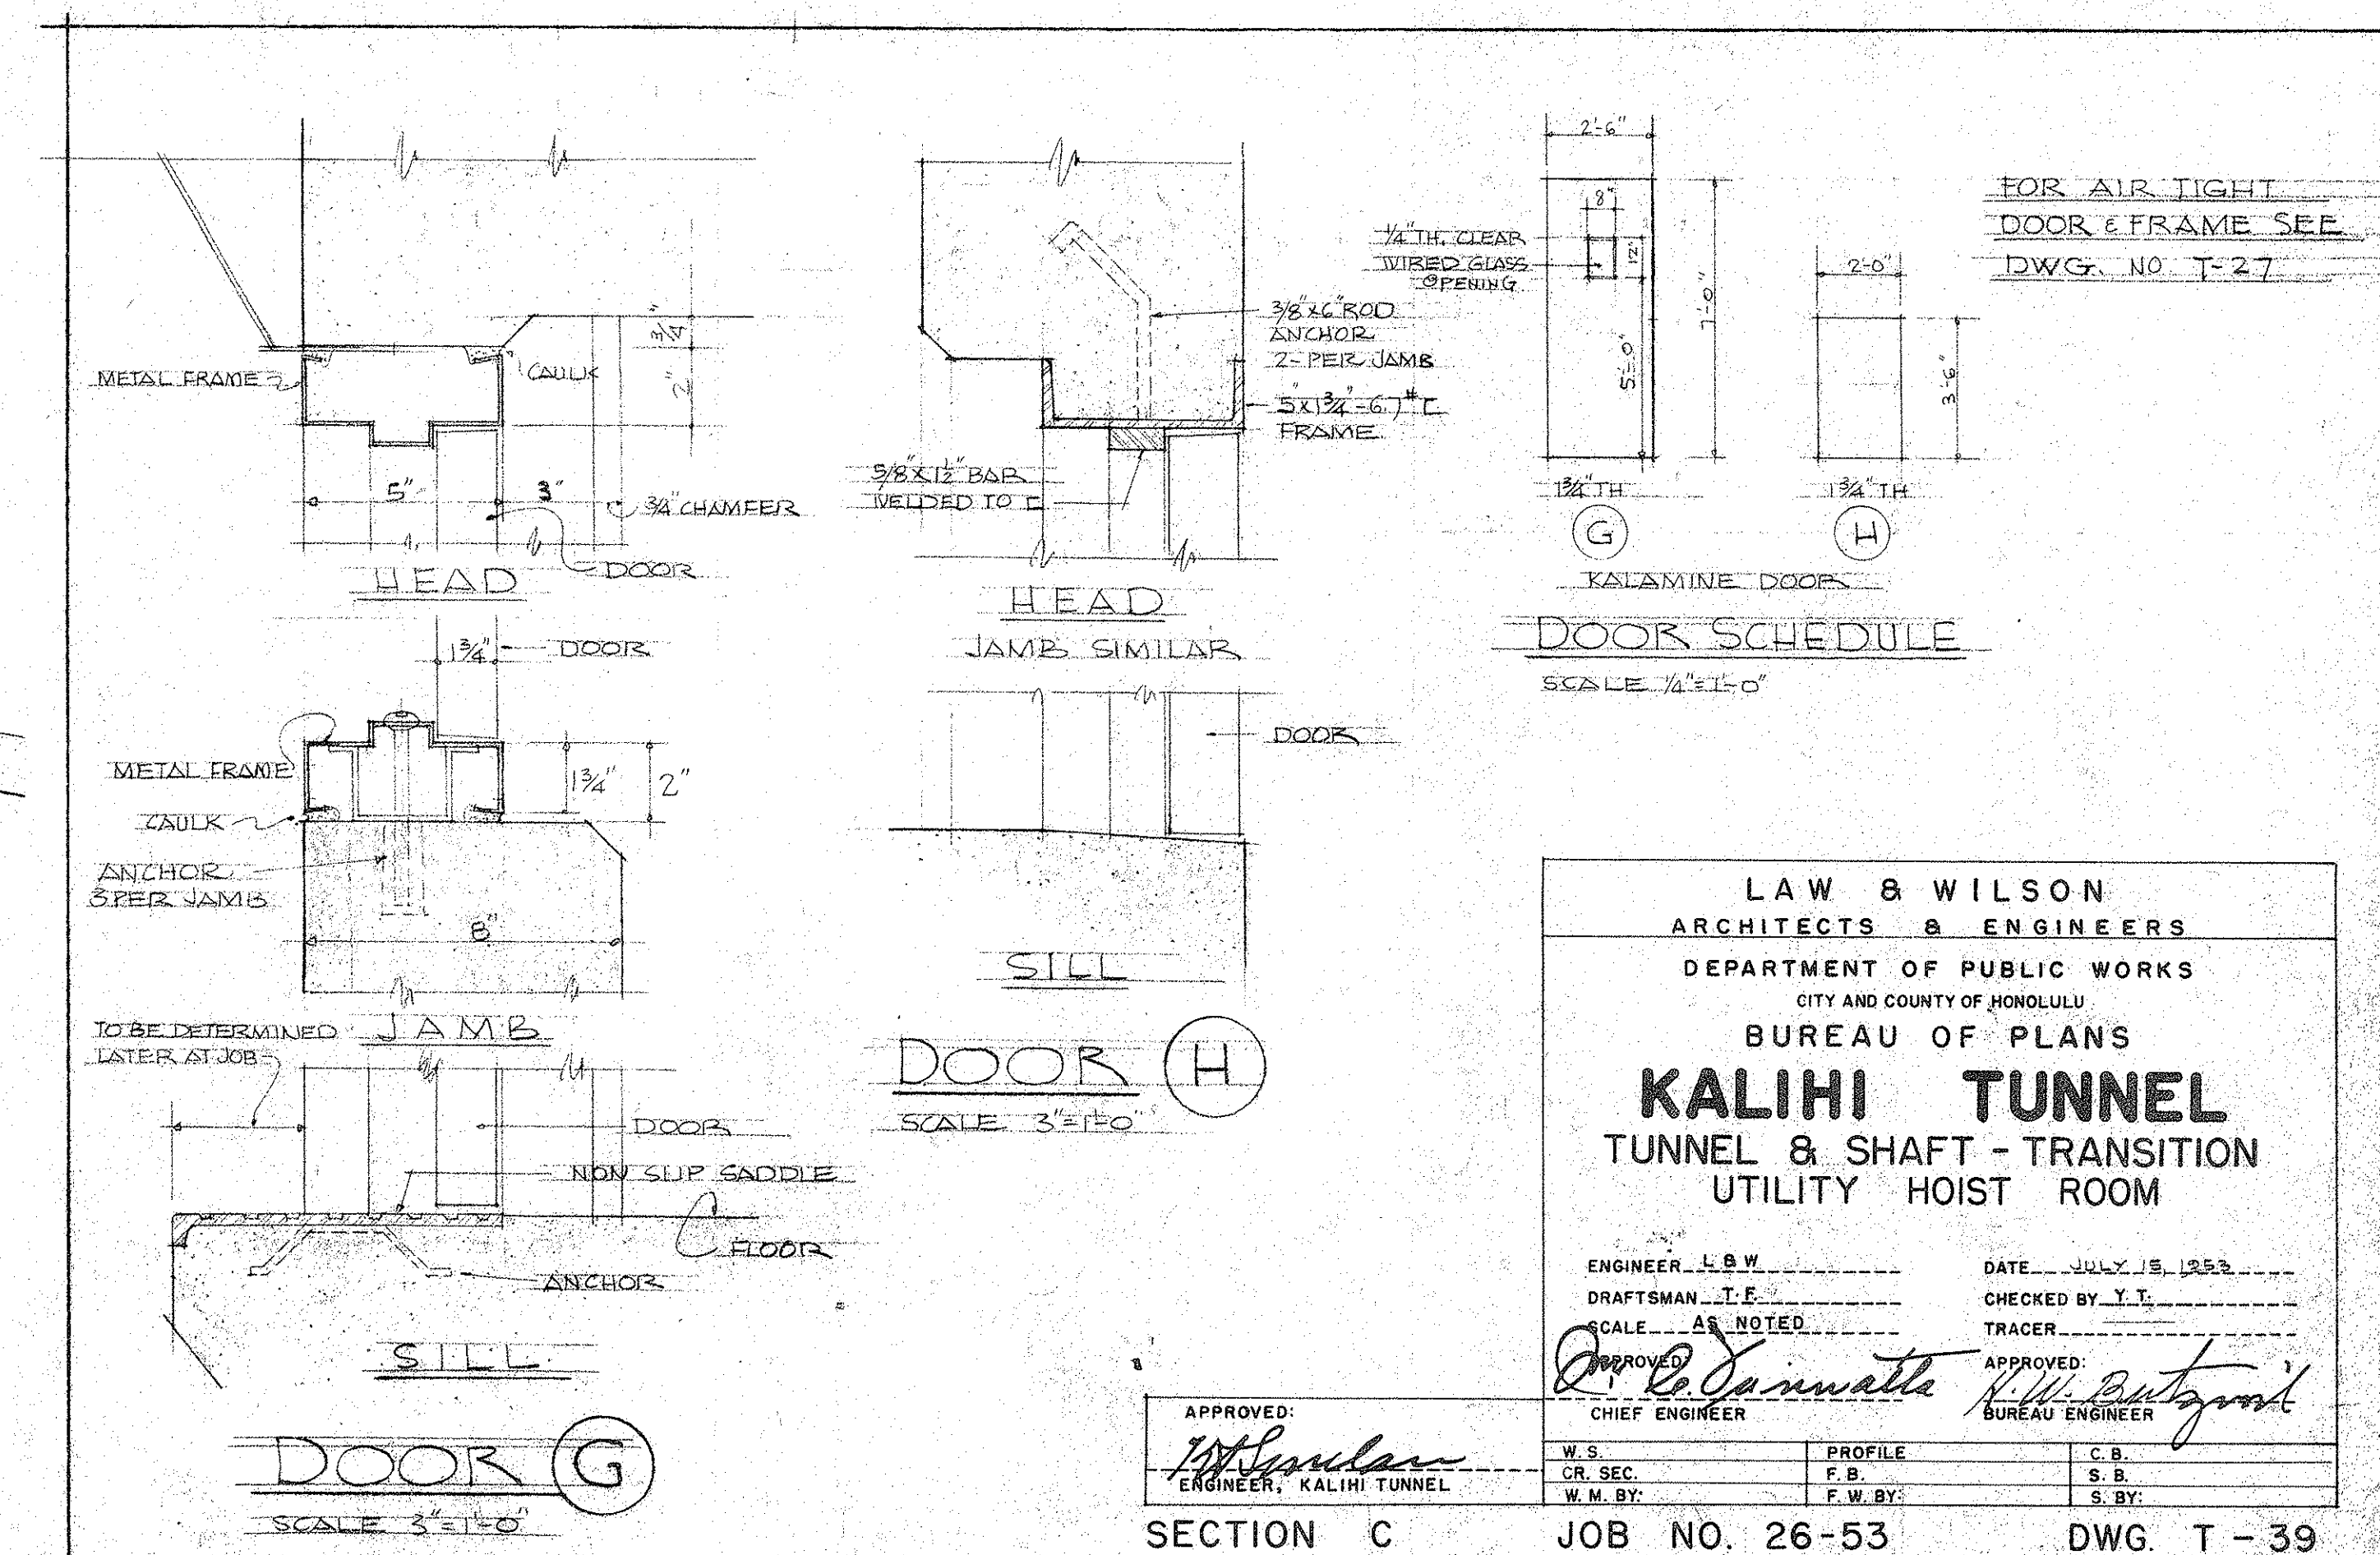
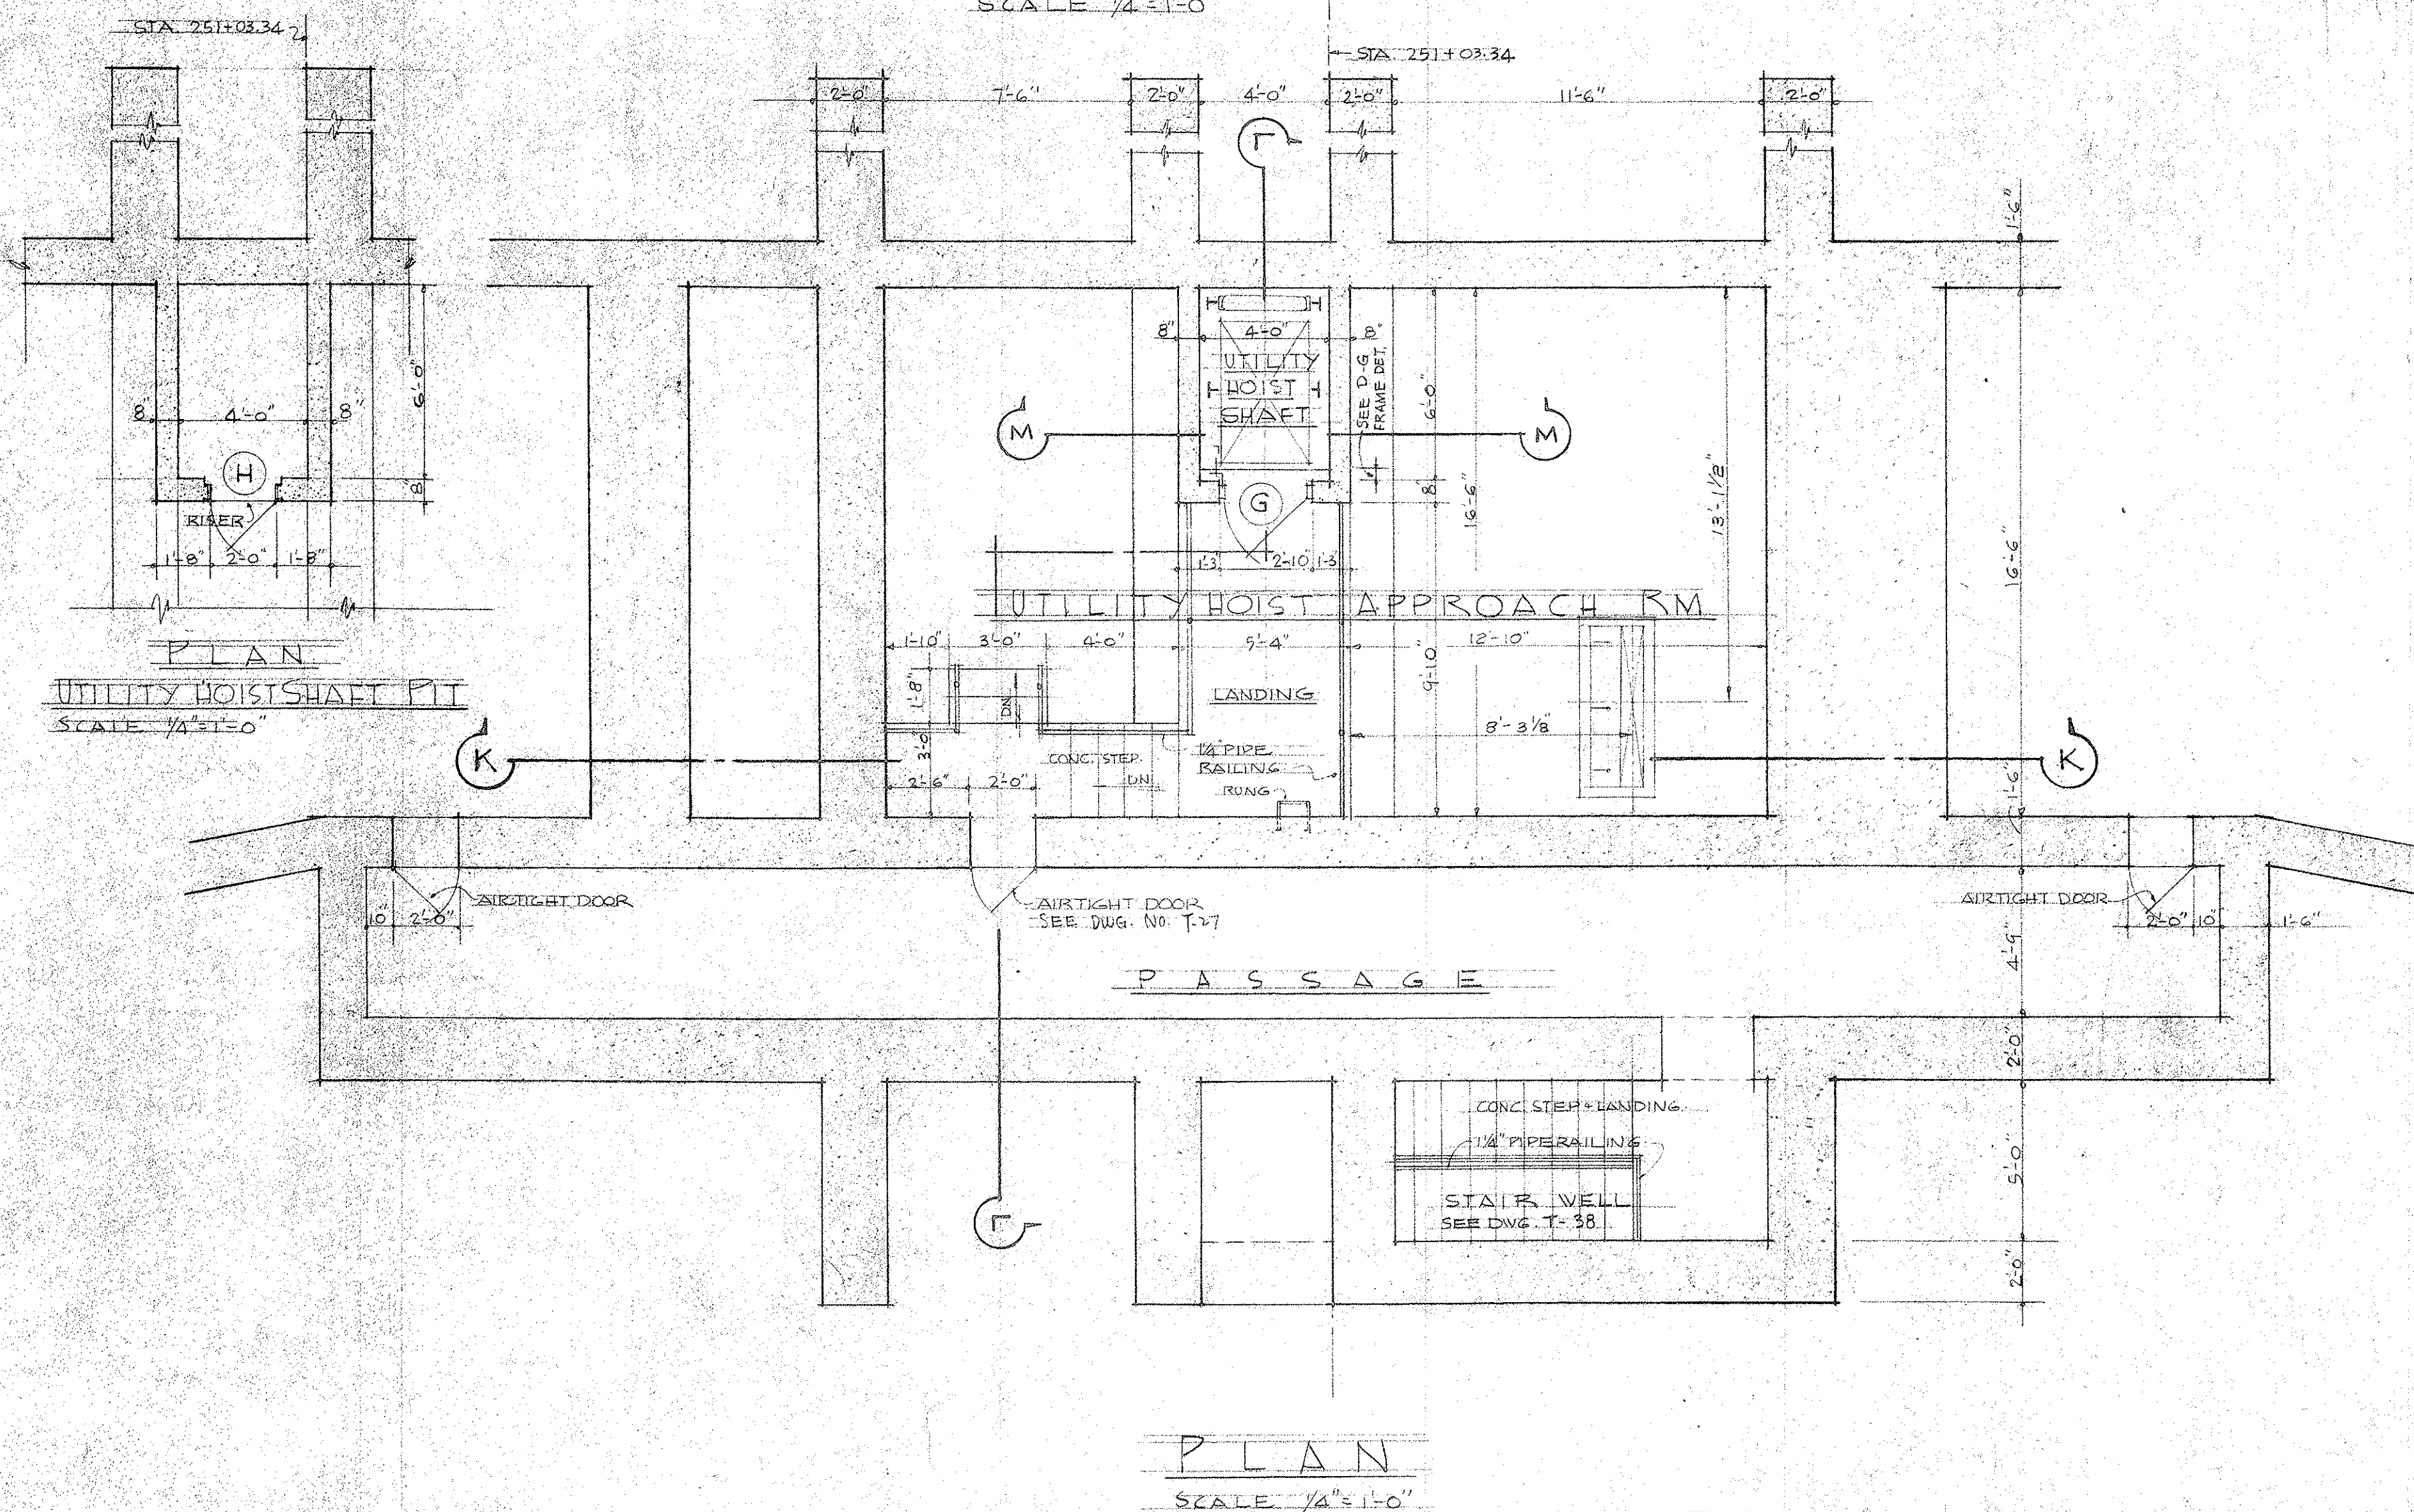
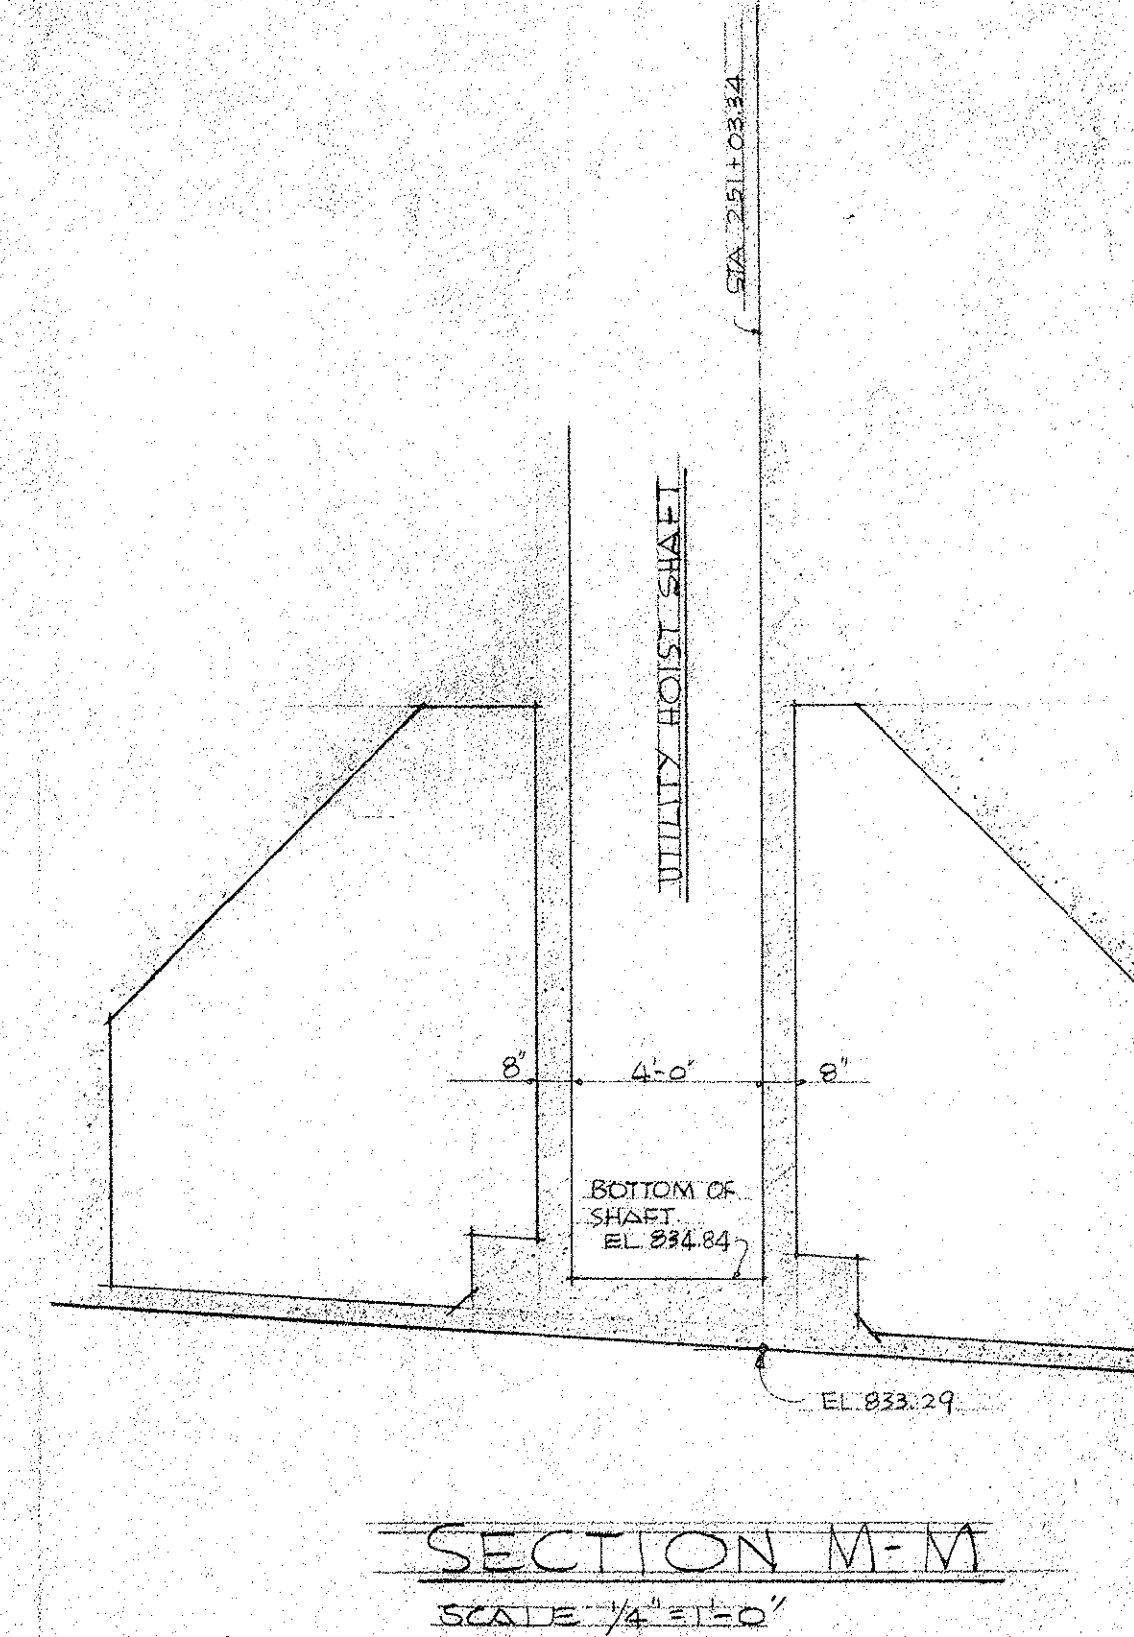
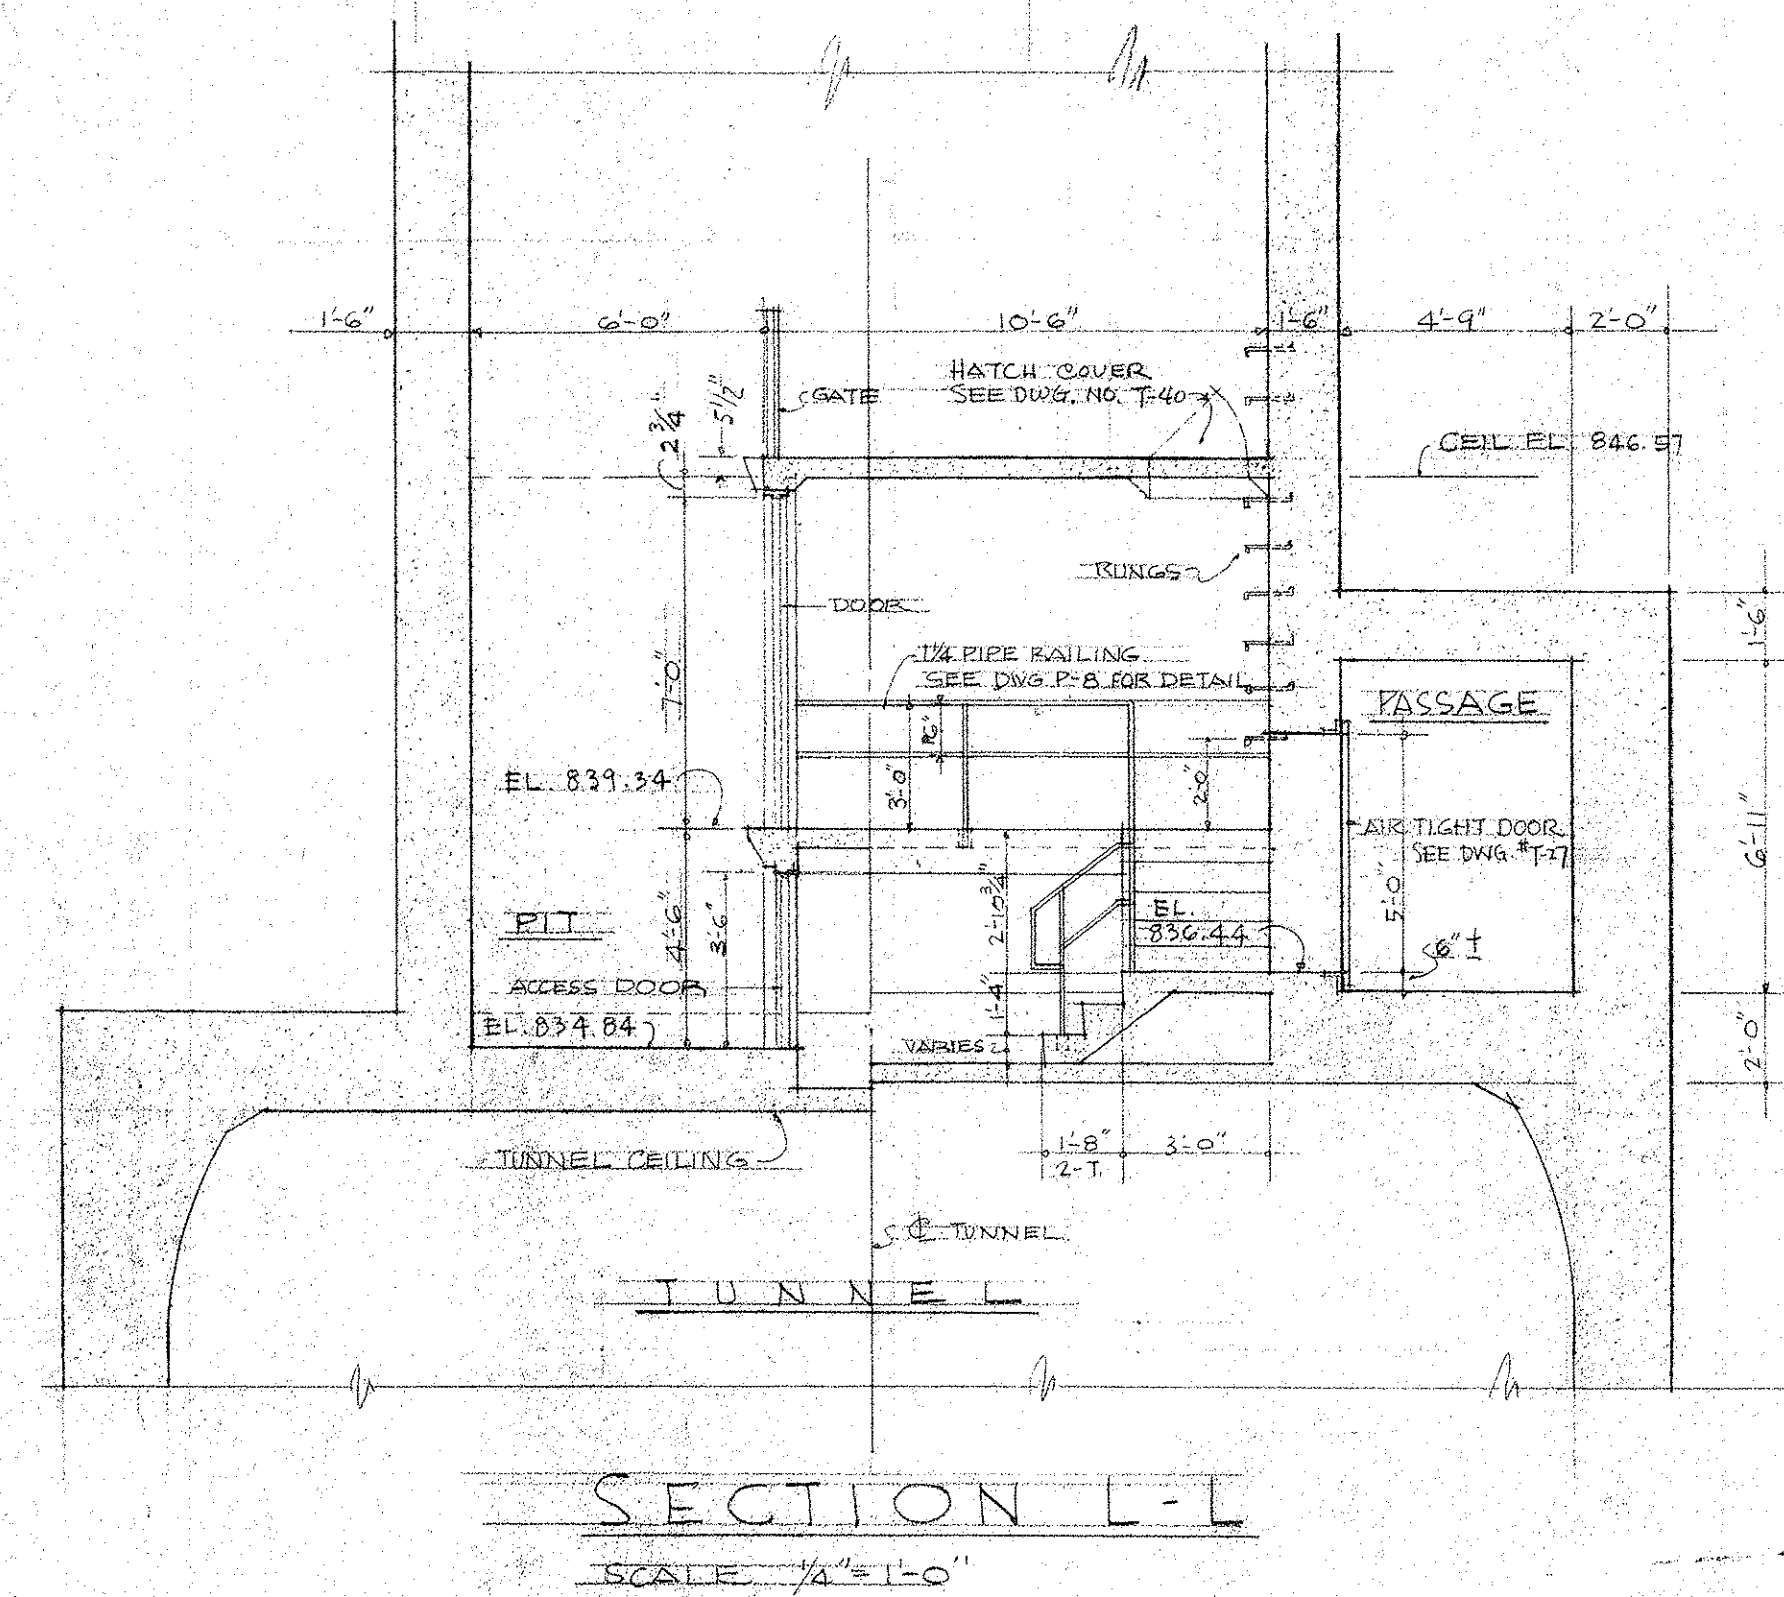


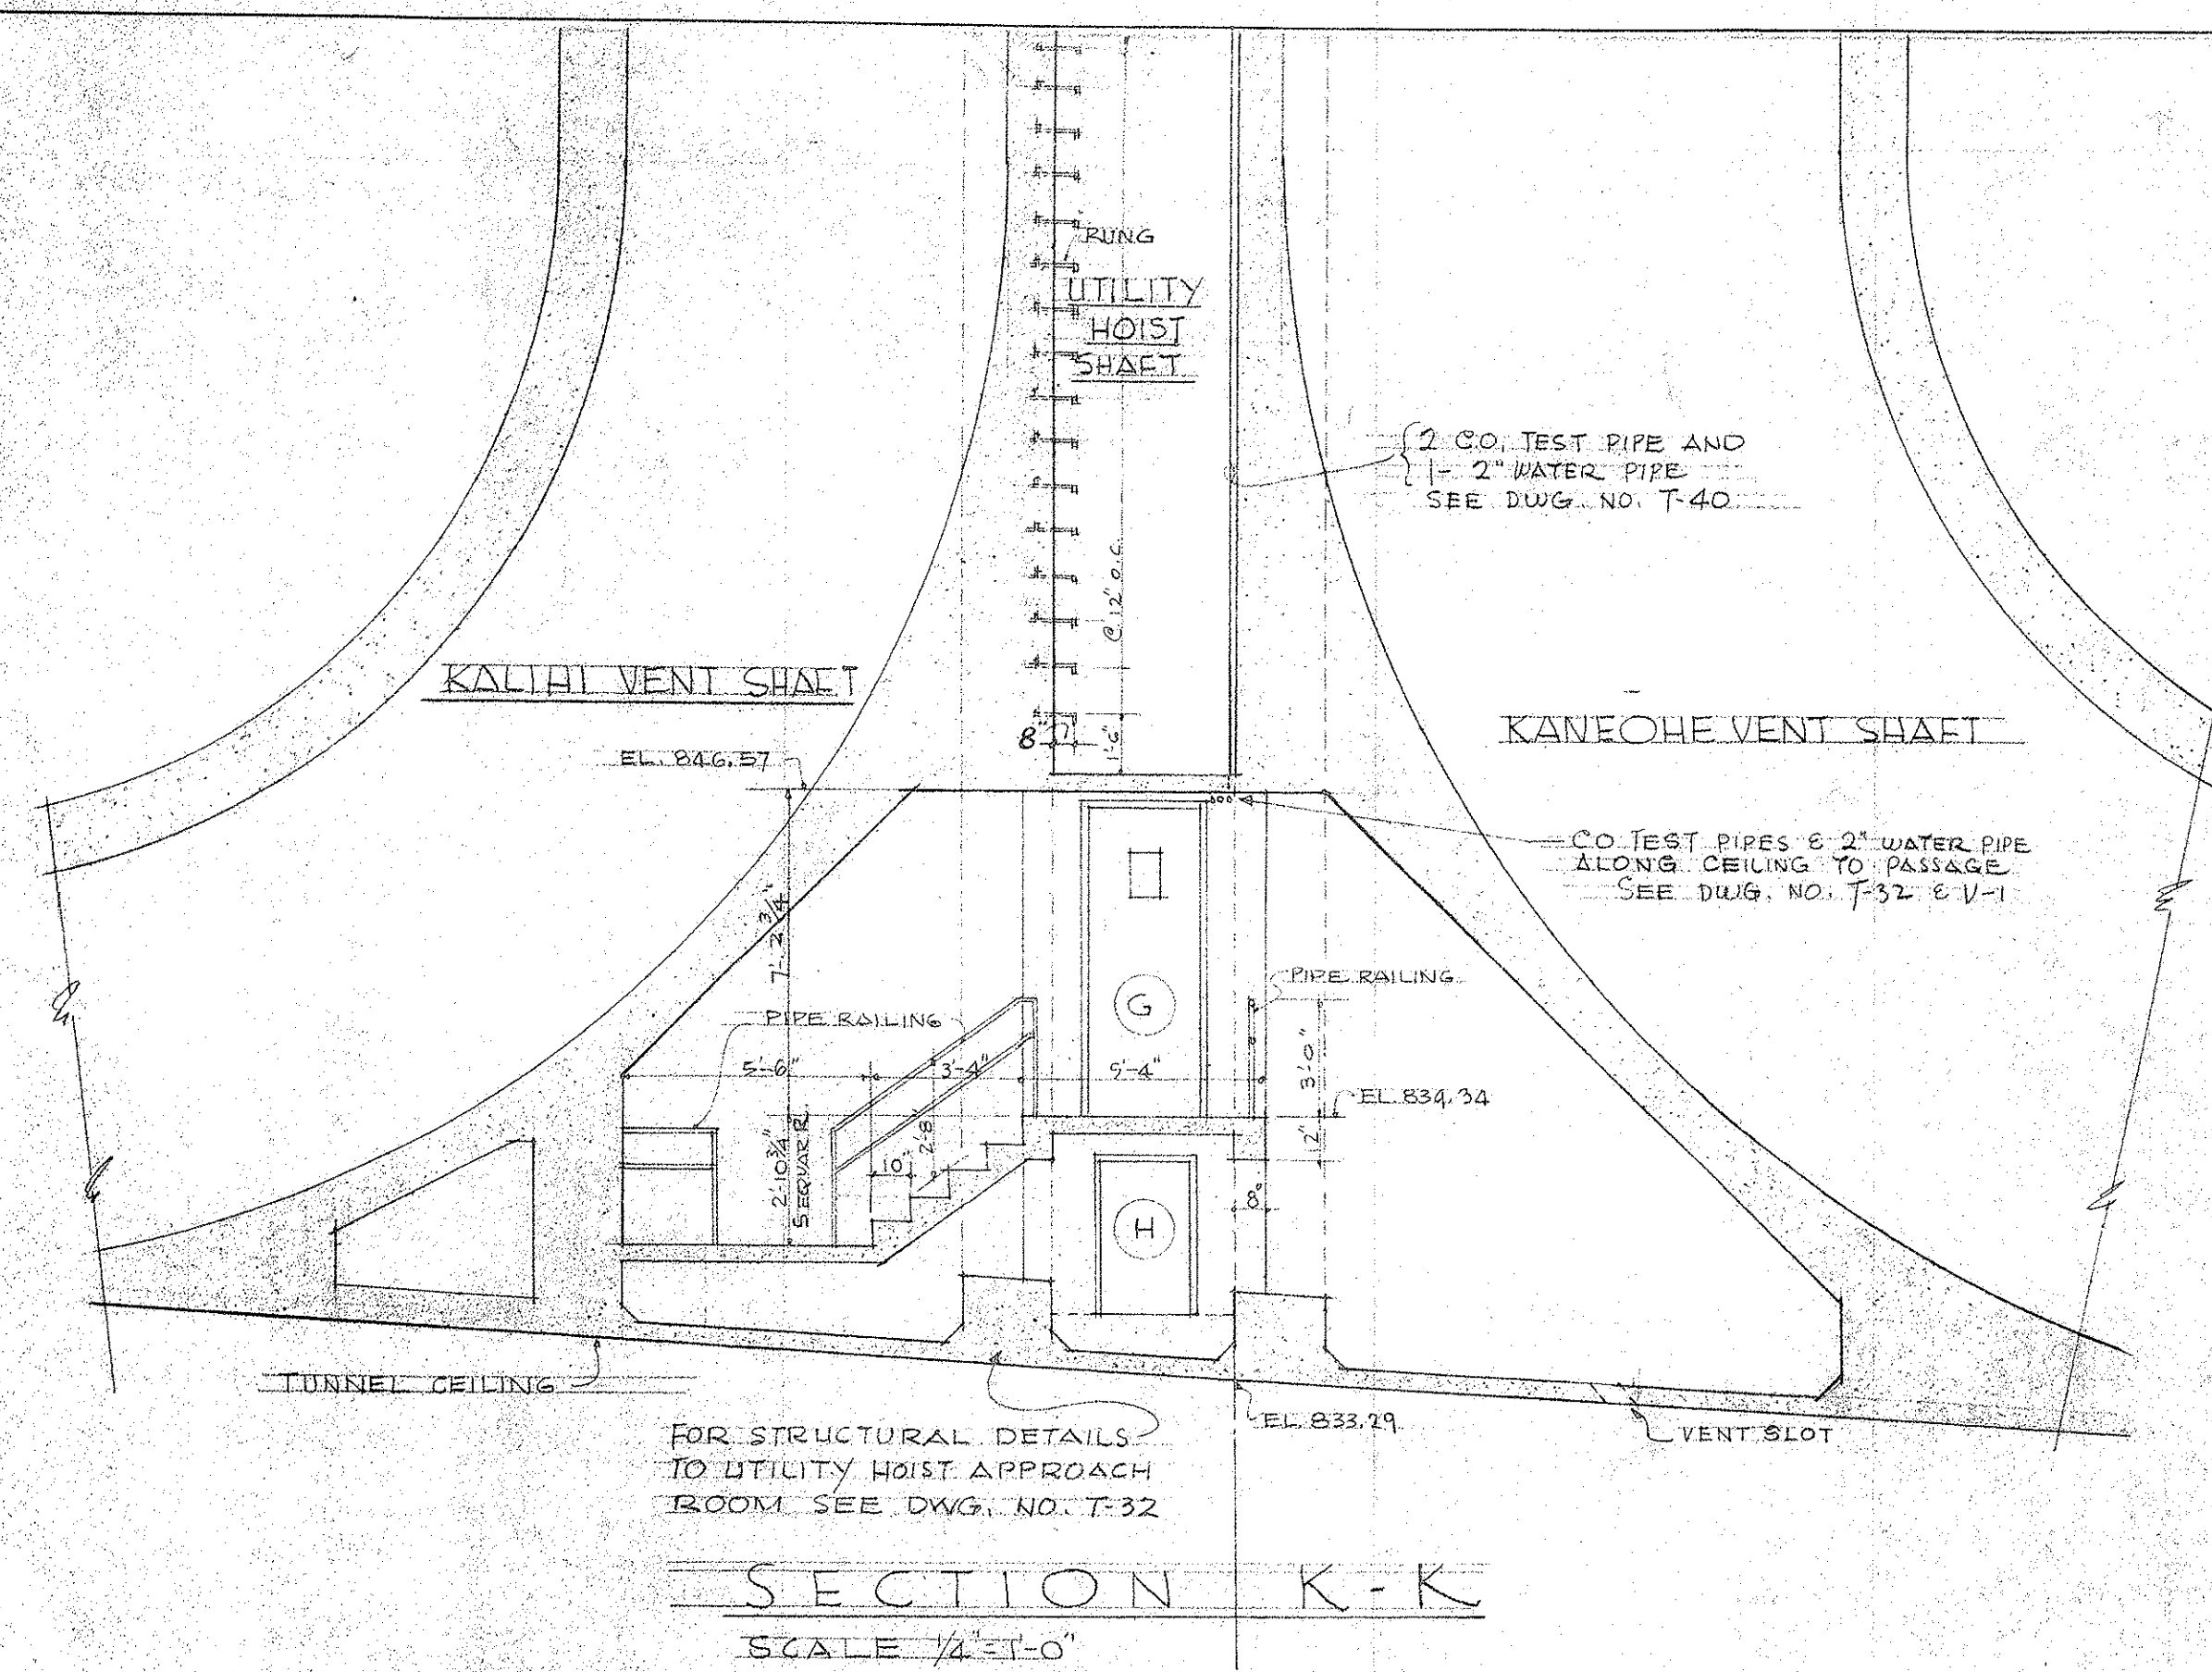

LAW & WILSON
ARCHITECTS & ENGINEERS
DEPARTMENT OF PUBLIC WORKS
CITY AND COUNTY OF HONOLULU
BUREAU OF PLANS
KALIHI TUNNEL
TUNNEL & SHAFT - TRANSITION
UTILITY HOIST ROOM

ENGINEER L.B.W. DATE JULY 15, 1952
DRAFTSMAN T.F. CHECKED BY Y.T.
SCALE AS NOTED TRACER _____
APPROVED: [Signature] APPROVED: [Signature]
CHIEF ENGINEER BUREAU ENGINEER