


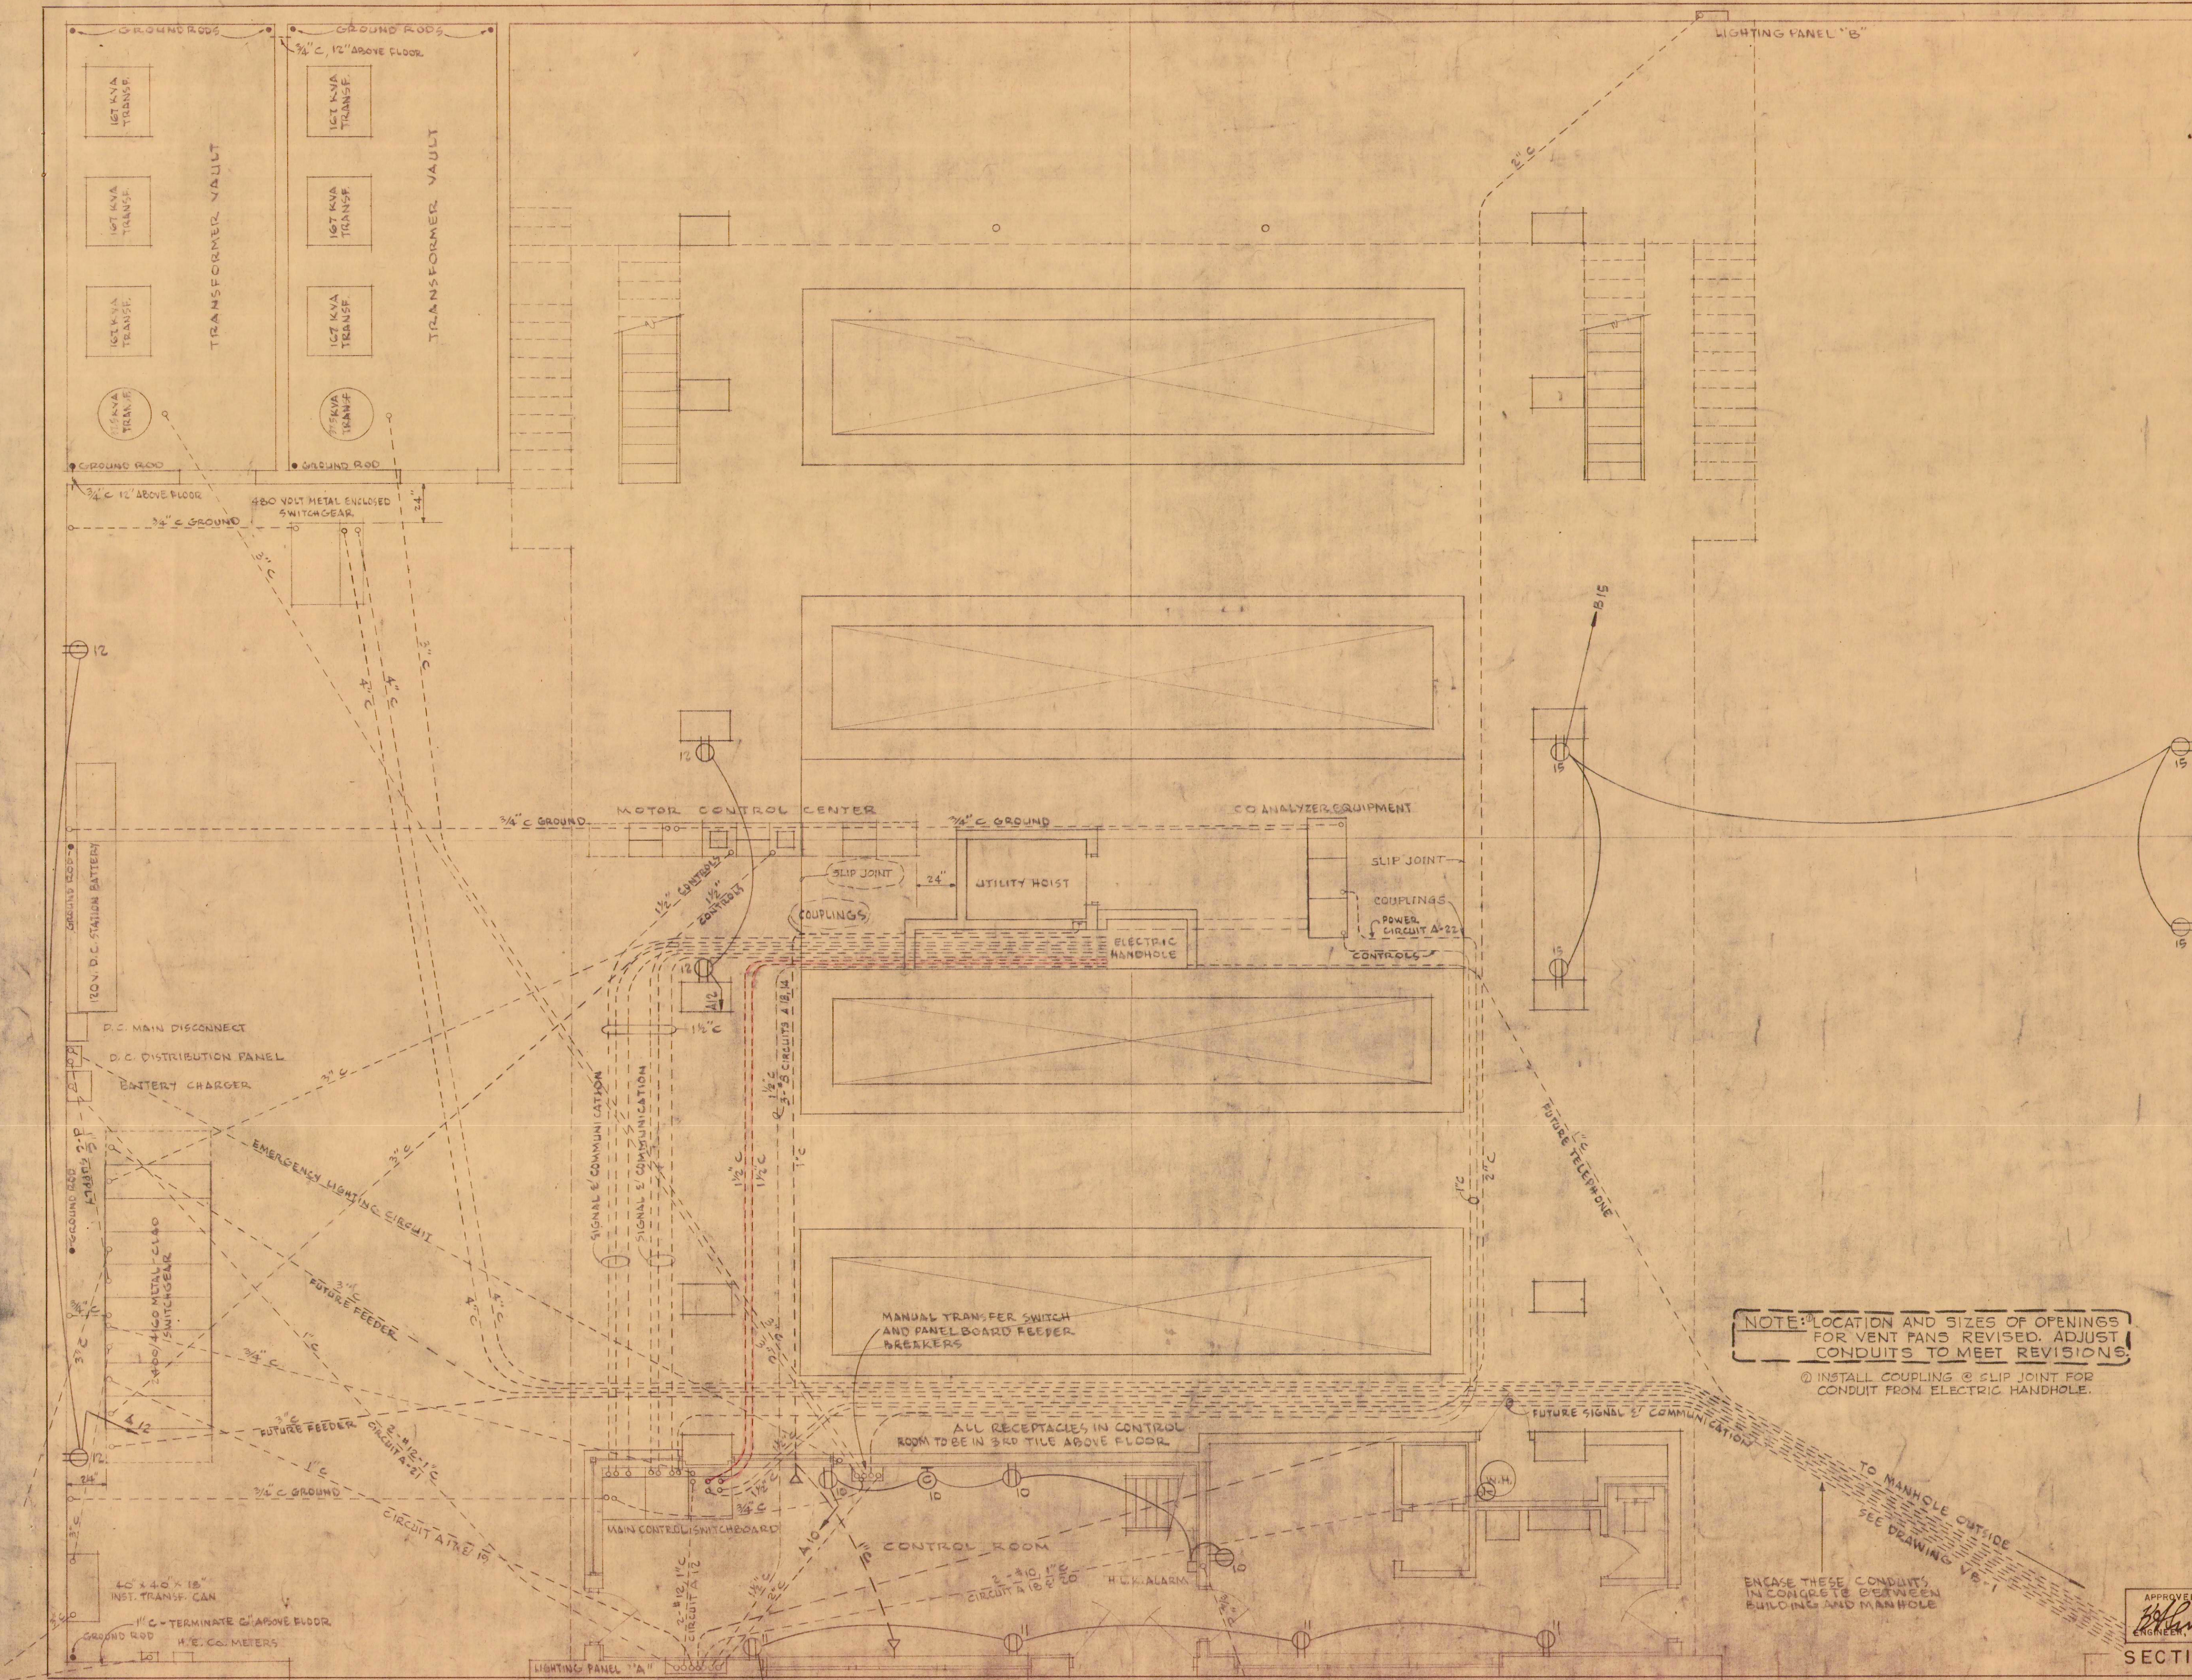

ACTUAL LOCATION OF CONDUIT TERMINATION
TO BE DETERMINED BY CONTRACTOR AFTER
PURCHASE OF EQUIPMENT.

FOR ELECTRICAL SYMBOLS SEE DWG. NO. VB-47

NOTE: LOCATION AND SIZES OF OPENINGS
FOR VENT FANS REVISED. ADJUST
CONDUITS TO MEET REVISIONS.

② INSTALL COUPLING @ SLIP JOINT FOR
CONDUIT FROM ELECTRIC HANDHOLE.

ENCASE THESE CONDUITS
IN CONCRETE BETWEEN
BUILDING AND MANHOLE

TO MANHOLE OUTSIDE
SEE DRAWING VB-1

2	7-20-56	AIR DUCT OPENINGS	H.M.	JO
1	4-16-56	SEE NOTE	E.V.	JO
REVISION	DATE	DESCRIPTION	MADE BY	CHK. BY

LAW & WILSON
ARCHITECTS & ENGINEERS
DEPARTMENT OF PUBLIC WORKS
CITY AND COUNTY OF HONOLULU
BUREAU OF PLANS
KALIHI TUNNEL
ELECTRICAL-VENT. BLDG.
EQUIPMENT & GROUND FLOOR
CONDUIT ROUTING

ENGINEER: L.S.W.
DRAFTSMAN: S.H.R.
SCALE: 1/4" = 1'-0"
APPROVED: *[Signature]*
CHIEF ENGINEER

DATE: JULY 15, 1958
CHECKED BY: *[Signature]*
TRACER:
APPROVED: *[Signature]*
BUREAU ENGINEER

W.S.	PROFILE	C.B.
CR. SEC.	F.B.	S.B.
W.M.B.Y.	F.W.B.Y.	S.B.Y.

APPROVED:
[Signature]
ENGINEER, KALIHI TUNNEL

FILE	FOCKET	FOLDER	NO.
7	6	3	21