


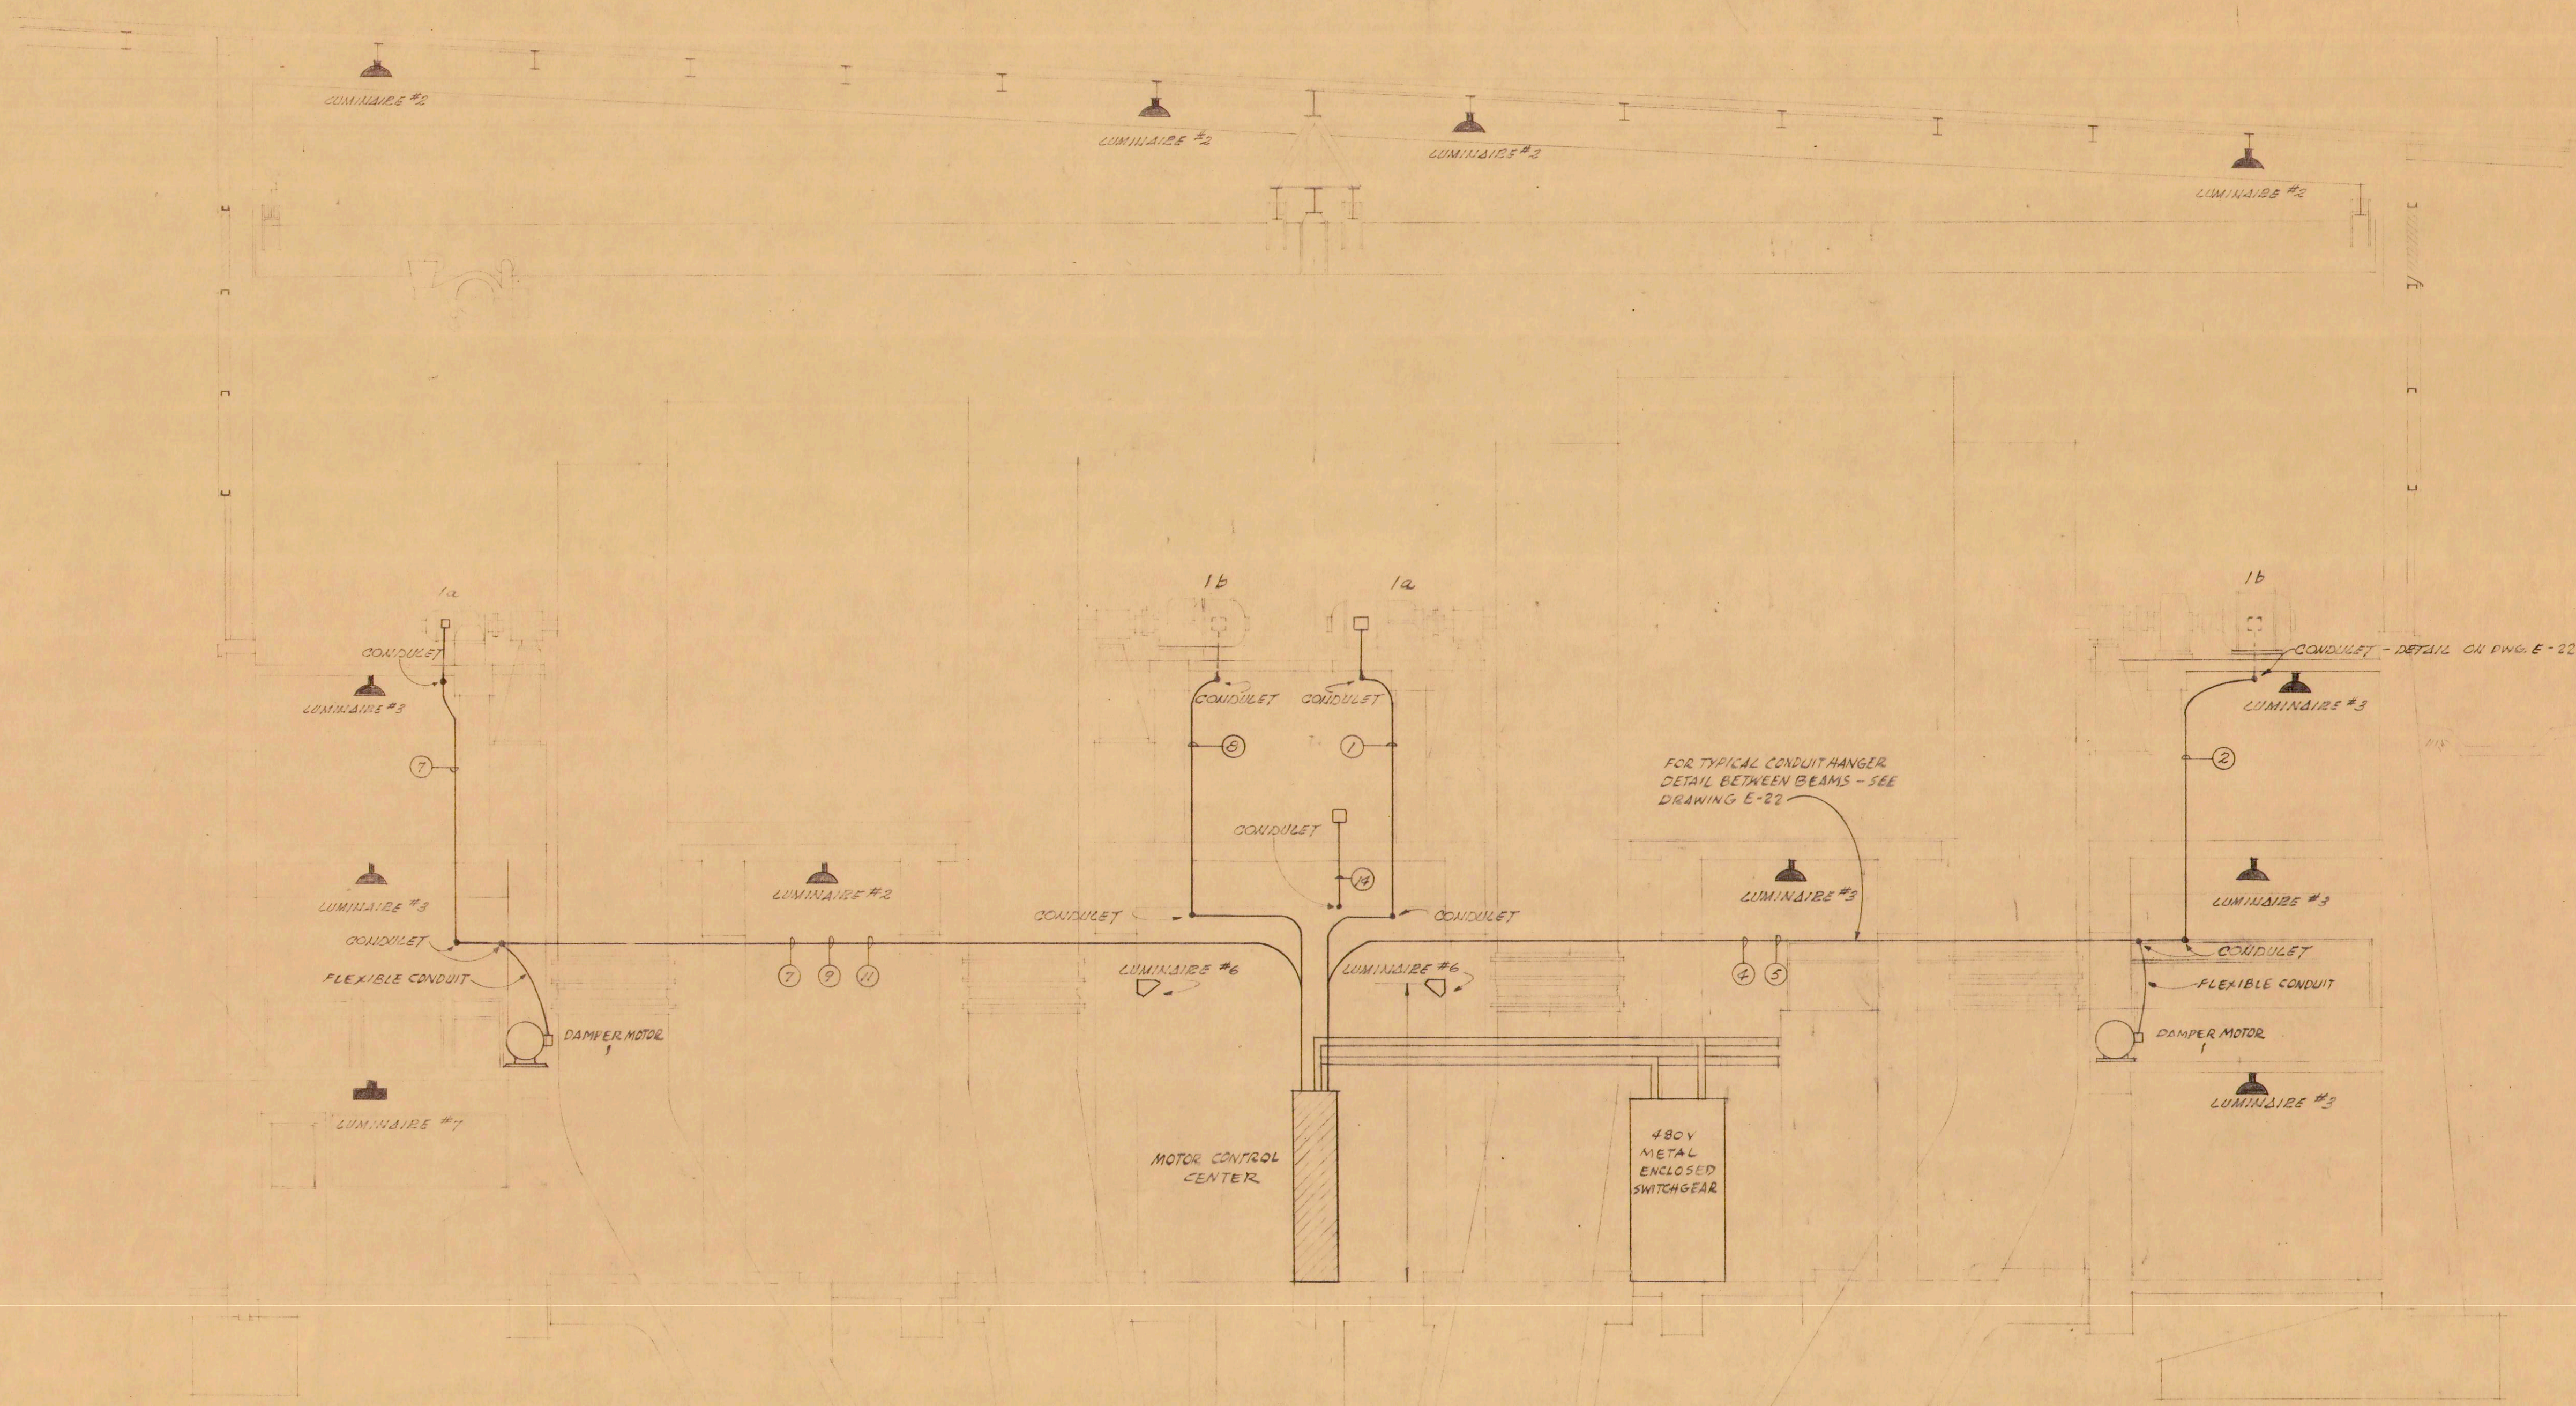

NOTE: LOCATION AND SIZES OF OPENINGS FOR VENT FANS REVISED. ADJUST ELECTRICAL CIRCUITS TO MEET REVISIONS.

1	4-16-56	SEE NOTE	E.W.	PD
REVISION	DATE	DESCRIPTION	MADE BY	CHK BY

LAW & WILSON
ARCHITECTS & ENGINEERS
DEPARTMENT OF PUBLIC WORKS
CITY AND COUNTY OF HONOLULU
BUREAU OF PLANS

KALIHI TUNNEL
ELECTRICAL - VENT. BLDG.
LUMINAIRE LOCATION & CONDUIT ROUTING
TRANSVERSE SECTION

ENGINEER - L. B. W. DATE - JULY 15, 1953
DRAFTSMAN - M. H. CHECKED BY - J. C. [Signature]
SCALE - 1/4" = 1'-0" TRACER -
APPROVED: [Signature] CHIEF ENGINEER APPROVED: [Signature] BUREAU ENGINEER

W. S.	PROFILE	C. B.
CR. SEC.	F. B.	S. B.
W. M. BY	P. W. BY	S. BY

SECTION C JOB NO. 26-53 DWG. E-20