


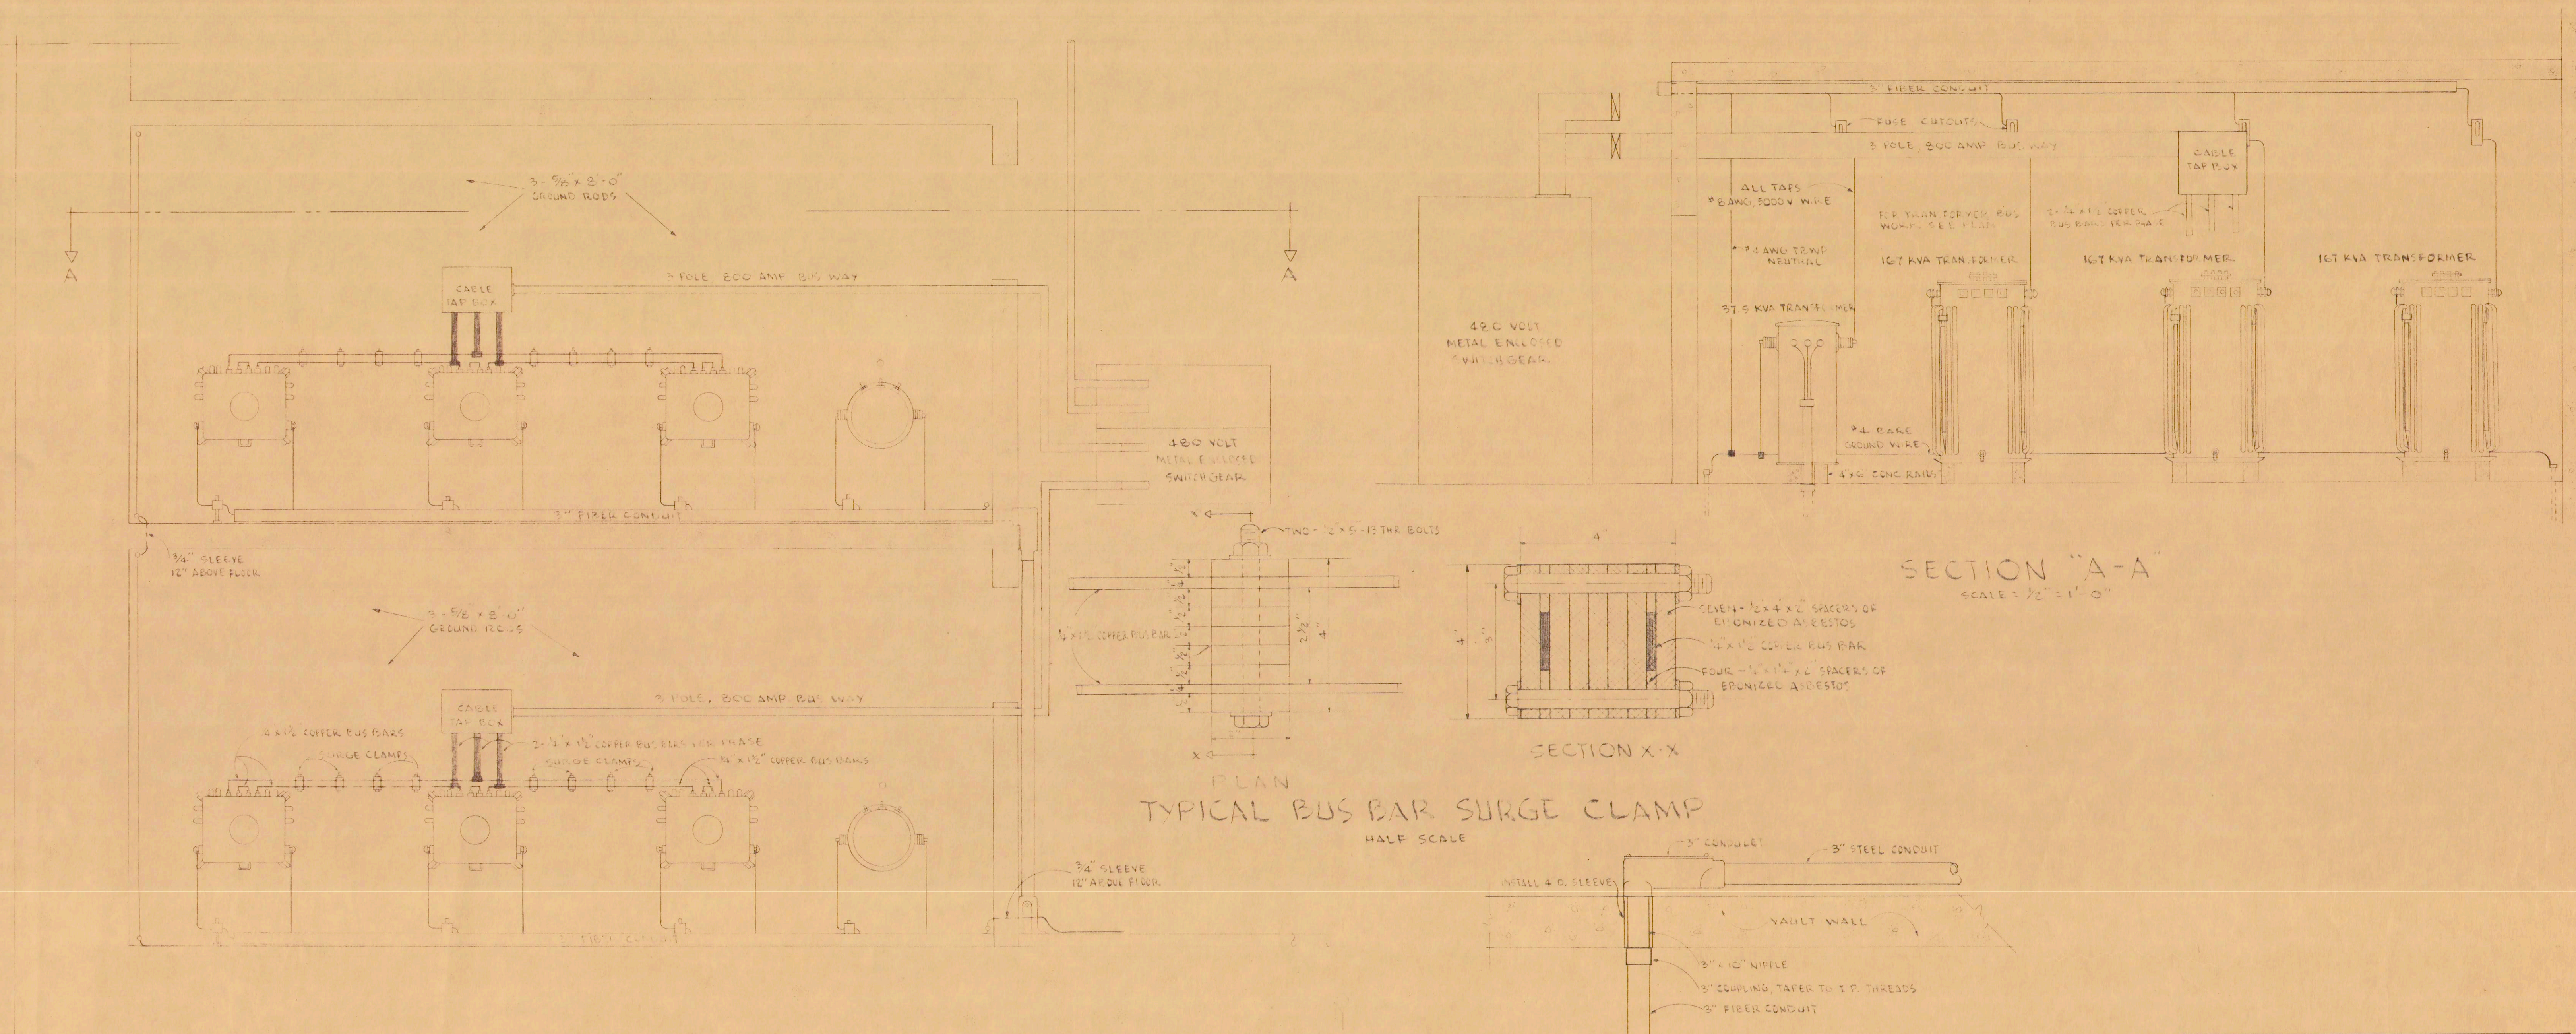

PLAN
SCALE: 1/2" = 1'-0"

PLAN
TYPICAL BUS BAR SURGE CLAMP
HALF SCALE

SECTION "A-A"
SCALE: 1/2" = 1'-0"

SECTION X-X

ENTRANCE OF CONDUIT
SCALE: 1" = 1'-0"

LAW & WILSON
ARCHITECTS & ENGINEERS

DEPARTMENT OF PUBLIC WORKS
CITY AND COUNTY OF HONOLULU
BUREAU OF PLANS

KALIHI TUNNEL
ELECTRICAL - VENT. BLDG.
TRANSFORMER VAULT DETAILS

ENGINEER: L. B. W. DATE: JULY 15, 1953
DRAFTSMAN: S. H. P. CHECKED BY: [Signature]
SCALE: AS NOTED TRACER: [Signature]

APPROVED: [Signature] APPROVED: [Signature]
CHIEF ENGINEER BUREAU ENGINEER

W.S.	PROFILE	C.B.
CR. SEC.	F.B.	S.B.
W.M. BY:	F.W. BY:	S.B. BY: