


FED. ROAD DIST. NO.	STATE	FED. AID PROJ. NO.	FISCAL YEAR	SHEET NO.	TOTAL SHEETS
HAWAII	HAW.	US-3-069001	1996	73	170

PLAN	BY	DATE
SURVEYED		
NOTE BOOK		
PLANNING CHECKED		
RET. OF WAY CHECKED		
NO.		



PROFILE	BY	DATE
SURVEYED		
NOTE BOOK		
GRADES CHECKED		
B. M. NOTED		
STRUCTURE NOTATIONS CHECKED		
NO.		

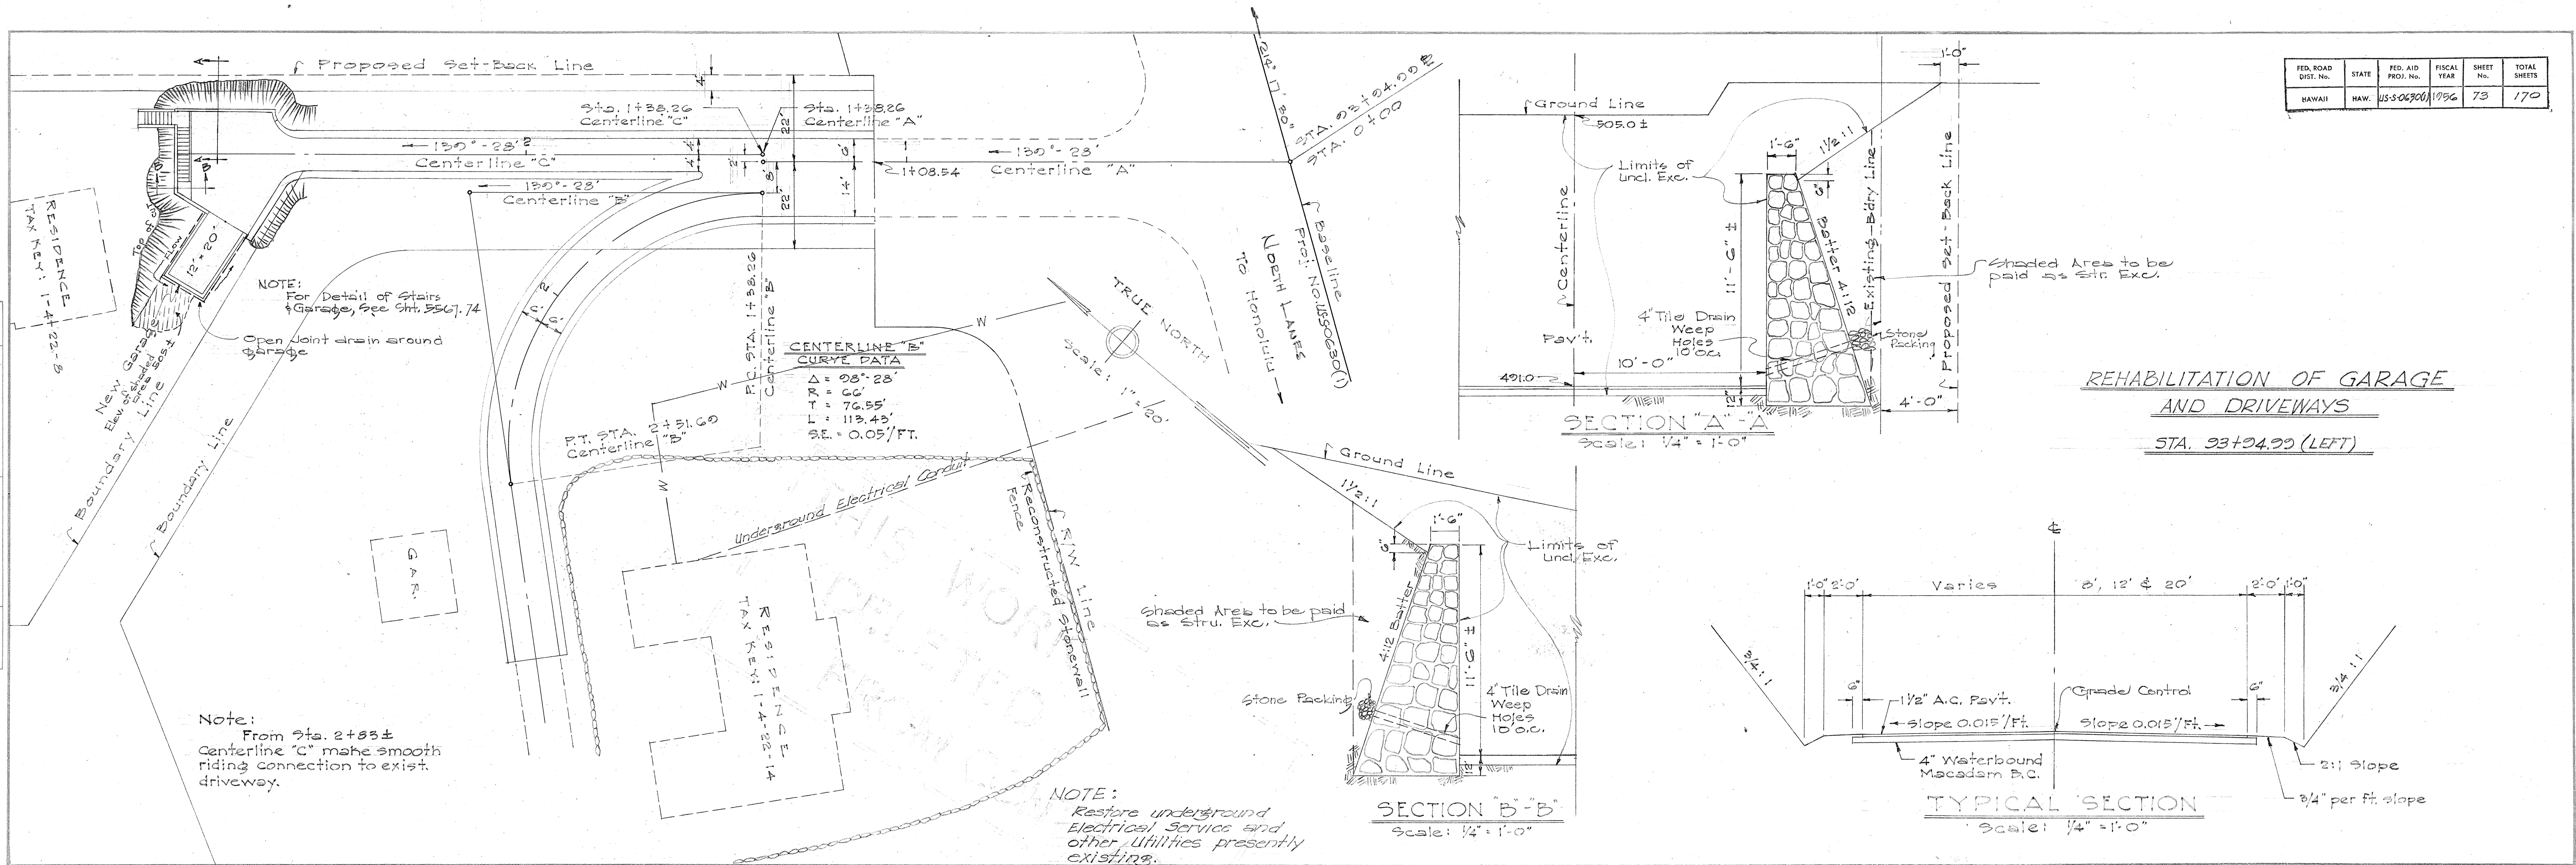