

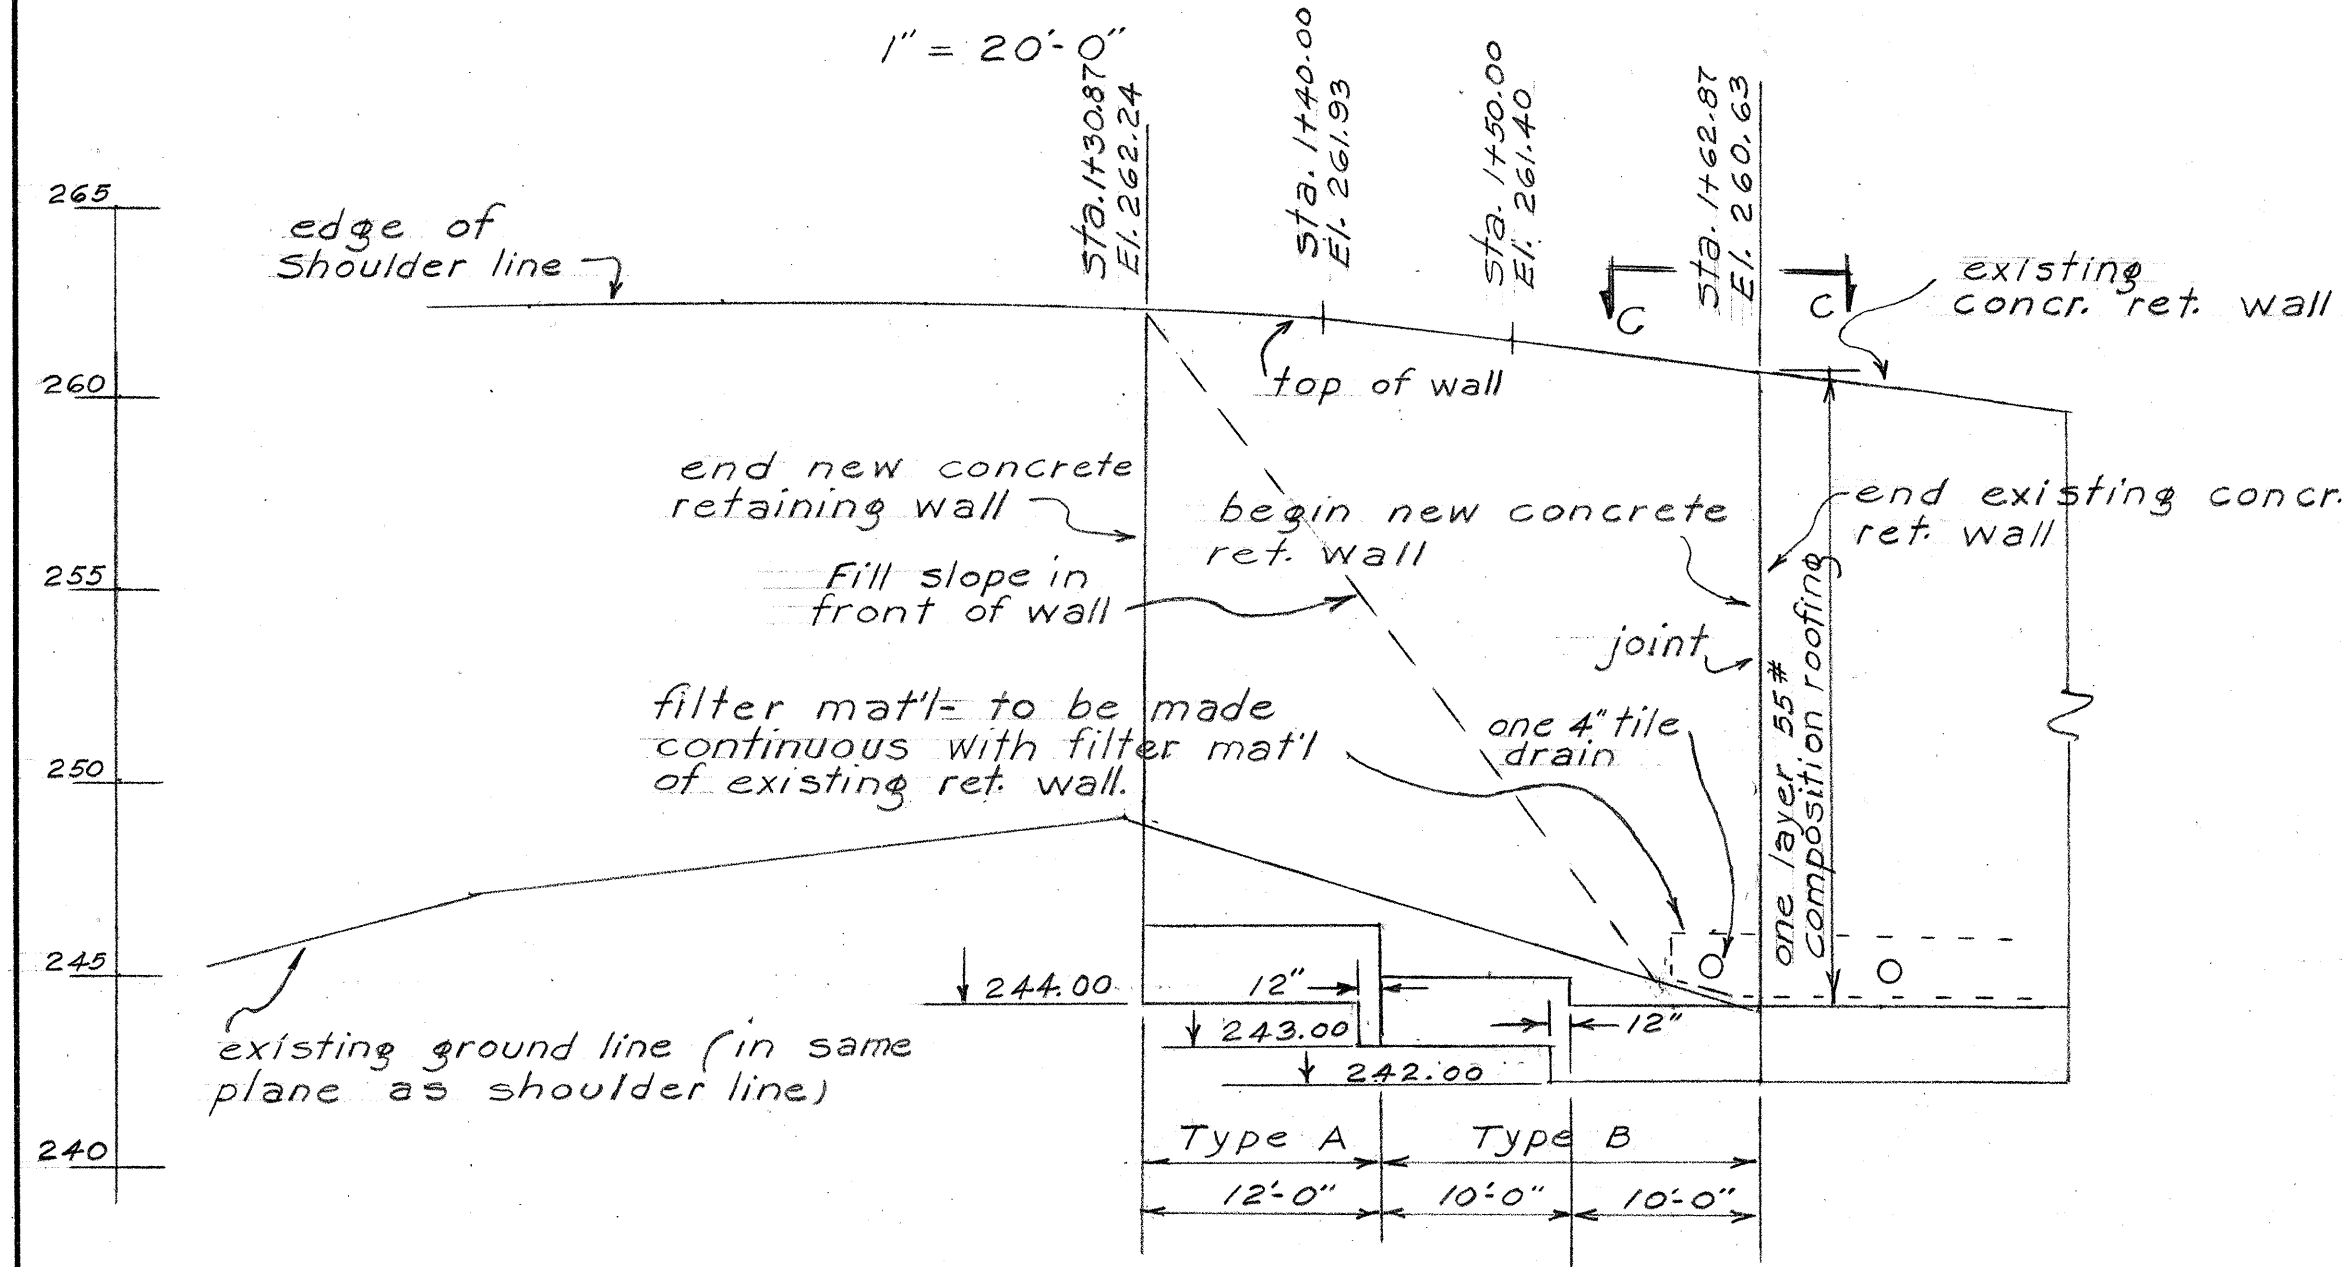



FED. ROAD DIST. NO.	STATE	FED. AID PROJ. NO.	FISCAL YEAR	SHEET NO.	TOTAL SHEETS
HAWAII	HAW	155-06300	1956	75	170

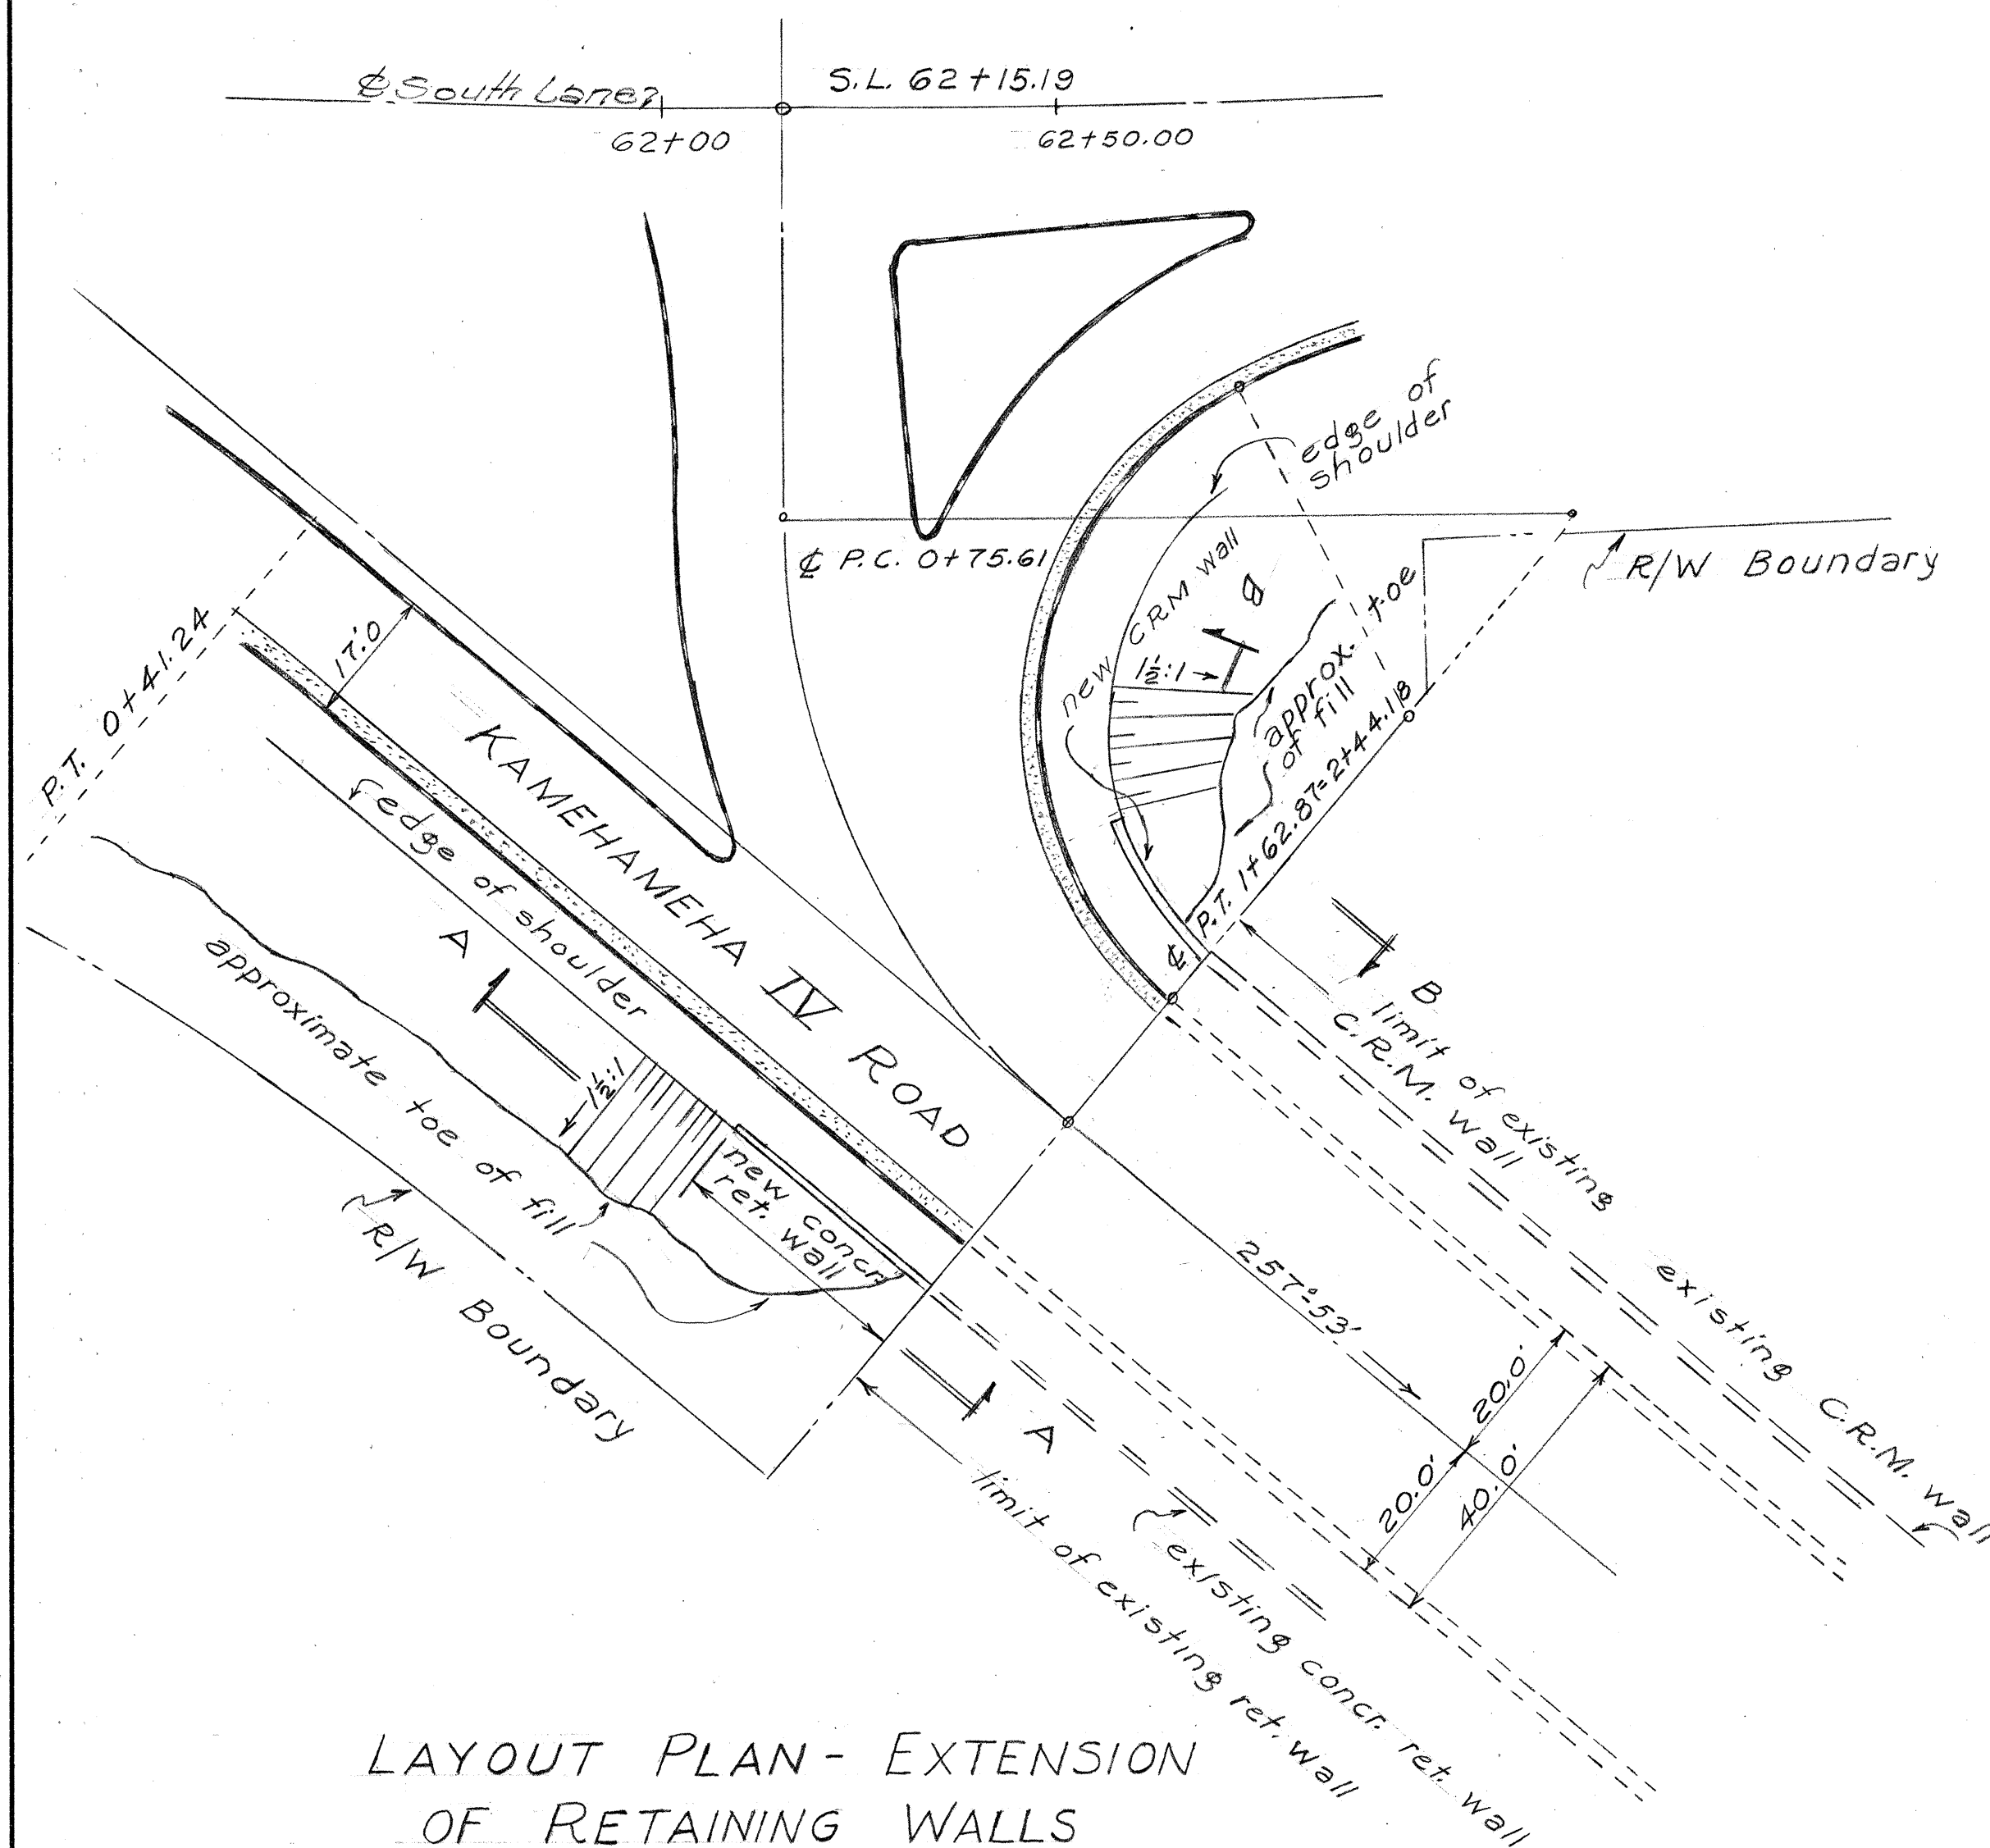


ELEVATION "A-A"
1" = 10'-0" HOR.
1" = 5'-0" VERT.

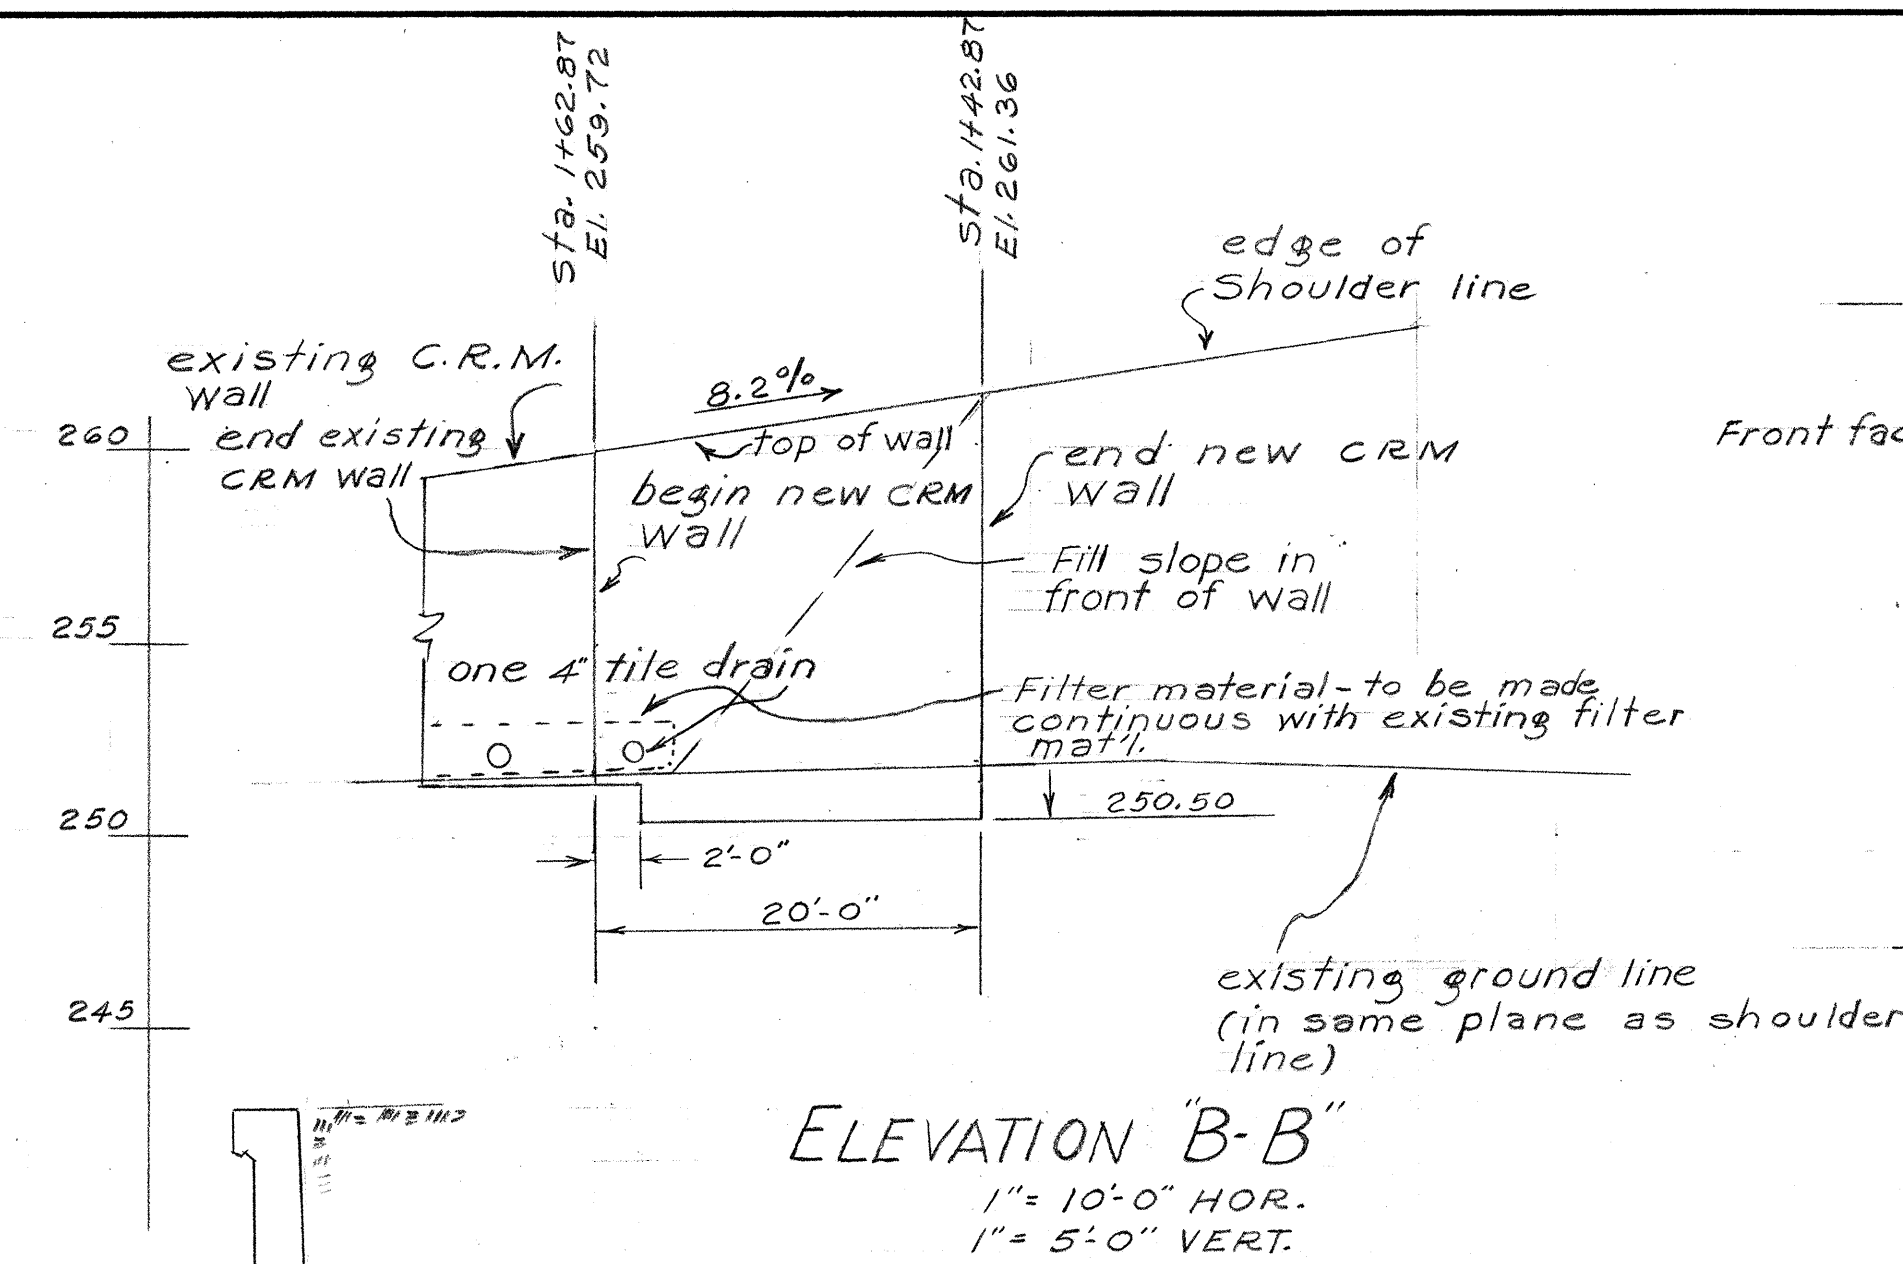


ELEVATION "B-B"
1" = 10'-0" HOR.
1" = 5'-0" VERT.

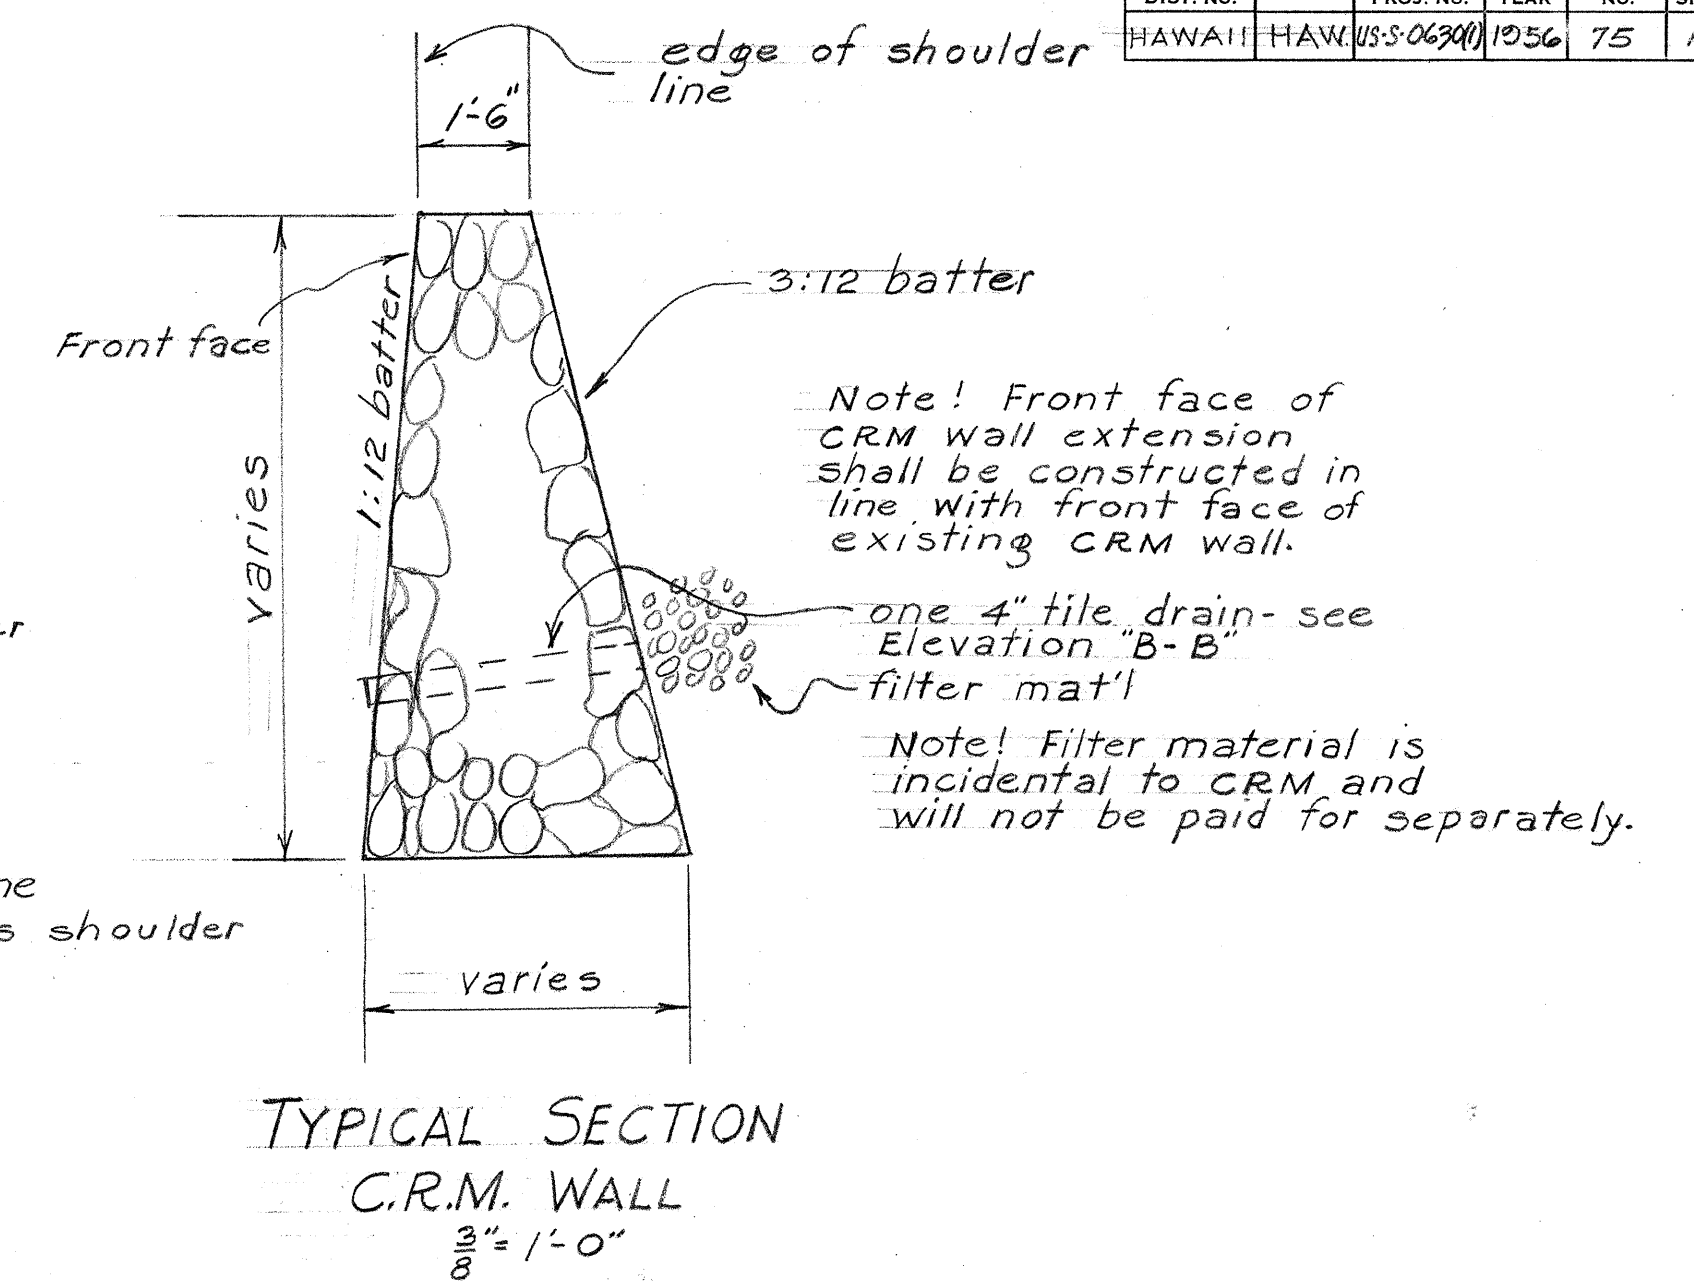

TYPICAL SECTION
C.R.M. WALL
3/8" = 1'-0"

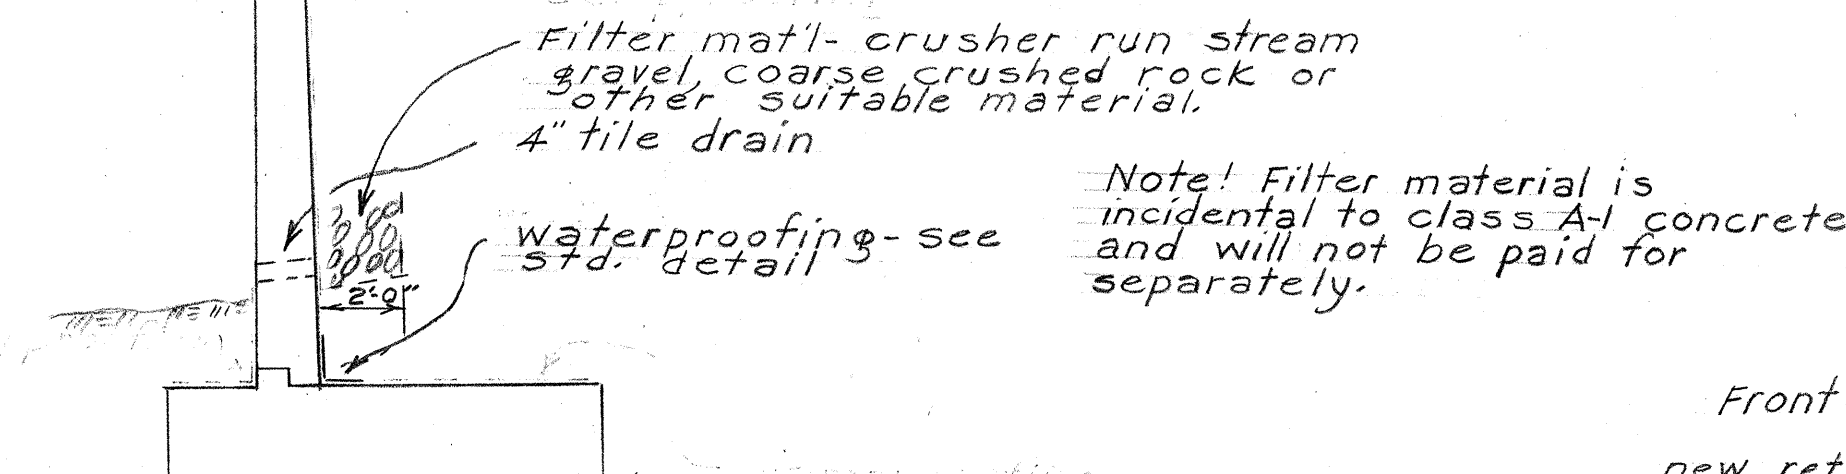


TYPICAL SECTION FOR
RET. WALL BACKFILL
1/4" = 1'-0"

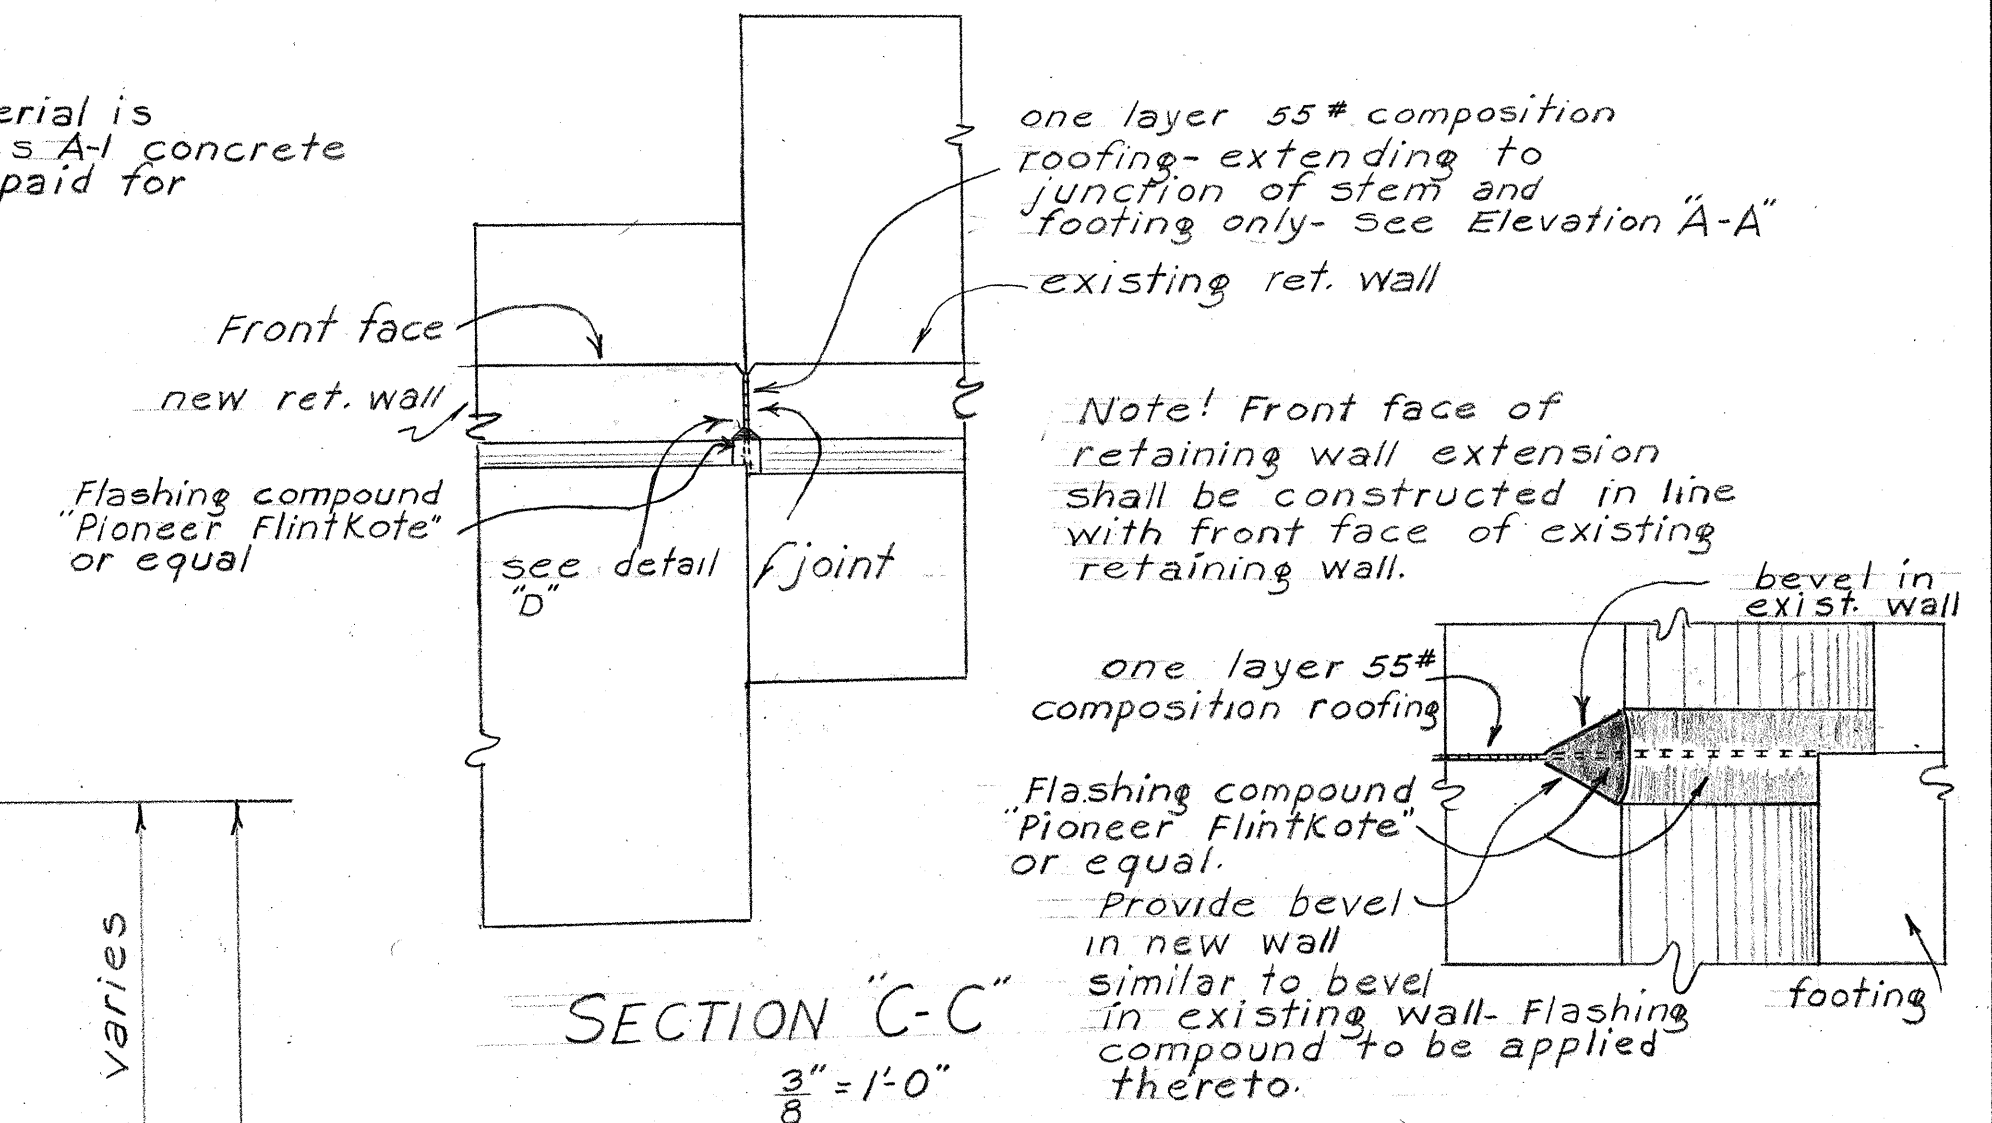

SECTION "C-C"
3/8" = 1'-0"

DETAIL "D"
3" = 1'-0"

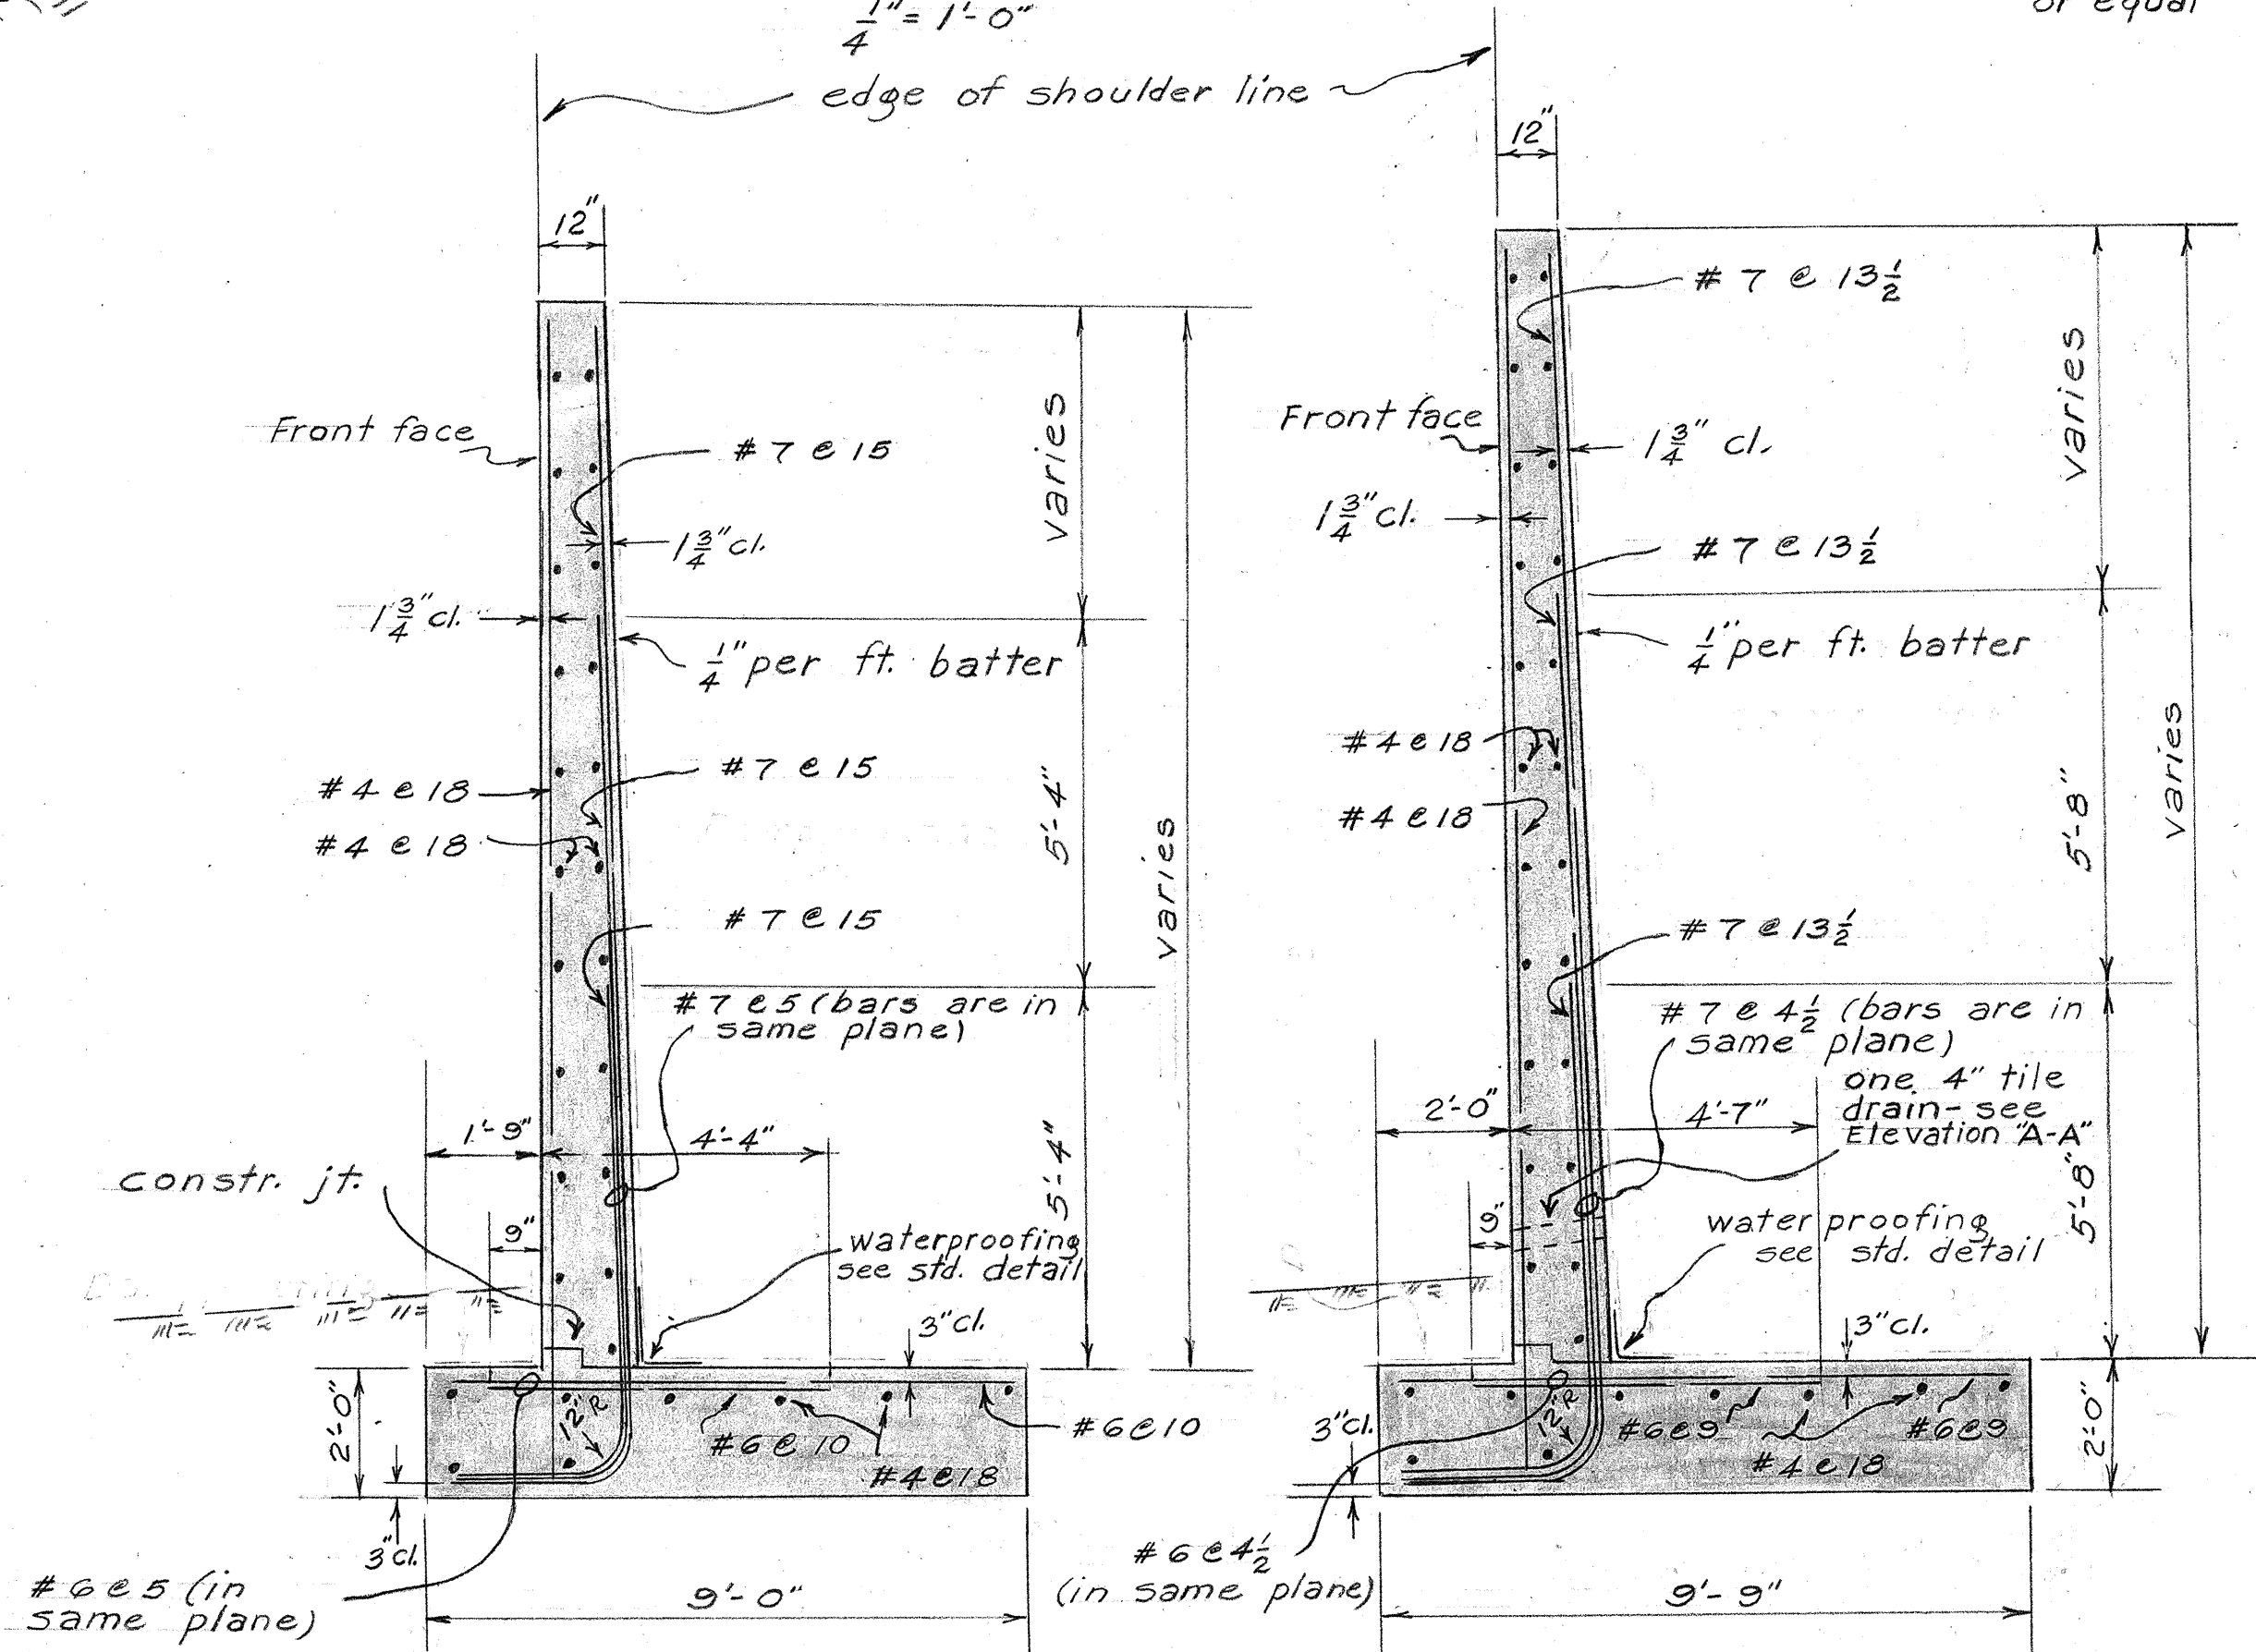

TYPE A
3/8" = 1'-0"

TYPE B
3/8" = 1'-0"

ESTIMATED QUANTITIES	
CLASS A-1 concrete	53.3 47 C.Y.
CRM	28.3 22 C.Y.
structure exc.	77.5 59 C.Y.
reinforcing steel	4362 4400 #

TERRITORIAL HIGHWAY DEPARTMENT	
TERRITORY OF HAWAII	
EXTENSION OF RET. WALLS	
177± R. B.L. STA. 62+51.19	
KALIHI VALLEY ROAD	
PROJ. NO. 155-0630(1)	
Scale: As noted	March, 1955

SHEET No. 1 OF 1 SHEETS

5567.75

SURVEY PLOTTED BY	DATE
DESIGNED BY	3/55
DRAWN BY	H. Chin
TRACED BY	
QUANTITIES BY	
CHECKED BY	
NOTE BOOK NO.	