
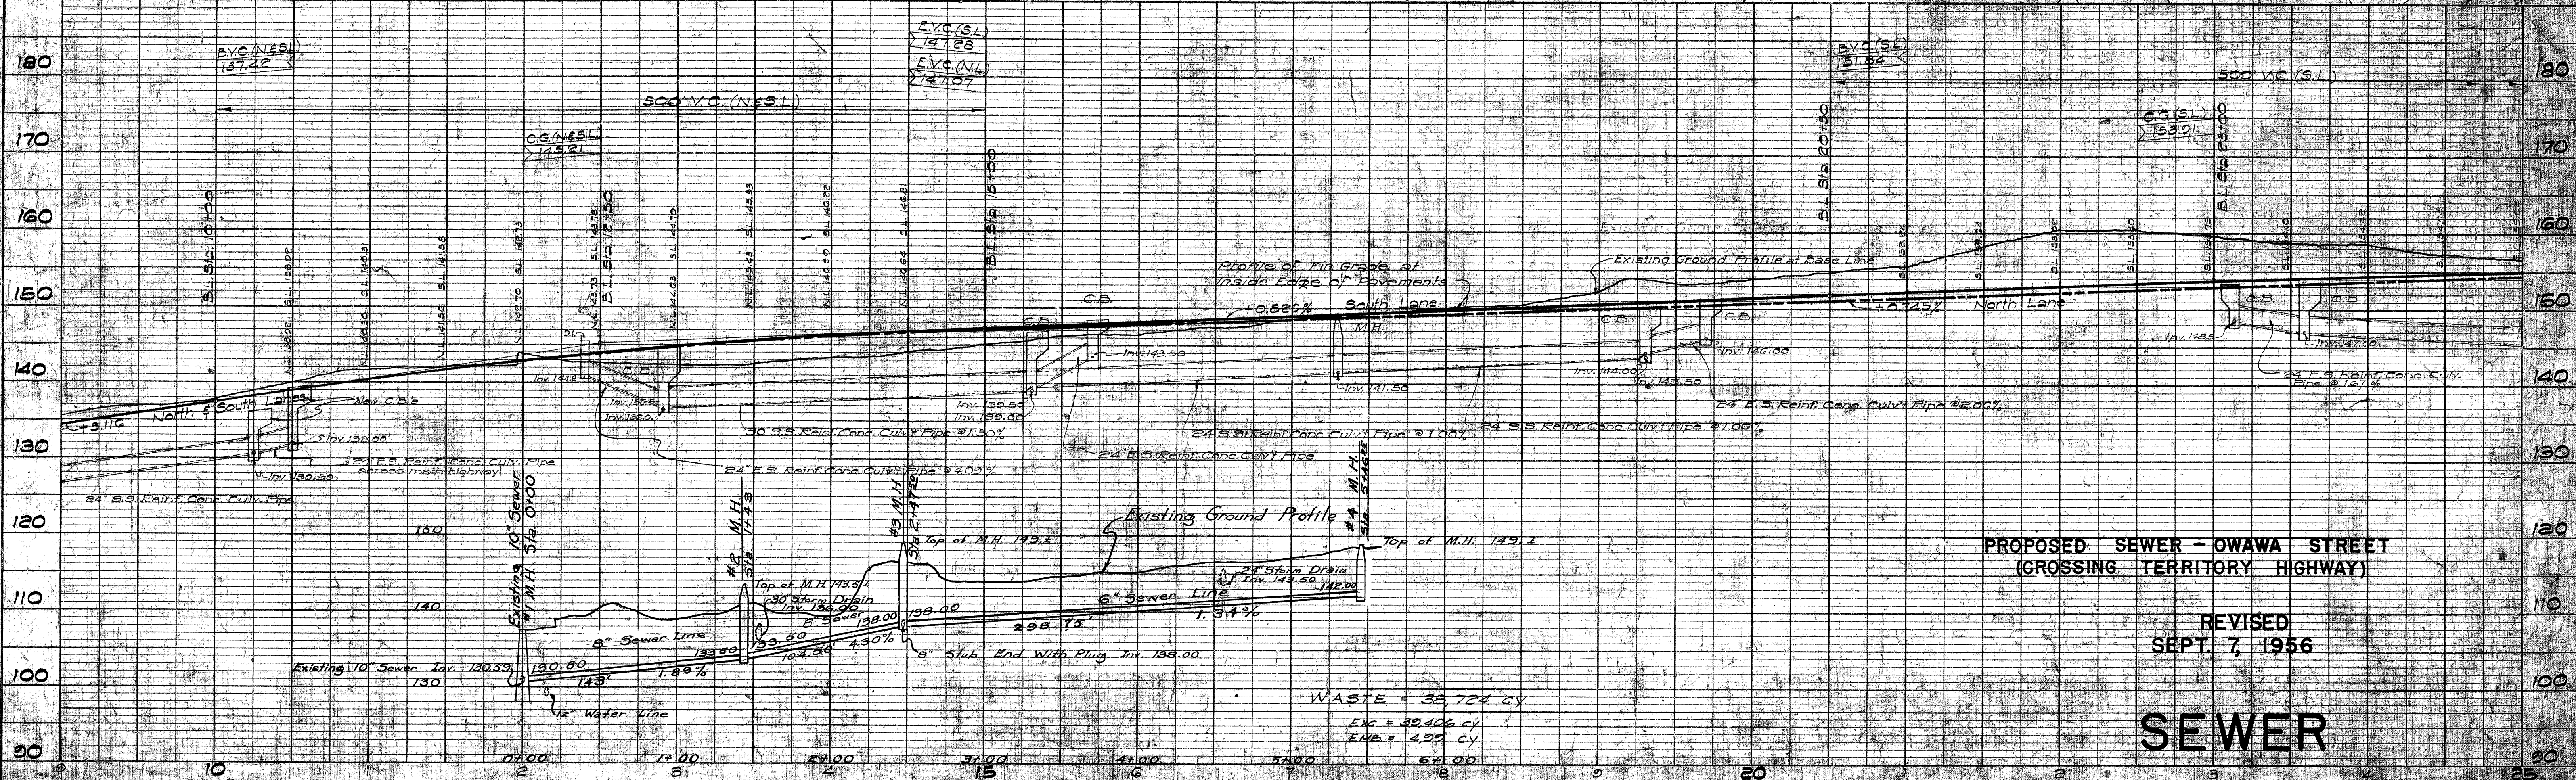


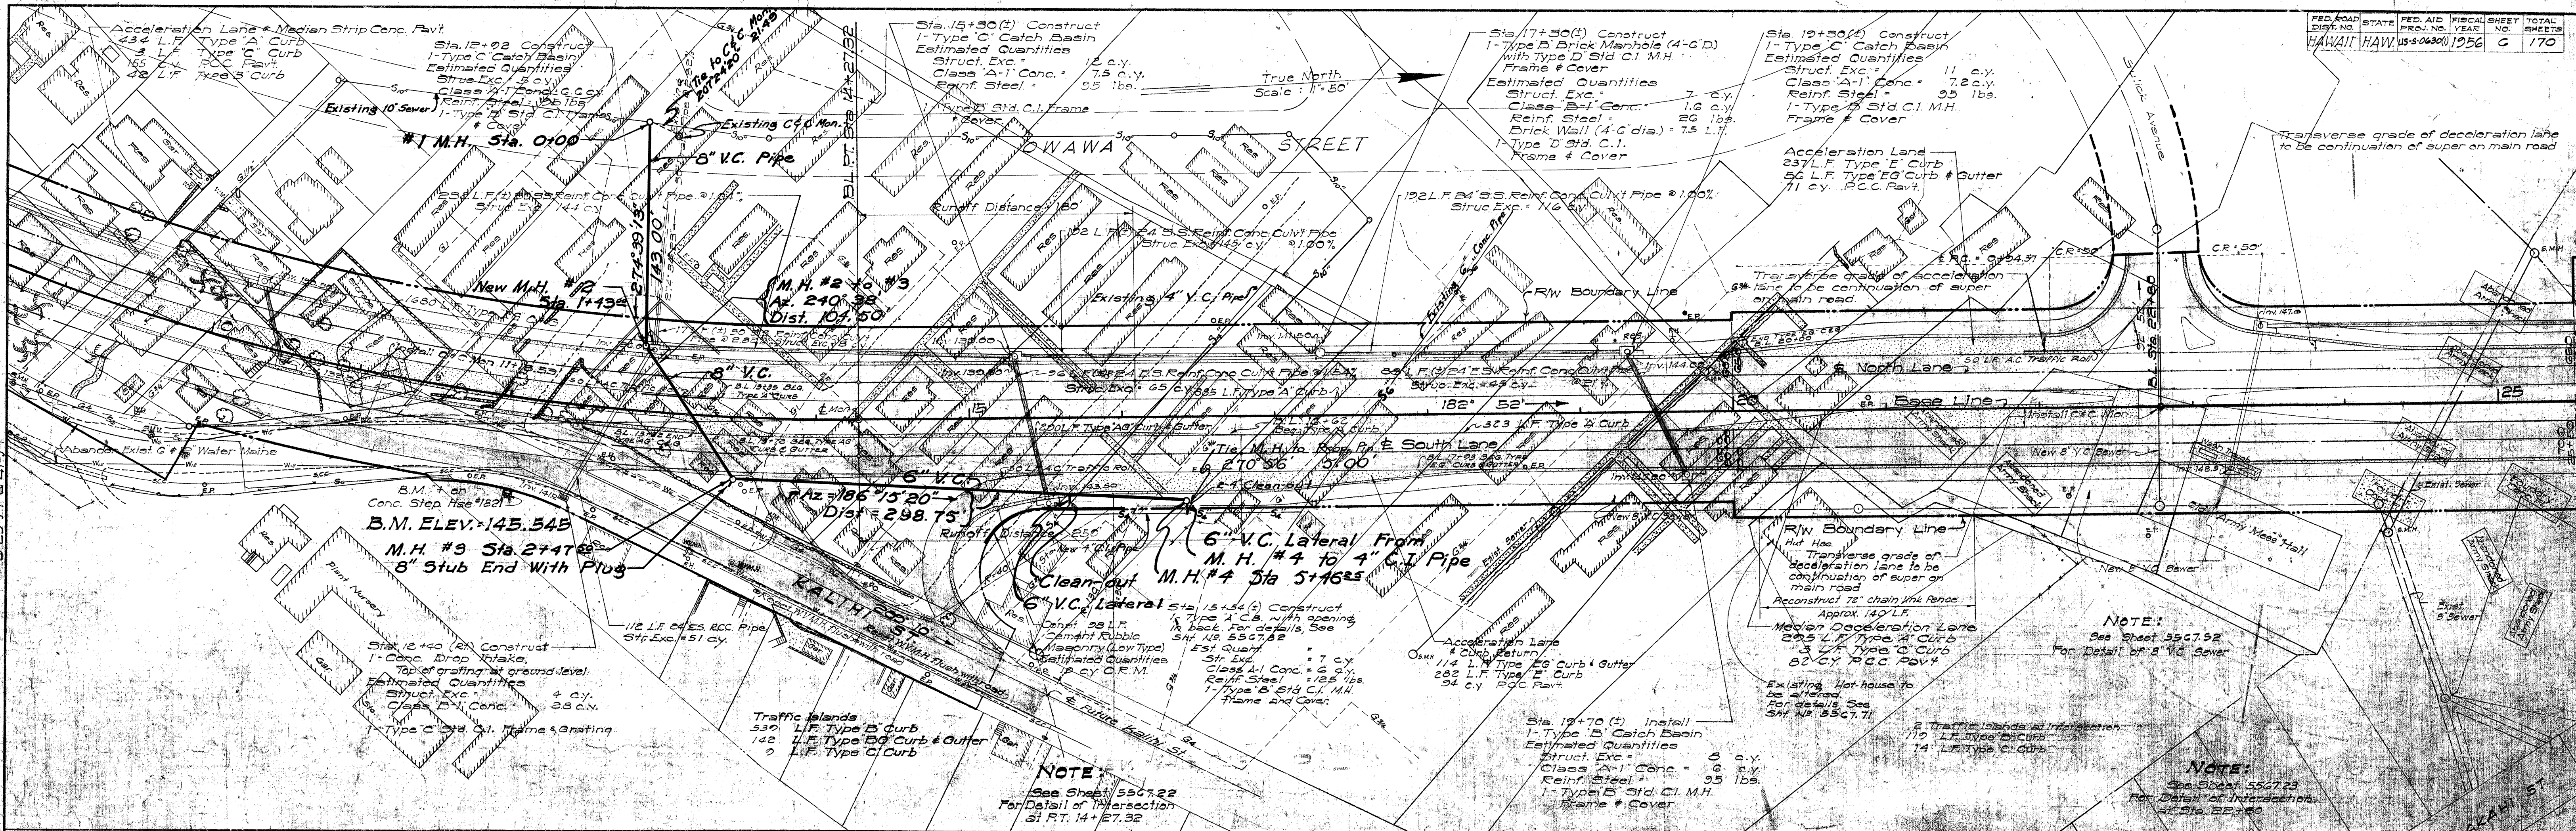


PROPOSED SEWER - OWAWA STREET
(CROSSING TERRITORY HIGHWAY)

REVISED
SEPT. 7, 1956



SEWER

5567.51A

FED. ROAD DIST. NO.	STATE	PROJ. NO.	FISCAL YEAR	SHEET NO.	TOTAL SHEETS
HAWAII	HAW.	US-5-0630	1956	52	170

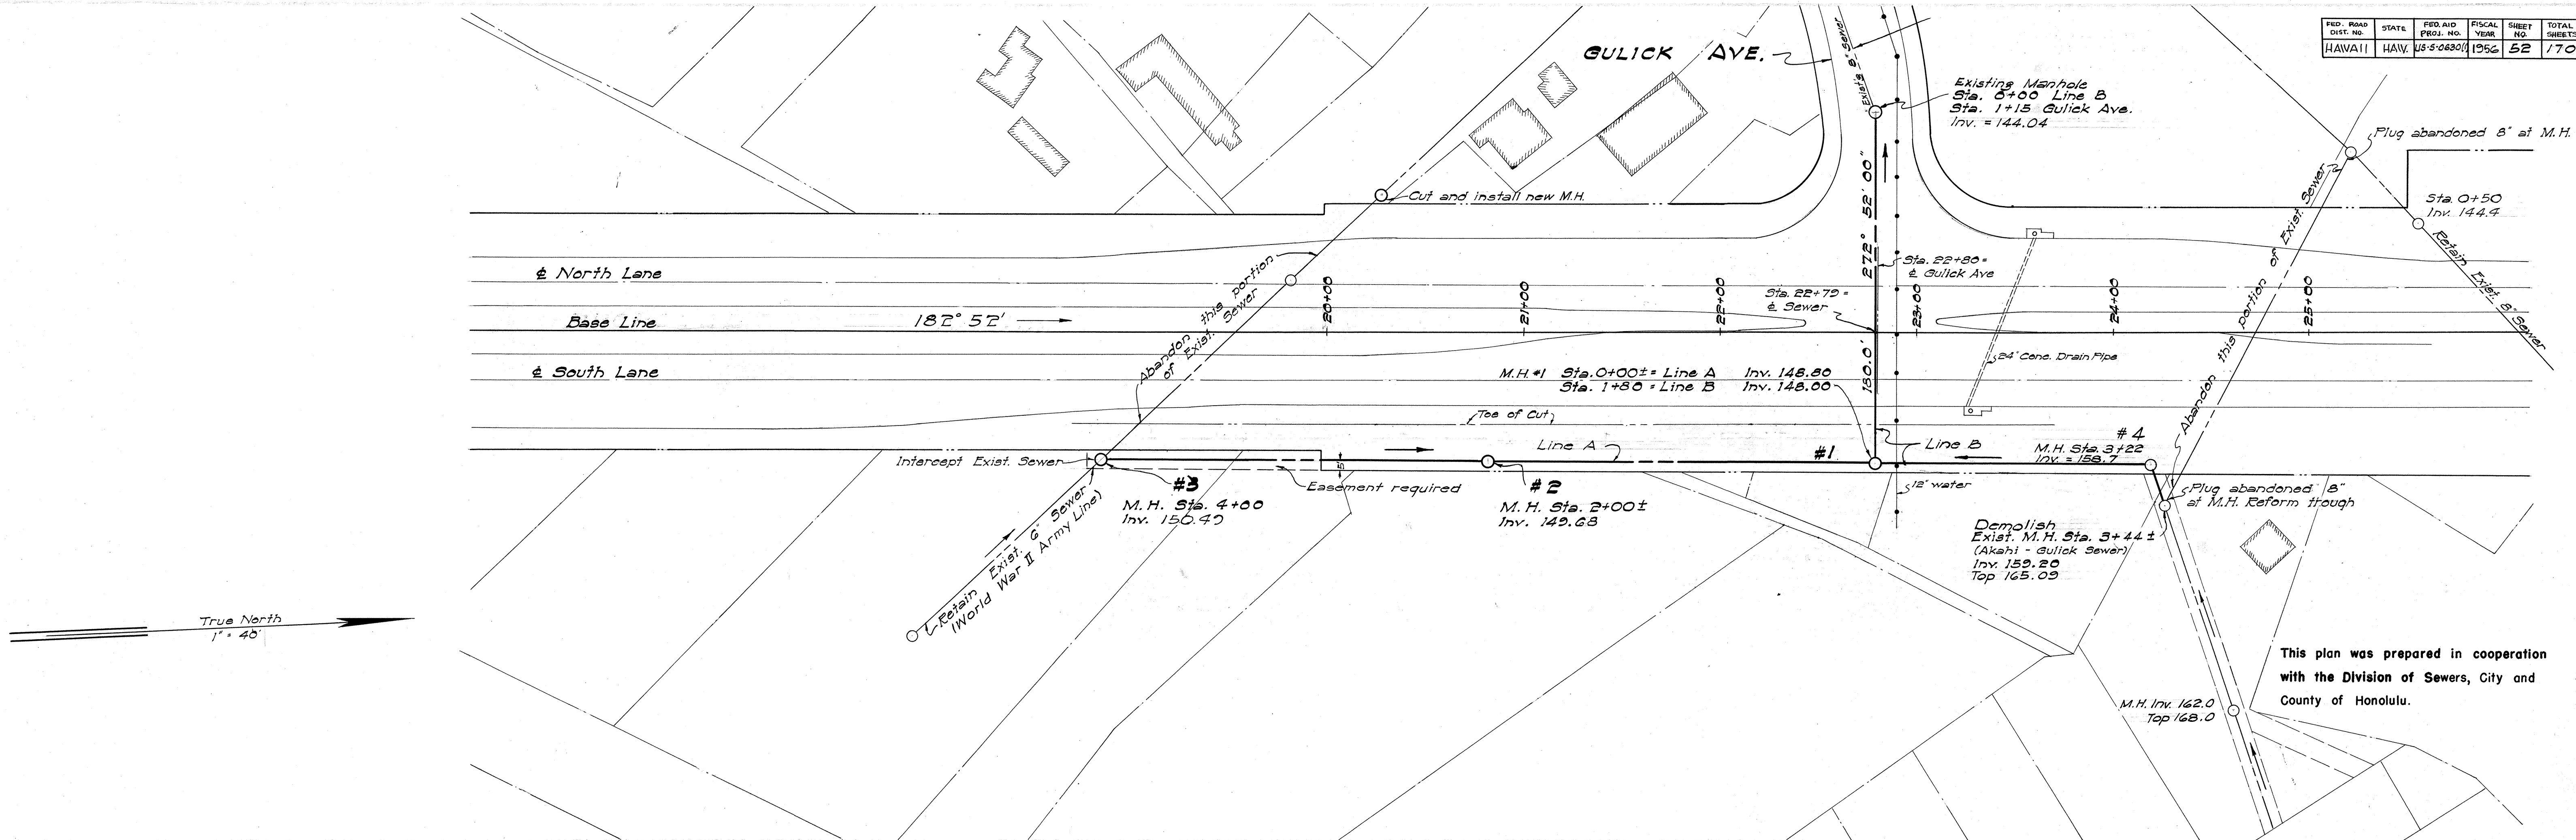


This plan was prepared in cooperation with the Division of Sewers, City and County of Honolulu.

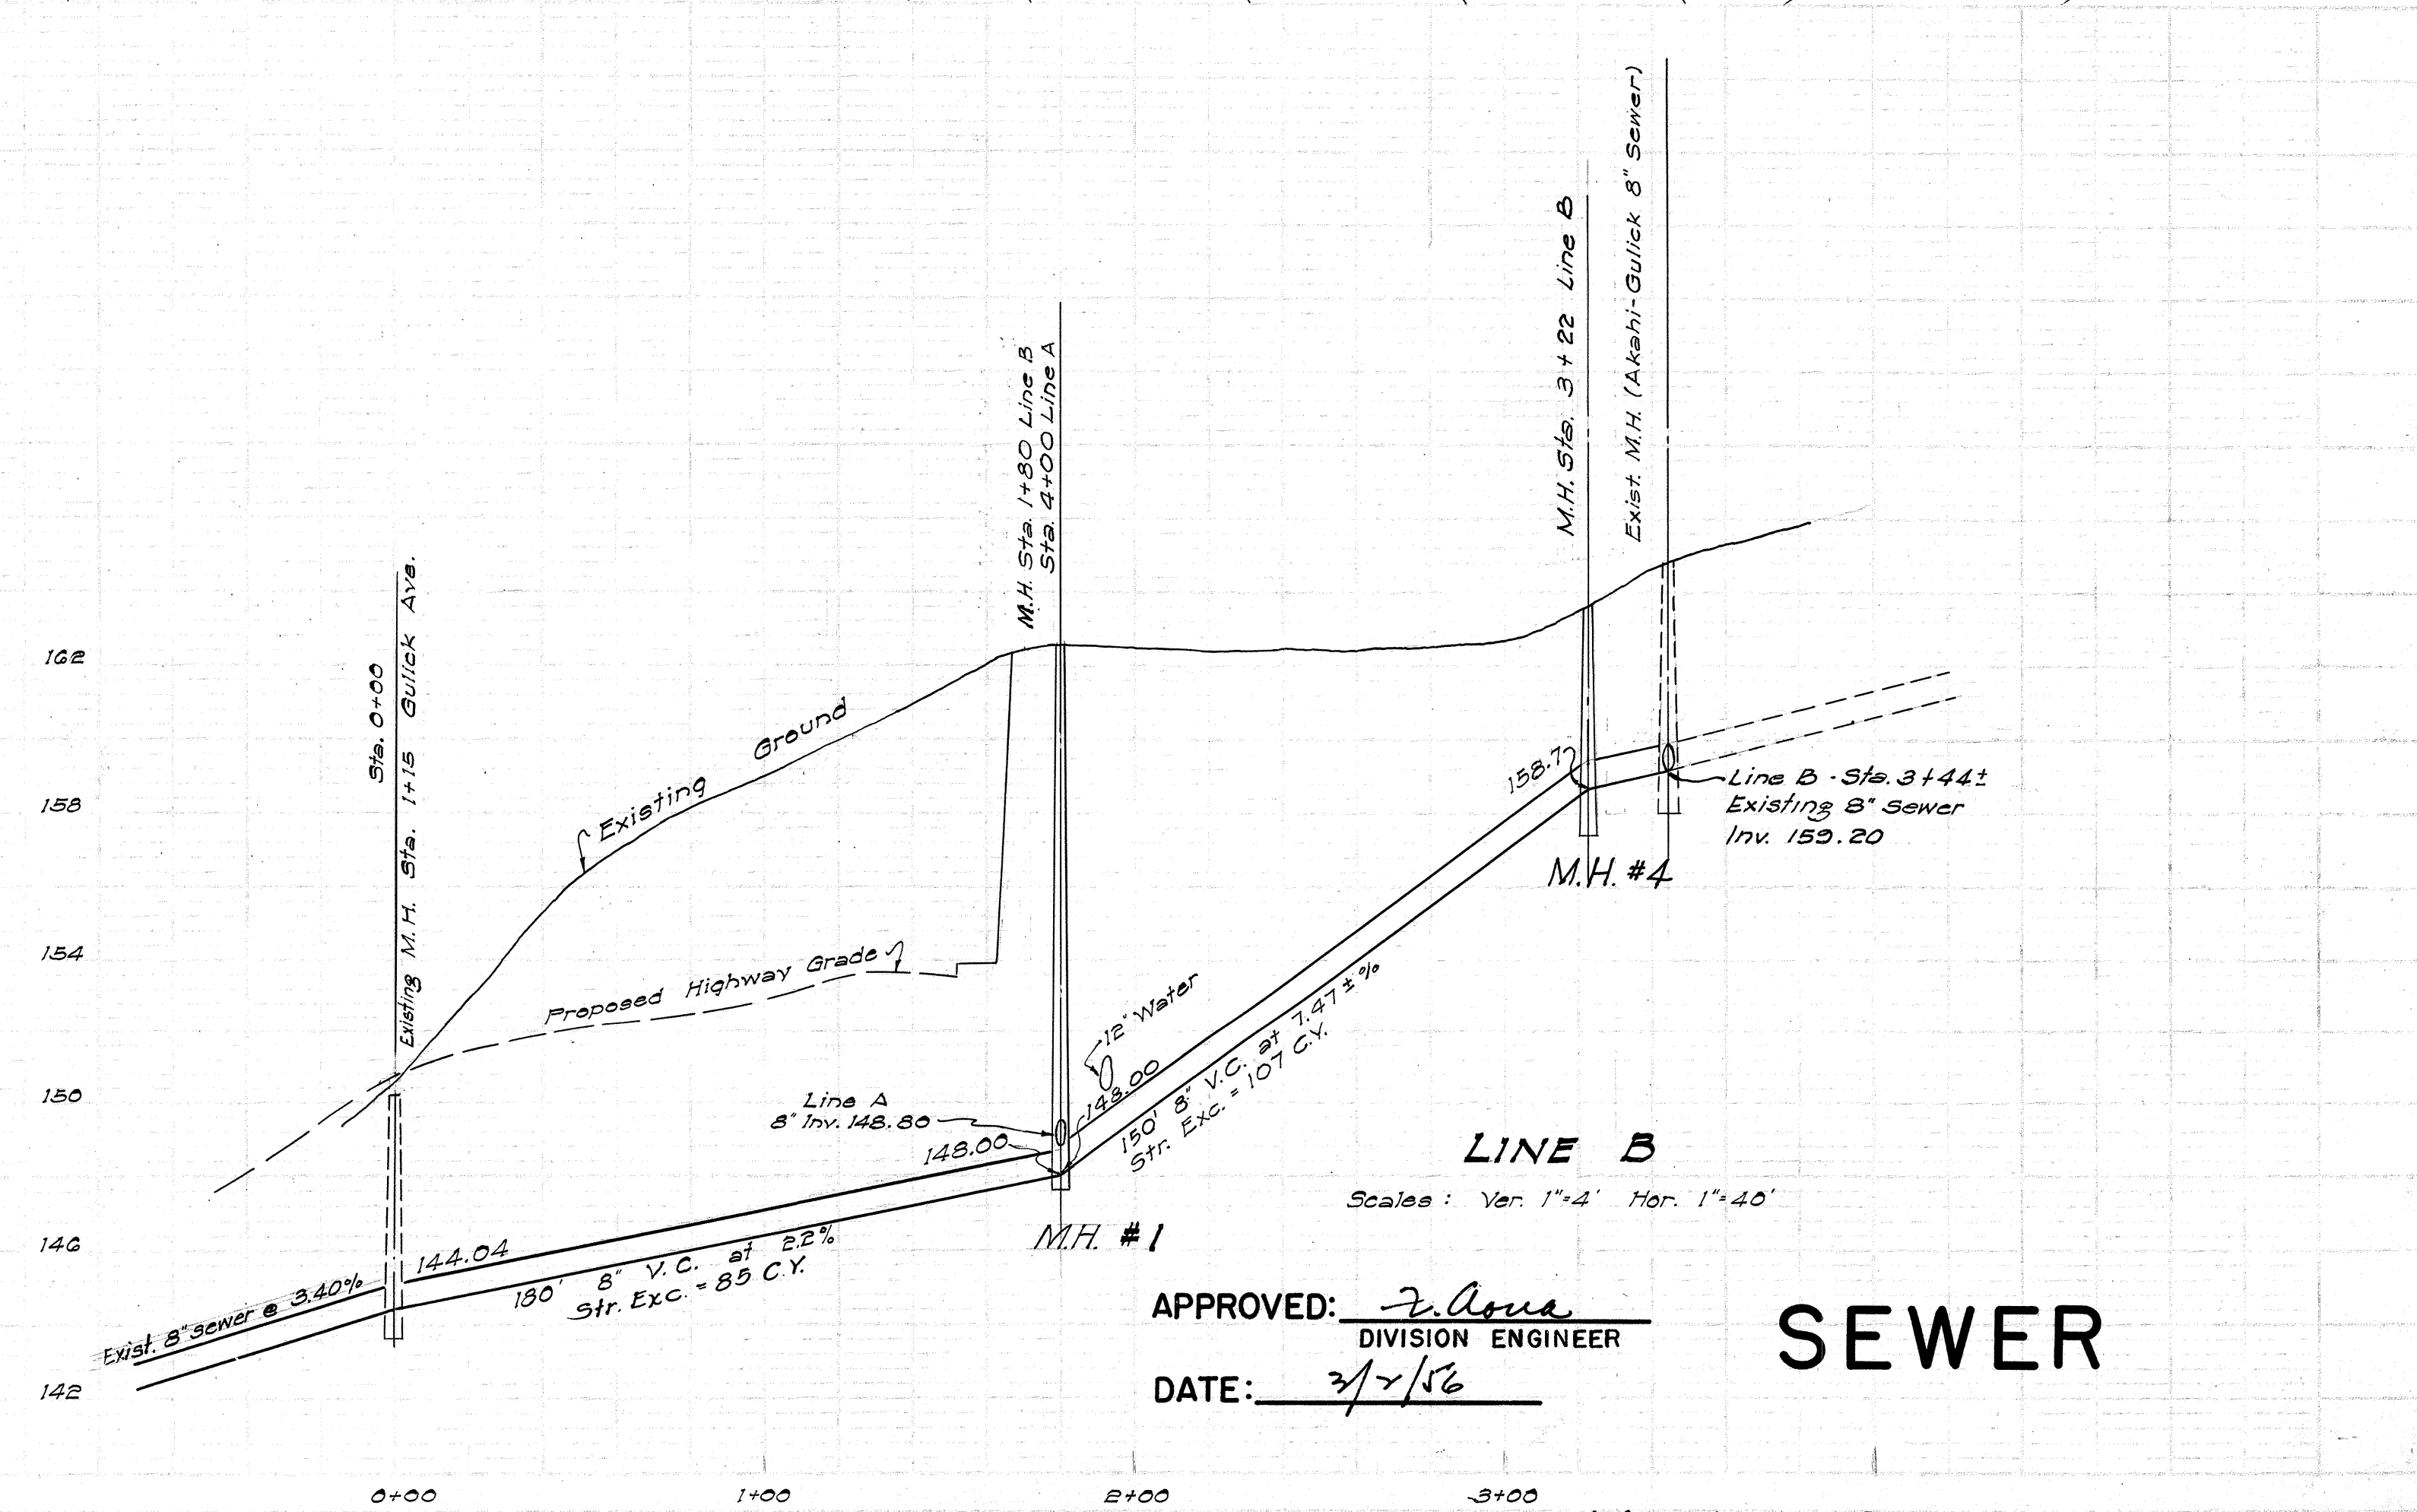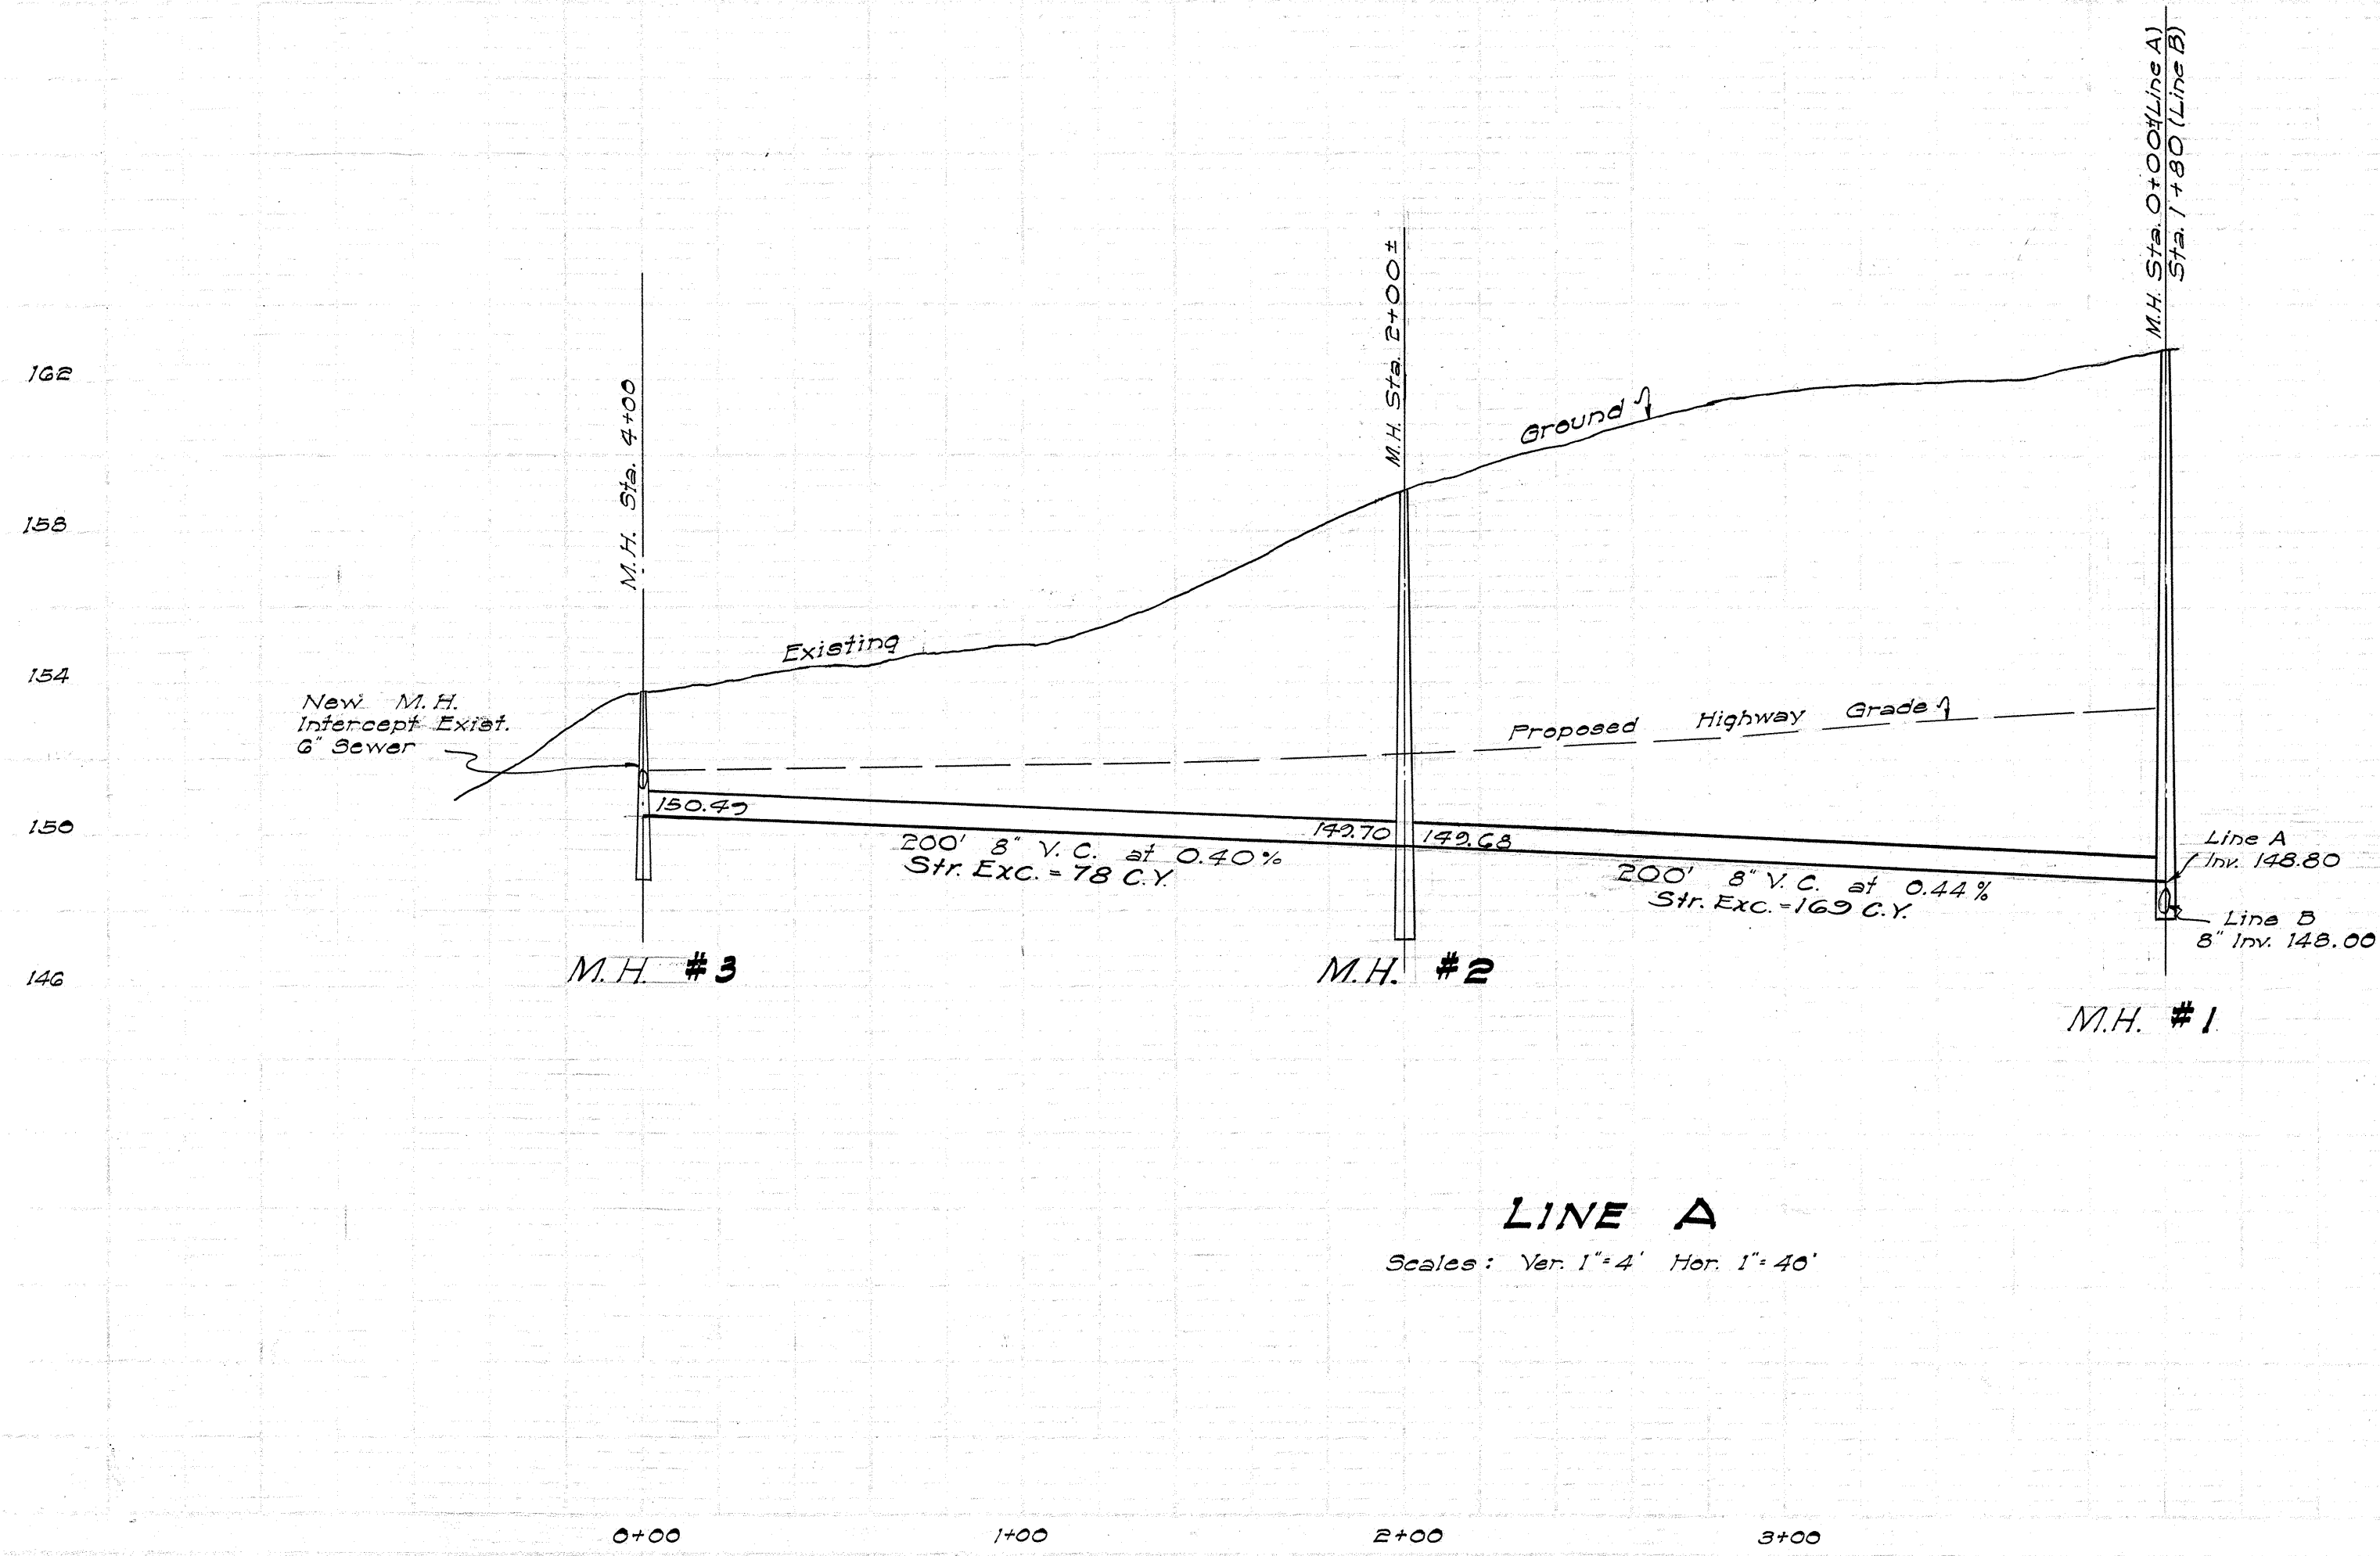


APPROVED: J. Davis
DIVISION ENGINEER
DATE: 3/7/56

SEWER


5567.52

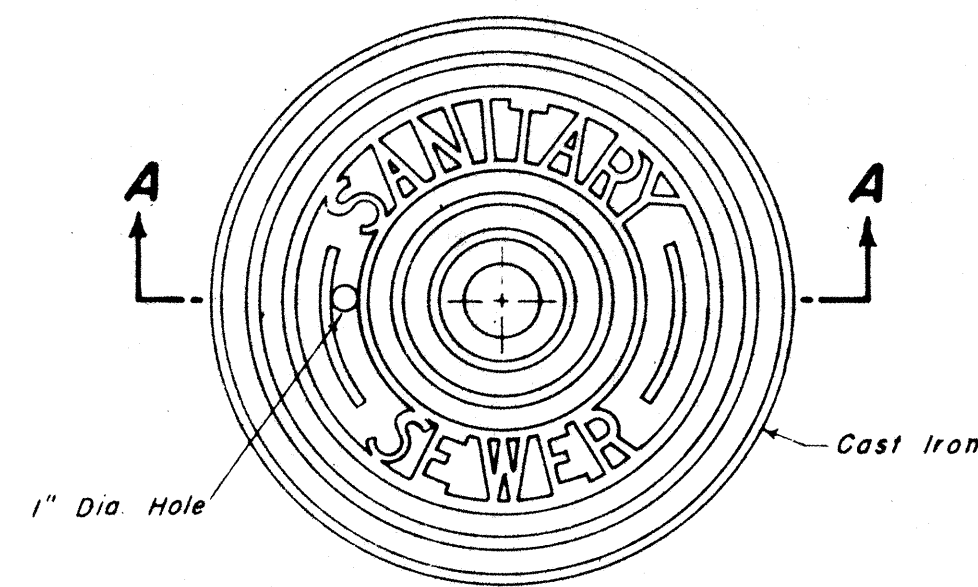


PLAN OF MANHOLE COVER
Scale 1-1/2" = 1'-0"

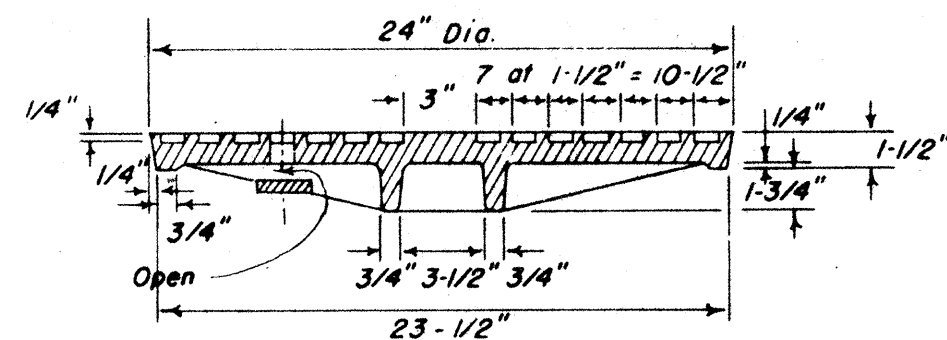


SECTION A - A

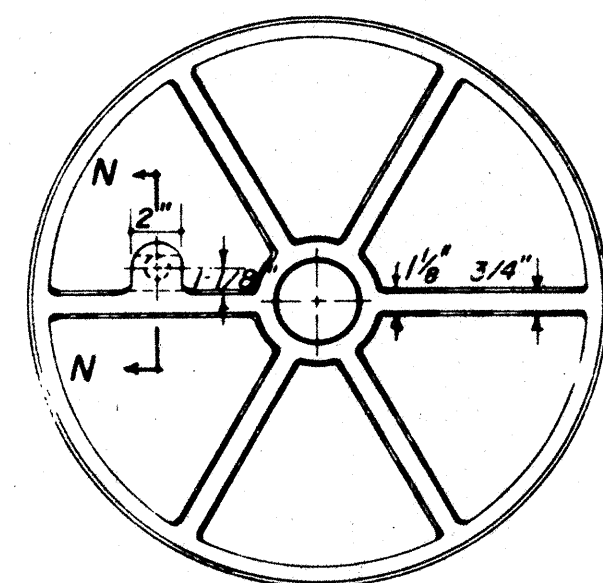

BOTTOM VIEW OF COVER
Scale 1-1/2" = 1'-0"

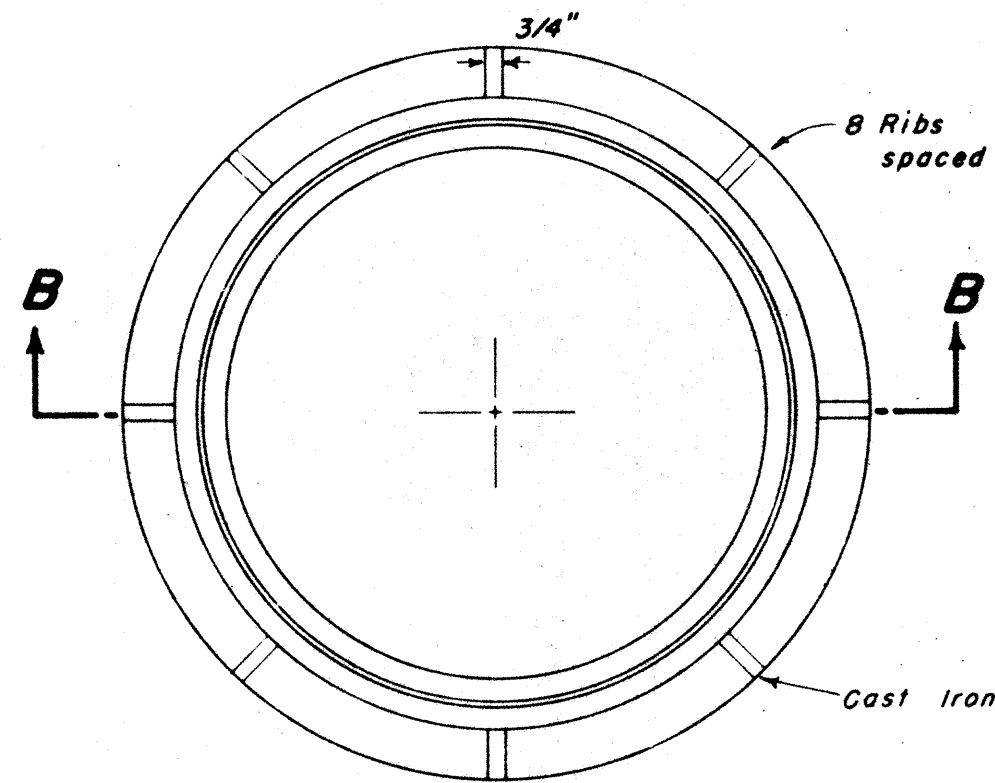

PLAN OF MANHOLE FRAME
Scale 1-1/2" = 1'-0"

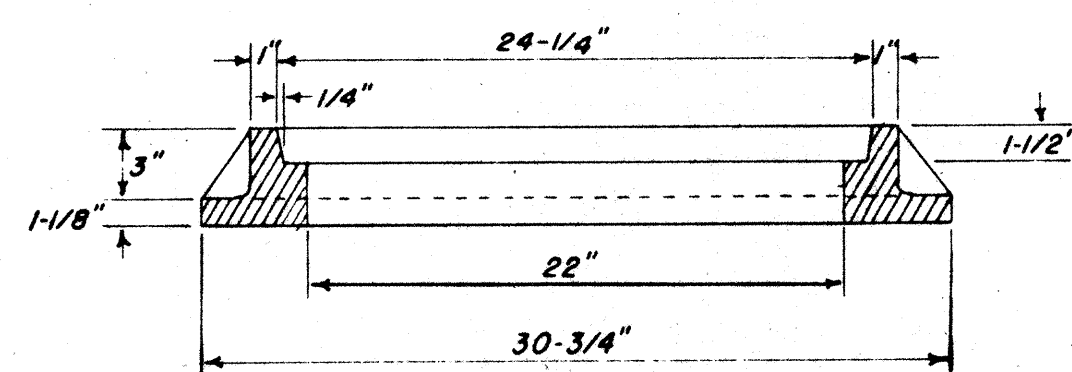


SECTION B - B

DROP MANHOLE CHIMNEY CASTINGS
Scale 1-1/2" = 1'-0"


Pipe Size	Min Width
6"	24"
8"	24"
10"	24"
12"	30"
15"	30"
18"	36"
21"	36"
24"	45"
27"	45"
30"	50"

Contractor shall set Concrete Blocks on undisturbed ground. Where ground is too low, the Contractor shall not heap up dirt under the Concrete Block but shall use Concrete Bricks to take up the deficiency, scraping away beneath Concrete Block to give sufficient room for Brick.


Note: Minimum width of cradle shall be minimum trench width.

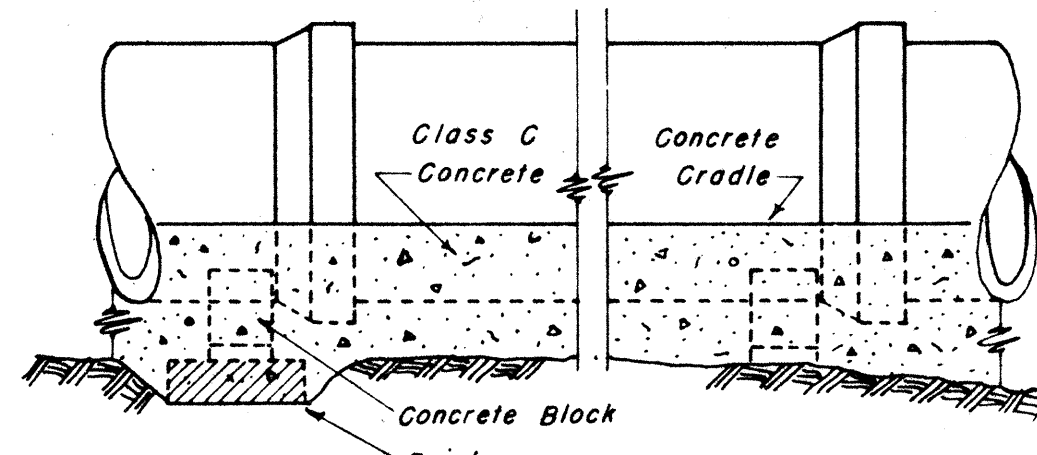


ELEVATION SHOWING METHOD OF LAYING PIPE

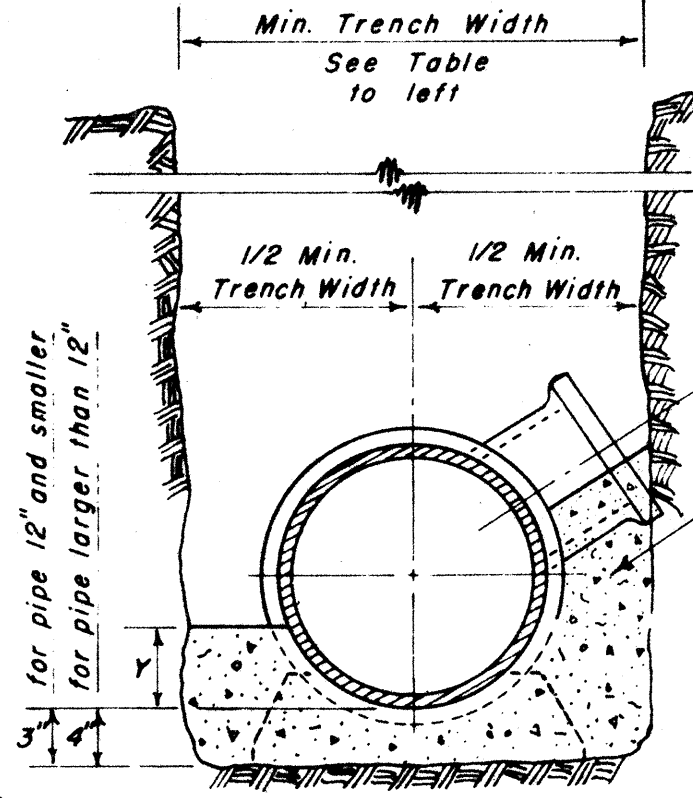


Pipe Size	"Y"
6"	3"
8"	3"
10"	3"
12"	3"
15"	4"
18"	5"
21"	5"
24"	6"
27"	7"
30"	7"

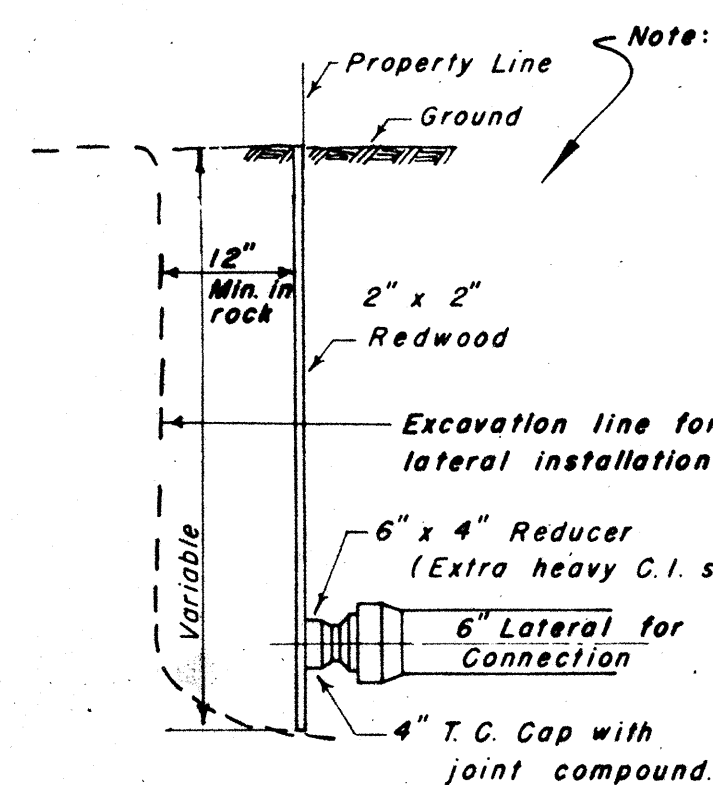

CONSTRUCTION AT PROPERTY LINE
Scale 1/2" = 1'-0"

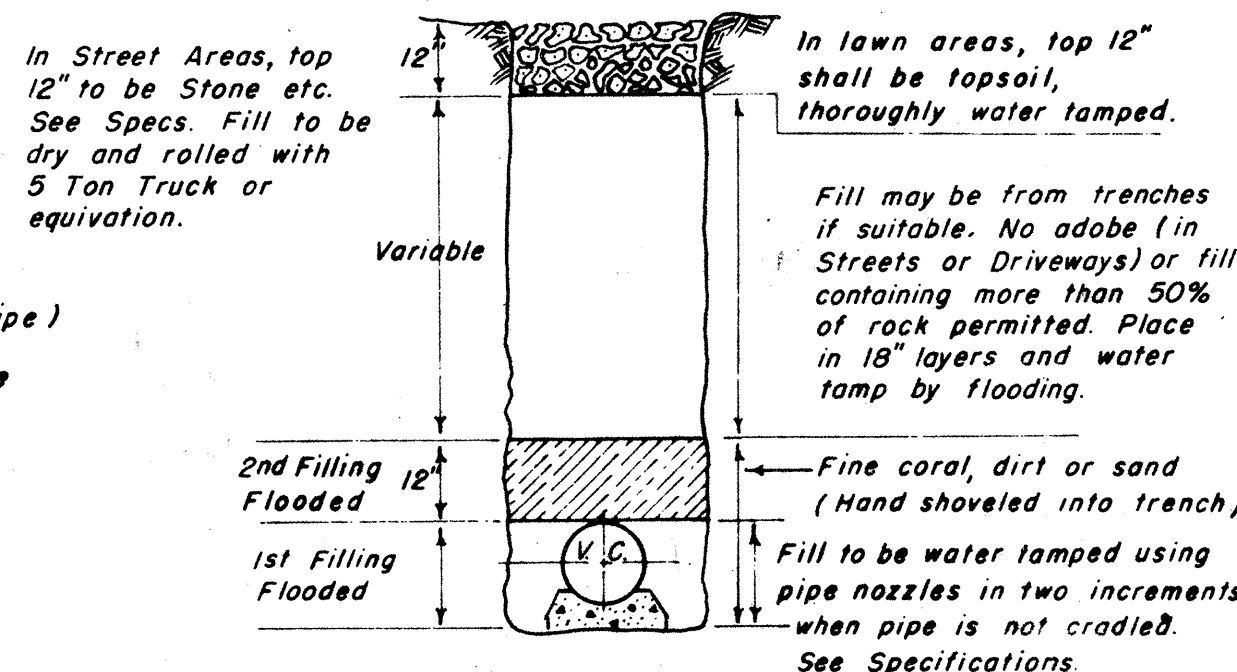


METHOD OF BACKFILL

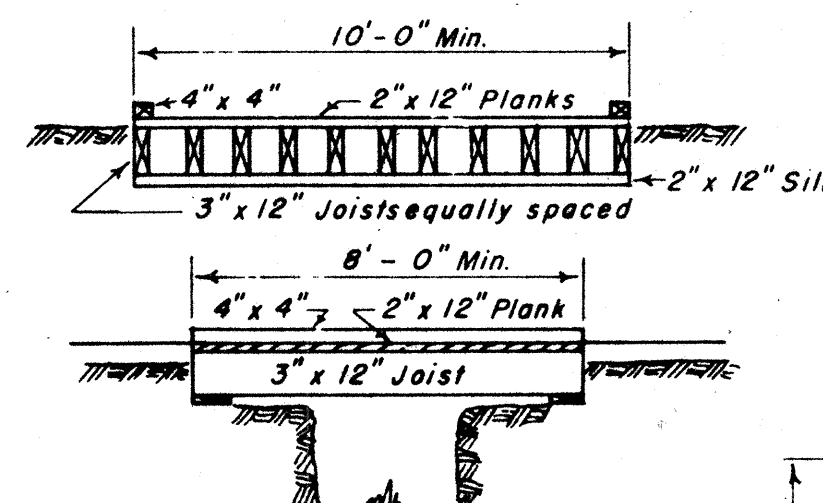

DETAILS
WOODEN BRIDGE OVER TRENCHES AT ROAD CROSSINGS
Scale 1/4" = 1'-0"

DETAIL OF PRECAST CONCRETE BLOCKS


Pipe Size	"A"	"B"	"C"
6"	1'-2"	6"	3"
8"	1'-5"	6"	3"
10"	1'-7"	6"	3"
12"	1'-7"	6"	3"
15"	1'-8"	6"	4"
18"	1'-9"	6"	4"
21"	1'-10"	6"	4"
24"	1'-11"	6"	4"
27"	2'-0"	6"	4"
30"	2'-3"	6"	4"

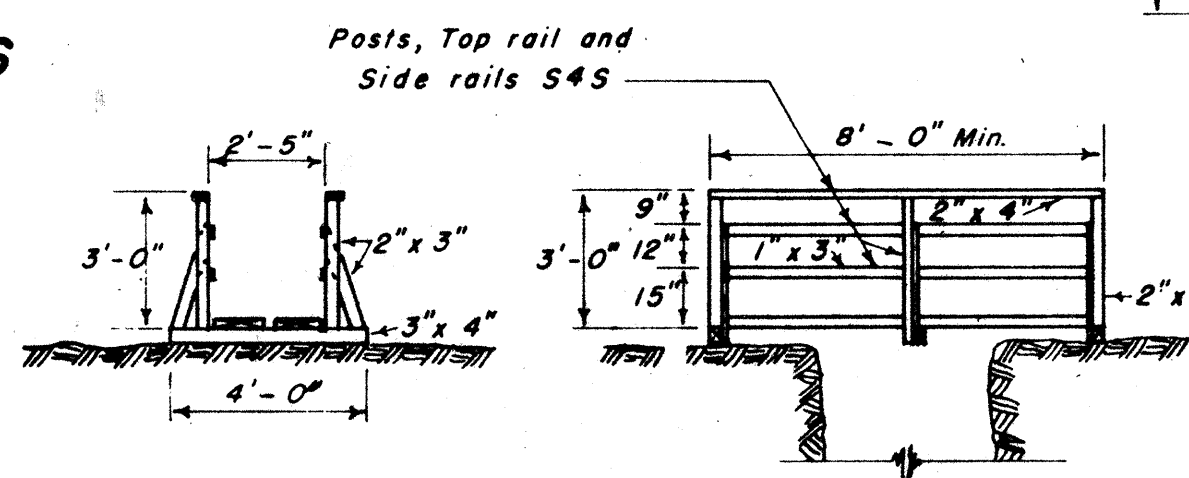


DETAILS
CROSS WALKS OVER TRENCHES
Scale 1/4" = 1'-0"

FED. ROAD DIST. No.	STATE	FED. AID PROJ. No.	FISCAL YEAR	SHEET No.	TOTAL SHEETS
HAWAII	HAWAII	15-5-0-10(1)	1956	54	170

Detail above this line similar to Standard Chimney Detail.

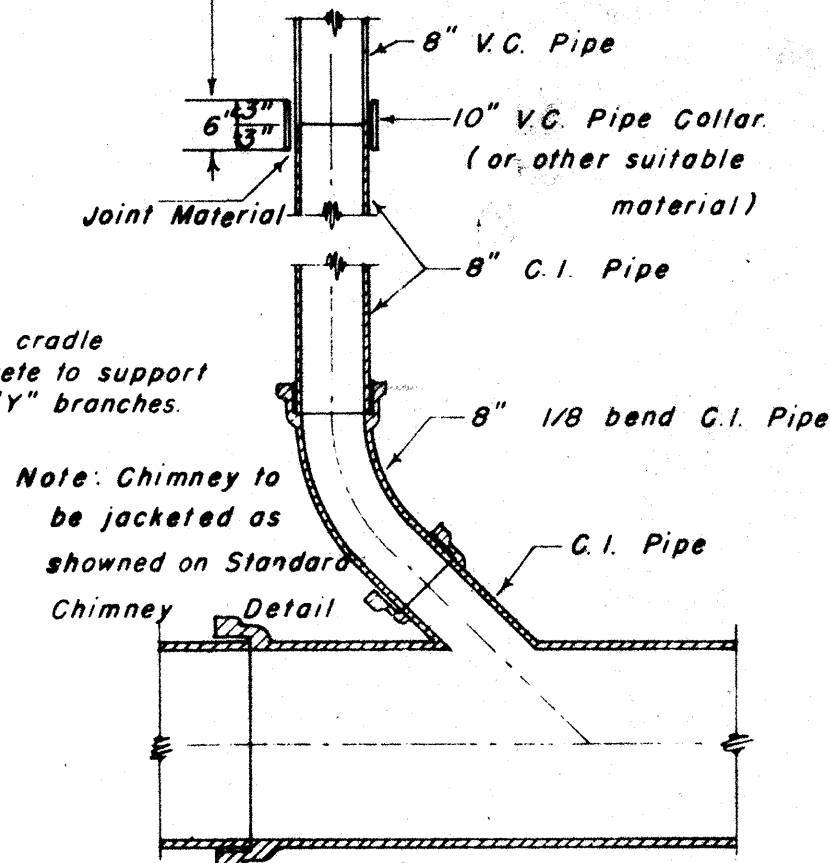


CHIMNEY DETAIL FOR CAST IRON SEWER LINE
Scale 1/2" = 1'-0"

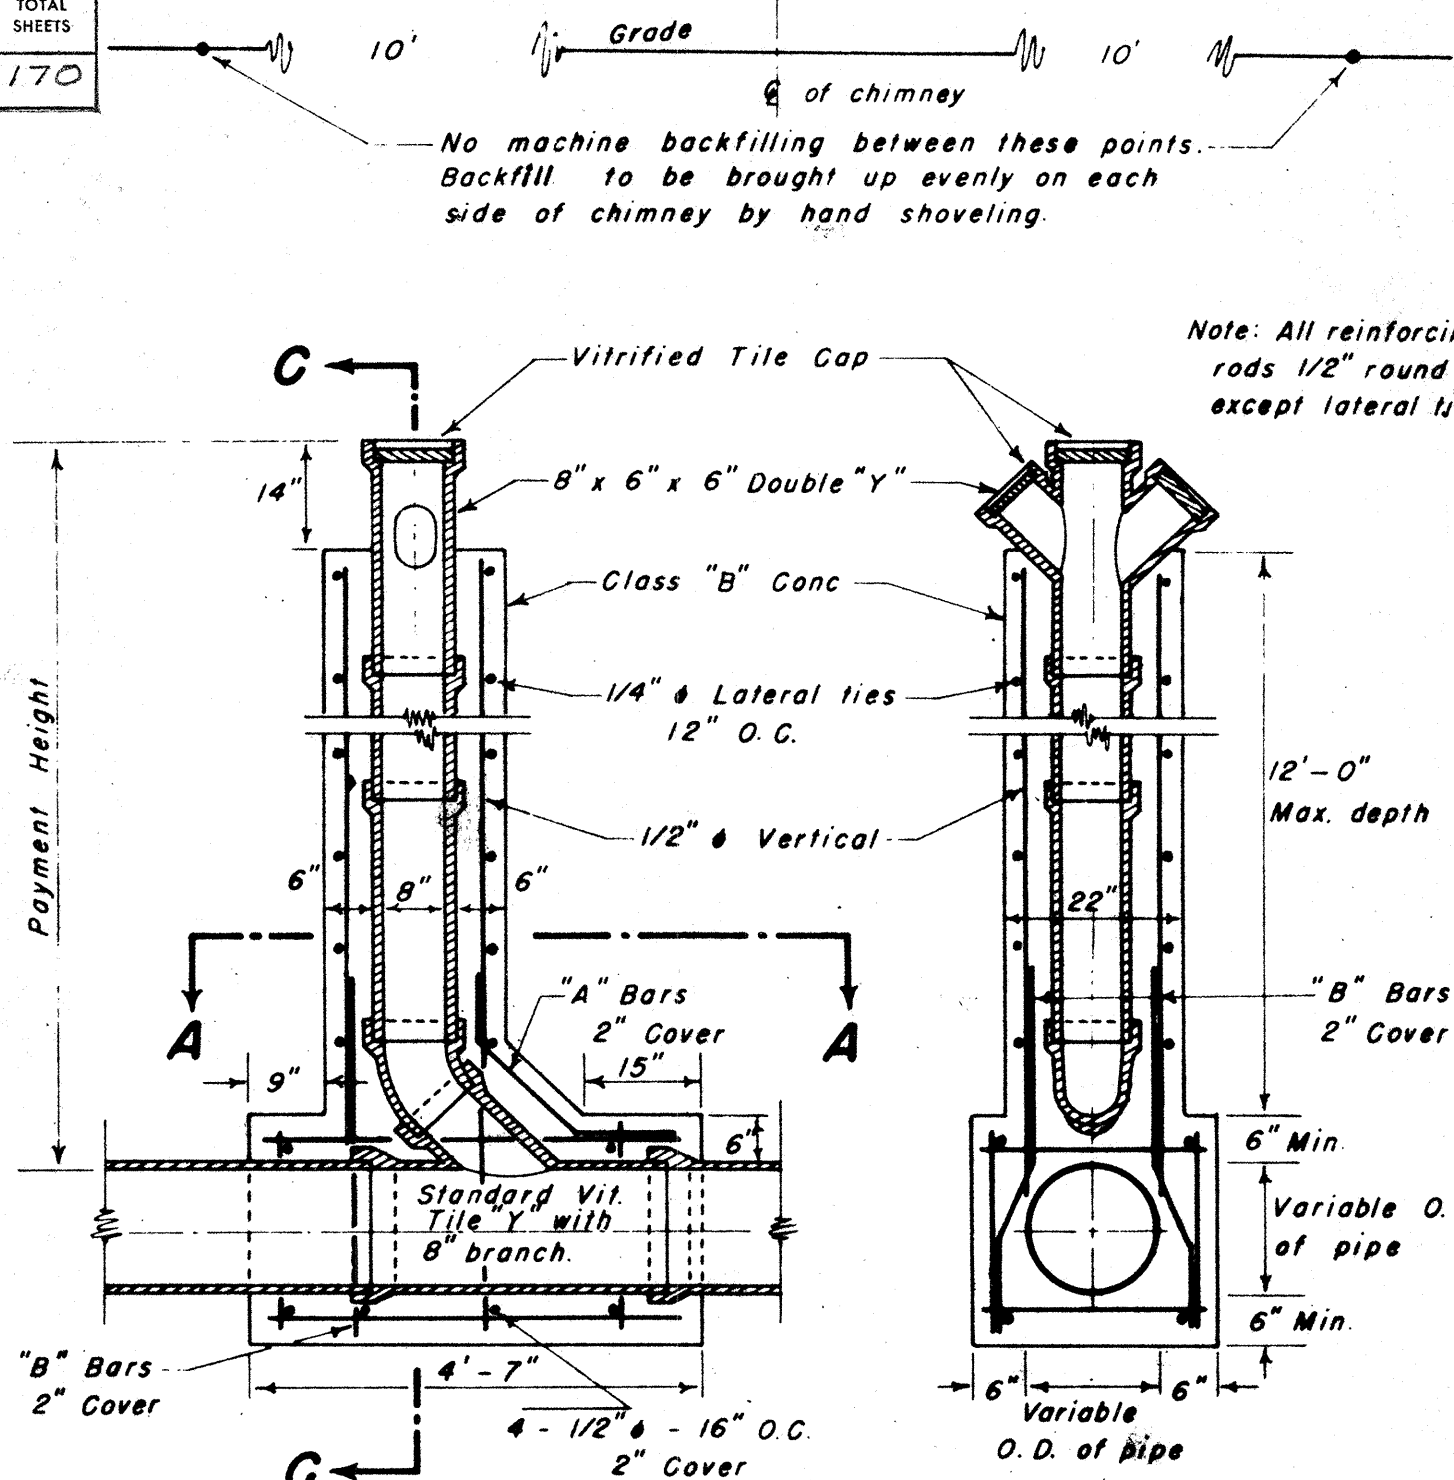


SECTION B - B
Scale 1/2" = 1'-0"

SECTION C - C
Scale 1/2" = 1'-0"

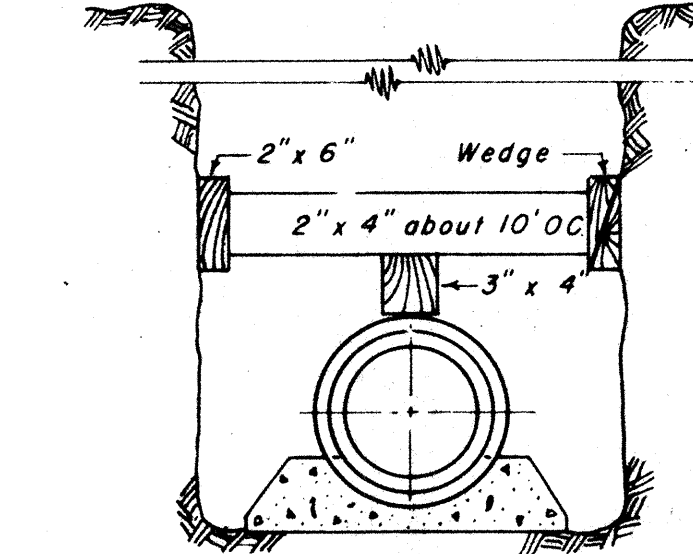

PIPE FLOTATION PREVENTION
Scale 1" = 1'-0"

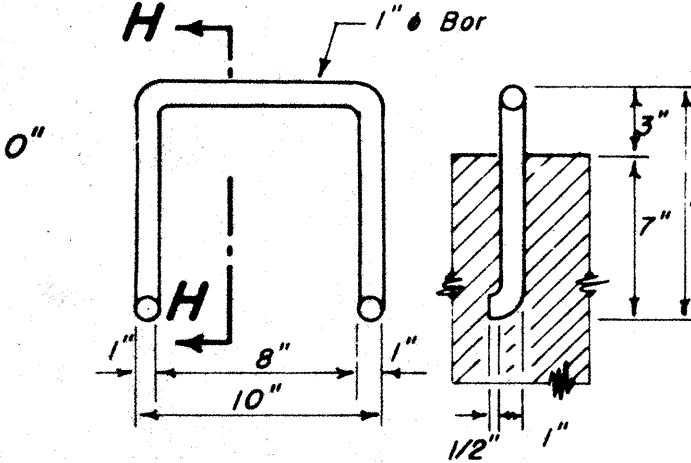


PLAN SECTION H - H
TYPE A RUNGS
WROUGHT IRON M.H. RUNGS
Scale 1-1/2" = 1'-0"


Mark	Steel	Shape	Req.
"A"	1/2"	45°	2 Pcs.
"B"	1/2"	22-1/2°	4 Pcs.

CHIMNEY DETAILS

Note: Dimensions shown may be varied to accommodate specific brand of pipe furnished by Contractor.
Note: Contractor shall use such Standard Details shown above as are applicable to, and called for, on this project.
When lateral sewers are constructed from the trunk sewer to the property line, the grade of such lateral sewer shall be 1/8" per lineal foot unless otherwise ordered by the Engineer.

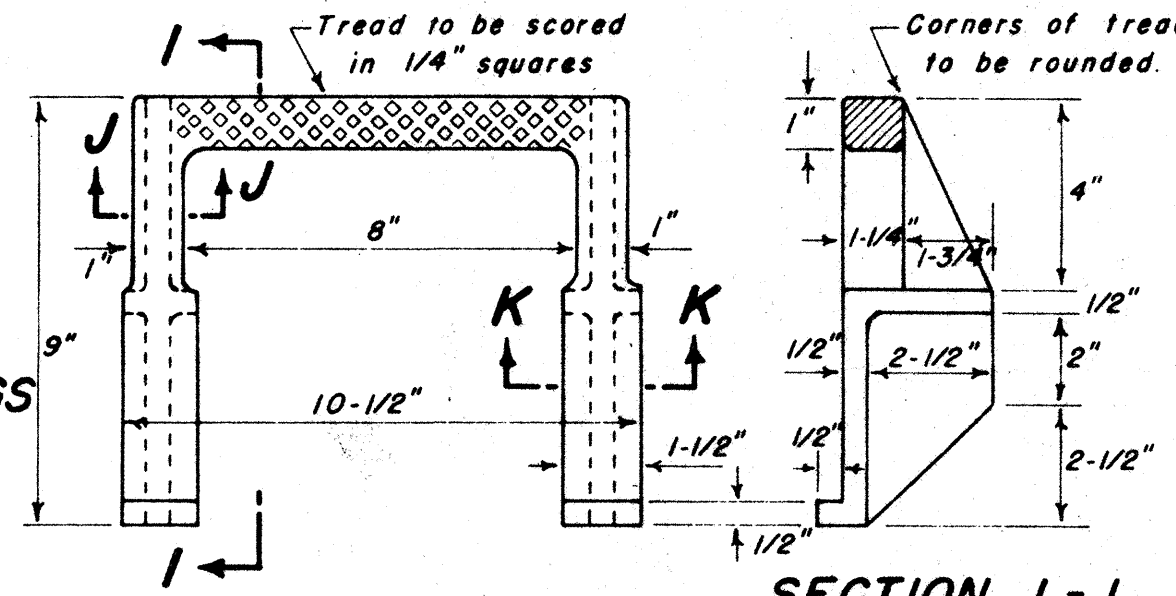

PLAN
TYPE B RUNGS
Scale 3" = 1'-0"

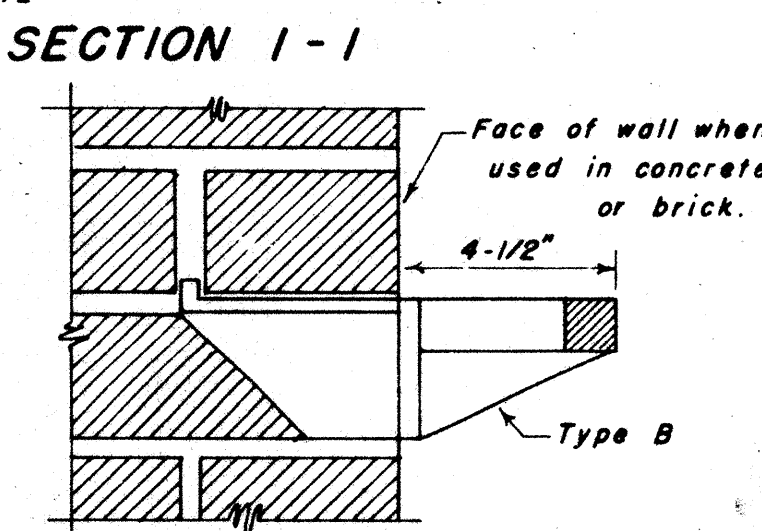

SECTION J - J
CAST IRON M.H. RUNGS
Scale 3" = 1'-0"

METHOD OF INSTALLATION

TERRITORIAL HIGHWAY DEPARTMENT
TERRITORY OF HAWAII
KALIHI VALLEY RD.
PROJ. NO. US-5-0630(1)
February 1956

DEPARTMENT OF PUBLIC WORKS
CITY AND COUNTY OF HONOLULU
DIVISION OF SEWERS

REVISED
STANDARD DETAILS
(SUPERSEDES STANDARD DATED 4-1-49)

ENGINEER: F. SUND, Nov. 1, 1954
DRAFTSMAN: A. Kanayama
SCALE: AS SHOWN
CHECKED BY: J. K. SUND
TRACER: A. Kanayama

APPROVED: J. K. SUND, ACTING CHIEF ENGINEER
APPROVED: J. K. SUND, ACTING DIVISION ENGINEER

