


INDEX TO DRAWINGS			
SHEET NO.	DESCRIPTION	SHEET NO.	DESCRIPTION
1	Title Sheet	70	Landscaping
2-4	Typical Sections	71	Alteration of Hothouse
5-16	Plan and Profile	72	Dwelling & Garage Relocation
17-20	Soil Profile	73-74	Garage & Driveway Rehabilitation
21-30	Intersection Details	75	Retaining Wall Extension
31-32	Pedestrian Walkway	76-85	Standard Details
33-42	Storm Drain Details	86-110	Kalihi Stream Bridge
43-50A	Water System	111	Standard Bridge Details
51-55	Sewer System	112-170	Cross Sections
56-58	Traffic Signal System		
59-64	Traffic Signs		
65-69	Highway Lighting System		


TERRITORY OF HAWAII
TERRITORIAL HIGHWAY DEPARTMENT
HONOLULU, OAHU, T. H.
**AS BUILT
PLANS OF
KALIHI VALLEY ROAD**
FEDERAL AID SECONDARY PROJECT NO. US-S-0630(I)
DISTRICT OF HONOLULU
ISLAND OF OAHU

SCALE
PLAN 1 INCH = 50 FEET
PROFILE HOR. 1 INCH = 50 FEET
 VER. 1 INCH = 10 FEET
CROSS SECTION HOR. 1 INCH = 10 FEET
 VER. 1 INCH = 10 FEET

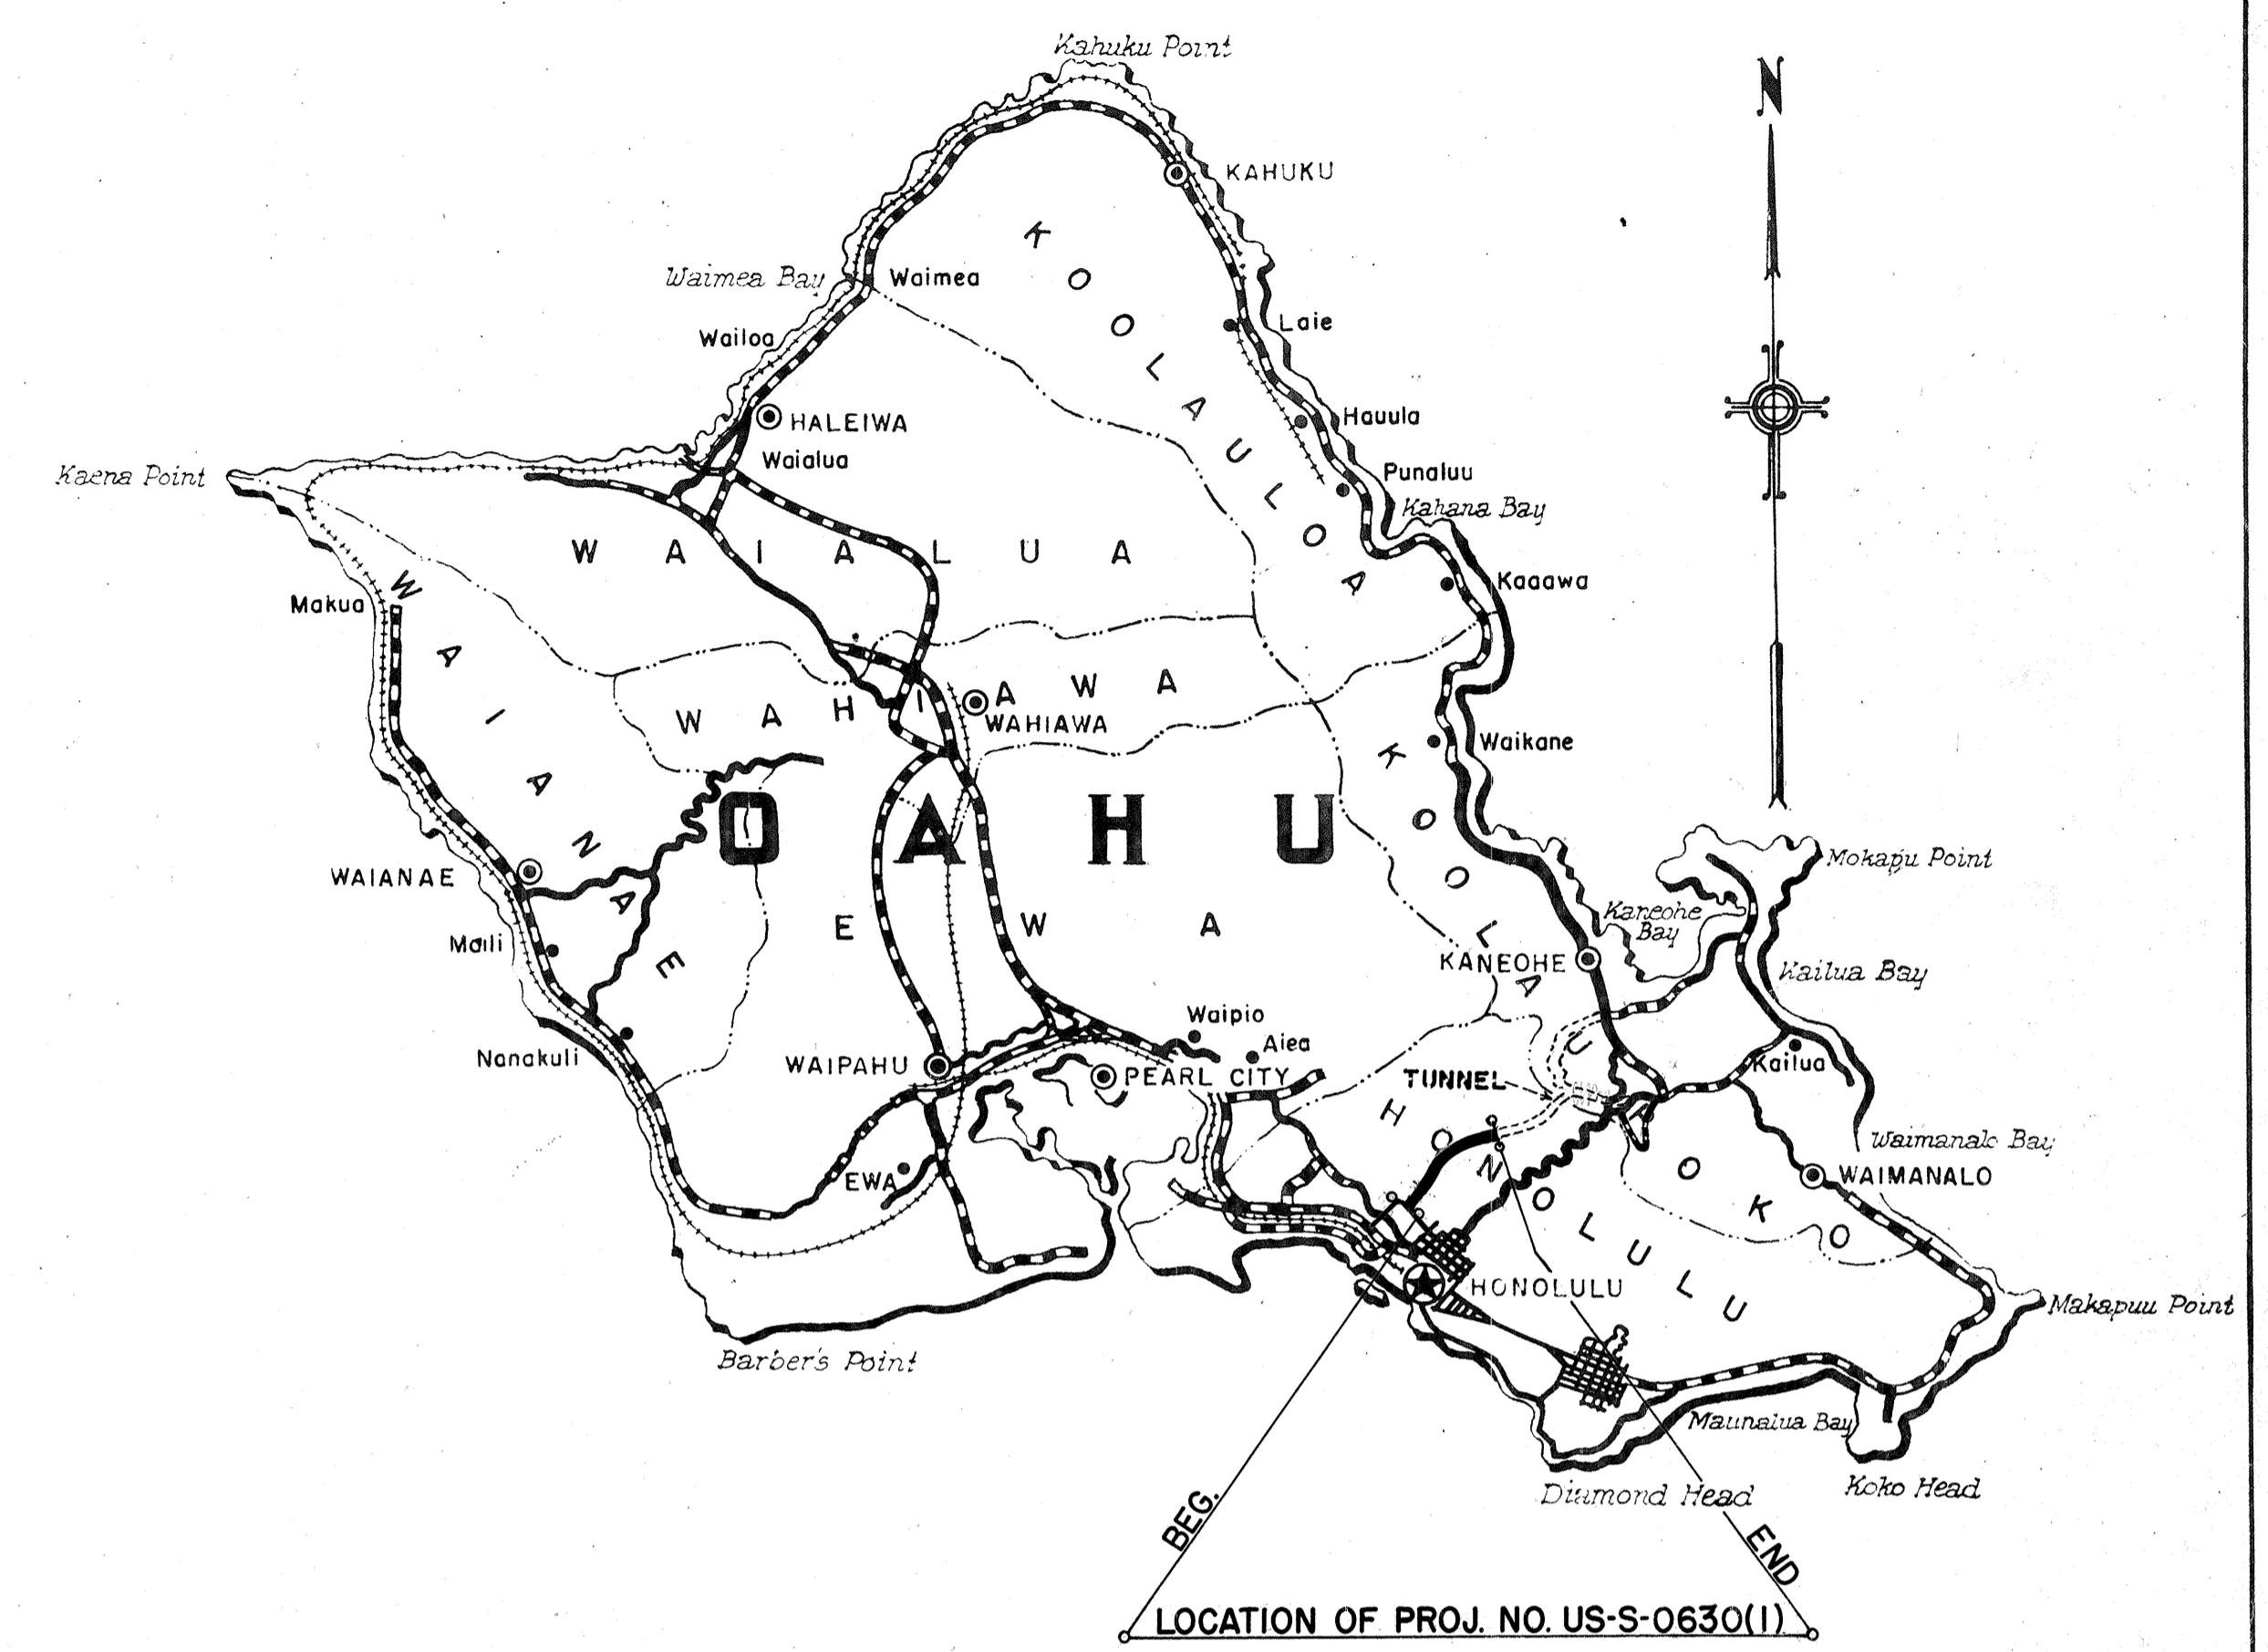

CONVENTIONAL SIGNS

Centerline	125
Boundary Lines	or
Fences (Named)	
Existing Roadways	
Circular Culvert	
Box Culvert	
Bridge	
Telephone Pole	T.O.P.
Electric Power Pole	E.P.P.
Water Main	W ₂ - W ₂ (W4, 8, 12, Etc.)
Storm Drain	SD ₁₂ - SD ₁₂ (SD _{18, 24} , Etc.)
Concrete Drop Intake	C.D.I.
Standard Catch Basin	S.C.B.
Standard Manhole	M.H. 5
Sewer Manhole	S.M. 8 1/2
Telephone Manhole	T.M.H.
Fire Hydrant	F.H.
Tree (Large, named)	Mango, Cocoa
Railroad	
Haw Telephone Underground Cable	HTC
Water Meter	WM

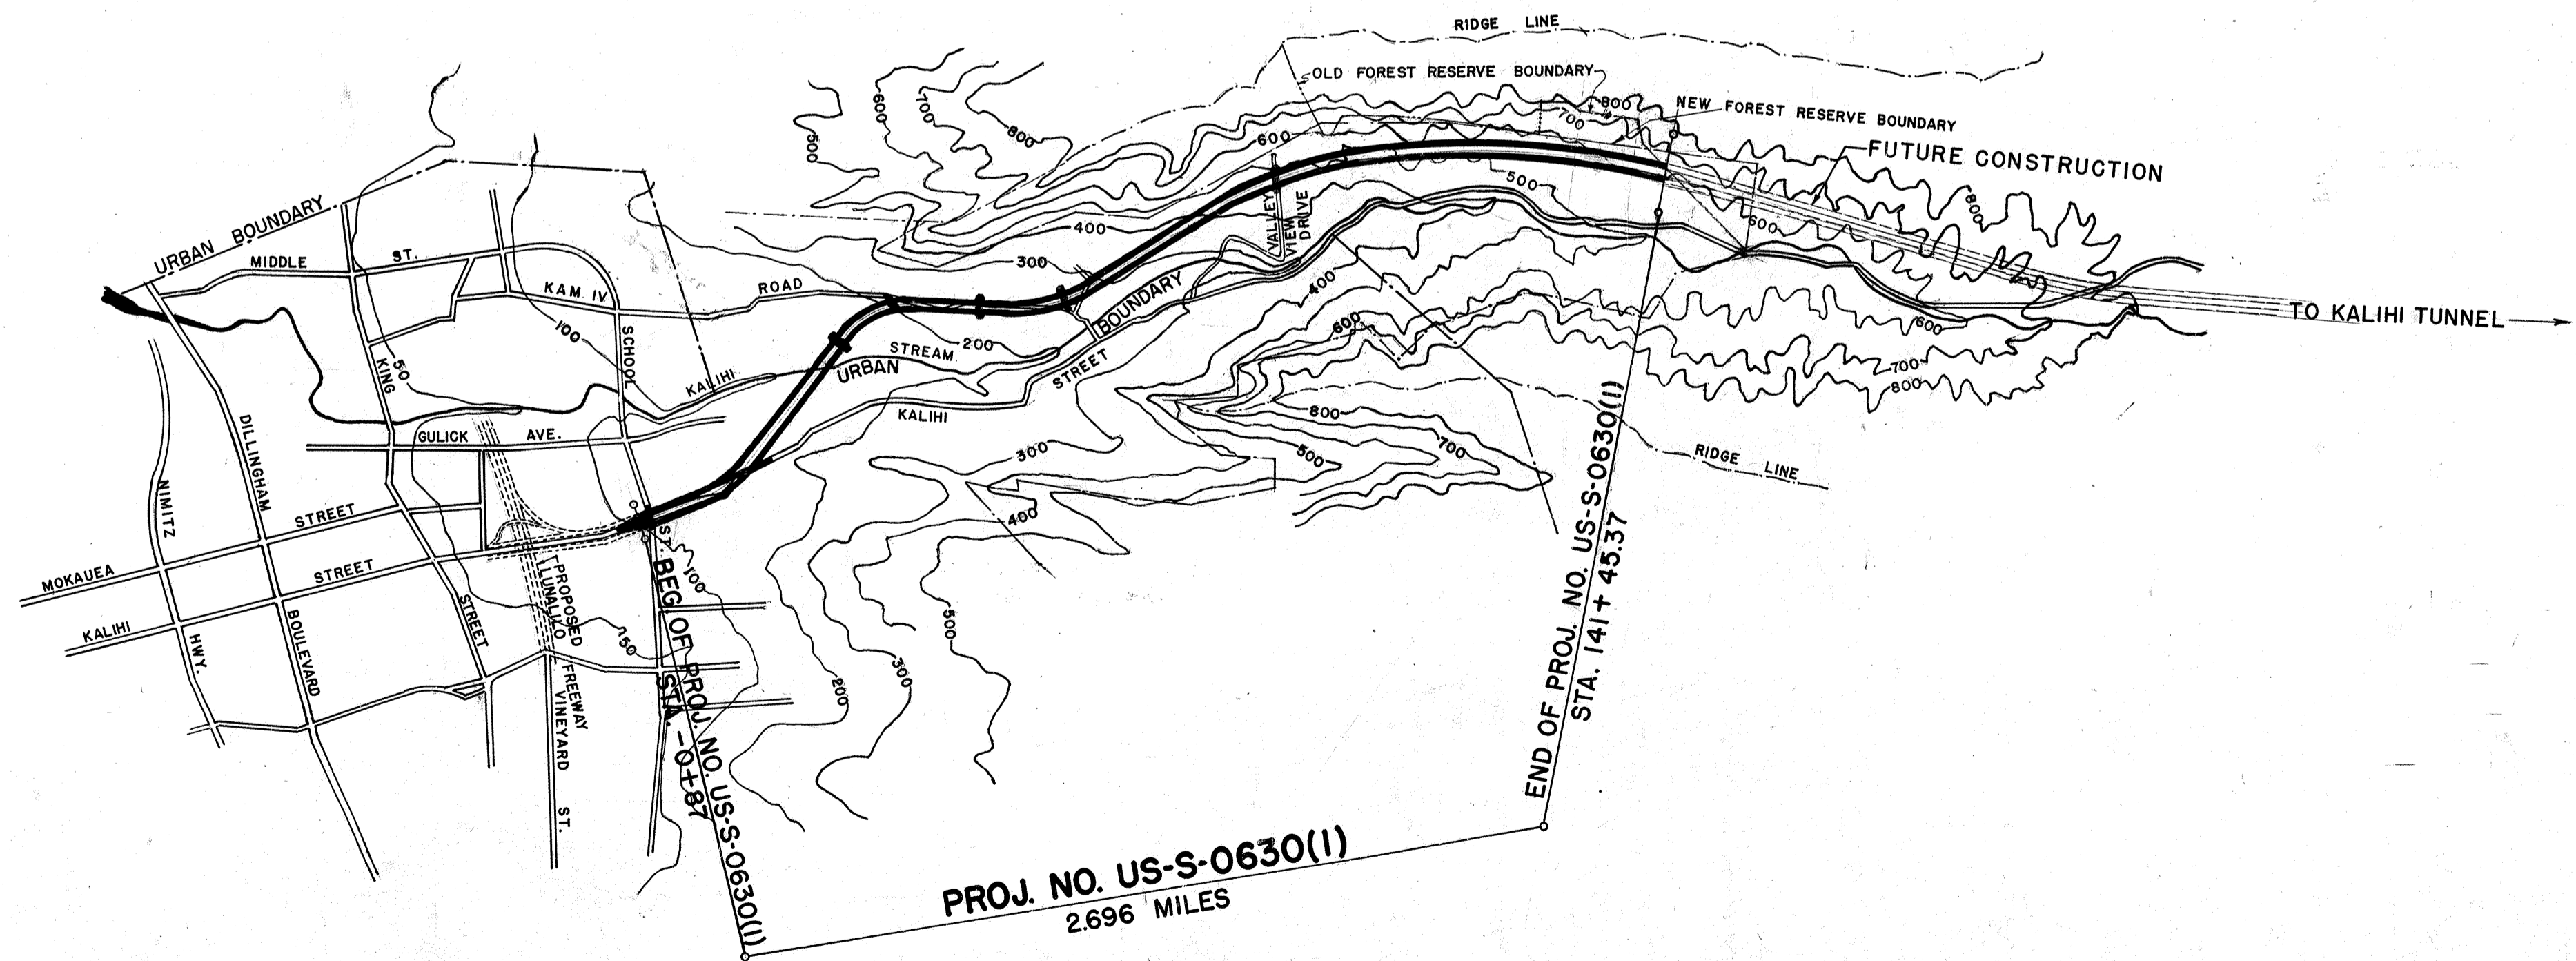

NOTE:
ALL CHANGES MADE DURING
CONSTRUCTION HAVE BEEN
NOTED IN THESE TRACINGS
IN RED AND CHECKED BY

T. Weston
RESIDENT ENGINEER
5-17-63
DATE

Scale: 1" = 1667'

LAYOUT OF PROJECT

GROSS LENGTH OF PROJ. = 2.696 MILES
BRIDGES OVER 20' SPAN = 0.039 MILE
NET LENGTH OF ROADWAY = 2.657 MILES

APPROVED DATE 3-22-56
Bow & Nettles
TERRITORIAL HIGHWAY ENGINEER

DEPARTMENT OF COMMERCE
BUREAU OF PUBLIC ROADS
APPROVED: _____
DISTRICT ENGINEER DATE

SURVEY PLOTTED BY S. P. ...
 ORIGINAL PLAN DRAWN BY K. Tomita
 NOTE BOOK OF ANNOTATIONS CHECKED BY P. M. ...
 CHECKED BY ...