


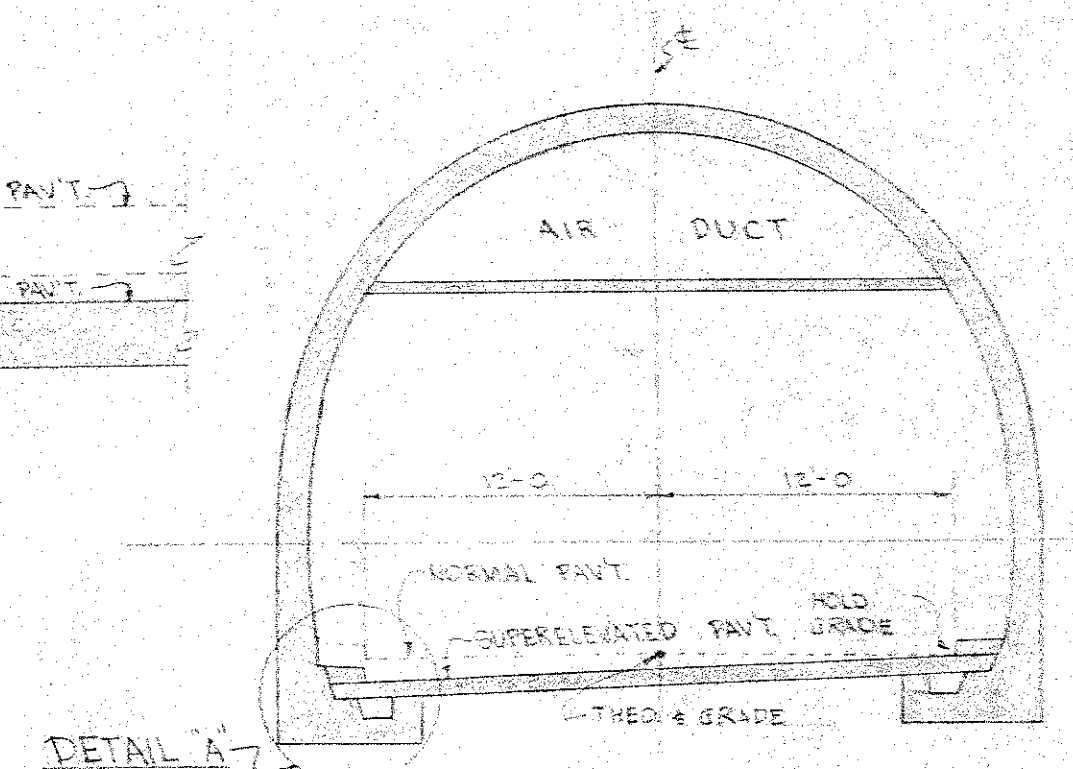

DEPARTMENT OF PUBLIC WORKS
CITY AND COUNTY OF HONOLULU
BUREAU OF PLANS

WILSON TUNNEL 2nd BORE TUNNEL

DATA AT CURVES

ENGINEER W. L. Loomis DATE 3-8-57
 DRAFTSMAN R. L. CHECKED BY W. L.
 SCALE _____ TRACER _____
 APPROVED W. L. Loomis APPROVED _____
 CHIEF ENGINEER _____ SURVEY ENGINEER _____

W. S.	PROFILE	C. B.
CR. SEC.	F. B.	S. B.
W. M. BY	F. W. BY	S. BY

JOB NO. 13-57 DWG. NO. T-2